


950027

1.5.1

FINAL MAP OF THE CROSSING AT SUMMERLIN VILLAGE 8 UNIT NO. 3

A PLANNED COMMUNITY
BEING A SUBDIVISION OF A PORTION OF SECTION 25, TOWNSHIP 20 SOUTH,
RANGE 59 EAST, M.D.M., CITY OF LAS VEGAS, CLARK COUNTY, NEVADA

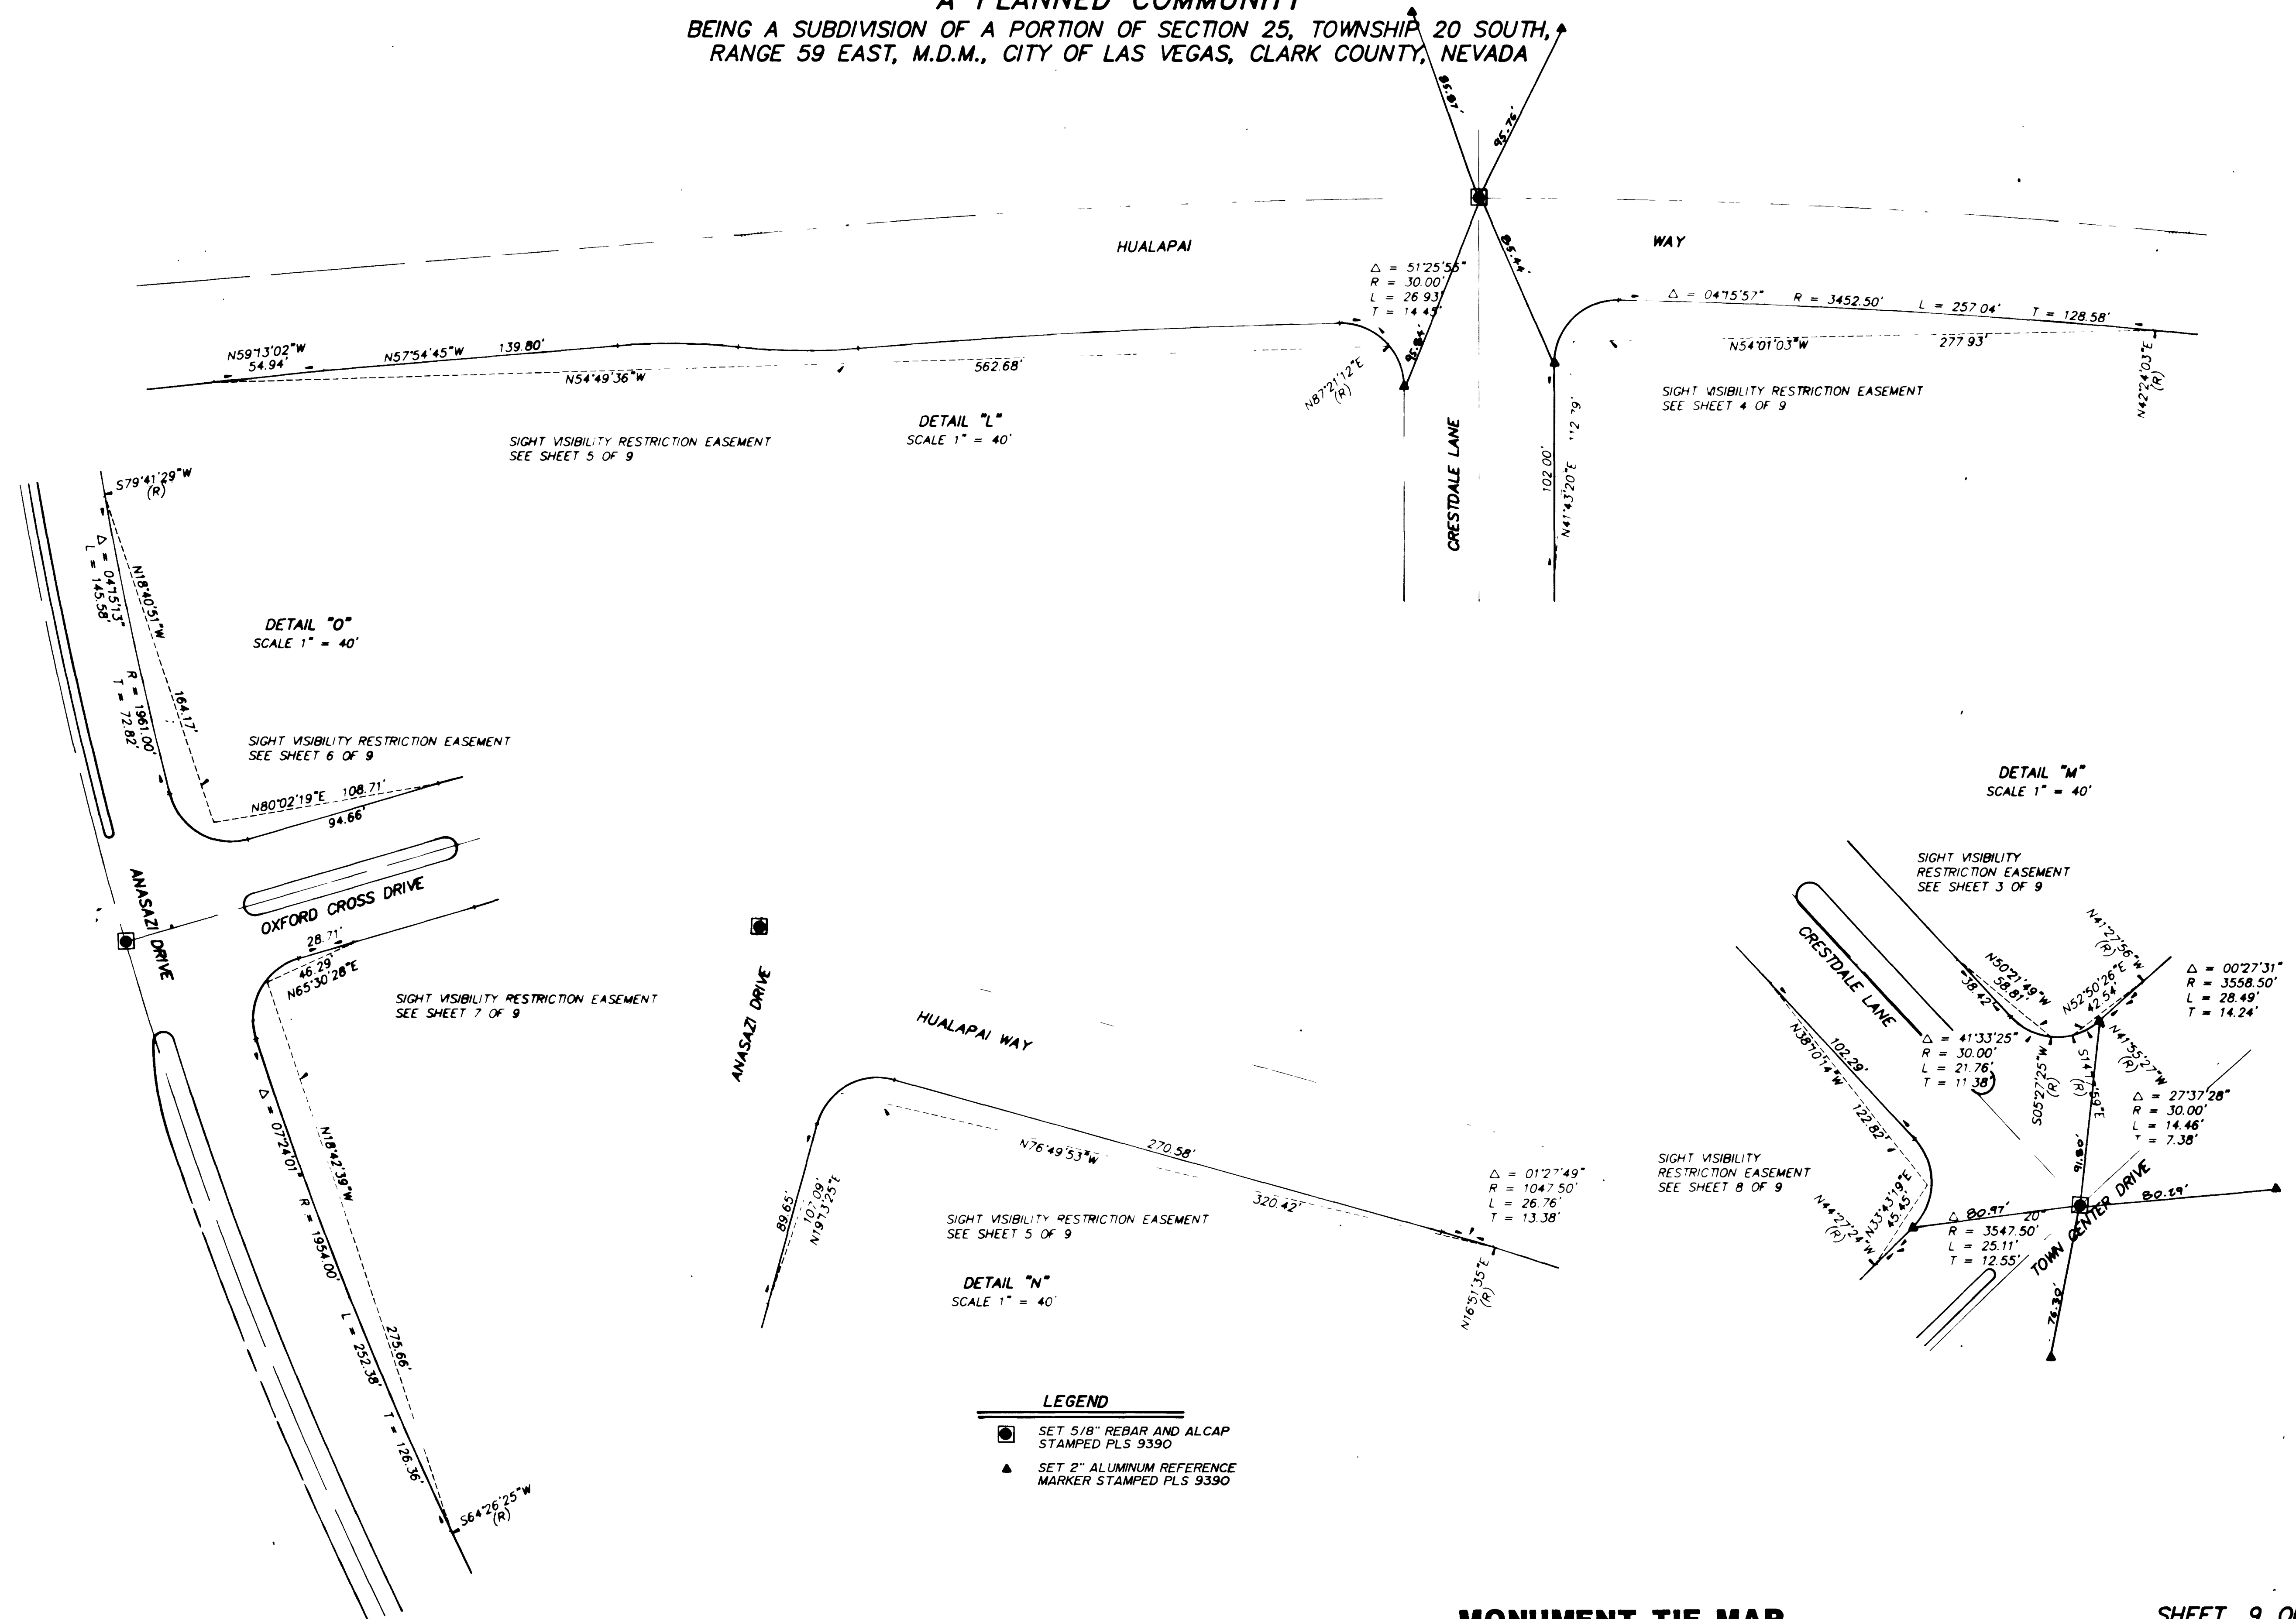

42008.403

PLOTTED: 04/28/98

3095

(See #107-V2310, #107-V2311, #107-V2259, #731-59B, #107-V2209)
Book 69 Page 99
058-4294-3
11-10-14

1. 1. 1.

A PLANNED COMMUNITY

MONUMENT THE MAP

SHEET 9 OF 9

[Faint, illegible handwritten notes]