


951 92.7

600


FINAL MAP OF THE CROSSING AT SUMMERLIN VILLAGE 8 UNIT NO. 3

A PLANNED COMMUNITY
BEING A SUBDIVISION OF A PORTION OF SECTION 25, TOWNSHIP 20 SOUTH,
RANGE 59 EAST, M.D.M., CITY OF LAS VEGAS, CLARK COUNTY, NEVADA

- LEGEND**
- SET 5/8" REBAR AND ALUM. CAP STAMPED P.L.S. 7755 W/ALUMINUM REFERENCE TIES IN TOP OF CURB (UNLESS OTHERWISE NOTED)
 - SET 5/8" REBAR AND ALUM. CAP STAMPED P.L.S. 7755
 - REFERENCE POINT
 - 2 LOT NUMBER
TOTAL LOTS = 7
TOTAL COMMON LOTS = 14
 - ⬢ BLOCK NUMBER
 - ① CURVE NUMBER
 - SUBDIVISION BOUNDARY LINE
 - STREET CENTERLINE
 - MATCH LINE
 - EASEMENT LINE
 - ⊙ SET 5/8" REBAR AND ALCAP STAMPED PLS 9390
 - ▲ SET 2" ALUMINUM REFERENCE MARKER STAMPED PLS 9390

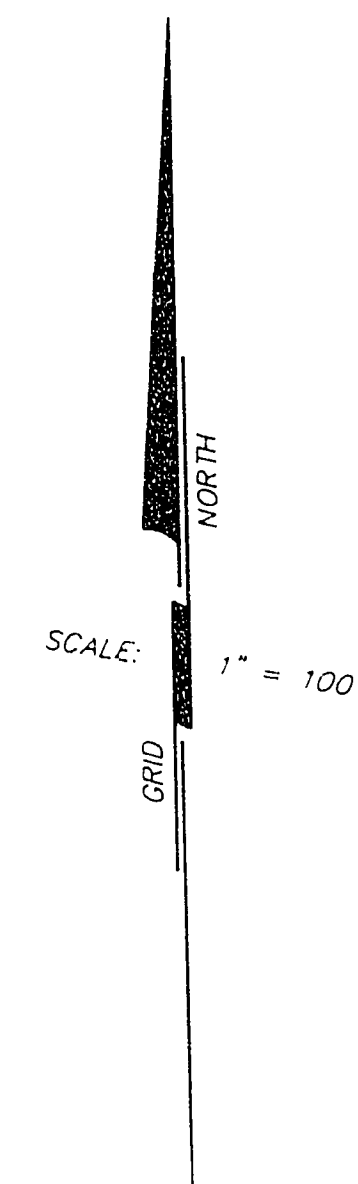

CURVE	DELTA	RADIUS	LENGTH	TANGENT
1	07°10'32"	1045.00	130.87	65.53'
2	09°19'59"	460.00	74.93	37.55'
3	91°07'49"	30.00	47.72	30.60'
4	91°7'10"	20.00	31.86	20.45'
5	00°12'08"	3283.50	11.59	5.79'

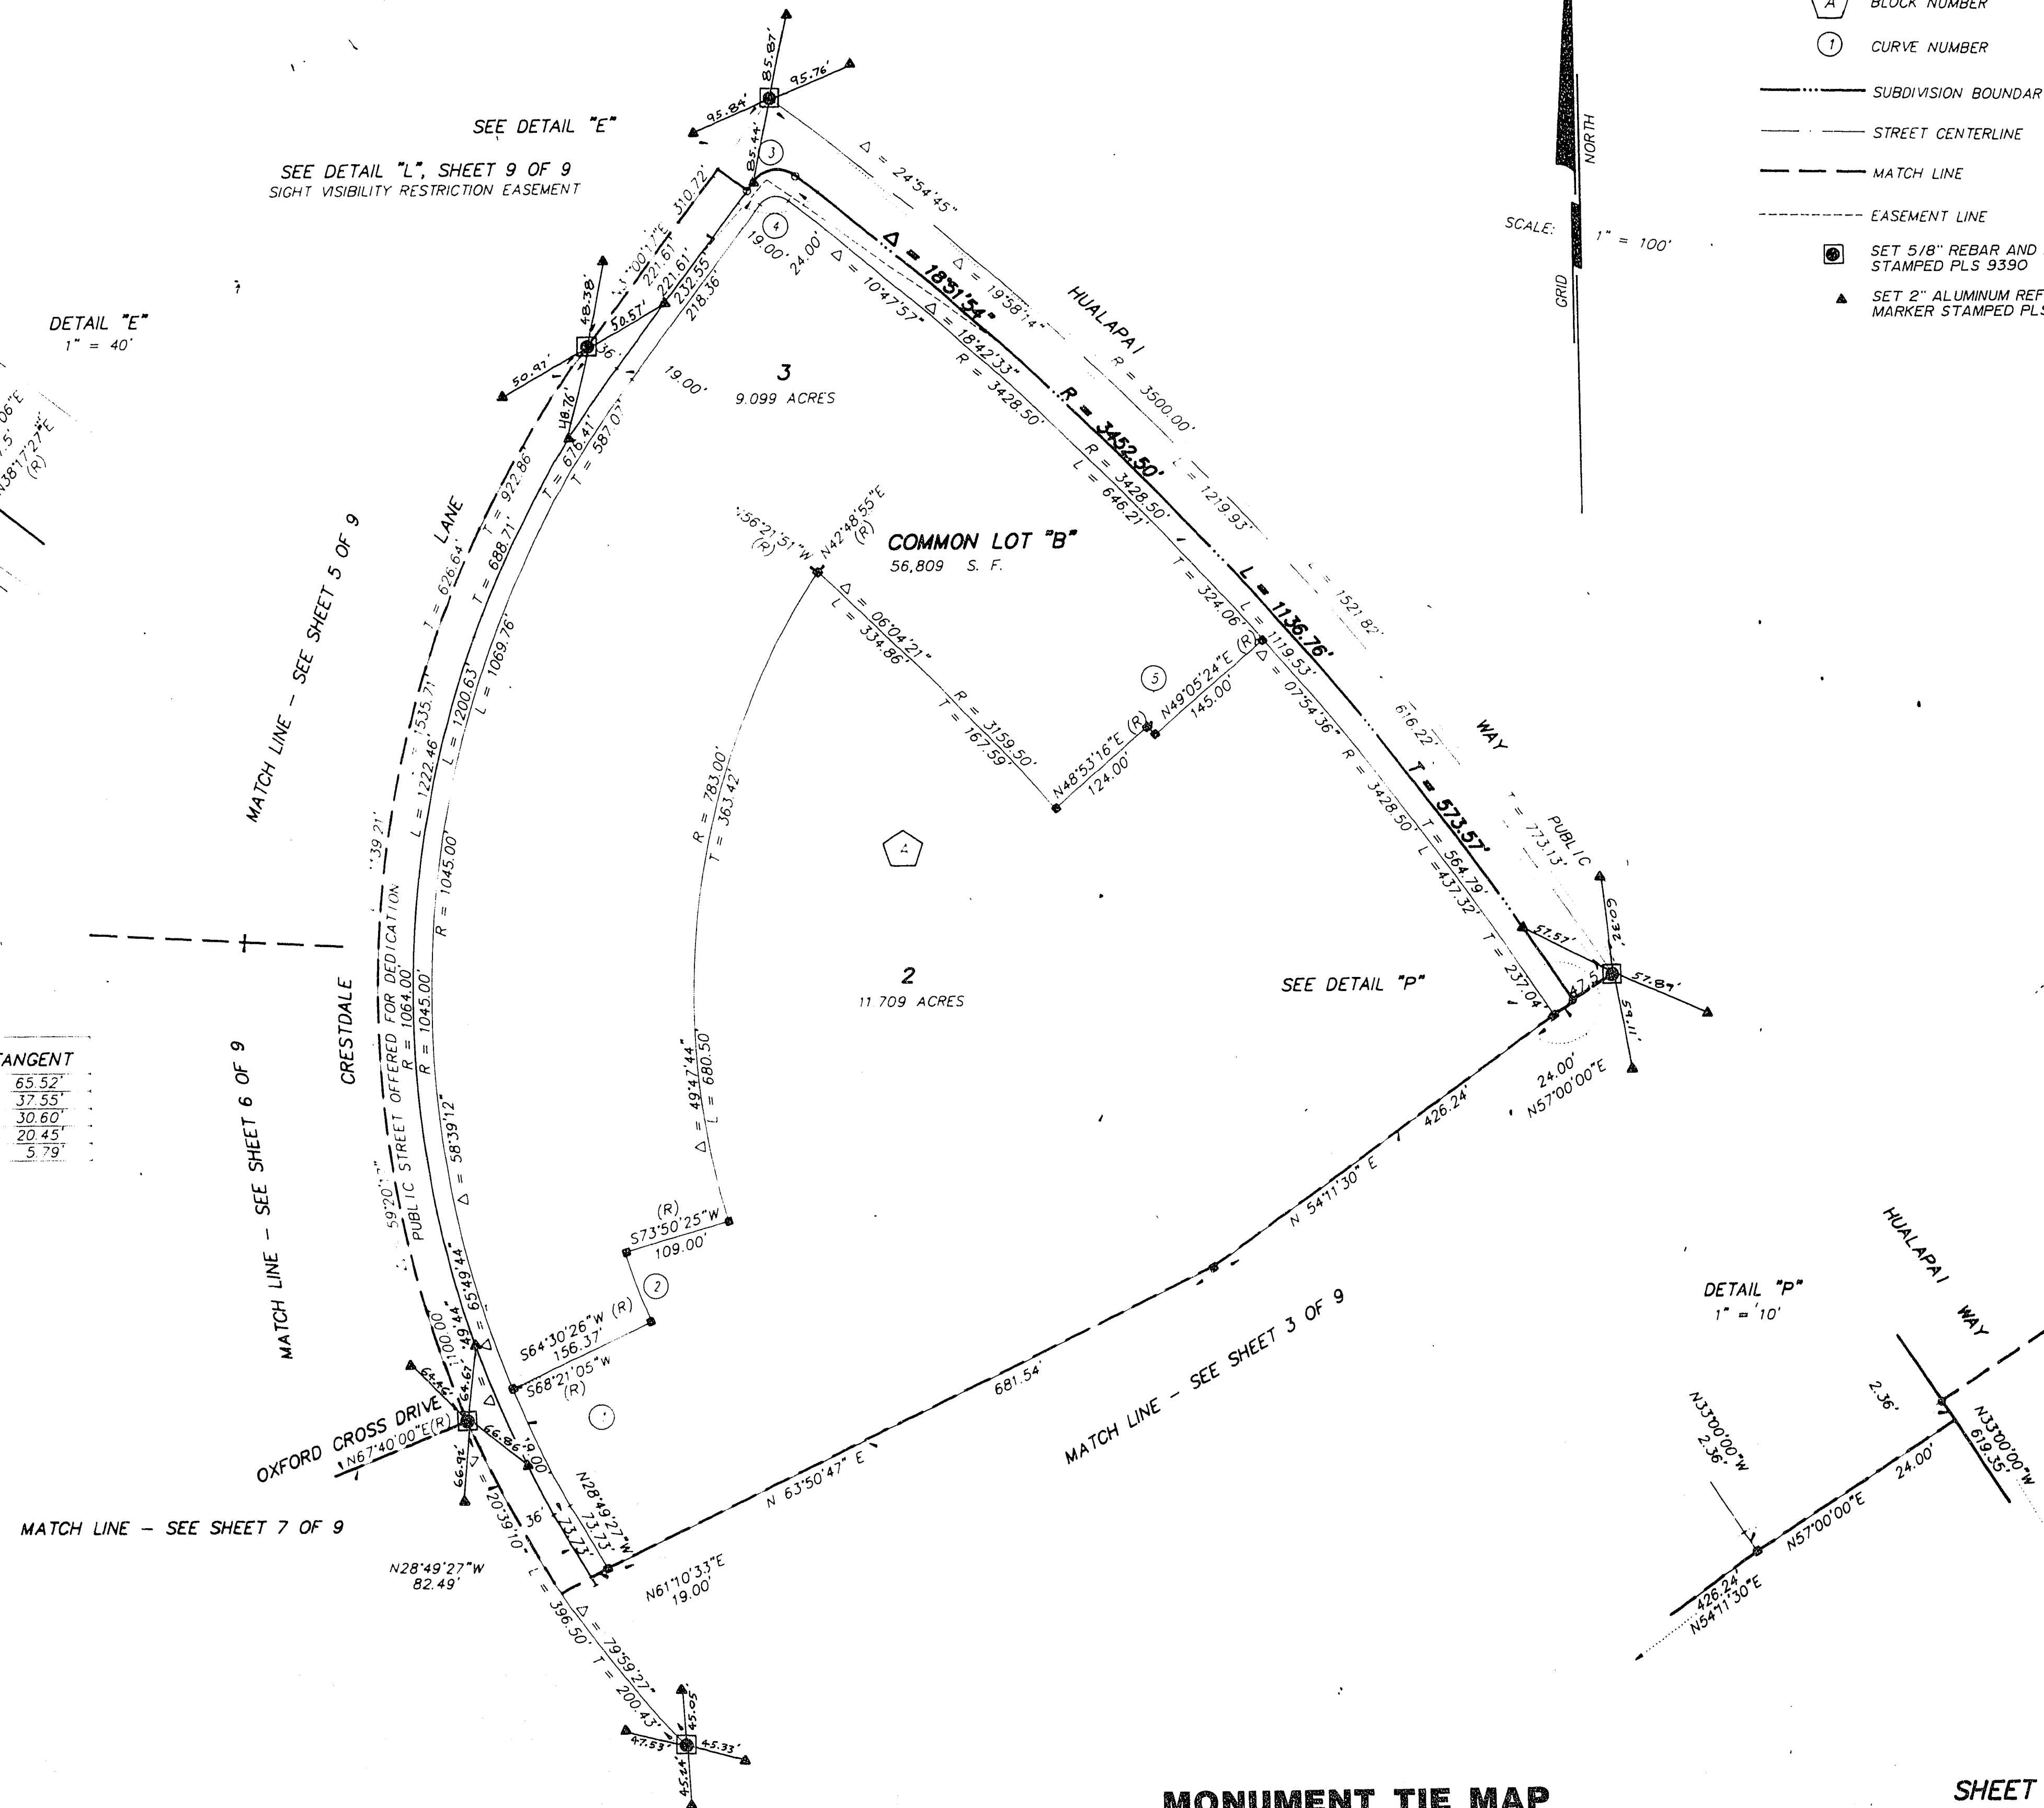

MONUMENT TIE MAP

SHEET 4 OF 9

(See #107-V2310, #107-V2289) Book 67 Page 99
#107-V2259, #731-59B 058-4294-3

11-b-9