


950927

61587

FINAL MAP OF THE CROSSING AT SUMMERLIN VILLAGE 8 UNIT NO. 3

A PLANNED COMMUNITY
BEING A SUBDIVISION OF A PORTION OF SECTION 25, TOWNSHIP 20 SOUTH,
RANGE 59 EAST, M.D.M., CITY OF LAS VEGAS, CLARK COUNTY, NEVADA

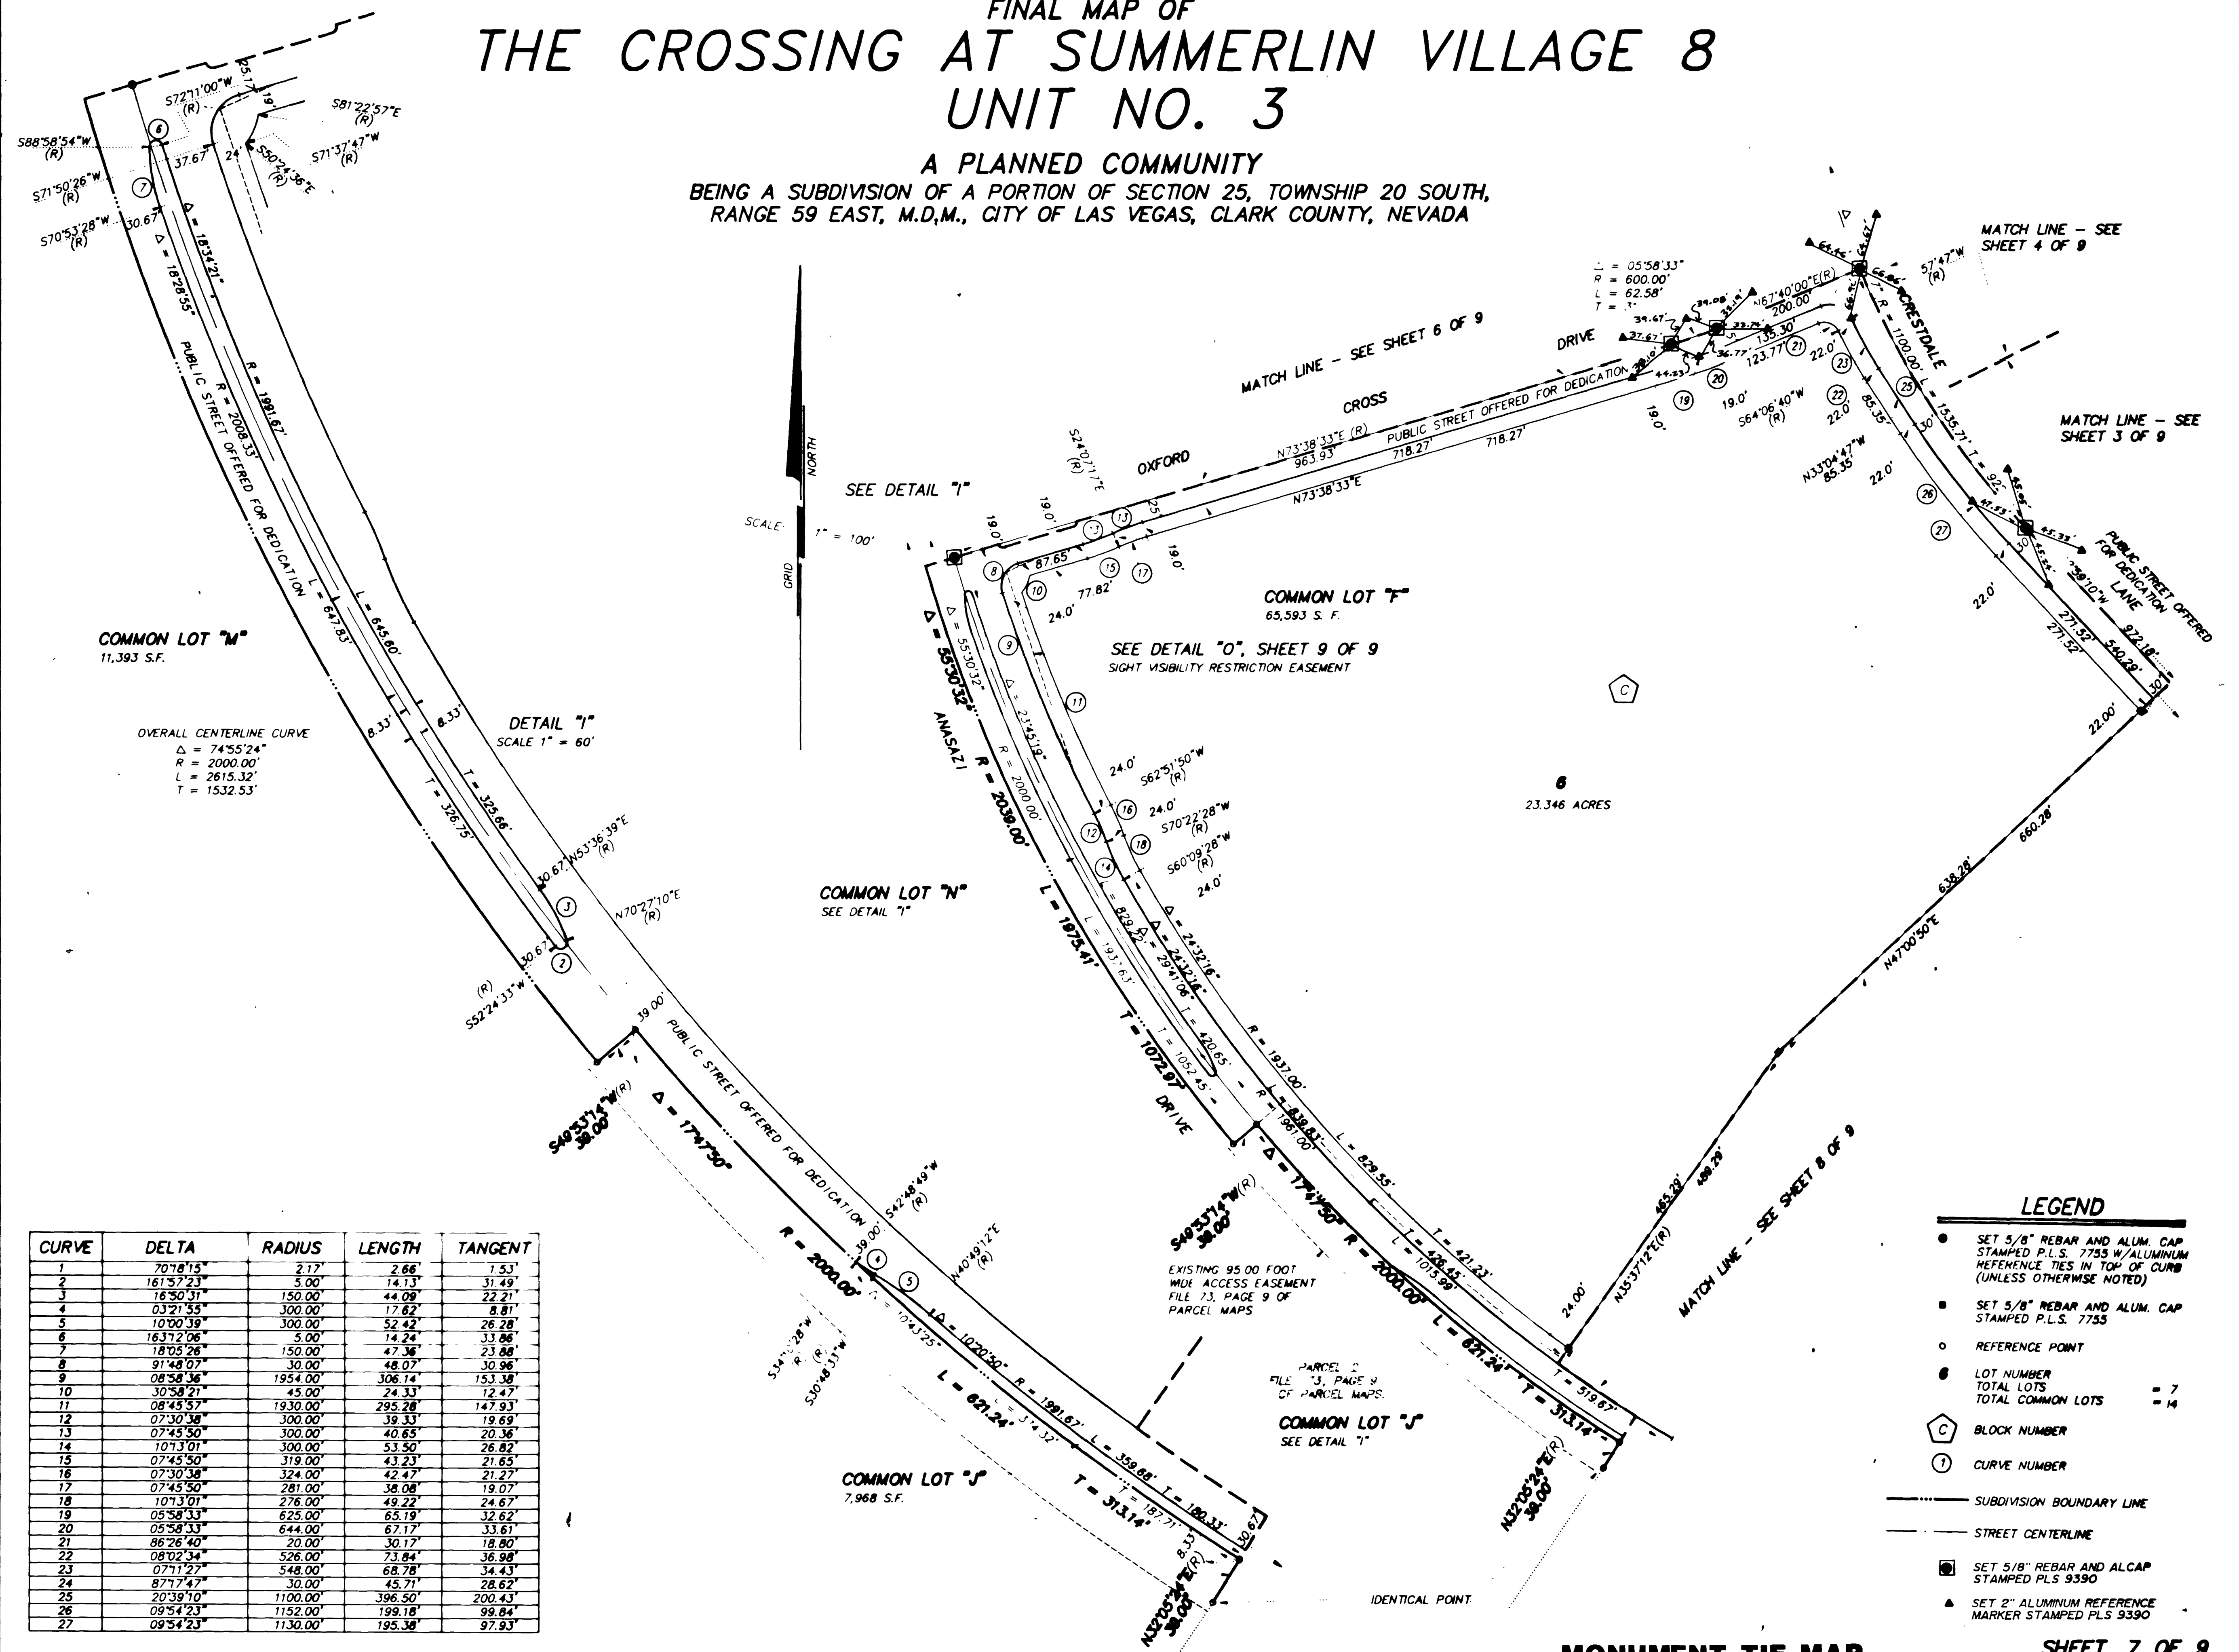

CURVE	DELTA	RADIUS	LENGTH	TANGENT
1	70°18'15"	2.17'	2.66'	1.53'
2	161°57'23"	5.00'	14.13'	31.49'
3	16°50'31"	150.00'	44.09'	22.21'
4	03°21'55"	300.00'	17.62'	8.81'
5	10°00'39"	300.00'	52.42'	26.28'
6	163°12'06"	5.00'	14.24'	33.86'
7	18°05'26"	150.00'	47.36'	23.86'
8	91°48'07"	30.00'	48.07'	30.96'
9	08°58'36"	1954.00'	306.14'	153.38'
10	30°58'21"	45.00'	24.33'	12.47'
11	08°45'57"	1930.00'	295.28'	147.93'
12	07°30'38"	300.00'	39.33'	19.69'
13	07°45'50"	300.00'	40.65'	20.36'
14	101°31'01"	300.00'	53.50'	26.82'
15	07°45'50"	319.00'	43.23'	21.65'
16	07°30'38"	324.00'	42.47'	21.27'
17	07°45'50"	281.00'	38.08'	19.07'
18	101°31'01"	276.00'	49.22'	24.67'
19	05°58'33"	625.00'	65.19'	32.62'
20	05°58'33"	644.00'	67.17'	33.61'
21	06°26'40"	20.00'	30.17'	18.80'
22	08°02'34"	526.00'	73.84'	36.98'
23	07°11'27"	548.00'	68.78'	34.43'
24	87°17'47"	30.00'	45.71'	28.62'
25	20°39'10"	1100.00'	396.50'	200.43'
26	09°54'23"	1152.00'	199.18'	99.84'
27	09°54'23"	1130.00'	195.38'	97.93'

- LEGEND**
- SET 5/8" REBAR AND ALUM. CAP STAMPED P.L.S. 7753 W/ALUMINUM REFERENCE TIES IN TOP OF CURB (UNLESS OTHERWISE NOTED)
 - SET 5/8" REBAR AND ALUM. CAP STAMPED P.L.S. 7753
 - REFERENCE POINT
 - LOT NUMBER
 - TOTAL LOTS = 7
 - TOTAL COMMON LOTS = 14
 - ⬢ BLOCK NUMBER
 - ① CURVE NUMBER
 - SUBDIVISION BOUNDARY LINE
 - STREET CENTERLINE
 - SET 5/8" REBAR AND ALCAP STAMPED P.L.S. 9390
 - ▲ SET 2" ALUMINUM REFERENCE MARKER STAMPED P.L.S. 9390

MONUMENT TIE MAP SHEET 7 OF 9

62008.403

PLOTTED: 06/28/06

(See #107-V2310, #107-V2289) Book 69 Page 99
#107-V2259, #731-59B 058-4294-3


11-6-12

950921

P. 147

FINAL MAP OF THE CROSSING AT SUMMERLIN VILLAGE 8 UNIT NO. 3

A PLANNED COMMUNITY

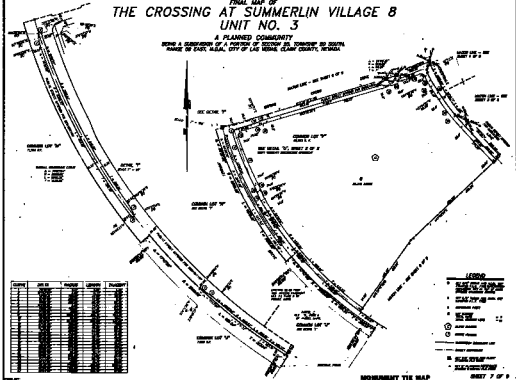

MONUMENT TIE MAP

SHEET 7 OF 9


11-6-12

047-40-000