


Avoid cutting underground utility lines. It's costly.

**Call
before you
Dig**

1-800-227-2600

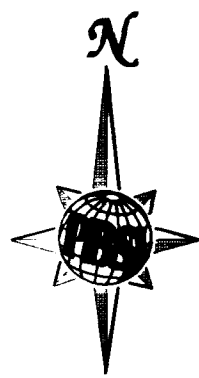



LEGEND

- BOUNDARY LINE
- SET 5/8" REBAR W/ALCAP W/ 4 TIES PLS # 8431
- REF. MON. 1-1/2 BC PLS 8431
- 10 LOT NUMBER
- 3 BLOCK NUMBER

SURVEYOR'S CERTIFICATE


I, CHARLES D. KIRCHER, A PROFESSIONAL LAND SURVEYOR, REGISTERED IN THE STATE OF NEVADA, DOES HEREBY CERTIFY THAT THE MONUMENTS HAVE BEEN SET AND THE TIE DISTANCE ESTABLISHED AS SHOWN HEREON. THIS SURVEY WAS COMPLETED ON APRIL 27, 1999.

CHARLES D. KIRCHER
PROFESSIONAL LAND SURVEYOR
STATE OF NEVADA
REGISTRATION NO. 8431

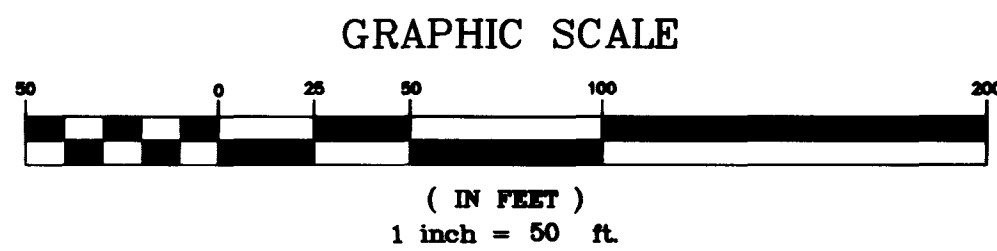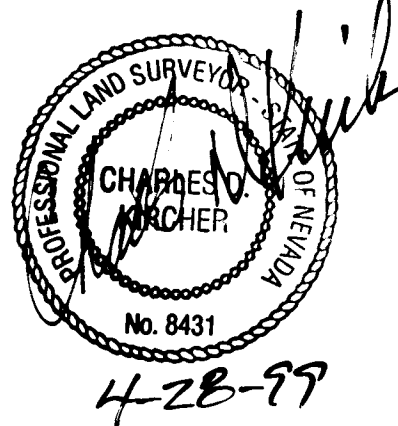

MONUMENT TIE MAP OF
HIGHLAND HILLS

ALL OF LOT 3 OF THE CROSSING AT SUMMERLIN VILLAGE 8 - UNIT NO. 1 PHASE 3 AS SHOWN IN BOOK 63 OF PLATS, PAGE 92, OFFICIAL RECORDS, CLARK COUNTY, NEVADA, LYING WITHIN SECTIONS 24 AND 25, TOWNSHIP 20 SOUTH, RANGE 59 EAST, M.D.M., CITY OF LAS VEGAS, CLARK COUNTY, NEVADA

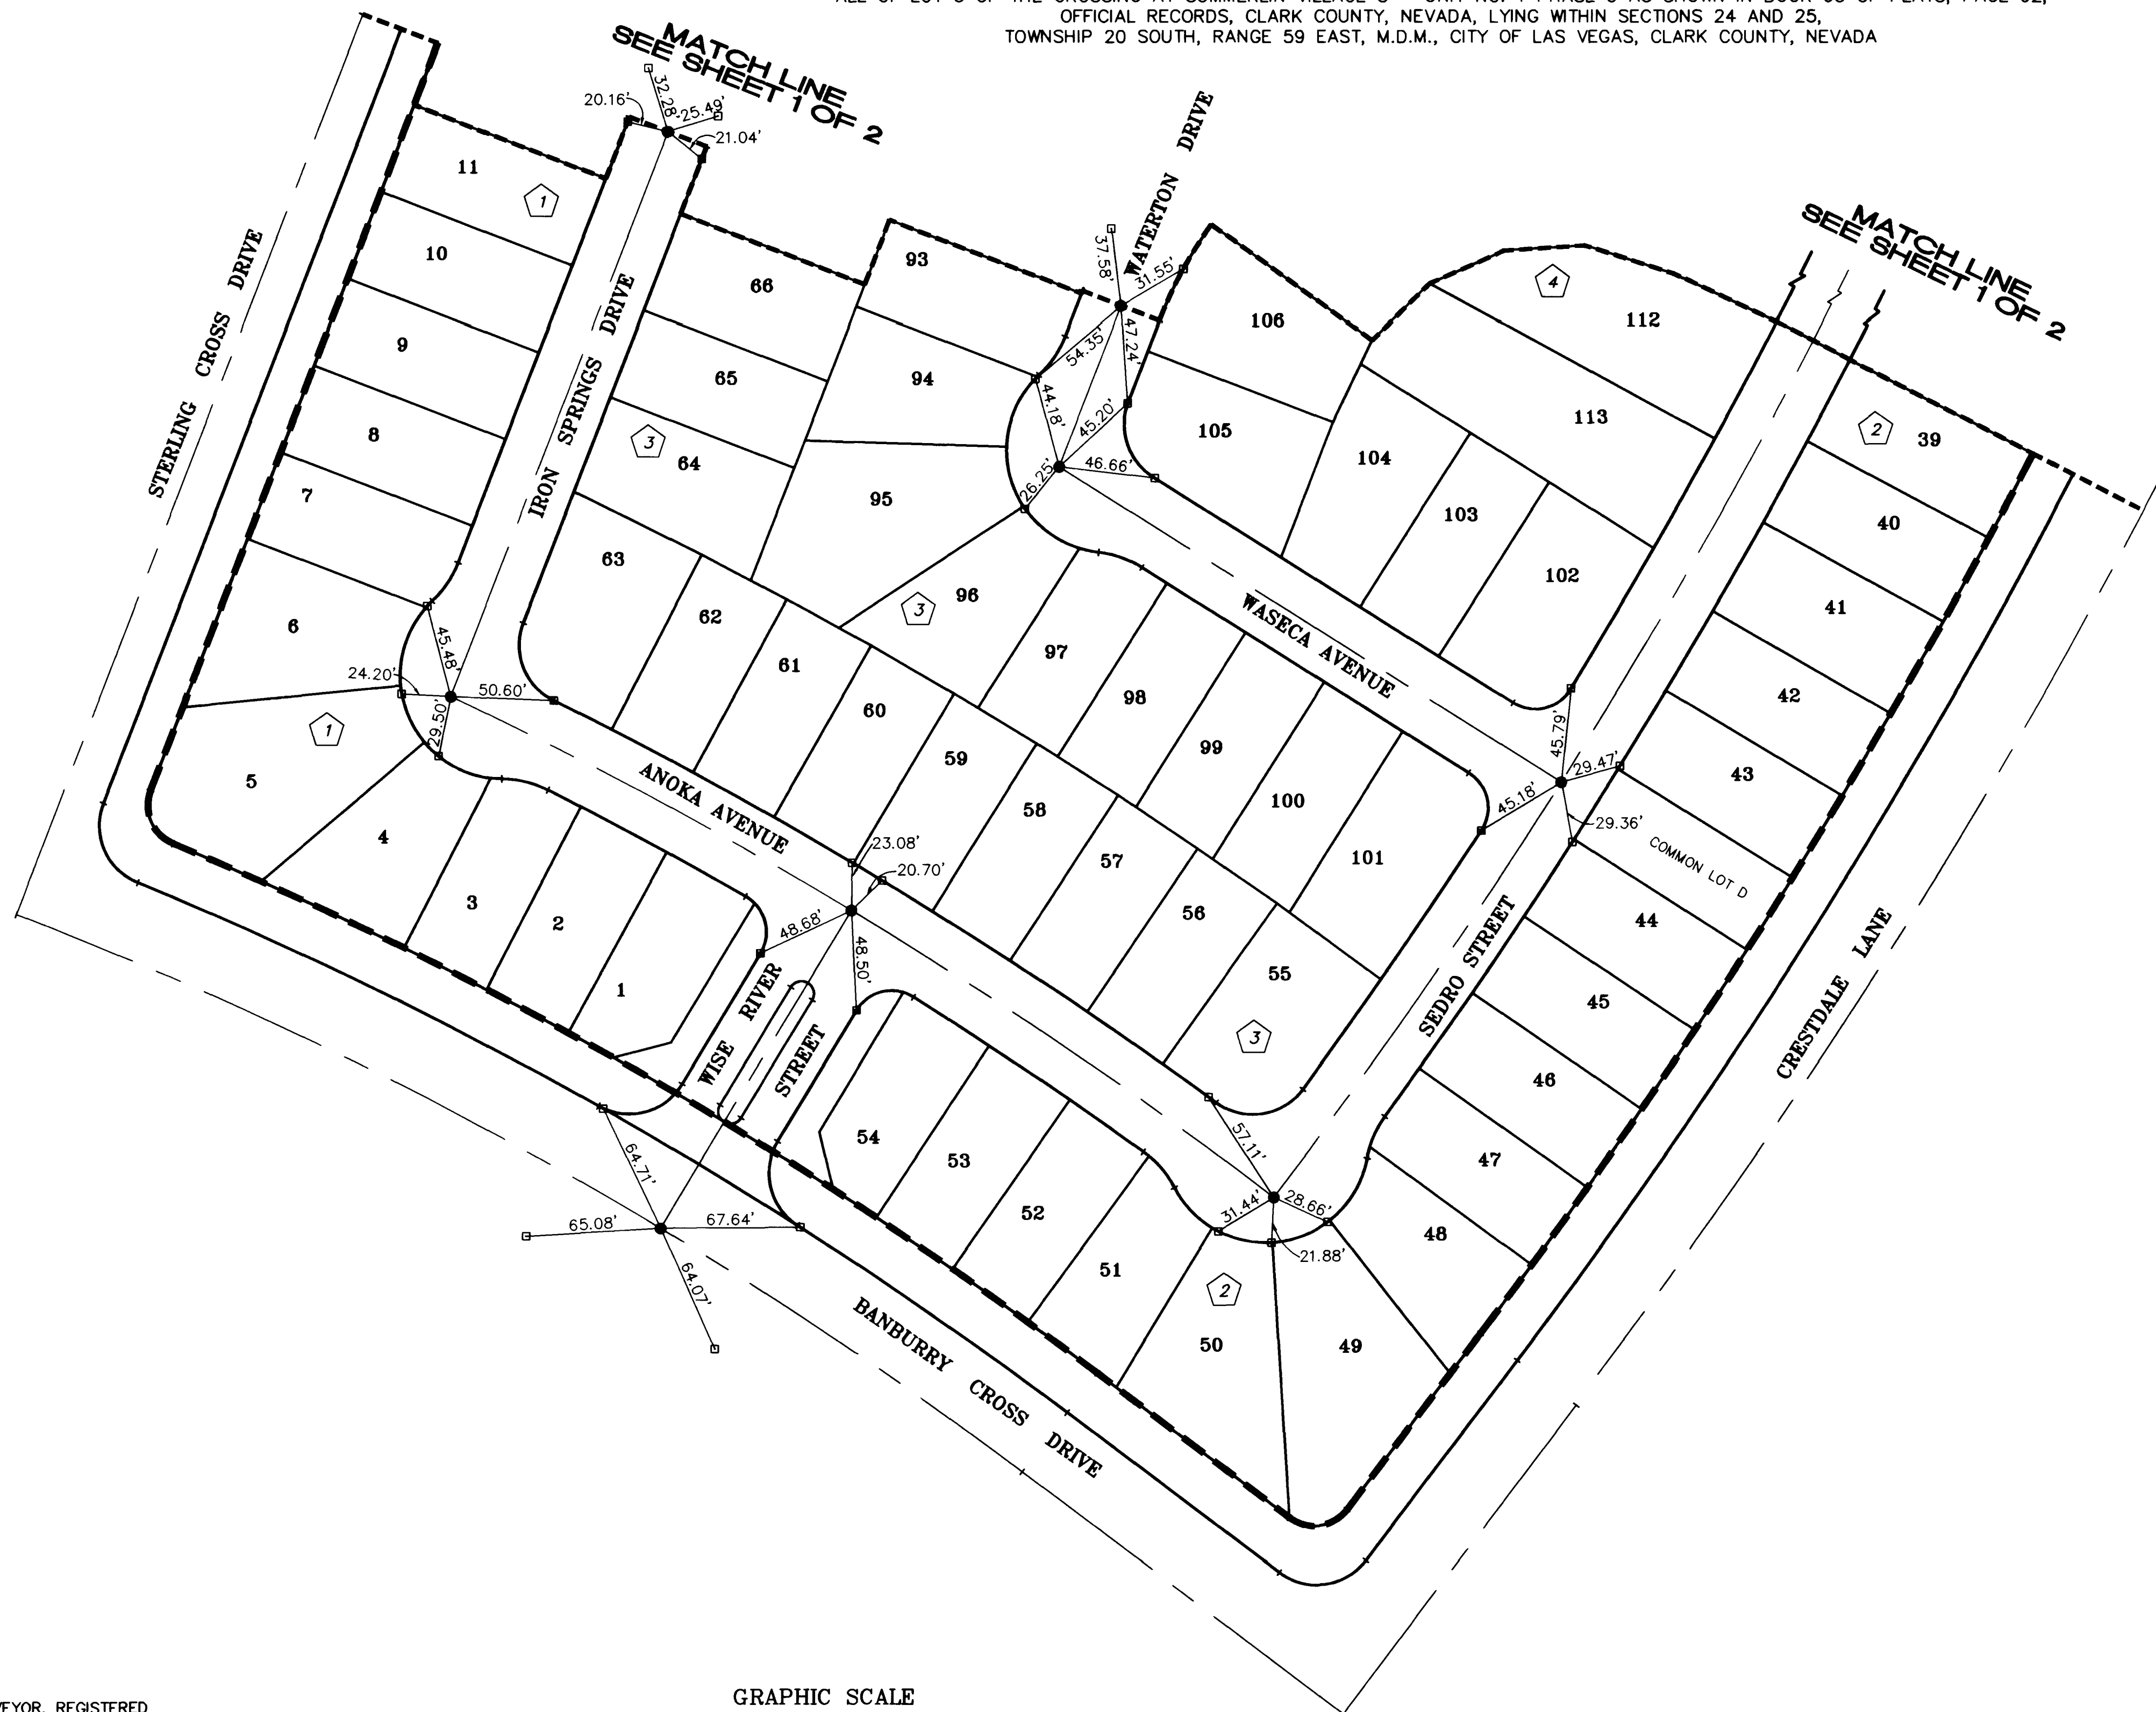

Job Number	51700	Sheet Number	2 OF 2	Drawn by	Scale	MONUMENT TIE MAP FOR HIGHLAND HILLS	 POST, BUCKLEY, SCHULH & JERNICAN 901 North Green Valley Hwy., Suite 100 Henderson, Nevada 89014 Telephone: 702/257-7255 Fax: 702/257-7260	No.	REVISIONS	Date/Init.	Appr.	Date
				Checked by	AS SHOWN							
				Date	700MT2	BOOK 68, PAGE 88 OF PLATS CITY OF LAS VEGAS CLARK COUNTY, NEVADA	ENGINEERING - PLANNING - SURVEYING - CONSTRUCTION SERVICES					
				APRIL 27, 1999								

