


INDIAN HILLS – UNIT 1

BEING A PORTION OF LOT 7 OF SUMMERLIN VILLAGE 7 – THE TRAILS UNIT NO. 3, BOOK 63 OF PLATS, PAGE 79,
LOCATED IN THE EAST HALF (E 1/2) OF SECTION 24, TOWNSHIP 20 SOUTH, RANGE 59 EAST, M.D.M.,
CITY OF LAS VEGAS, CLARK COUNTY, NEVADA.

MONUMENTATION TIE MAP

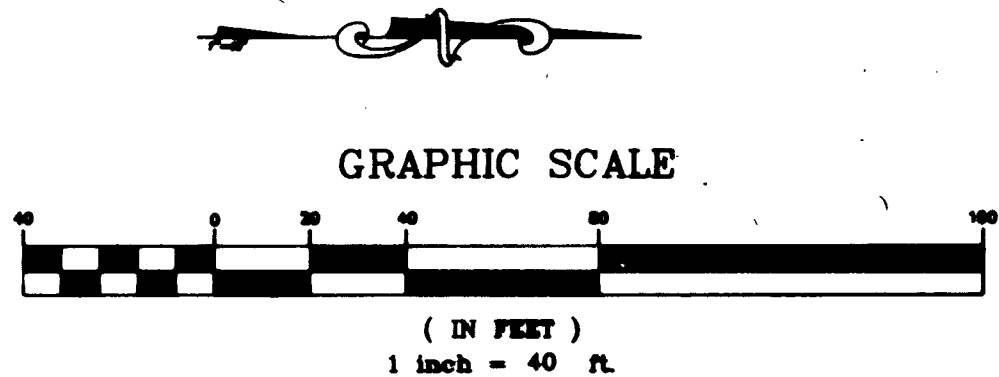


I, STEPHEN P. GURLIDES, A PROFESSIONAL LAND SURVEYOR IN THE STATE OF NEVADA, DO HEREBY CERTIFY THAT THE MONUMENTS HAVE BEEN SET AND THE TIE DISTANCE ESTABLISHED AS SHOWN HEREON. THIS SURVEY WAS COMPLETED ON

STEPHEN P. GURLIDES
NEVADA CERTIFICATION NO. 9105

8-13-99

LEGEND

- 15 LOT NUMBER / RESIDENTIAL = 78
COMMON ELEMENT LOT = 3
TOTAL = 81
- 2 BLOCK NUMBER
- R1 RADIAL LINE NUMBER
- L3 COURSE NUMBER
- C2 CURVE NUMBER
- FOUND MONUMENT AS DESCRIBED
- SET REBAR WITH AL. CAP - "VTN PLS 9105"
- SET NAIL & BRASS TAG "PLS 8421" OR SAWCUT TOP OF CURB ON PROLONGATION OF PROPERTY LINES, PER NOTE 1
- P.U.E. PUBLIC UTILITY EASEMENT
- S.F. SQUARE FEET
- CENTERLINE
- LOT LINE
- BOUNDARY LINE
- 4' PEDESTRIAN ACCESS CORRIDOR EASEMENT
- SIGHT VISIBILITY RESTRICTION EASEMENT AREA - ARE PUBLIC EASEMENTS AND AS SUCH THE HEIGHT OF LANDSCAPING OR PHYSICAL IMPROVEMENTS WITHIN THE EASEMENT AREA ARE RESTRICTED TO A MAXIMUM HEIGHT OF 30 INCHES.

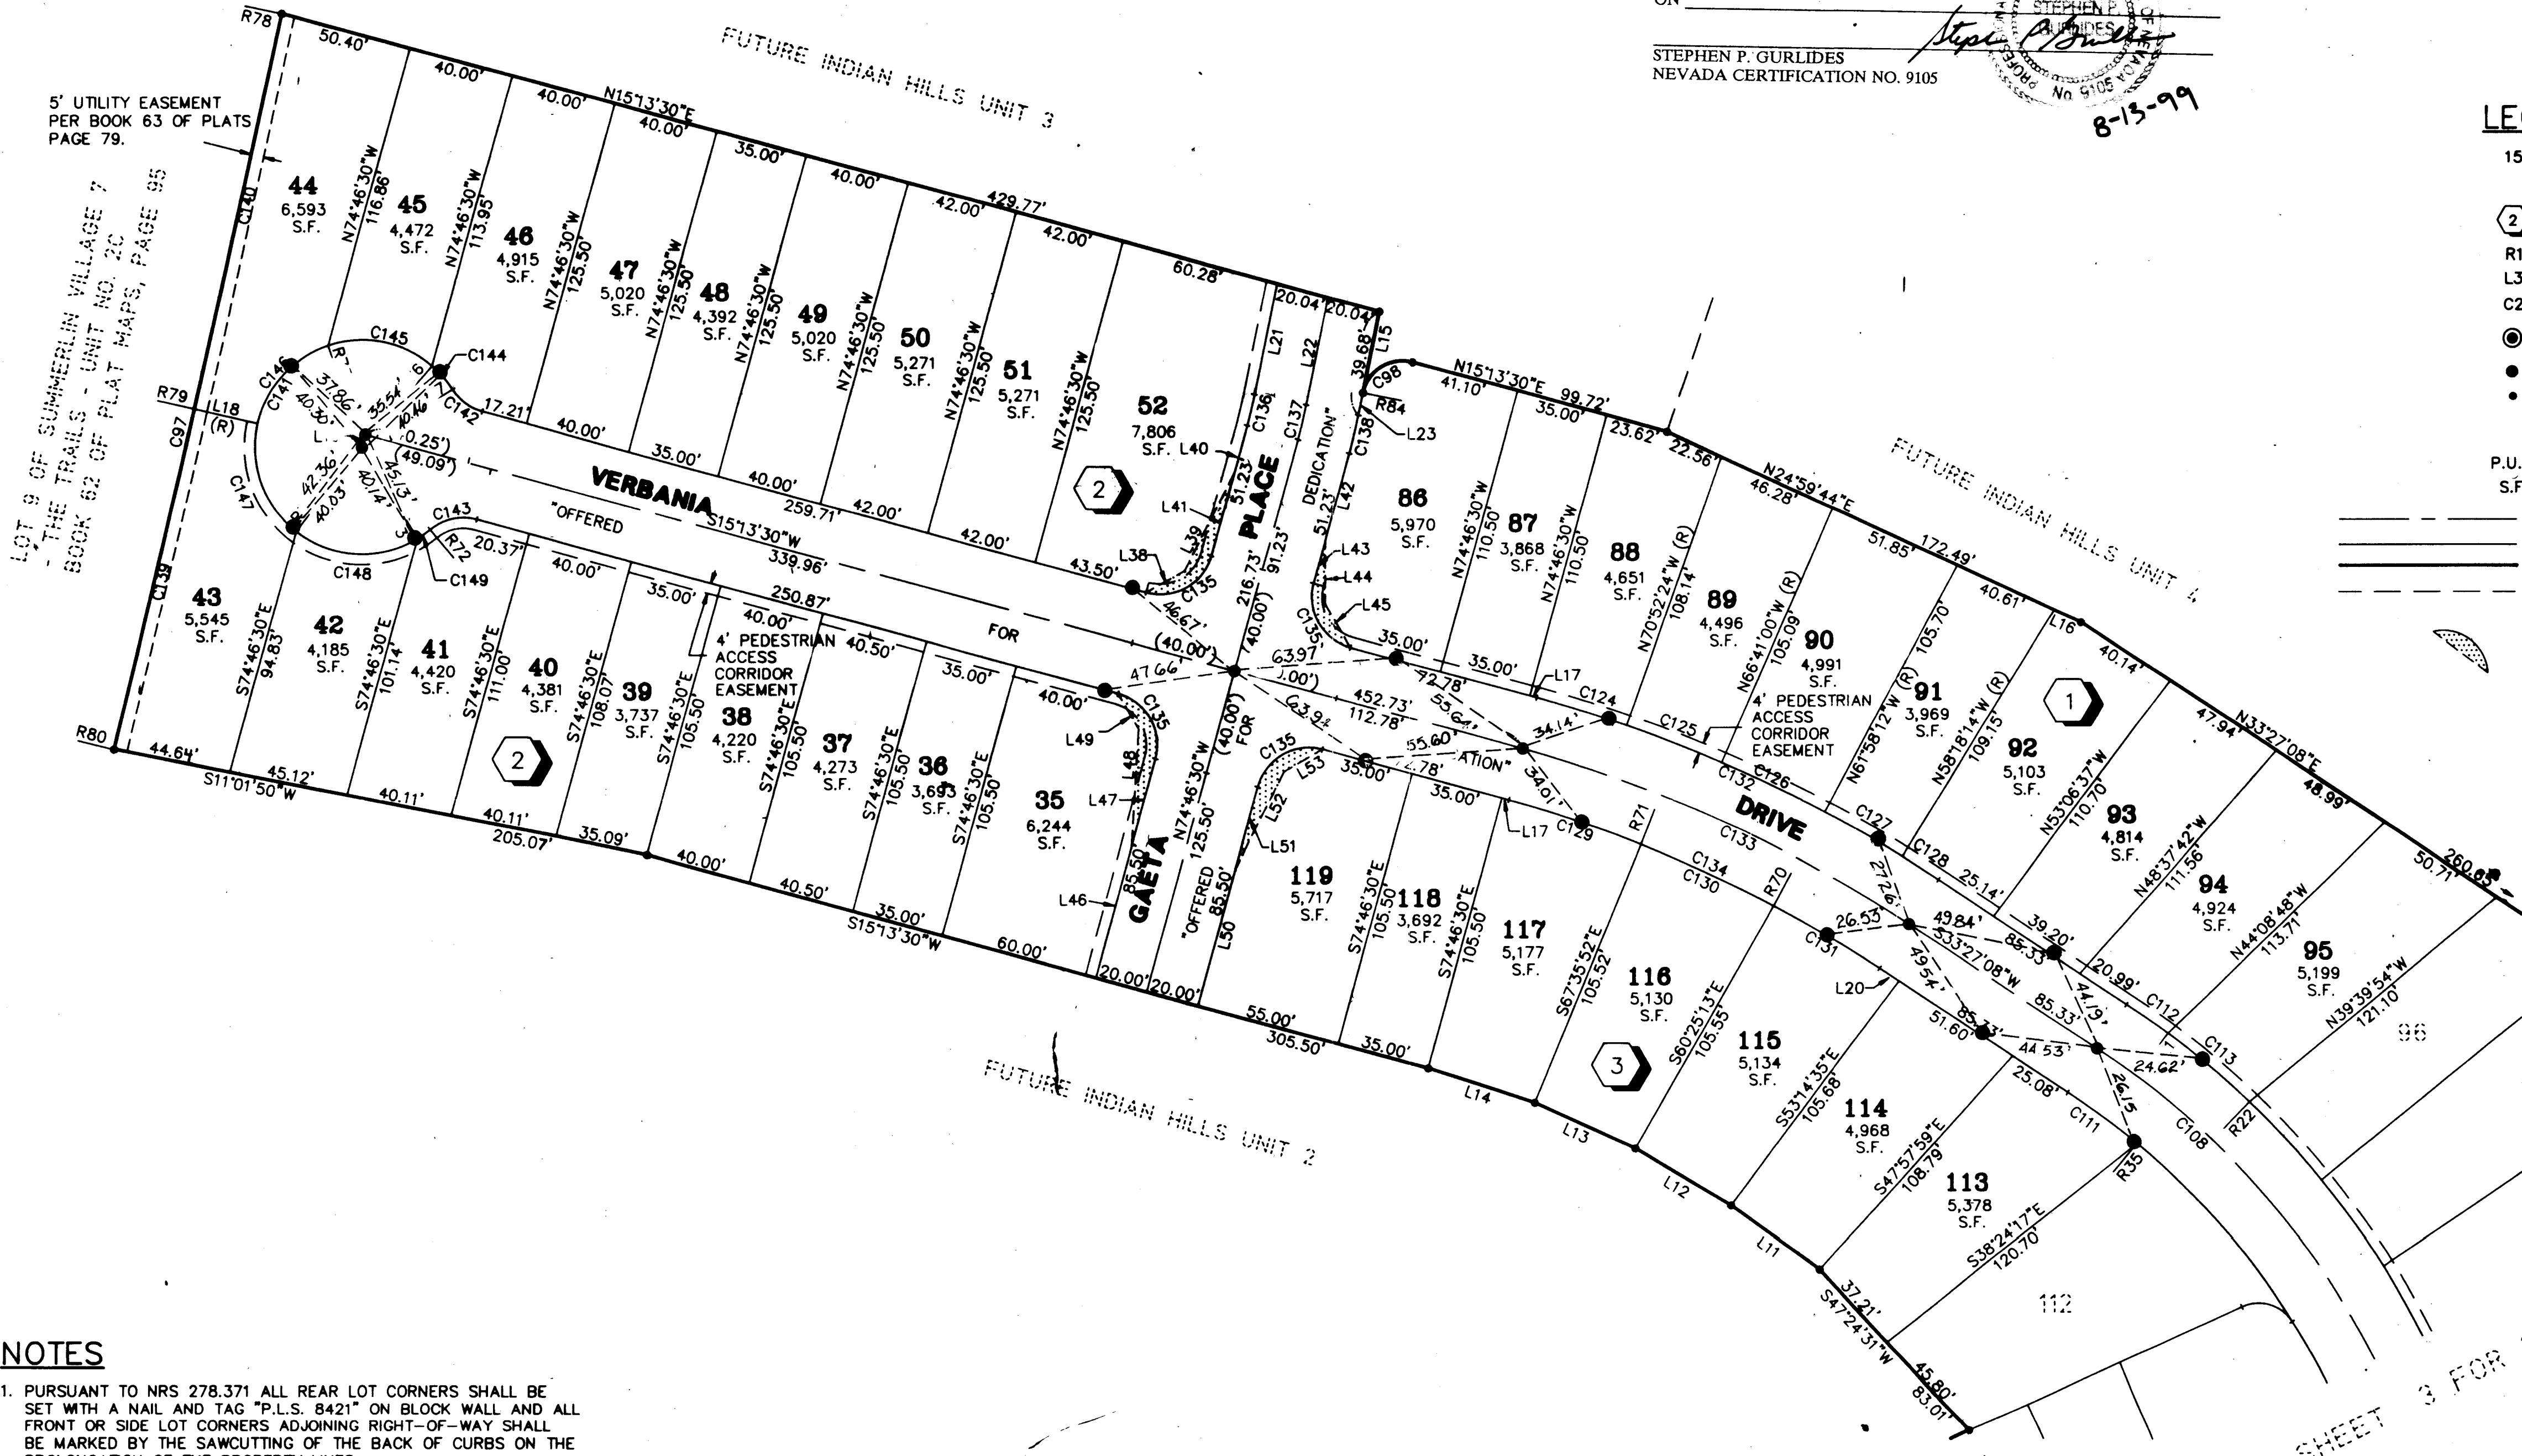

NOTES

- PURSUANT TO NRS 278.371 ALL REAR LOT CORNERS SHALL BE SET WITH A NAIL AND TAG "P.L.S. 8421" ON BLOCK WALL AND ALL FRONT OR SIDE LOT CORNERS ADJOINING RIGHT-OF-WAY SHALL BE MARKED BY THE SAWCUTTING OF THE BACK OF CURBS ON THE PROLONGATION OF THE PROPERTY LINES.
- DIRECT VEHICULAR ACCESS TO TRAIL HOLLOW DRIVE, AND TRAIL WOOD DRIVE THROUGH COMMON AREA FROM ADJUTING LOTS IS PROHIBITED.
- SEE SHEET 5 OF 5 FOR CURVE, COURSE, AND RADIAL LINE TABLES.
- ALL COMMON ELEMENT LOTS ARE TO BE MAINTAINED BY THE HOME OWNER'S ASSOCIATION.

ACT	DATE	BY	REVISION
2	4/27/95	TE	REVISED R78, 79, 80 - C97, 132, 140 - L18
1	4/14/95	VCL	ADDED C.E. LOT F, SVRE, & 4' SIDEWALK EASEMENT

W.O. 4820-1
SHEET 4 OF 5
VCL

05B-4410-1

