


951206

00775

INDIAN HILLS - UNIT 5

BEING A PORTION OF LOT 7 OF SUMMERLIN VILLAGE 7 - THE TRAILS UNIT NO. 3, BOOK 63 OF PLATS, PAGE 79,
LOCATED IN THE EAST HALF (E 1/2) OF SECTION 24, TOWNSHIP 20 SOUTH, RANGE 59 EAST, M.D.M.,
CITY OF LAS VEGAS, CLARK COUNTY, NEVADA.

MONUMENT TIE MAP

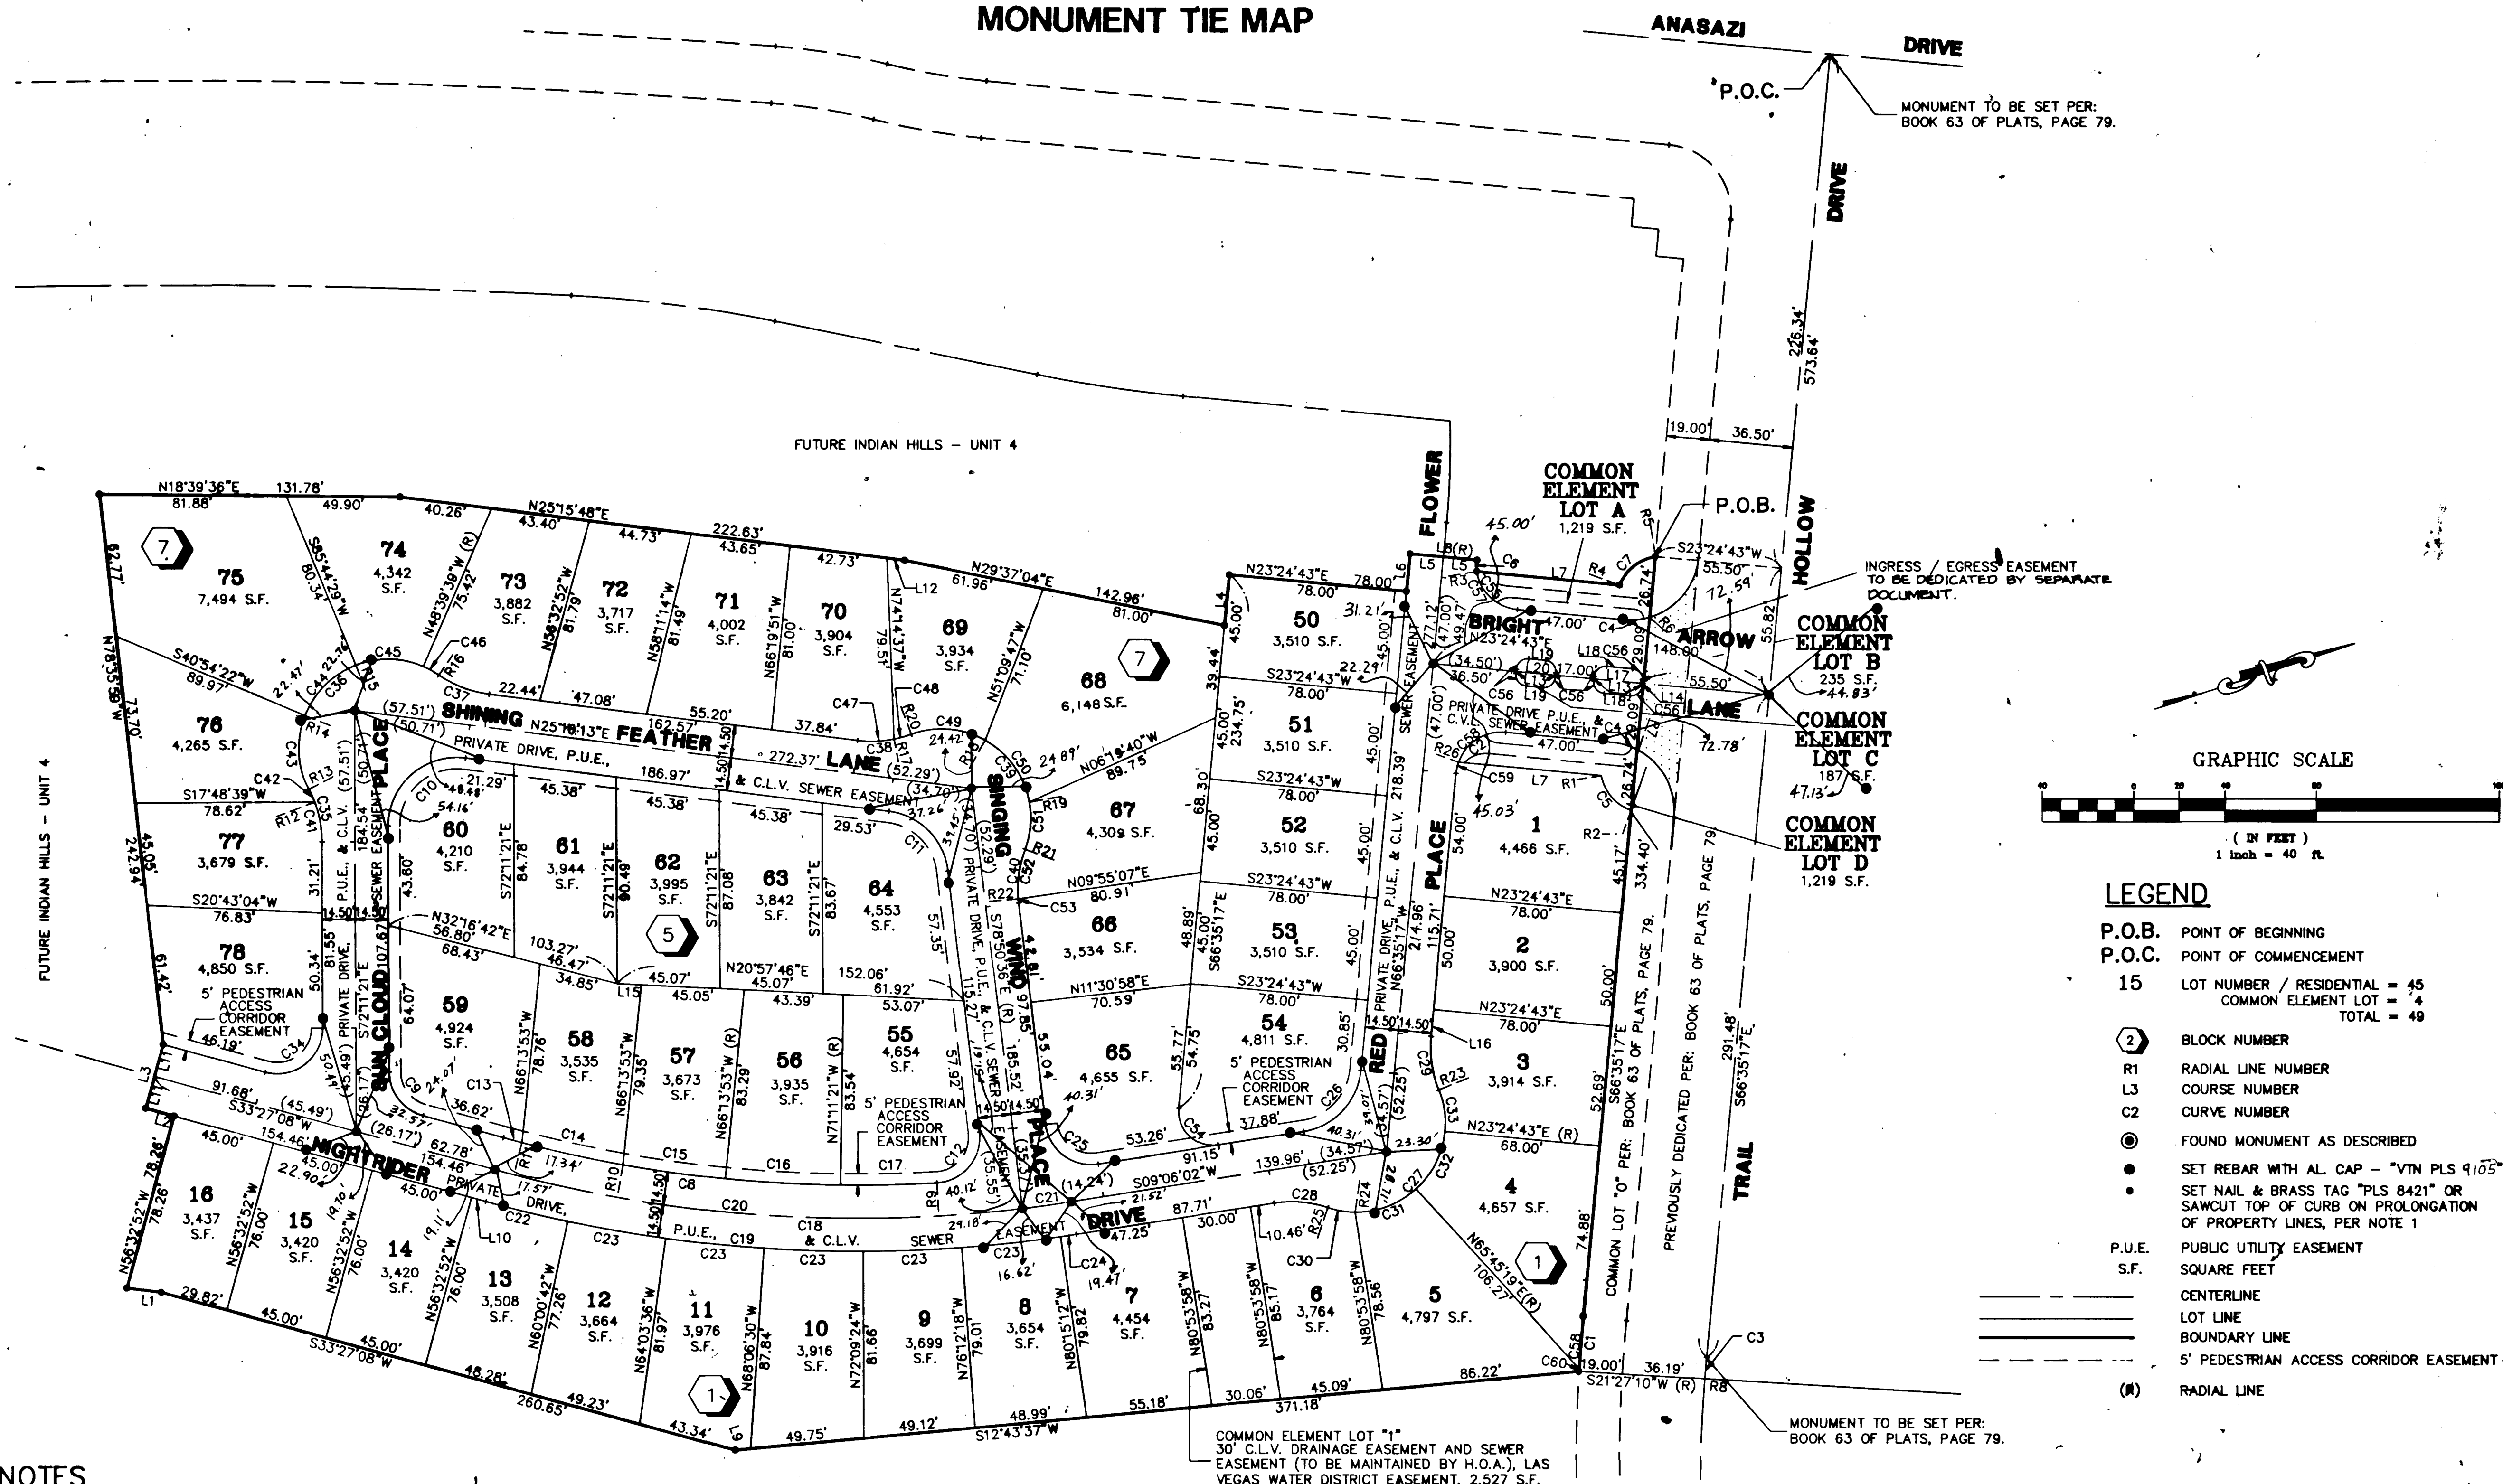

NOTES

- PURSUANT TO NRS 278.371 ALL REAR LOT CORNERS SHALL BE SET WITH A NAIL AND TAG "P.L.S. 8421" ON BLOCK WALL AND ALL FRONT OR SIDE LOT CORNERS ADJOINING RIGHT-OF-WAY SHALL BE MARKED BY THE SAWCUTTING OF THE BACK OF CURBS ON THE PROLONGATION OF THE PROPERTY LINES.
- DIRECT VEHICULAR ACCESS TO TRAIL HOLLOW DRIVE DRIVE THROUGH COMMON AREA FROM ADJUTING LOTS IS PROHIBITED.
- SEE SHEET 4 OF 4 FOR CURVE, COURSE, AND RADIAL LINE TABLES.
- ALL COMMON ELEMENT LOTS, STREETS, AND PUBLIC DRAINAGE EASEMENTS TO BE MAINTAINED BY HOME OWNERS ASSOCIATION.

INDIAN HILLS UNIT - 1 BOOK 69 OF PLATS, PAGE 12.

I, STEPHEN P. GURLIDES, A PROFESSIONAL LAND SURVEYOR IN THE STATE OF NEVADA, DO HEREBY CERTIFY THAT THE MONUMENTS HAVE BEEN SET AND THE TIE DISTANCE ESTABLISHED AS SHOWN HEREON. THIS SURVEY WAS COMPLETED ON

STEPHEN P. GURLIDES
NEVADA CERTIFICATION NO. 9105

ACT	DATE	BY	REVISION
4	8/15/95	T.H.	CLV SURVEY CORRECTIONS
3	8/1/95	T.H.	REV. BNDY, ENTRANCE, MOVED 9' WEST; AND REV LOT 1
2	7/7/95	T.H.	REV. BNDY, ENTRANCE, MOVED 10' WEST; AND REV LOTS 5-16
1	6/16/95	VCL	ADDED 4.33' LANDSCAPE EASEMENT

14148


W.O. 4820-5
SHEET 3 OF 5
VCL/T.H.

058-4410-5

INDIAN HILLS - UNIT 5

BEING A PORTION OF LOT 7 OF SUMMERLIN VILLAGE 7 - THE TRAILS UNIT NO. 3, BOOK 63 OF PLATS, PAGE 79,
LOCATED IN THE EAST HALF (E 1/2) OF SECTION 24, TOWNSHIP 20 SOUTH, RANGE 56 EAST, M.D.M.,
CITY OF LAS VEGAS, CLARK COUNTY, NEVADA.

MONUMENT TIE MAP

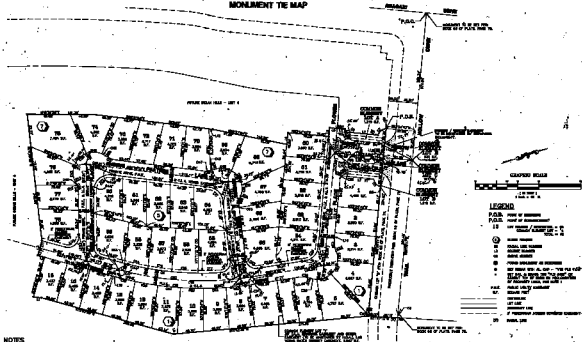

NOTES

