


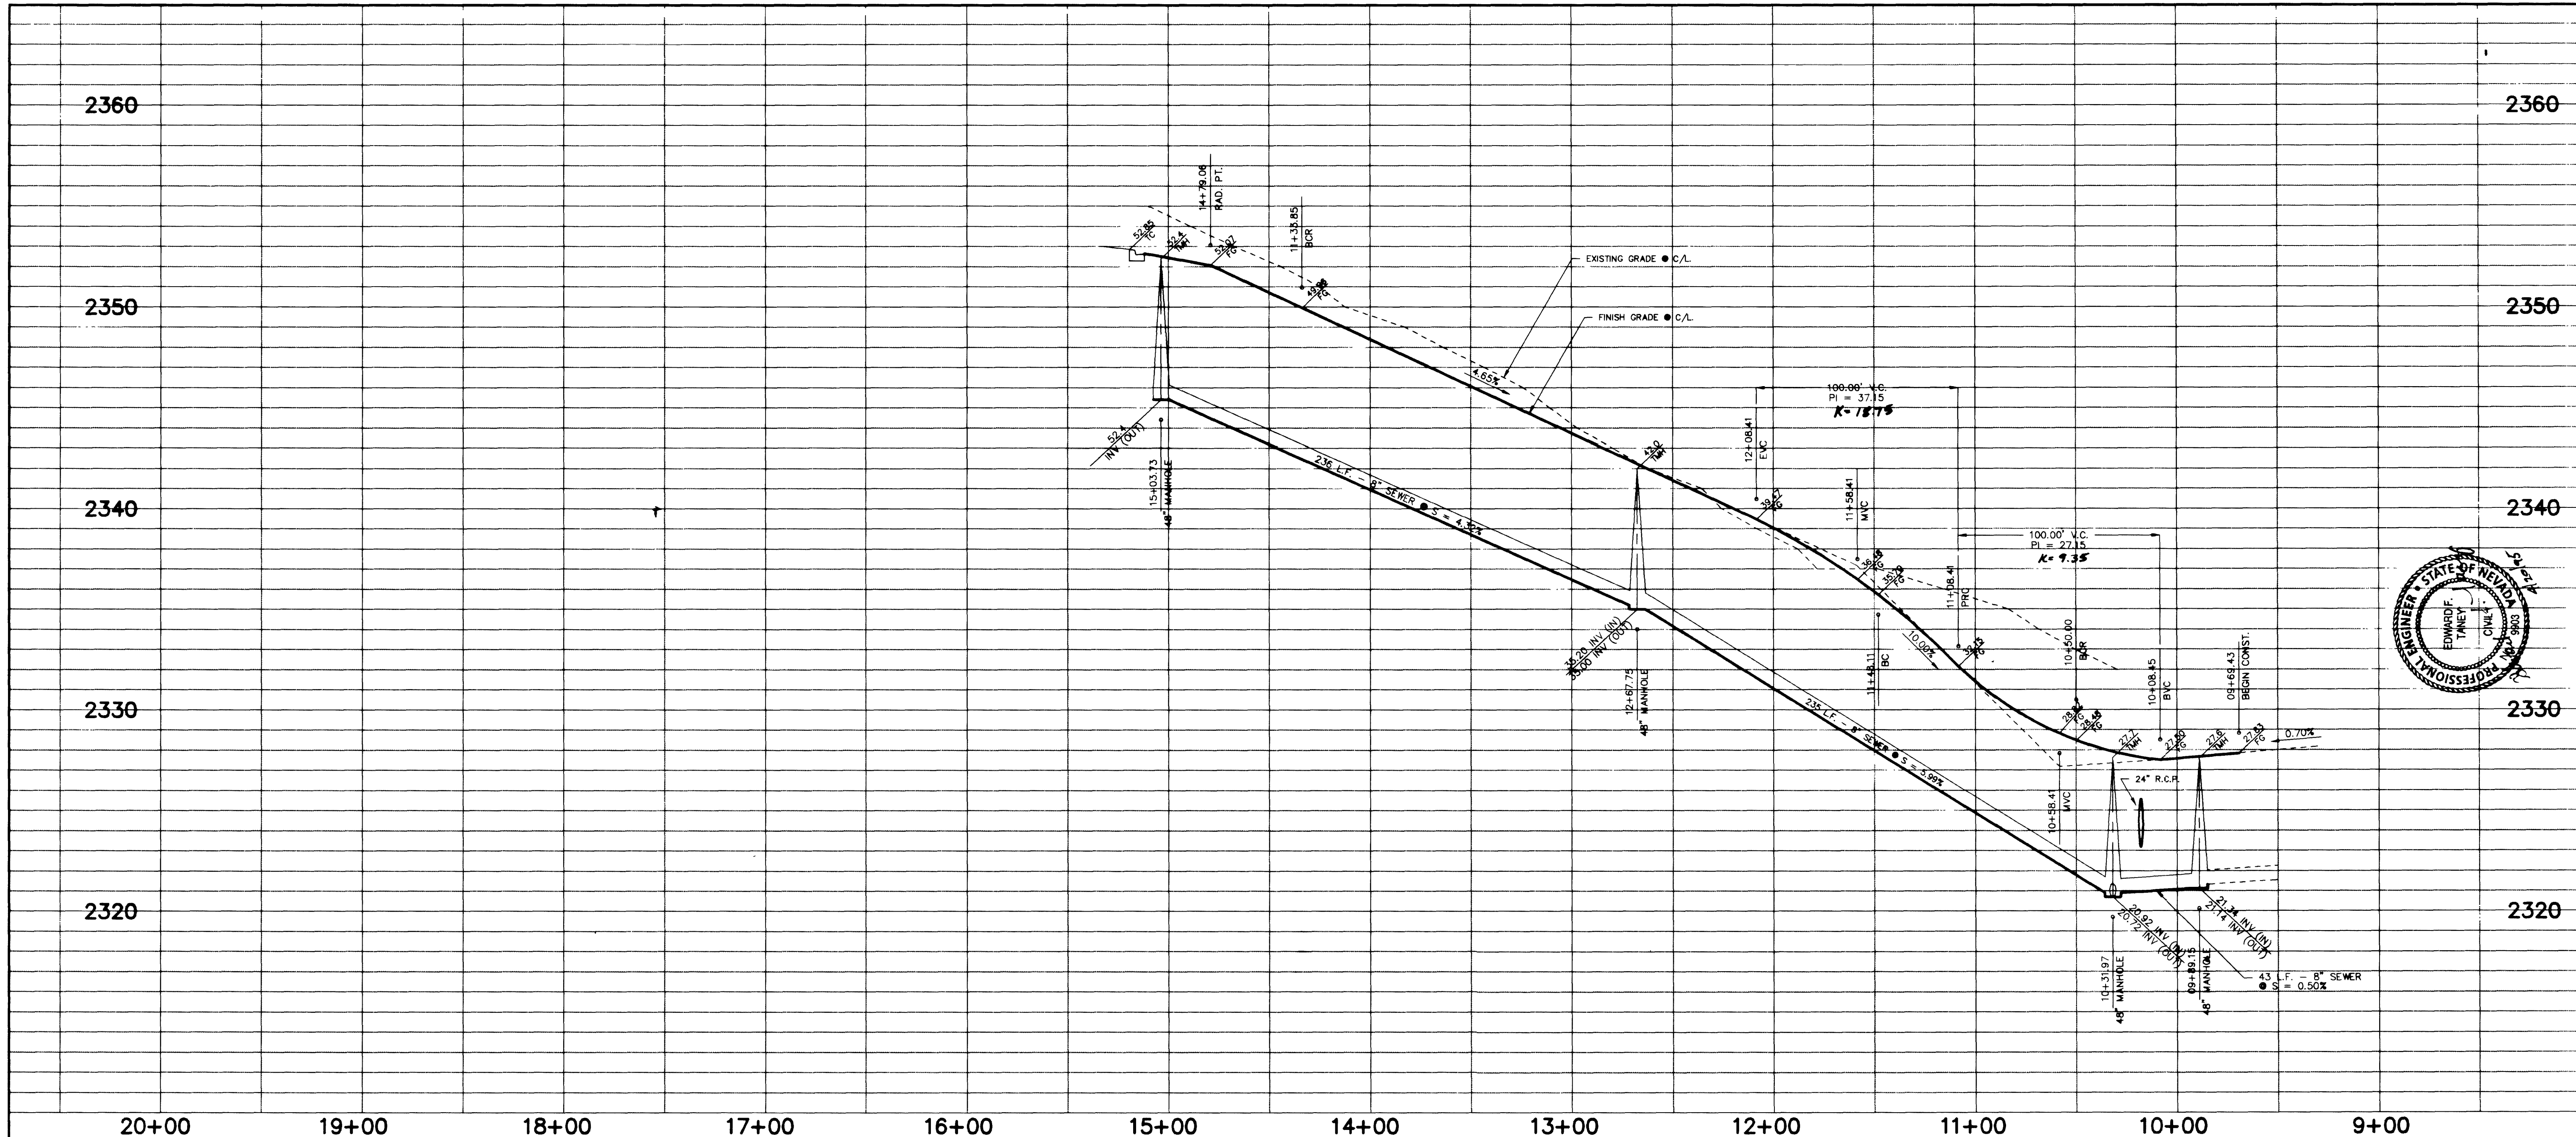

**BCR & CURVE DATA
AT BACK OF CURB**


No.	RADIUS	DELTA	LENGTH	TANGENT
C1	5159.57	00°49'43"	74.73	37.37
C2	5159.57	00°40'06"	60.18	30.09
C3	50.00	90°00'00"	78.54	50.00
C4	70.00	90°00'00"	109.96	70.00
C5	5119.57	00°50'19"	74.92	37.48
C6	5119.57	00°45'49"	68.22	34.11
C7	35.00	90°00'00"	47.12	30.00
C8	5139.57	03°41'29"	330.95	165.33
C9	40.50	80°38'19"	57.00	34.37
C10	40.50	80°42'54"	42.92	23.72
C11	40.50	64°54'18"	43.98	25.15
C12	40.50	70°57'50"	50.18	28.87
C13	5159.57	00°52'48"	4.21	2.10
C14	5159.57	00°48'38"	71.00	36.50
C15	20.00	23°29'31"	8.20	4.18
C16	20.00	25°22'21"	1.88	4.50
C17	20.00	48°21'37"	16.88	8.98
C18	5119.57	00°44'27"	66.20	33.10

LINE DATA TABLE

No.	BEARING	DISTANCE
L1	N84°16'23"W	8.11
L2	N84°16'23"W	3.52

QUANTITY ESTIMATES THIS SHEET

2" ASPHALTIC CONCRETE PAVEMENT	2,005 S.Y.
30" ROLL-TYPE CURB & GUTTER	1,000 L.F.
SIDEWALK	4,030 S.F.
8" SEWER	514 L.F.
48" MANHOLE	4 EA.

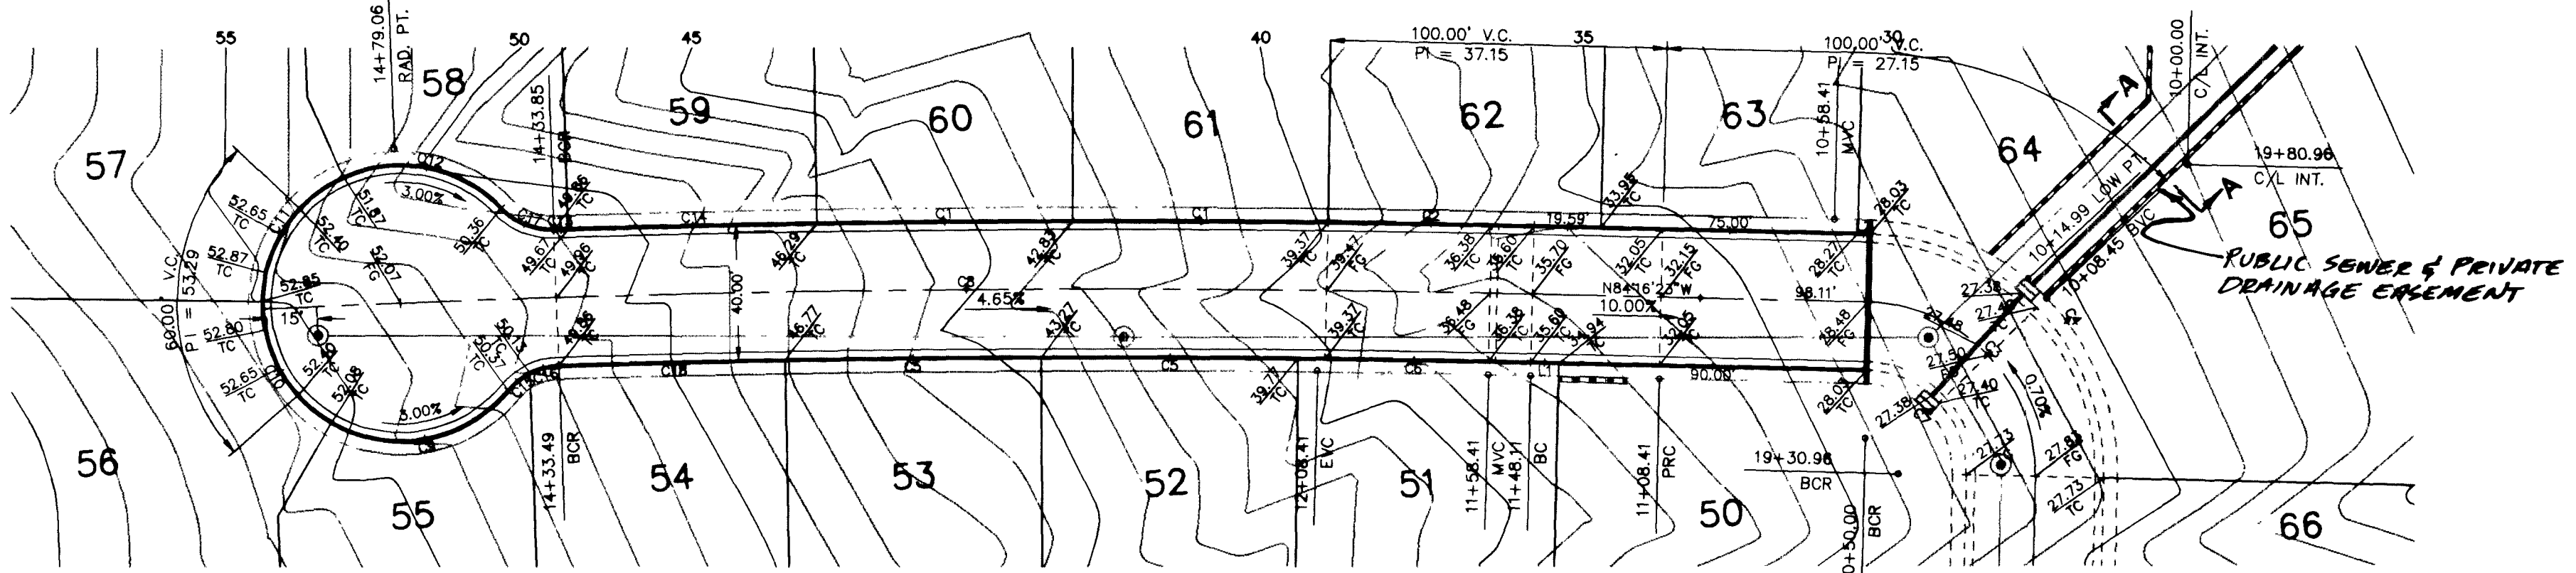

ANGEL PEAK COURT

(SEE SUMMERLIN STD. DETAIL S-8)

NOTICE
EXISTING UTILITIES ARE SHOWN ON PLANS FOR THE CONVI-
NIENCE OF THE CONTRACTOR
ONLY. THE CONTRACTOR IS
RESPONSIBLE FOR THE PRO-
TECTION OF ALL UTILITIES.
THE ENGINEER BEARS NO RES-
PONSIBILITY FOR UTILITIES NOT
SHOWN OR SHOWN INCORRECTLY.

**BEFORE YOU
DIG**
1-800-227-2800
UNDERGROUND SERVICE (USA)

STREET & SEWER PLAN & PROFILE
ANGEL PEAK COURT
HIGHPOINTE AT SUMMERLIN
UNIT 2

JOB # N4-76-15
NAME VERTICES/MRA
DATE 12-13-94
SCALE 1" = 40'
PAGE 5

11-17-90 107Y-4364-2

