


Call
before you
Dig
1-800-227-2600

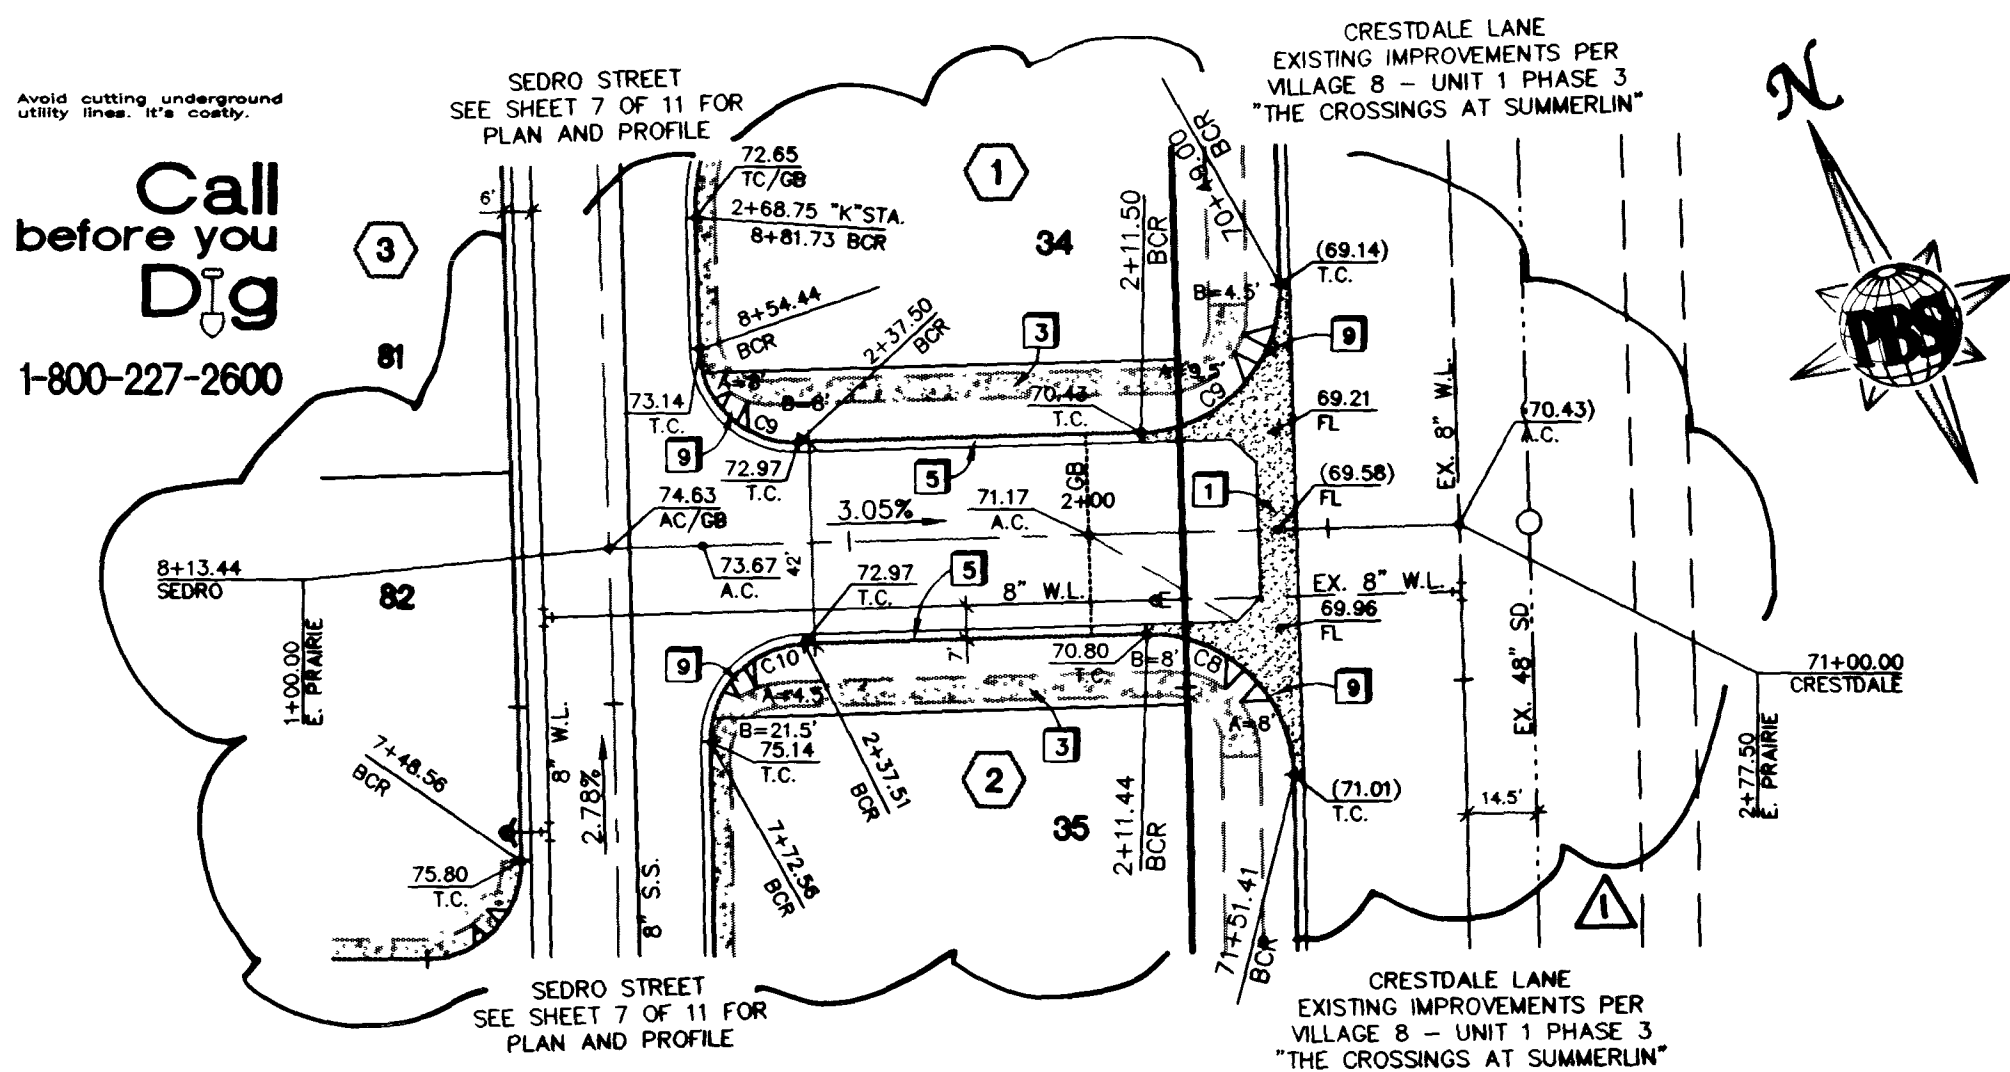


EDEN PRAIRIE AVE. - PLAN VIEW
HORIZONTAL SCALE: 1" = 40'

CONSTRUCTION NOTES


1. CONSTRUCT 8" CONCRETE VALLEY GUTTER PER SUMMERLIN IMPROVEMENT STANDARD DWG. NO. S-64.
2. CONSTRUCT SIDEWALK RAMP (CASE 1) PER SUMMERLIN IMPROVEMENT STANDARD DWG. NO. S-77. (TRANSITION LENGTHS A & B SHOWN ON PLAN, 2'-3.5').
3. CONSTRUCT 5' WIDE CONCRETE SIDEWALK PER SUMMERLIN IMPROVEMENT STANDARD DWG. NO. S-72.
4. CONSTRUCT 4' WIDE CONCRETE SIDEWALK PER SUMMERLIN IMPROVEMENT STANDARD DWG. NO. S-72.
5. CONSTRUCT "T" TYPE CURB & GUTTER PER SUMMERLIN IMPROVEMENT STANDARD DWG. NO. S-47.
9. CONSTRUCT SIDEWALK RAMP PER SUMMERLIN STANDARD DWG. NO. S-75.
10. 0 INCH DRIVEWAY REQUIRED.

GENERAL NOTES


1. ALL STATIONING IS CENTERLINE STATIONING UNLESS OTHERWISE NOTED.
2. SEWER LENGTHS ARE FROM CENTER OF MANHOLE TO CENTER OF MANHOLE.
3. "K" STA. INDICATES KNUCKLE STATIONING AT BACK OF CURB.

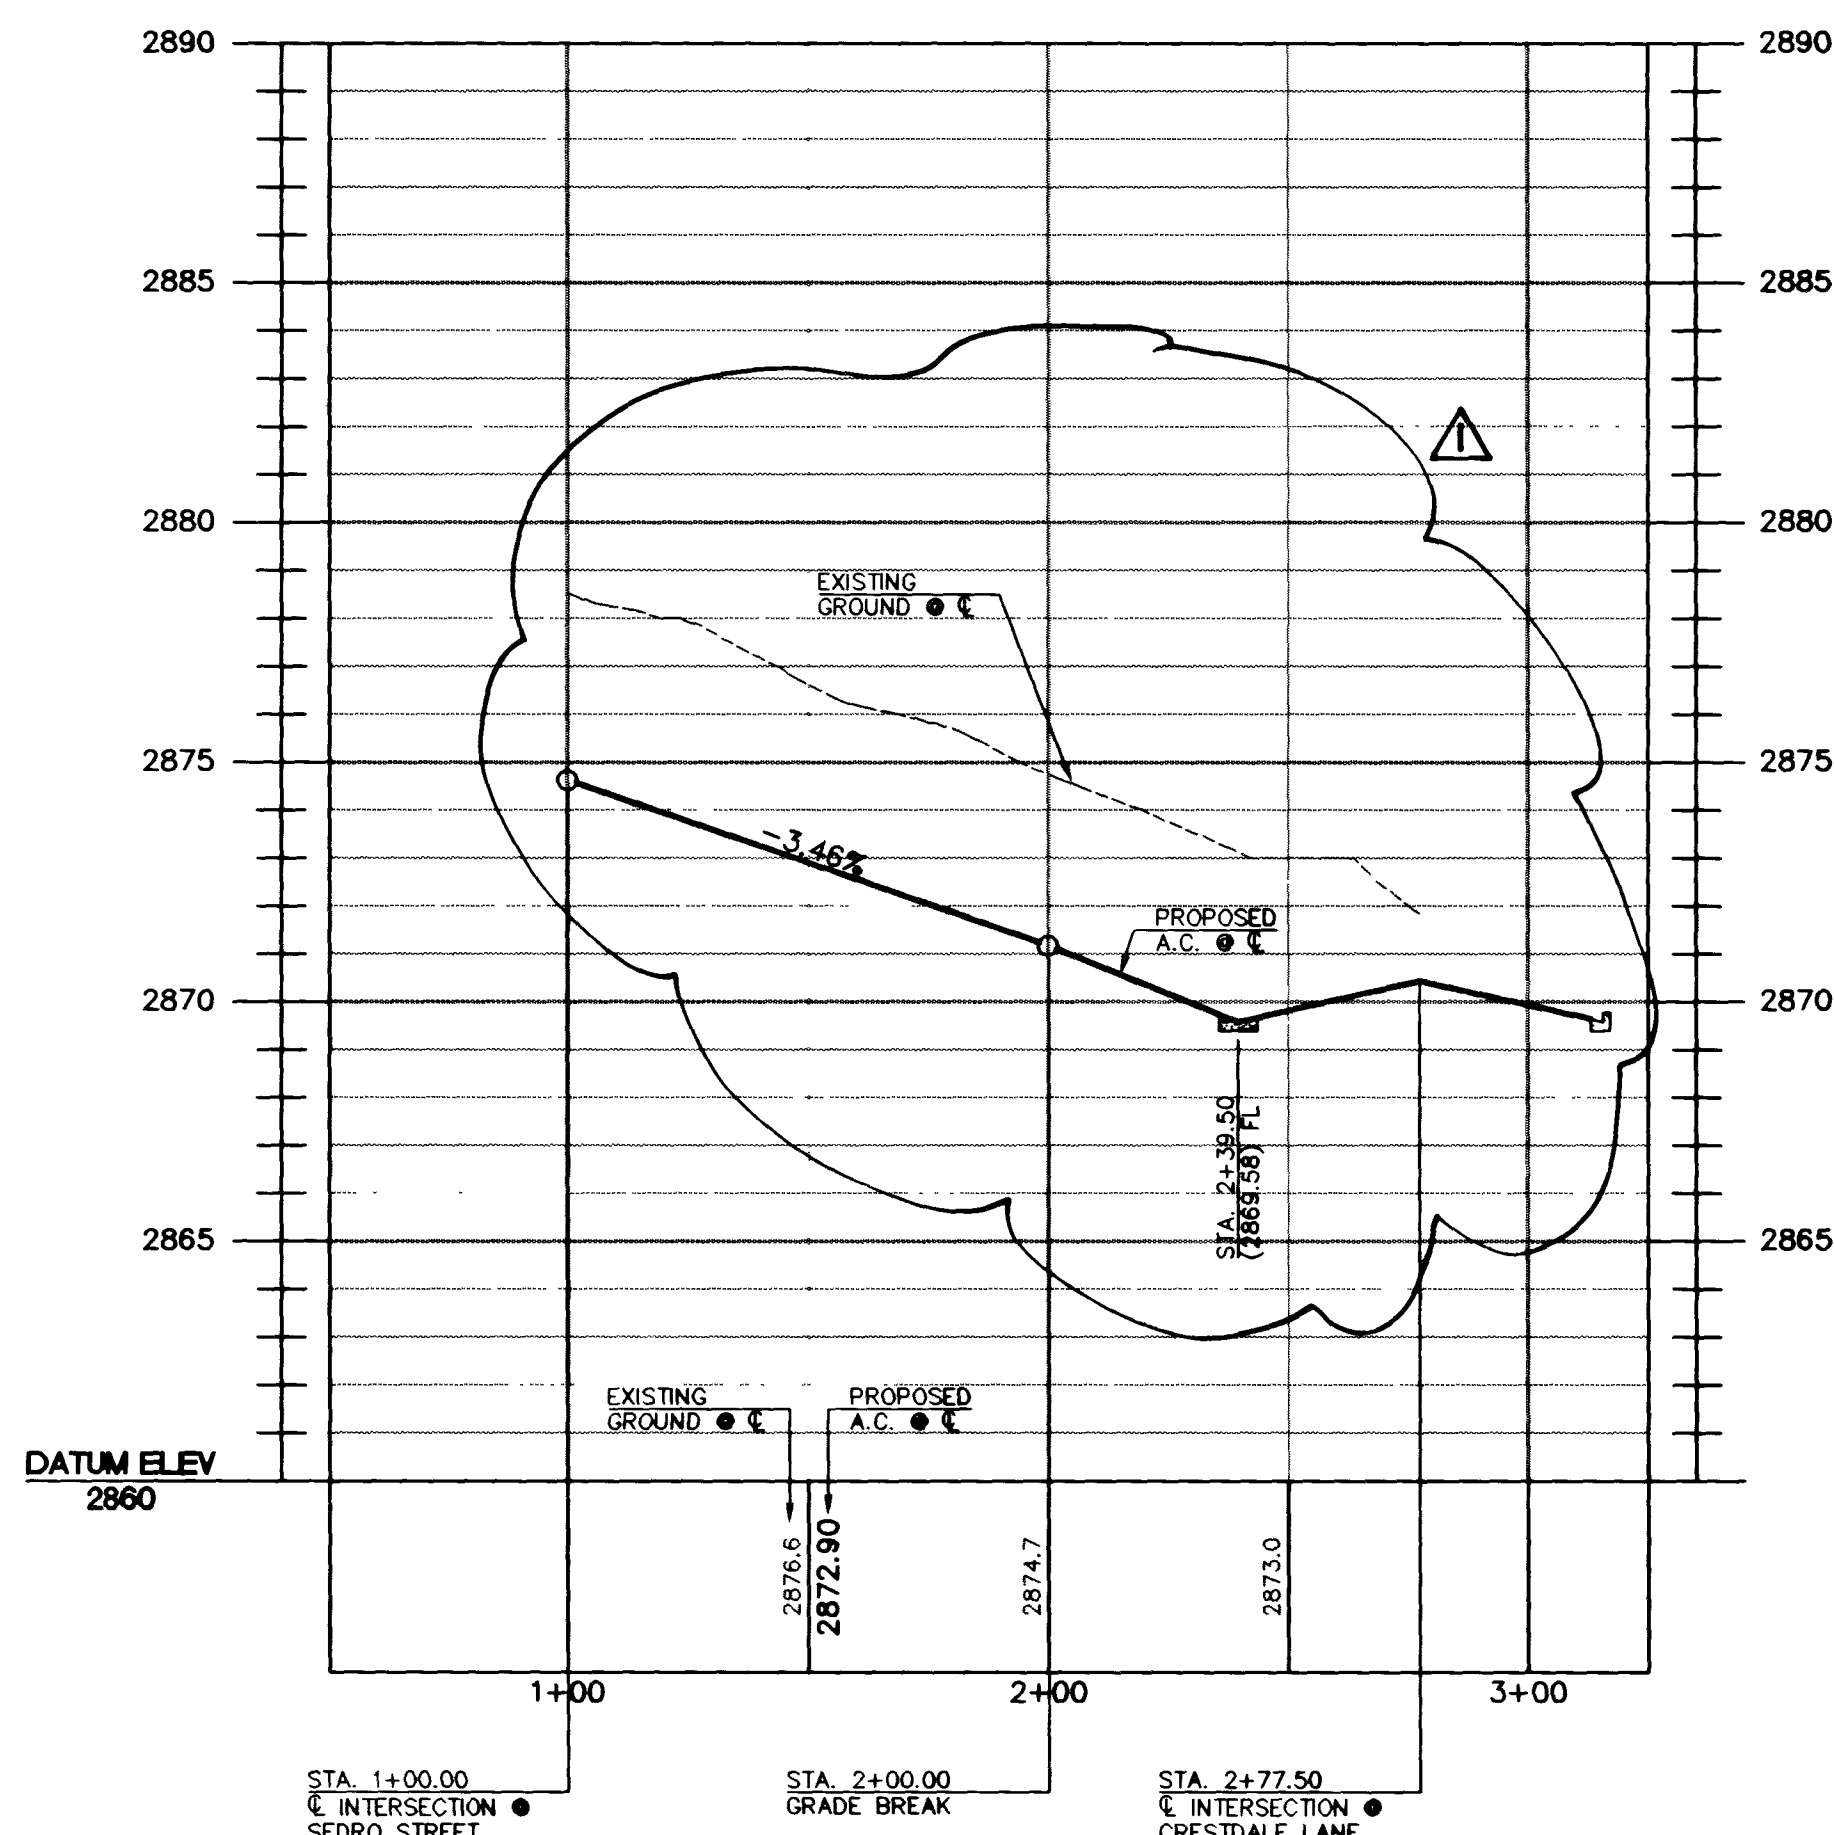

EDEN PRAIRIE AVE. - PROFILE
HORIZONTAL SCALE: 1" = 40'
VERTICAL SCALE: 1" = 4'

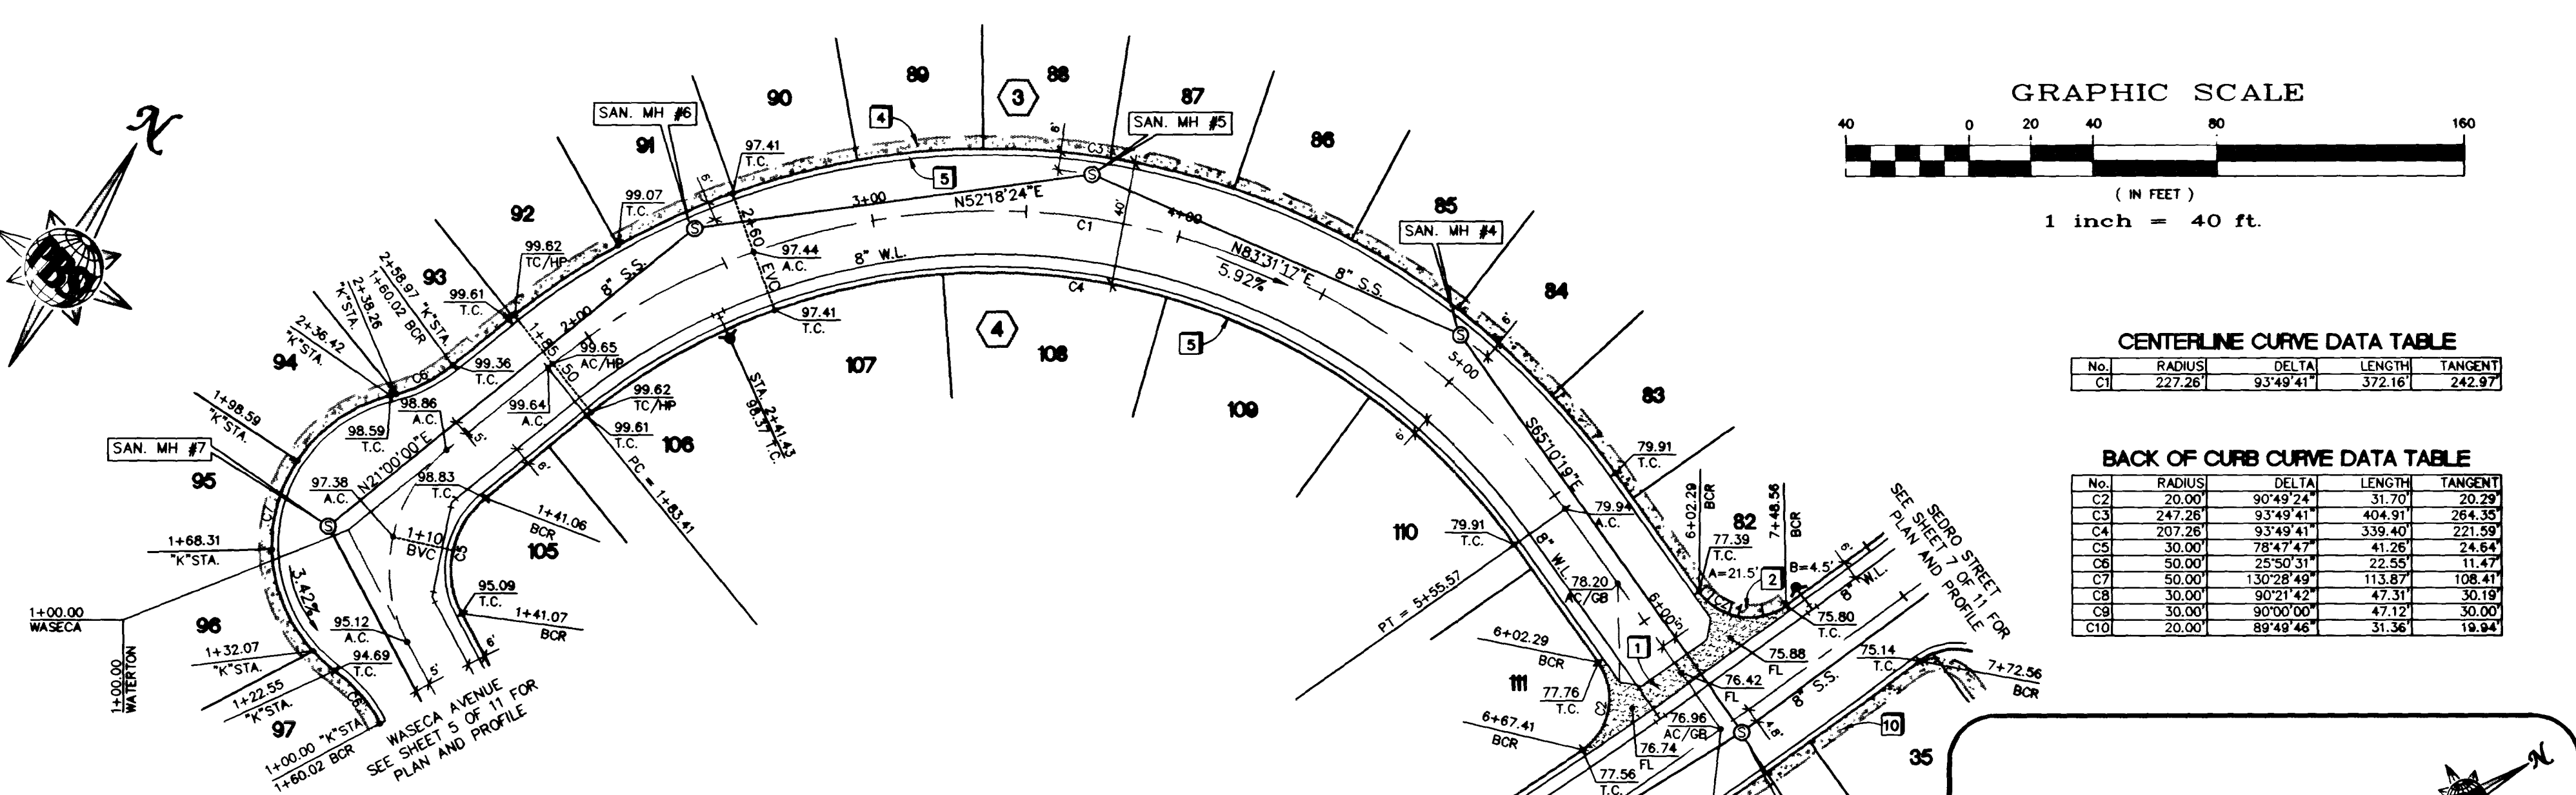


WATERTON DRIVE - PLAN VIEW
HORIZONTAL SCALE: 1" = 40'

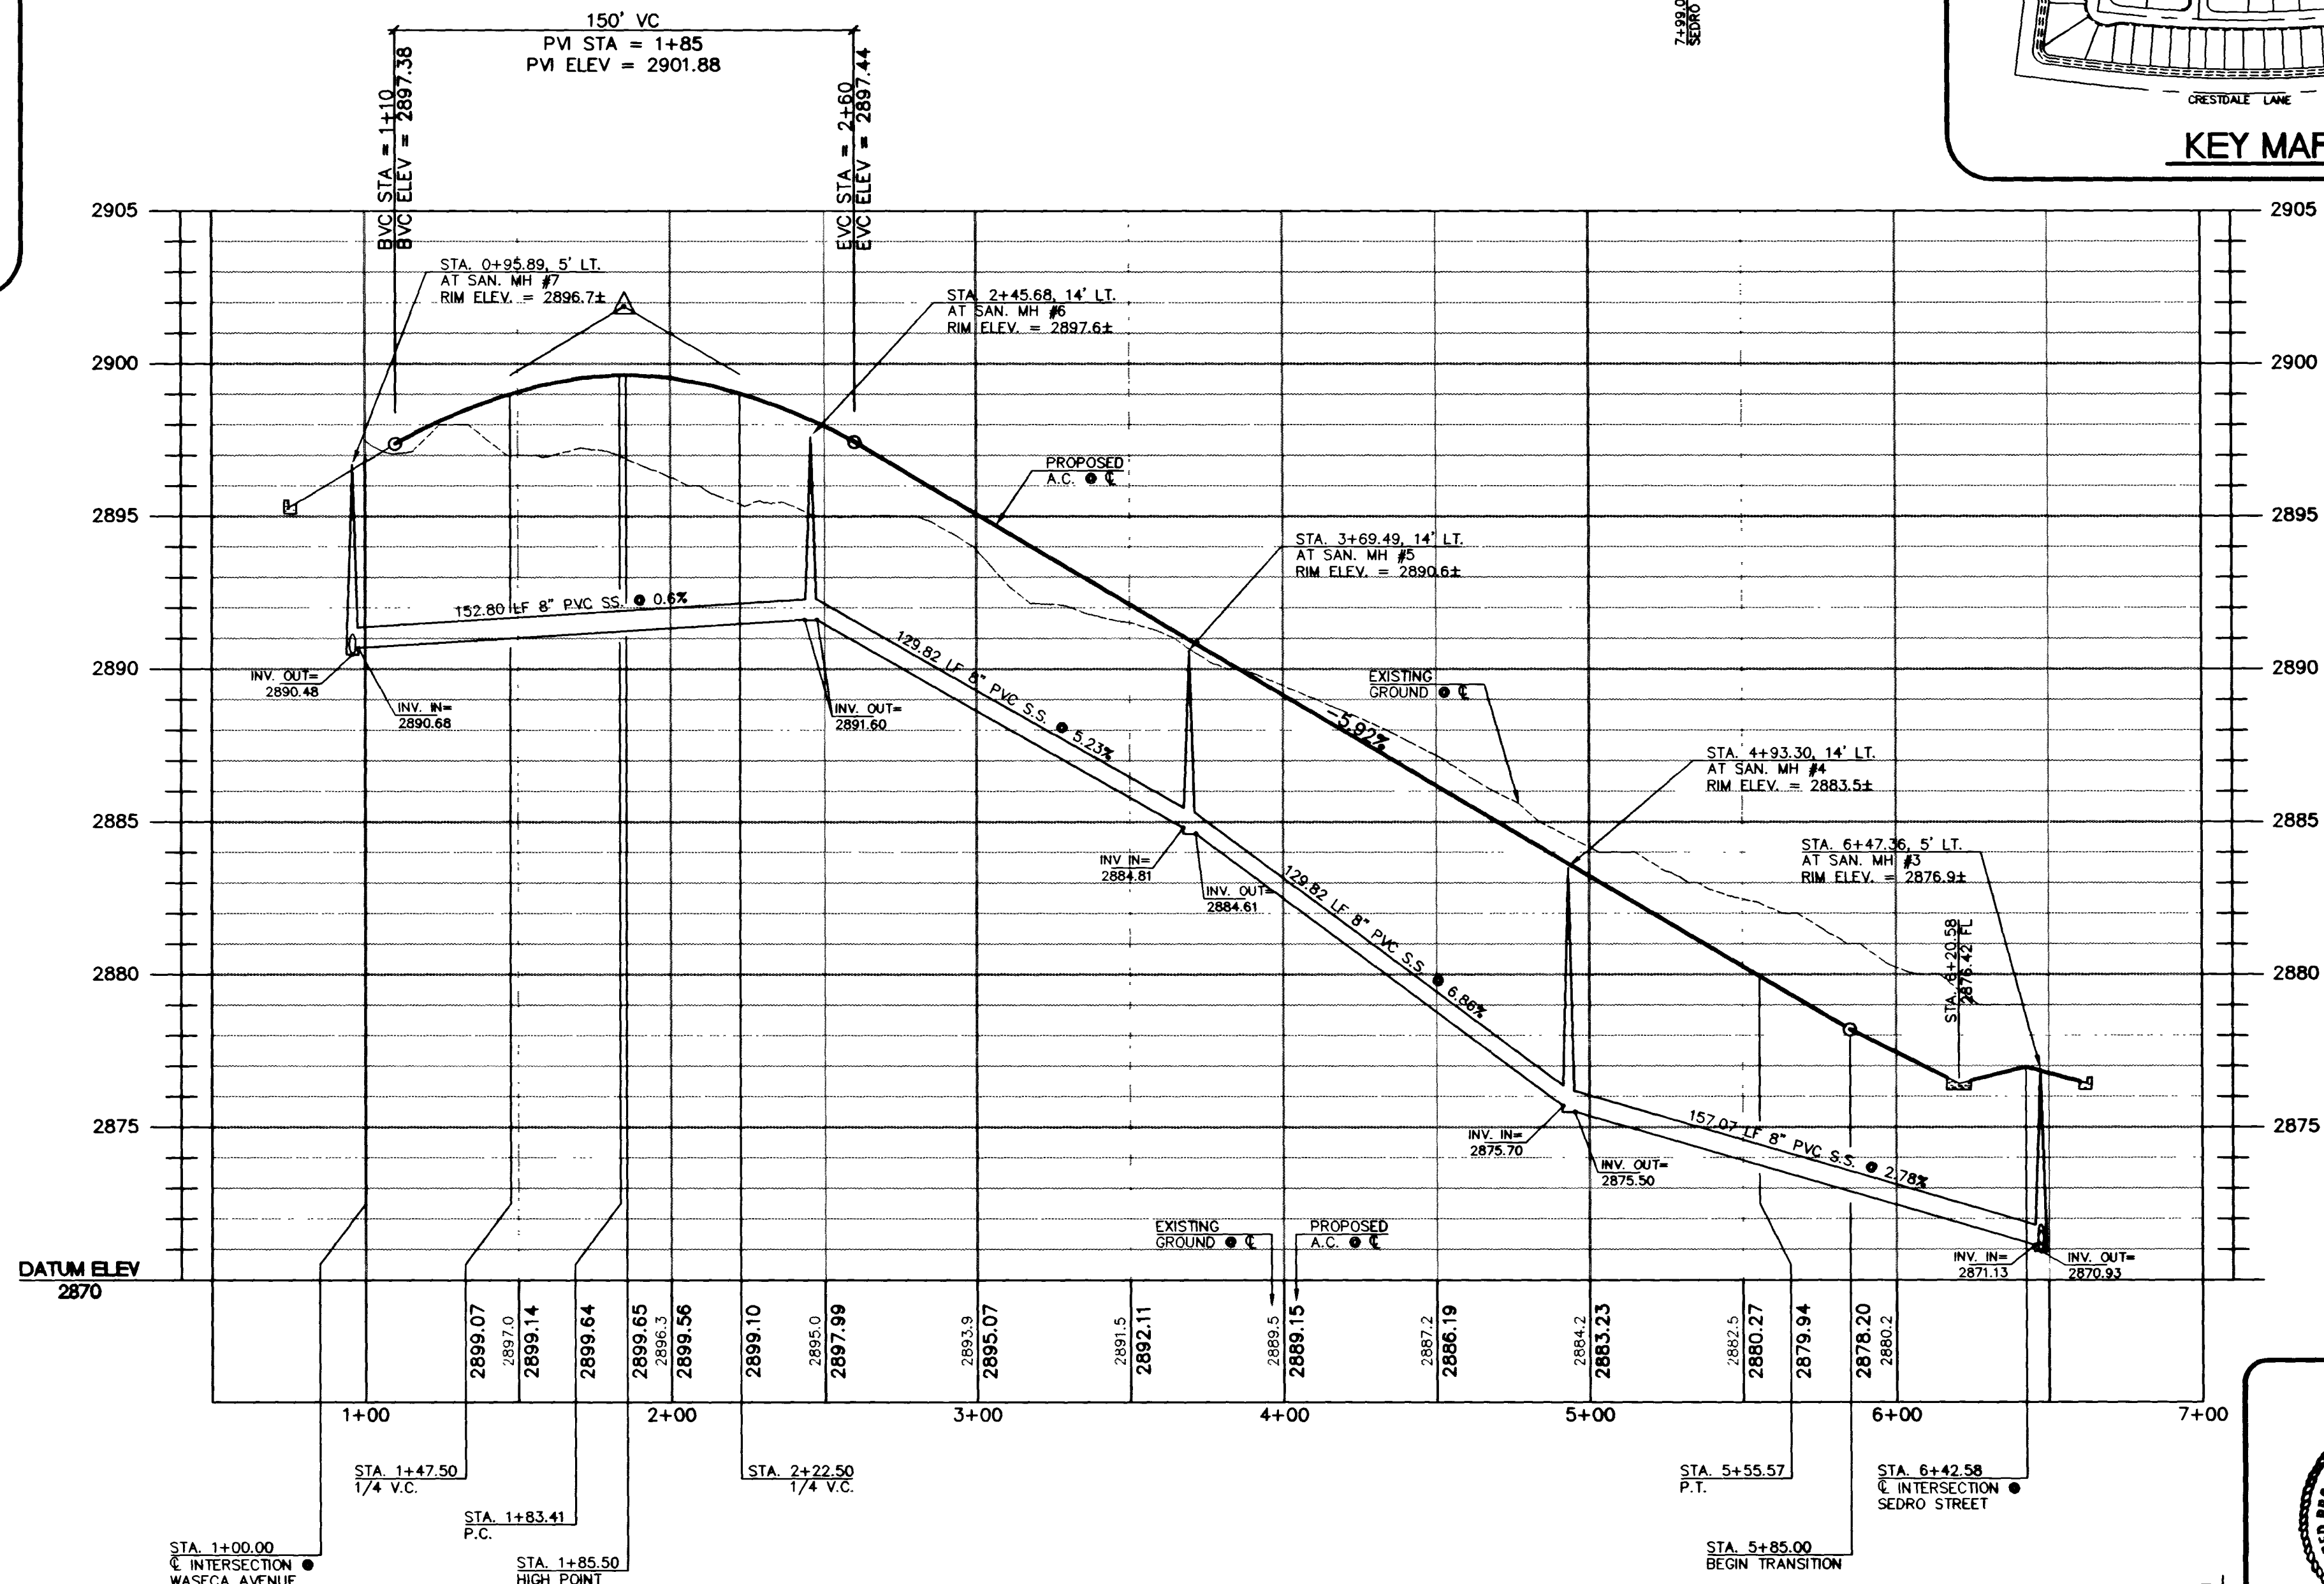

WATERTON DRIVE - PROFILE
HORIZONTAL SCALE: 1" = 40'
VERTICAL SCALE: 1" = 4'

No.	RADIUS	DELTA	LENGTH	TANGENT
C1	227.28	93°49'41"	372.16	242.97

No.	RADIUS	DELTA	LENGTH	TANGENT
C2	20.00	90°49'24"	31.70	20.29
C3	247.28	93°49'41"	404.21	264.35
C4	207.28	93°49'41"	339.40	221.59
C5	30.00	78°47'47"	41.26	24.64
C6	30.00	23°50'51"	22.55	11.47
C7	50.00	130°28'49"	113.87	108.41
C8	30.00	90°21'42"	47.31	30.19
C9	30.00	90°20'00"	47.12	30.00
C10	20.00	89°49'48"	31.36	19.94

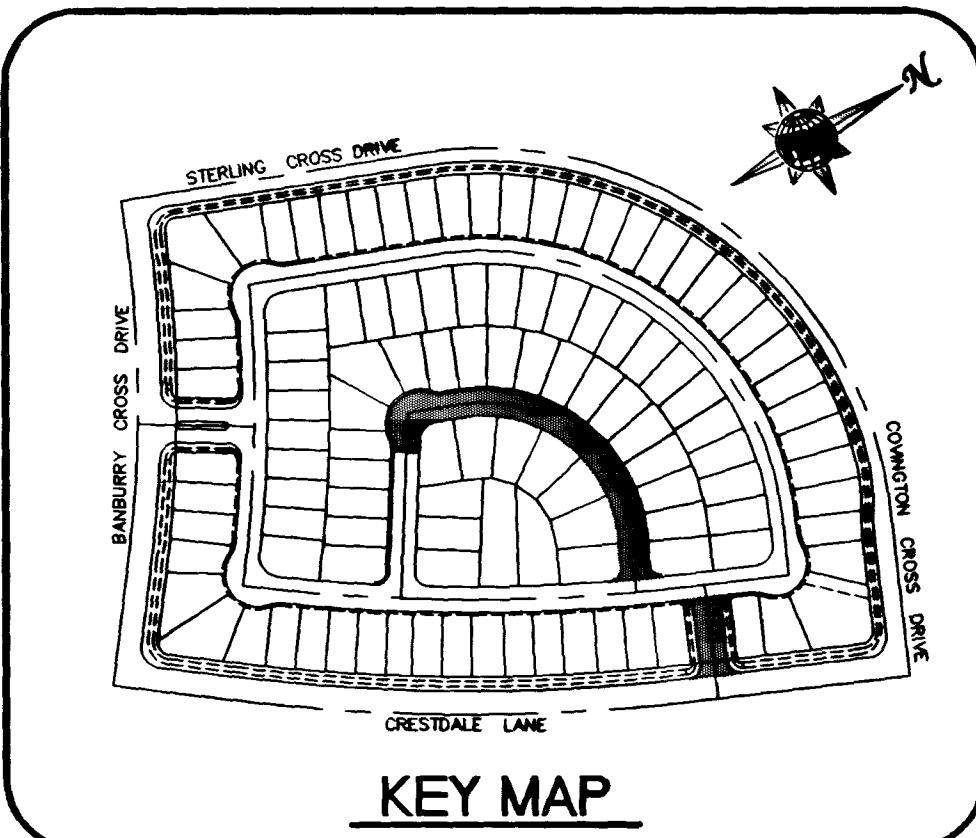

HIGHLAND HILLS

EDEN PRAIRIE AVENUE &
WATERTON DRIVE
PLAN AND PROFILE

Drawn by
7198.700
Checked by
8 OF 11
Date
APRIL 04, 1995
PLOT DATE
08-14-95

