




Call before you Dig
1-800-227-2600

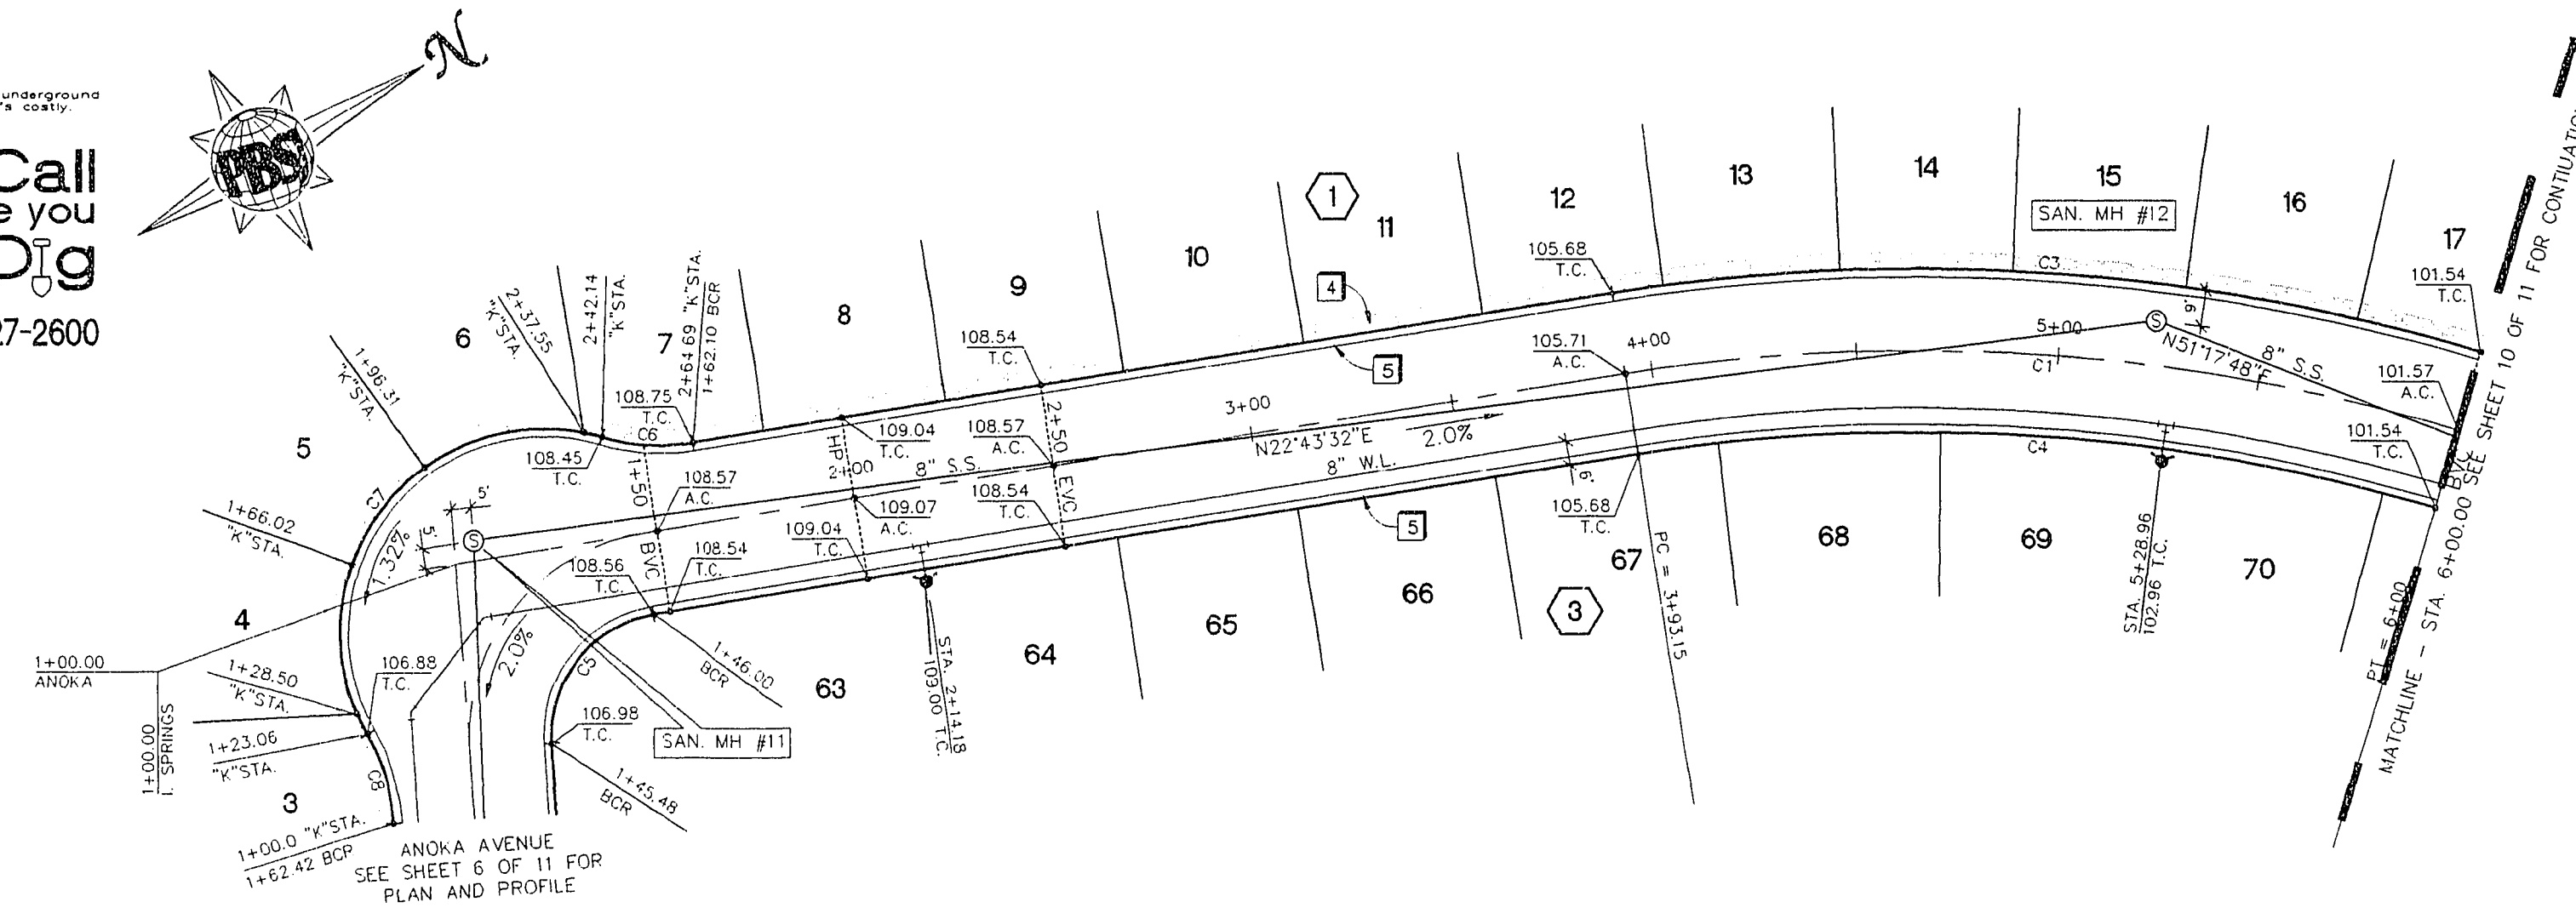

IRON SPRINGS DRIVE - PLAN VIEW
HORIZONTAL SCALE: 1" = 40'

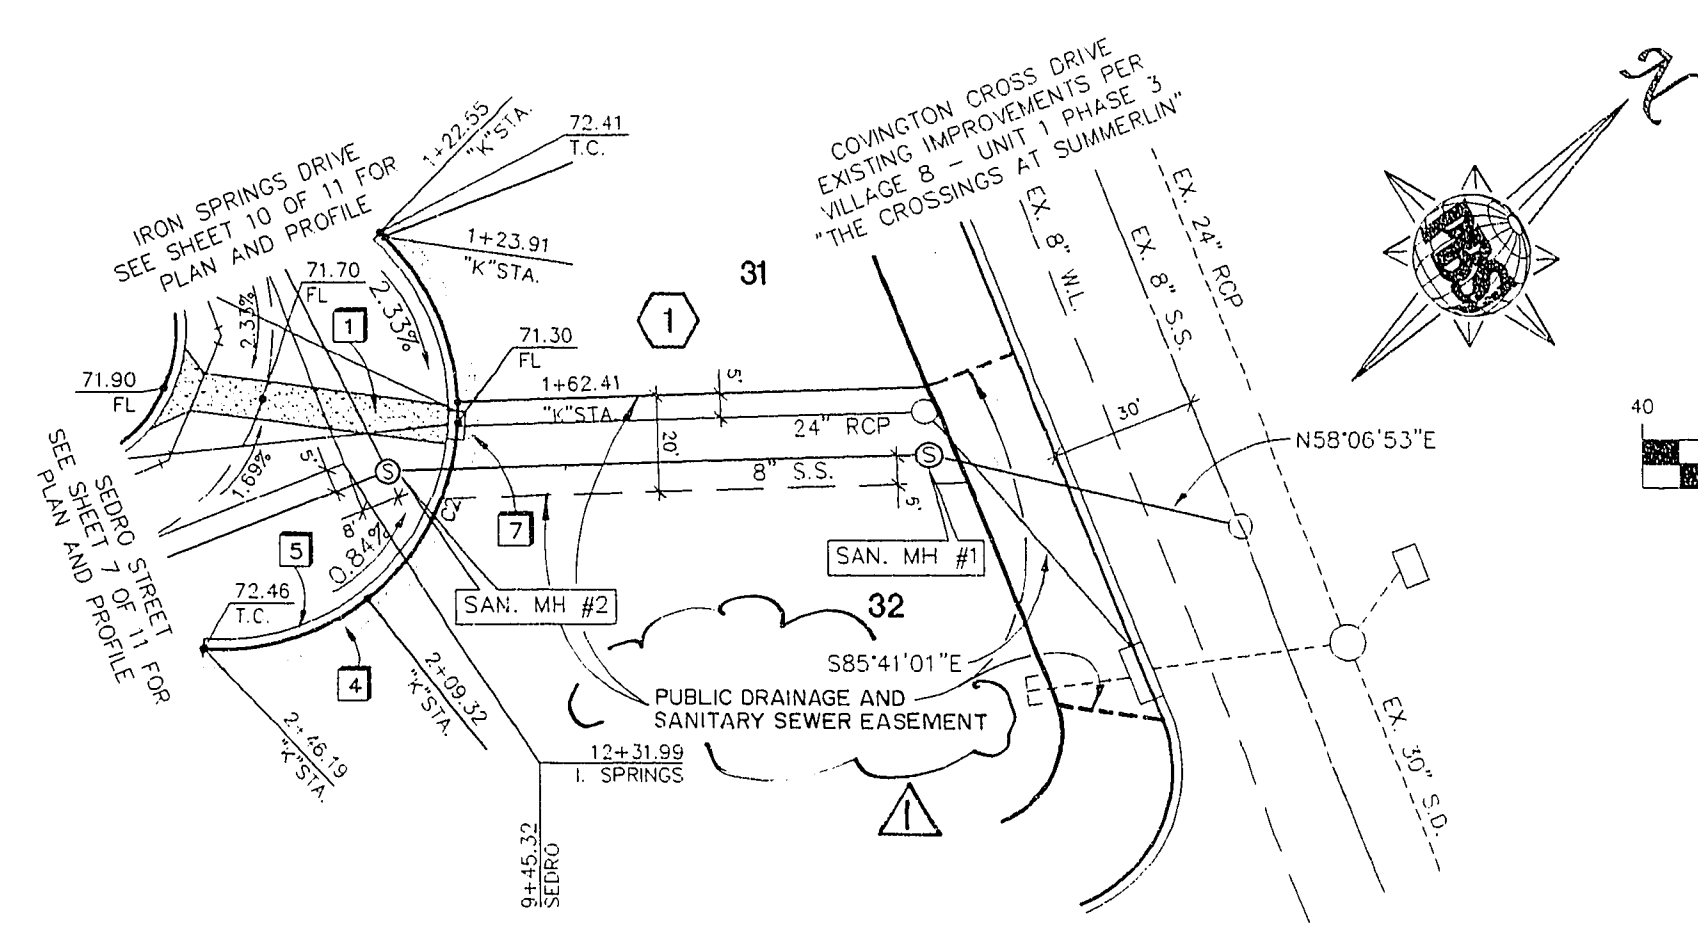

20' EASEMENT - PLAN VIEW
HORIZONTAL SCALE: 1" = 40'

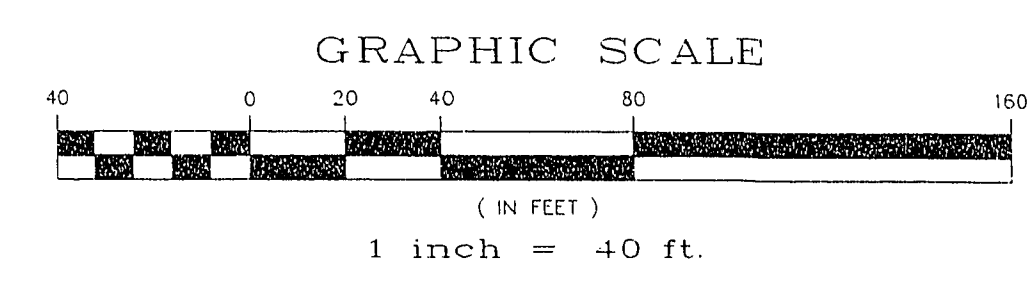



CENTERLINE CURVE DATA TABLE

No.	RADIUS	DELTA	LENGTH	TANGENT
C1	462.36	25°38'19"	236.85	105.19


BACK OF CURB CURVE DATA TABLE

No.	RADIUS	DELTA	LENGTH	TANGENT
C2	450.00	141°41'00"	133.64	143.93
C3	482.28	25°38'19"	215.80	109.74
C4	442.26	25°38'19"	197.90	100.63
C5	30.00	84°38'02"	44.31	27.31
C6	50.00	35°50'31"	22.55	11.47
C7	50.00	135°27'19"	119.08	125.18
C8	50.00	26°25'40"	23.06	11.74


- CONSTRUCTION NOTES**
1. CONSTRUCT 8" CONCRETE VALLEY GUTTER PER SUMMERLIN IMPROVEMENT STANDARD DWG. NO. S-64.
 4. CONSTRUCT 4' WIDE CONCRETE SIDEWALK PER SUMMERLIN IMPROVEMENT STANDARD DWG. NO. S-72.
 5. CONSTRUCT "L" TYPE CURB & GUTTER PER SUMMERLIN IMPROVEMENT STANDARD DWG. NO. S-47.
 7. 6" TYPE "C" DROP INLET PER SUMMERLIN IMPROVEMENT STANDARD DWG. NO. D-14.
- GENERAL NOTES**
1. ALL STATIONING IS CENTERLINE STATIONING UNLESS OTHERWISE NOTED.
 2. SEWER LENGTHS ARE FROM CENTER OF MANHOLE TO CENTER OF MANHOLE.
 3. "K" STA. INDICATES KNUCKLE STATIONING AT BACK OF CURB.

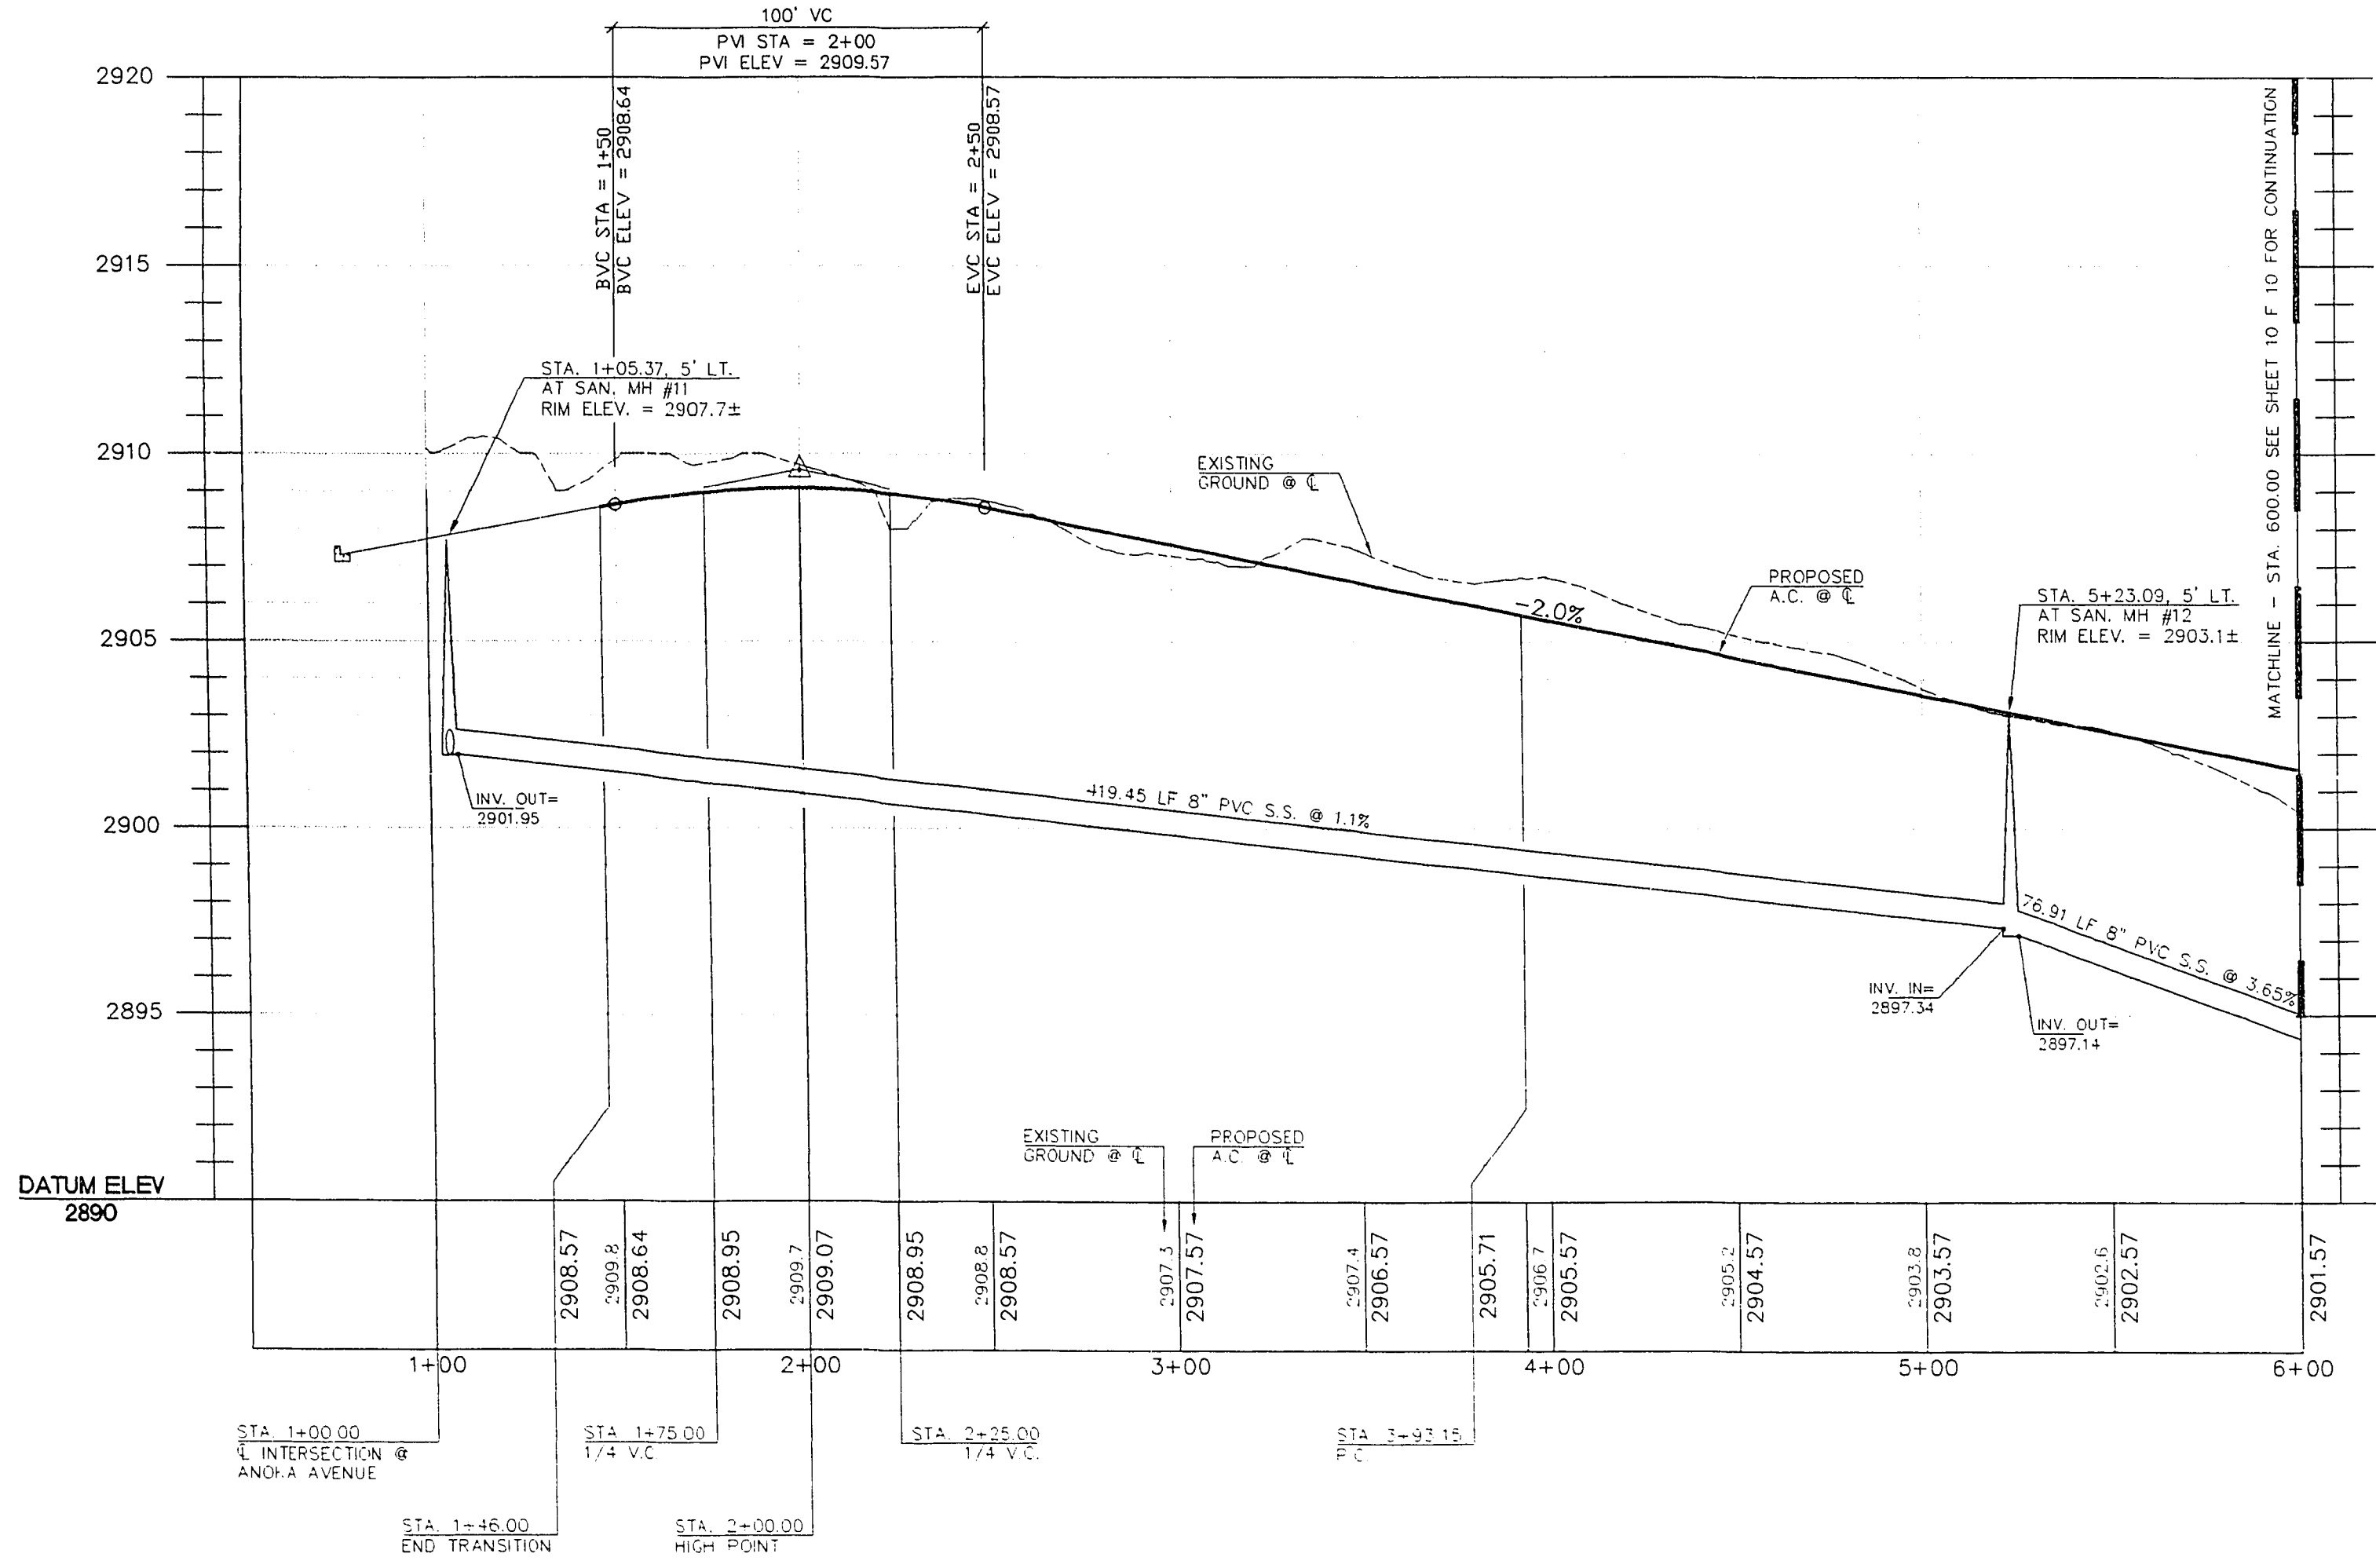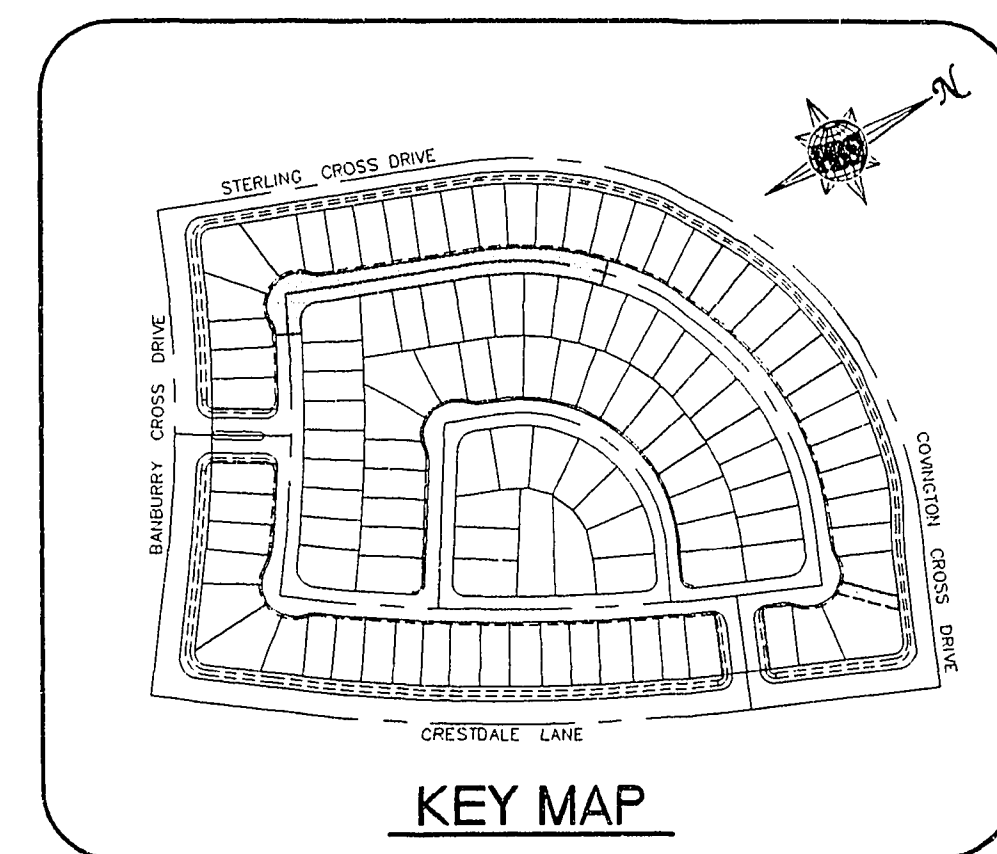

IRON SPRINGS DRIVE - PROFILE
HORIZONTAL SCALE: 1" = 40'
VERTICAL SCALE: 1" = 4'

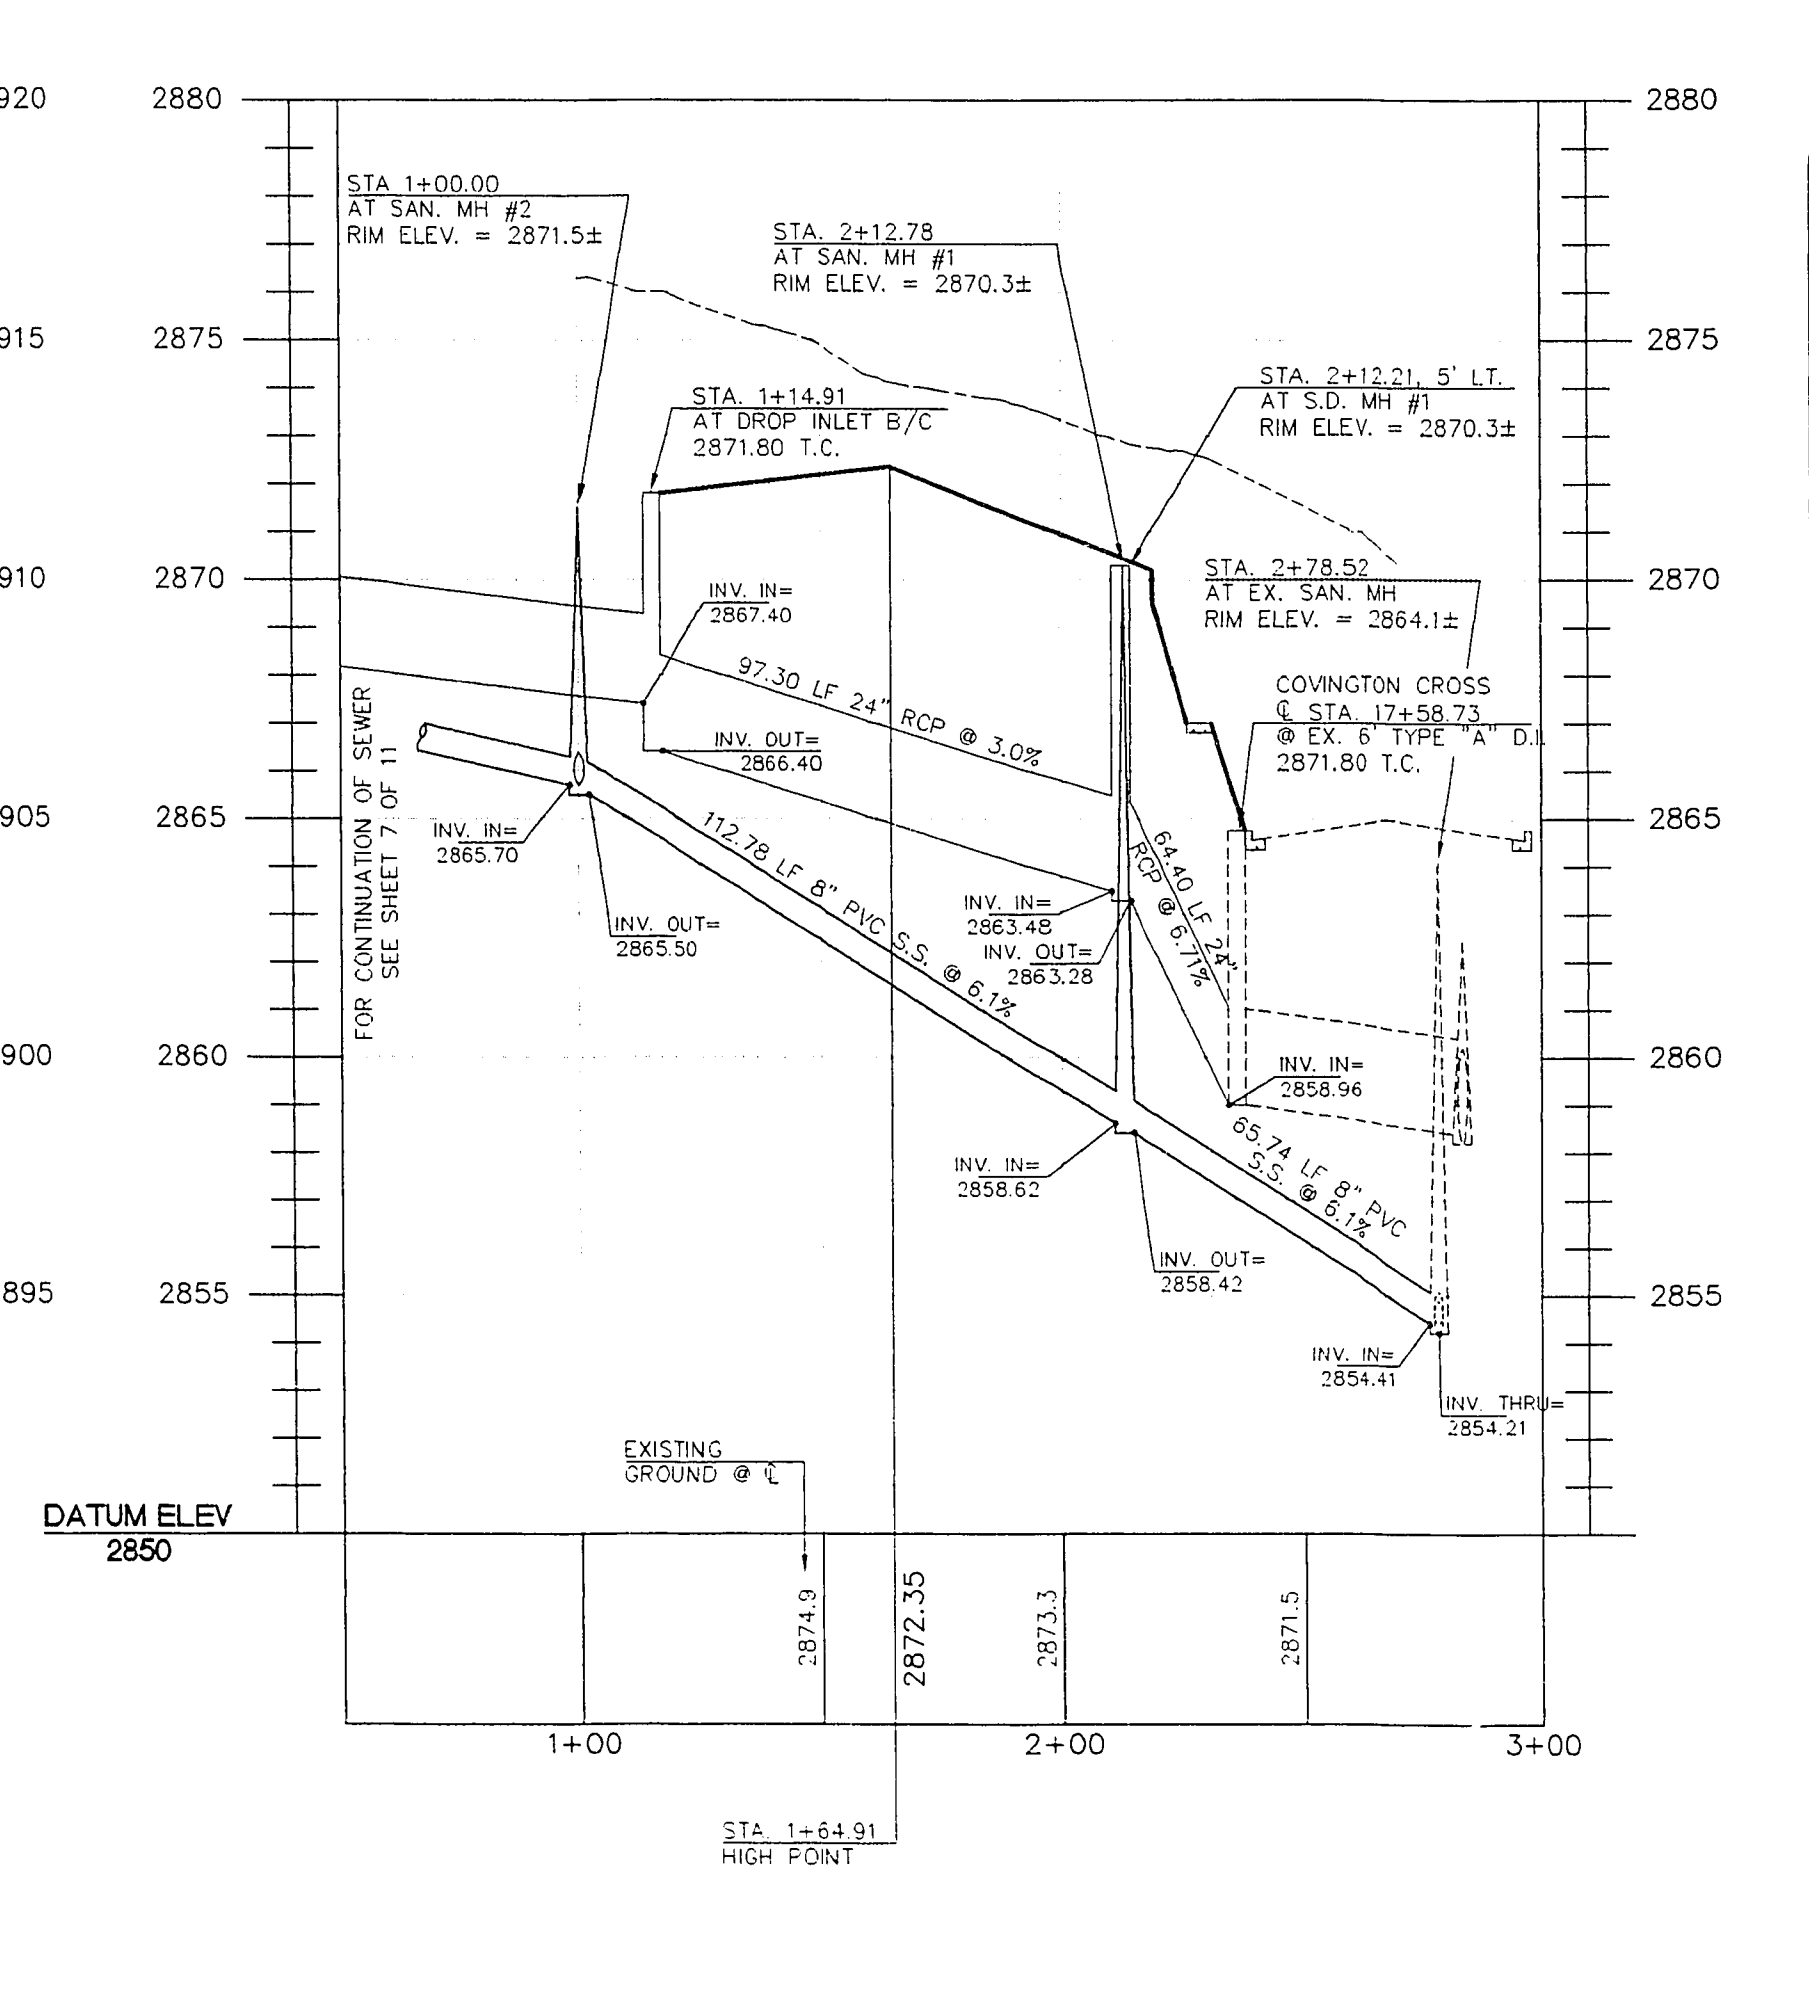

20' EASEMENT - PROFILE
HORIZONTAL SCALE: 1" = 40'
VERTICAL SCALE: 1" = 4'

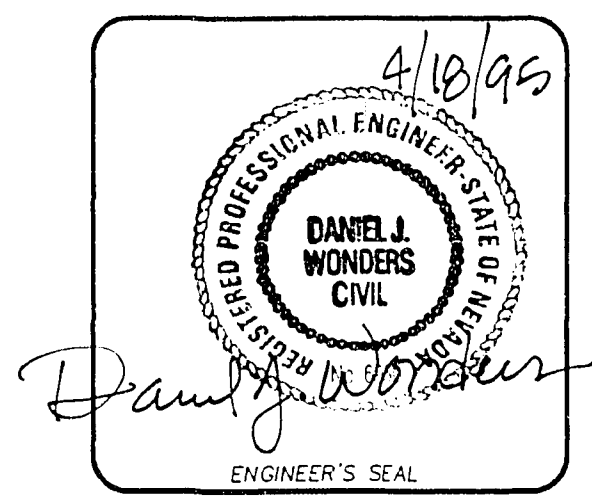

Job Number	Scale	Drawn by	Date	Plot Date
7198.700	1" = 40'	DB	APRIL 04, 1995	04-04-95
Sheet Number	File No.	Checked by	Date	Plot Date
9 OF 11	700IMP	MDP	APRIL 04, 1995	04-04-95

Address: 6600 West Charleston Blvd., Suite 100, Las Vegas, Nevada 89102. Telephone: 702/978-6244. Fax: 702/978-7778.

POST: BOCKLEY & JERNICAN

ENGINEERING - PLANNING - SURVEYING - CONSTRUCTION SERVICES

HIGHLAND HILLS

IRON SPRINGS DRIVE
STA. 1+00.00 TO 6+00.00
& 20' SEWER & DRAINAGE EASE.
PLAN AND PROFILE

11-21-142

107Y-4394