Avoid cutting underground utility lines. It's costly.

Call before you Dig

1-800-227-2600

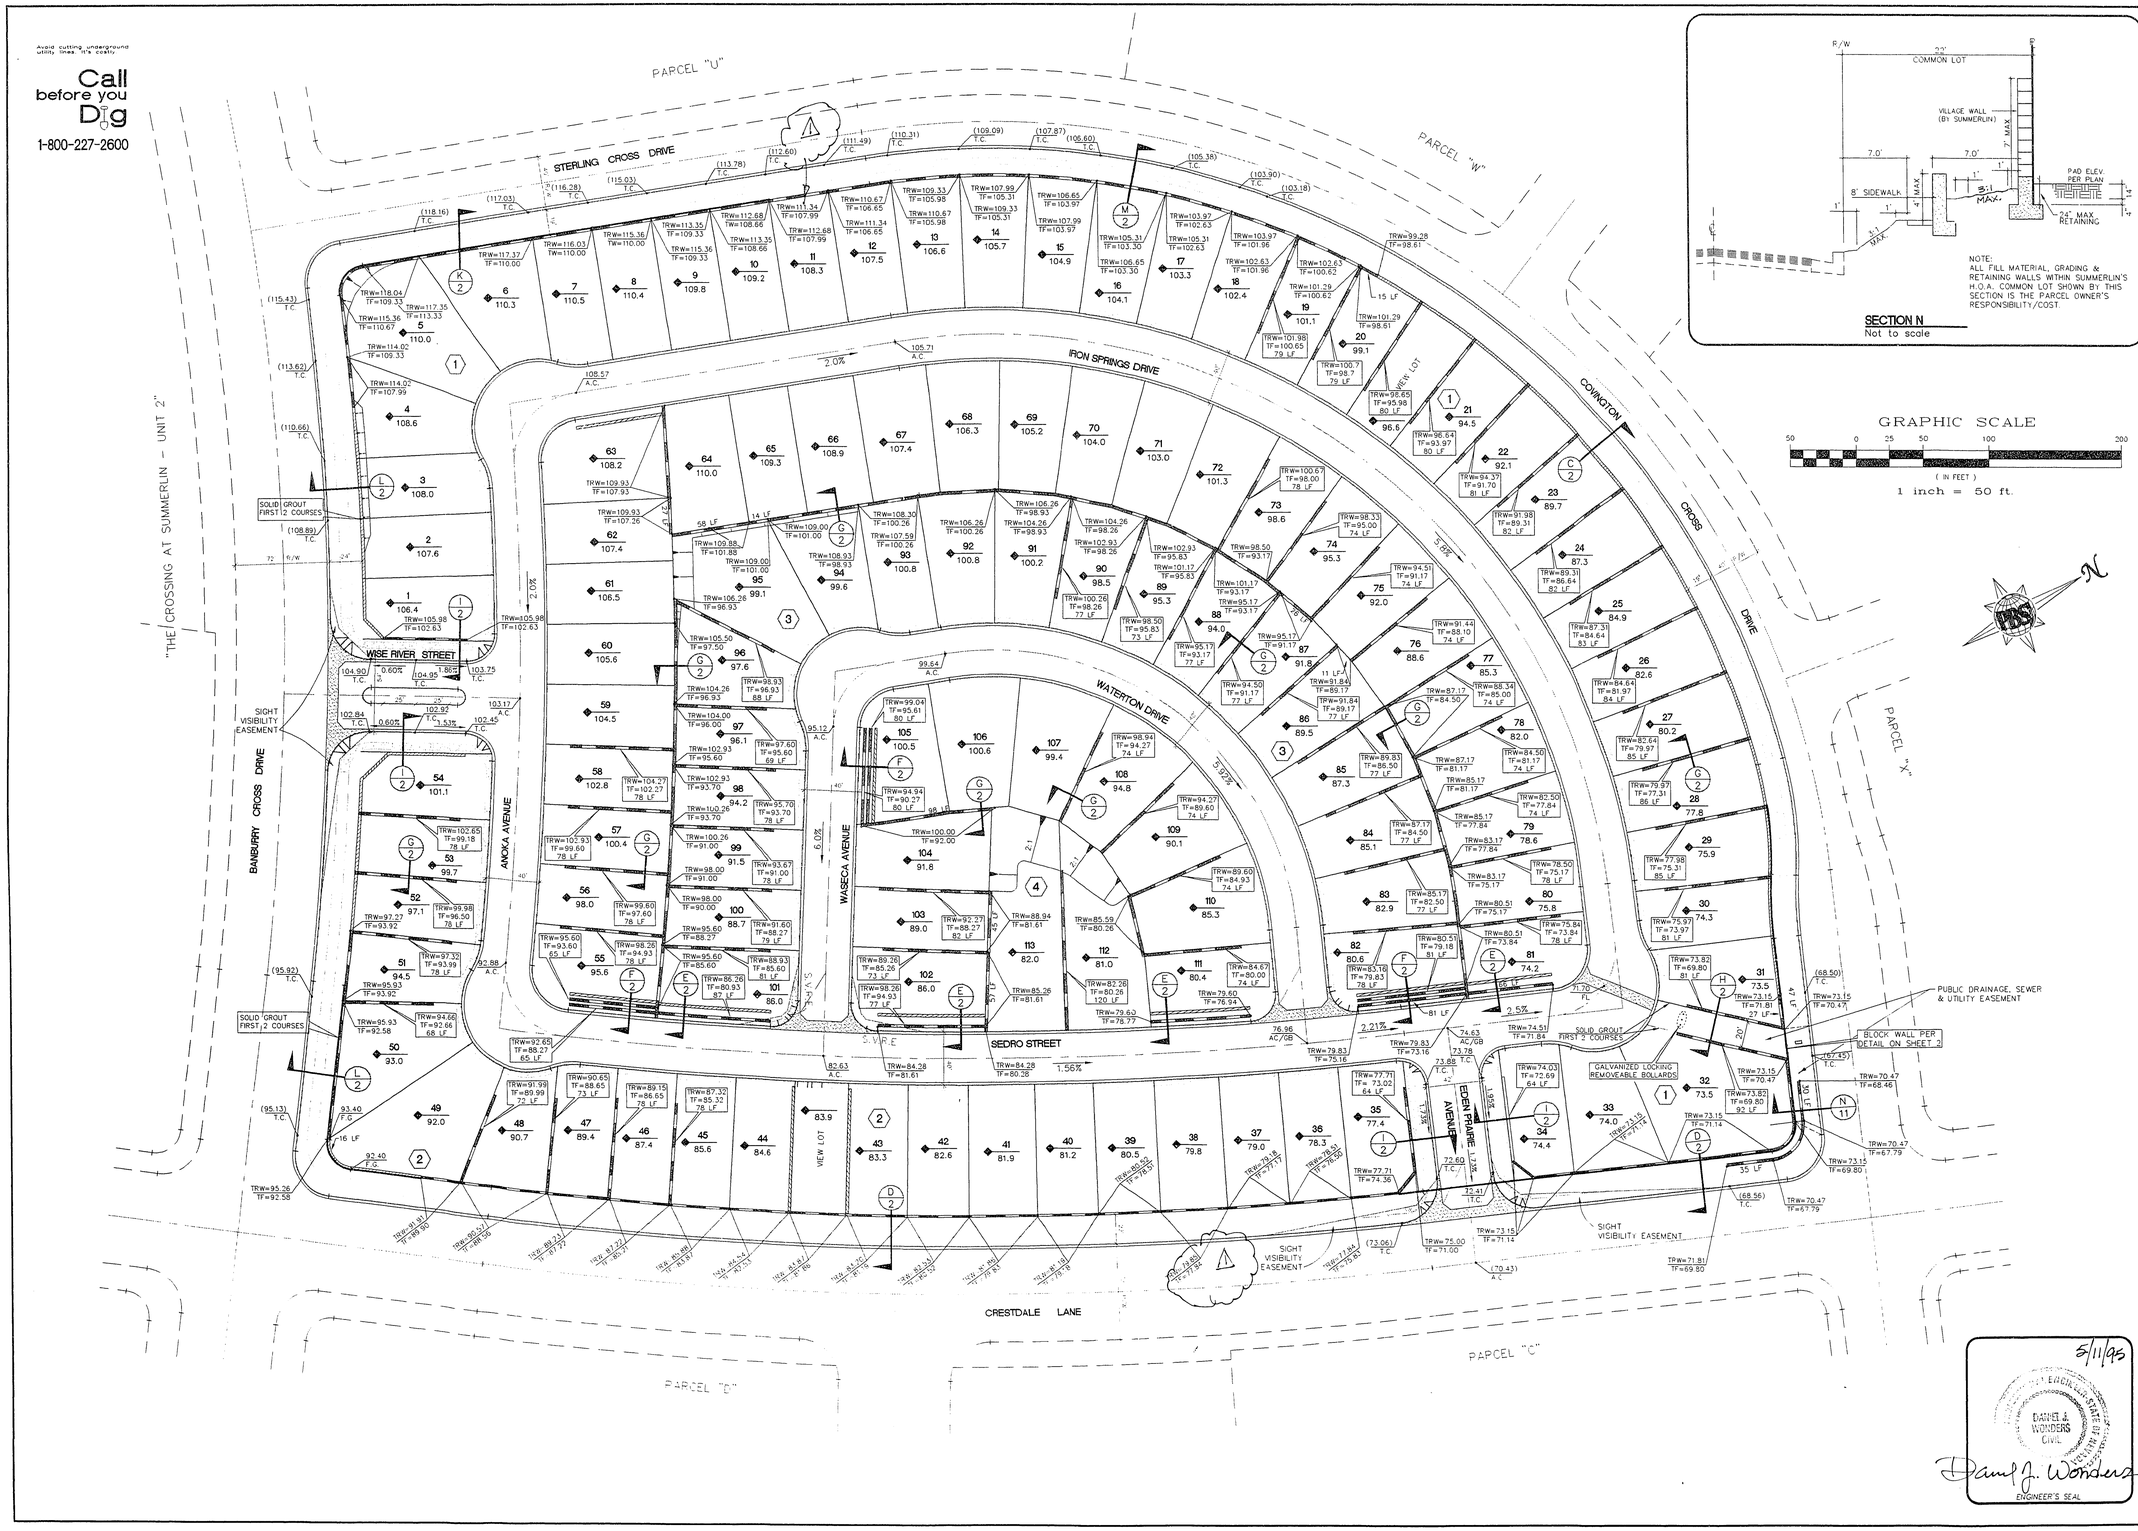

SECTION N
Not to scale

No.	REVISIONS	Date	Init.	Appr.	Date
1	Revise Ret. Wall Crestdale & Sq. Cross	4/6/95	T.K.		

POST, BUCKLEY, SCHUH & JERNIGAN
6600 West Charleston Blvd.
Suite 100
Las Vegas, Nevada 89102
Phone: 702/878-6644
Fax: 702/878-7758
ENGINEERING · PLANNING · SURVEYING · CONSTRUCTION SERVICES

HIGHLAND HILLS

RETAINING WALL PLAN

Job Number 7198.700	Drawn by DTB	Scale 1" = 50'	
	Checked by MDP	File No. 700IMP	
Sheet Number 11 OF 11	Date APRIL 04, 1995		

DRAWING: 700-11 PLOT DATE: 06-15-95

5/11/95

DANIEL J. WONDERS CIVIL

Daniel J. Wonders

ENGINEER'S SEAL

11-21-144

107Y-4394