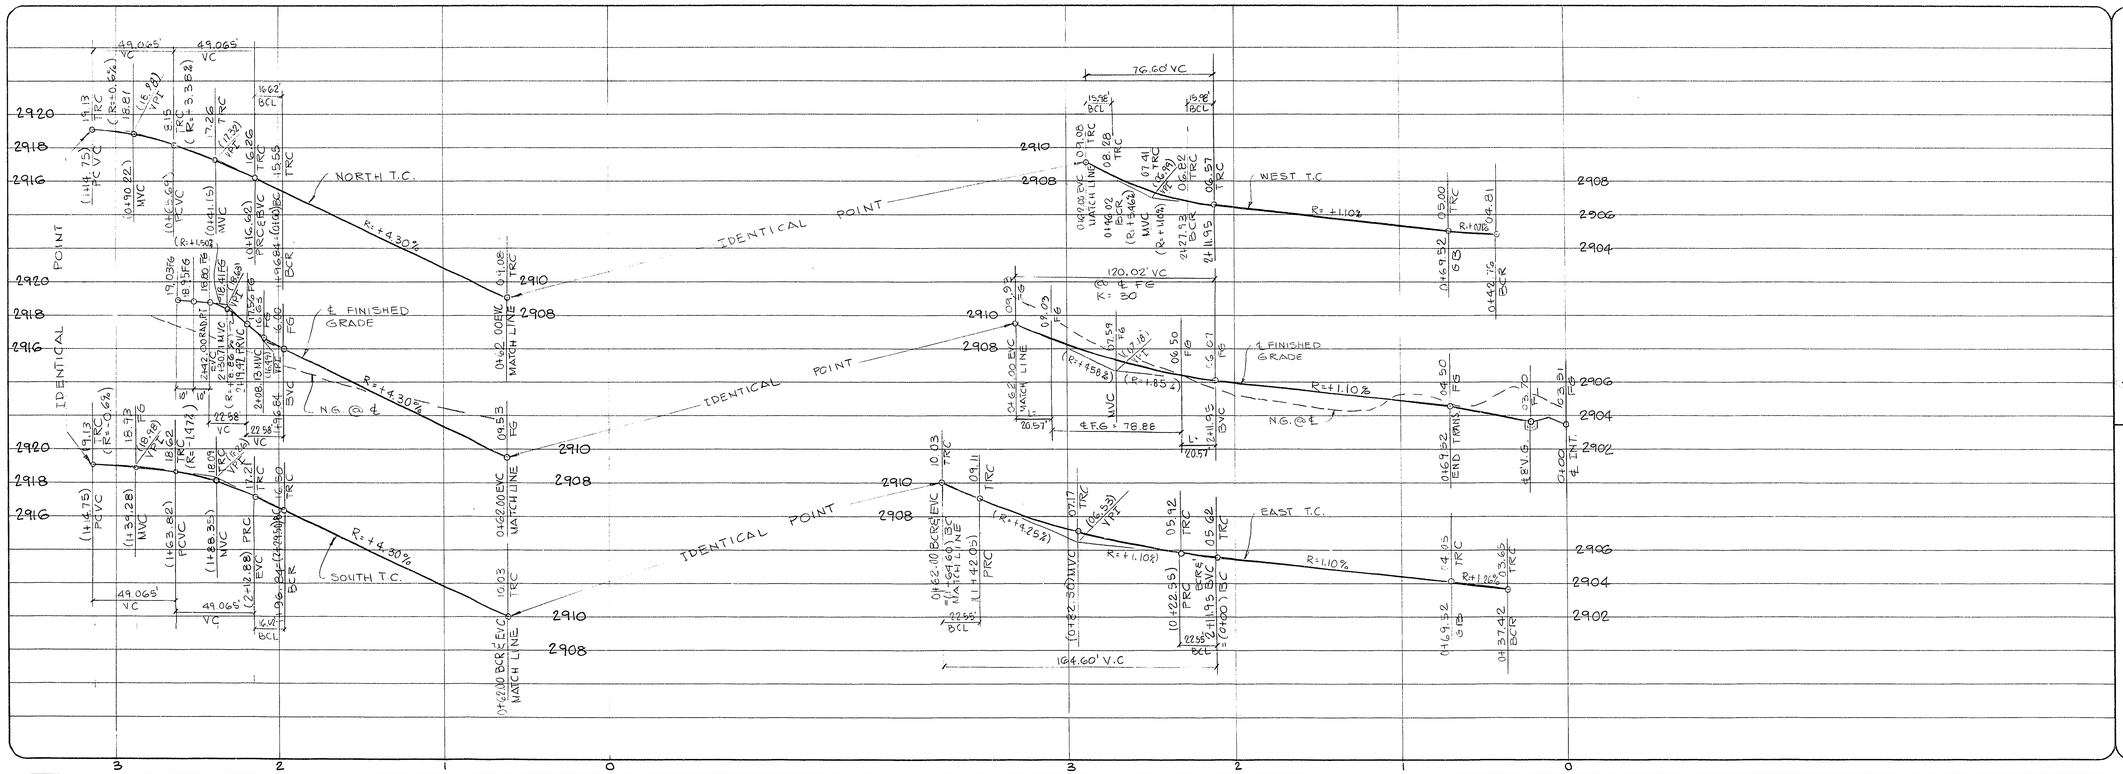

SCALE 1"=40'
0 20' 40' 80'

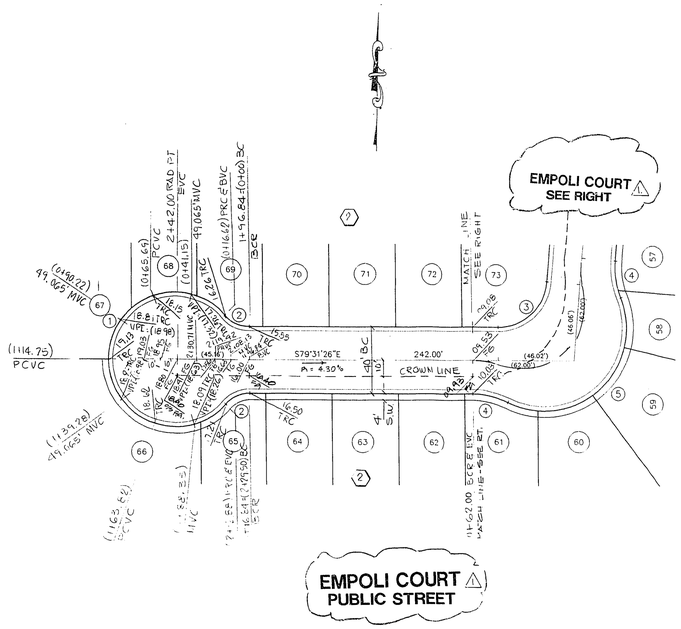

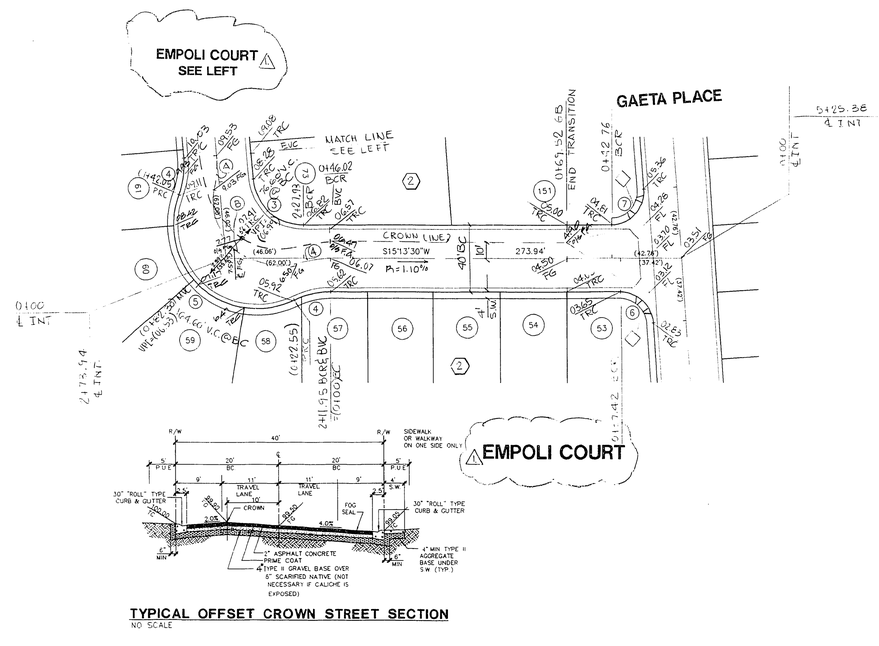

BENCHMARK

CONTROL POINT "SPANKY" A BRASS CAP SET, IN CONCRETE STAMPED #12" SET BY GC WALLACE ENGINEERING AND USED FOR BENCHMARK FOR SUMMERLIN CONSTRUCTION

ELEVATION = 2825.38 (SUMMERLIN DATUM)= PROJECT DATUM
ELEVATION EQUATION: SUMMERLIN ELEV.=0.217+NGVD'29 ELEV.
ELEVATION EQUATION: NGVD ELEV.+2.437=NAVD'88 ELEV.

2 working days Call before you Dig
1-800-227-2600

CURVE TABLE AT BACK OF CURB

CURVE	RADIUS	LENGTH	TANGENT	DELTA
1	40.50'	196.26'	35.42'	277°39'15"
2	19.50'	16.62'	8.85'	48°49'38"
3	30.00'	44.64'	27.61'	85°15'04"
4	50.00'	27.55'	11.47'	31°50'31"
5	50.00'	119.50'	126.72'	136°56'06"
6	20.00'	30.08'	18.71'	86°10'31"
7	20.00'	32.75'	21.38'	93°49'29"

℄ CURVE DATA

CURVE	RADIUS	LENGTH	TANGENT	DELTA
A	70.00'	20.57'	10.36	16°50'16"
B	28.00'	76.88'	64.42'	118°55'37"

TYPICAL OFFSET CROWN STREET SECTION
NO SCALE

PLASTER DEVELOPMENT
CITY OF LAS VEGAS

REV	DATE	BY	REVISION
1	7.31.96	MDM	REV. STREET NAME
2			
3			
4			

CONSULTING ENGINEERS • PLANNERS • LAND SURVEYORS
2727 SOUTH RAINBOW BOULEVARD
LAS VEGAS, NEVADA 89102-5148 PHONE (702) 873-7550 FAX (702) 362-2597

vgn nevada

TITLE: STREET PLAN - PROFILE
△1 EMPOLI COURT

PROJECT: INDIAN HILLS
UNIT 3

SEAL
REGISTERED PROFESSIONAL ENGINEER
JOSEPH D. MASON
CIVIL
No. 11007
STATE OF NEVADA
5.9.96

WO NO. 4820-3
BY
DATE JAN.,'96
SCALE HORIZ. 1"=40'
VERT. 1"=4'
SHEET 5 OF 8 SHEETS

H:\CAD\LANDEV\4820\V4820U3.DWG[BR-ST3A]CRW

1/23-21

1074-4410-3