



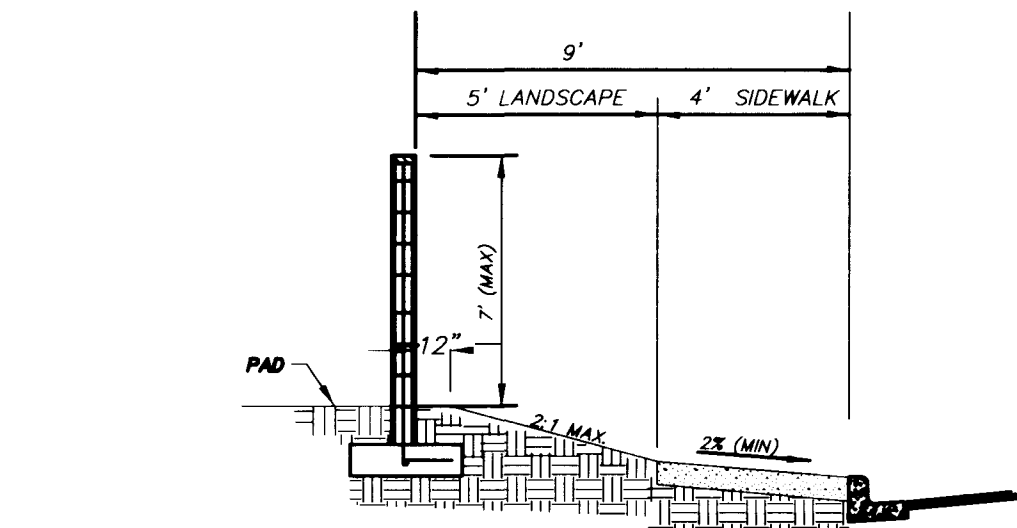


A TYPICAL WALL SECTION
NO SCALE

NOTE: IF MORE THAN 7' HIGH WALL IS NEEDED,
DUAL RETAINING WALLS WILL BE REQUIRED.

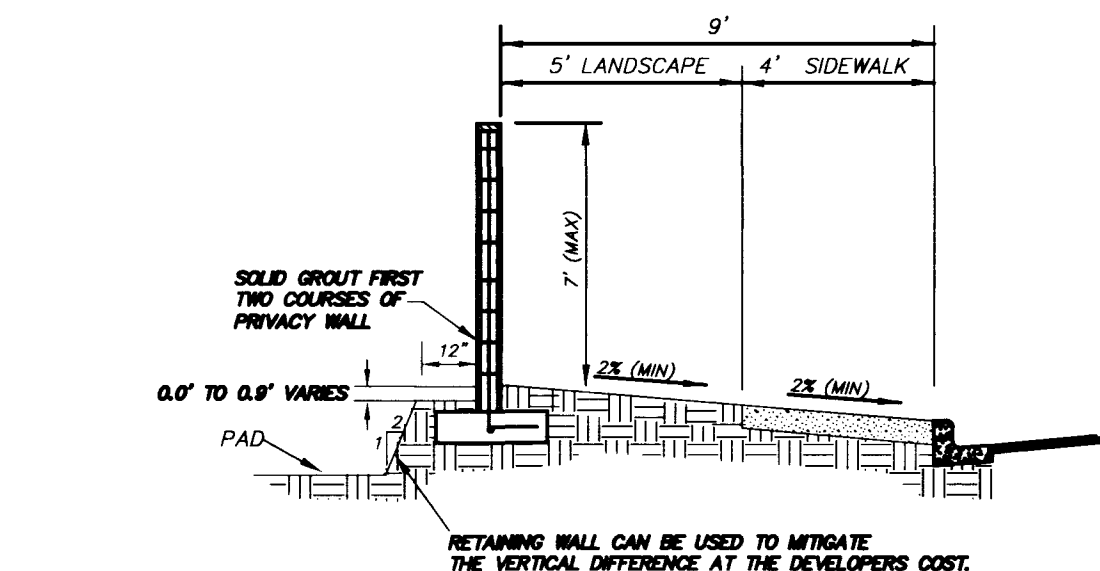


B TYPICAL WALL SECTION
NO SCALE

NOTE: IF MORE THAN 7' HIGH WALL IS NEEDED,
DUAL RETAINING WALLS WILL BE REQUIRED.

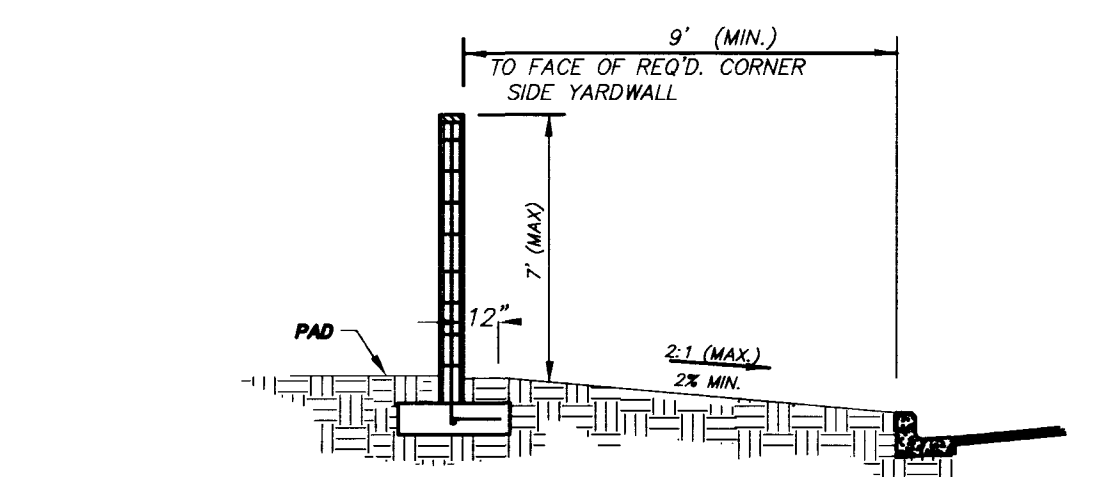


C TYPICAL WALL SECTION
NO SCALE

NOTE: IF MORE THAN 7' HIGH WALL IS NEEDED,
DUAL RETAINING WALLS WILL BE REQUIRED.

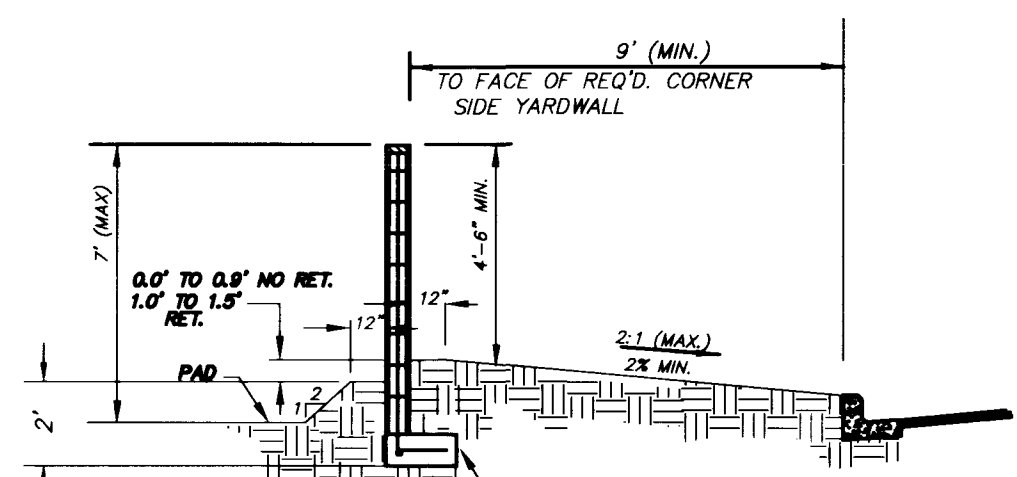


D TYPICAL WALL SECTION
NO SCALE

NOTE: IF MORE THAN 7' HIGH WALL IS NEEDED,
DUAL RETAINING WALLS WILL BE REQUIRED.

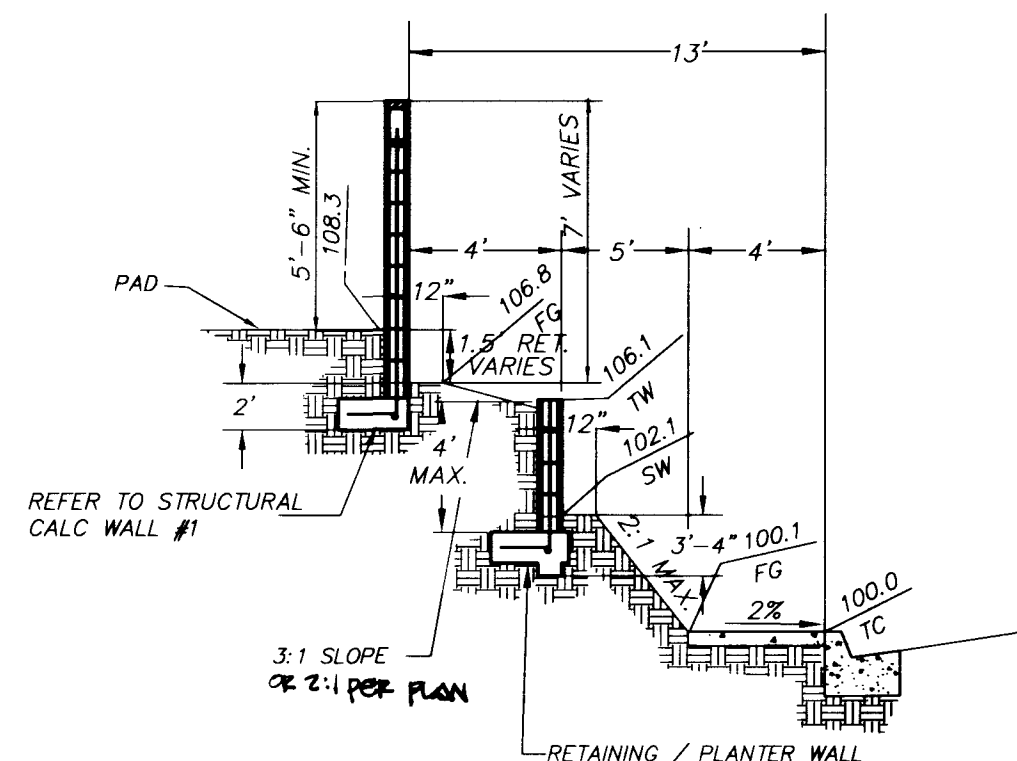


E TYPICAL WALL SECTION
NO SCALE

NOTE: IF MORE THAN 7' HIGH WALL IS NEEDED,
DUAL RETAINING WALLS WILL BE REQUIRED.

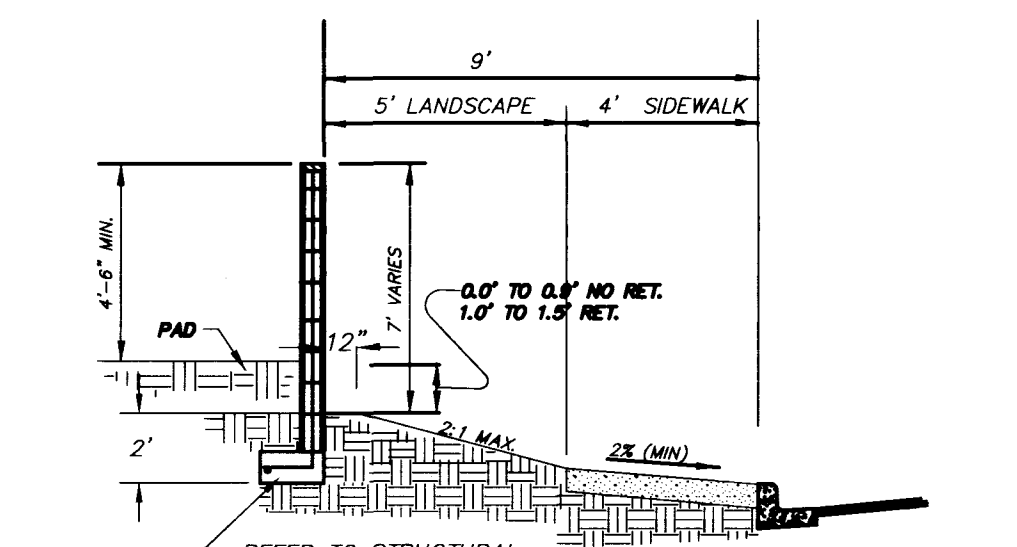


F TYPICAL WALL SECTION
NO SCALE

NOTE: IF MORE THAN 7' HIGH WALL IS NEEDED,
DUAL RETAINING WALLS WILL BE REQUIRED.

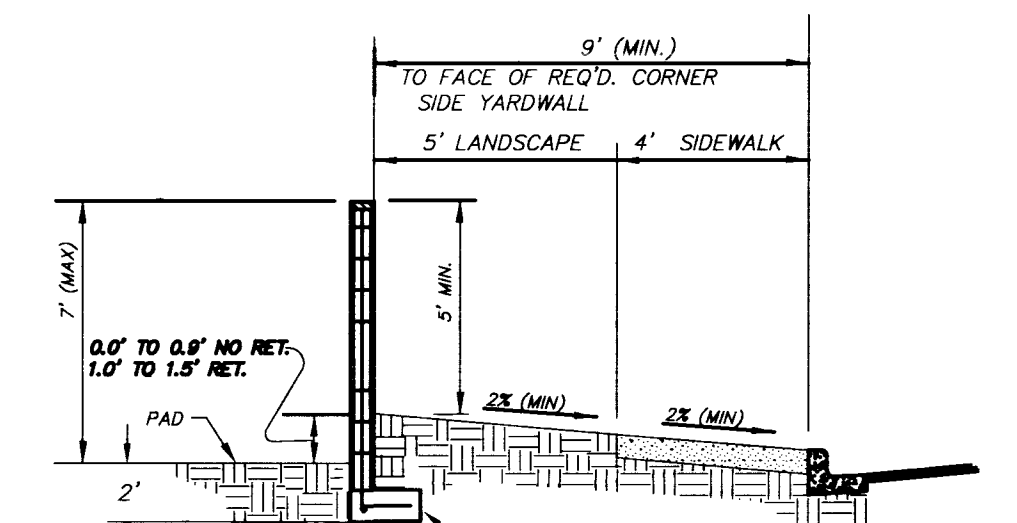


G TYPICAL WALL SECTION
NO SCALE

NOTE: IF MORE THAN 7' HIGH WALL IS NEEDED,
DUAL RETAINING WALLS WILL BE REQUIRED.

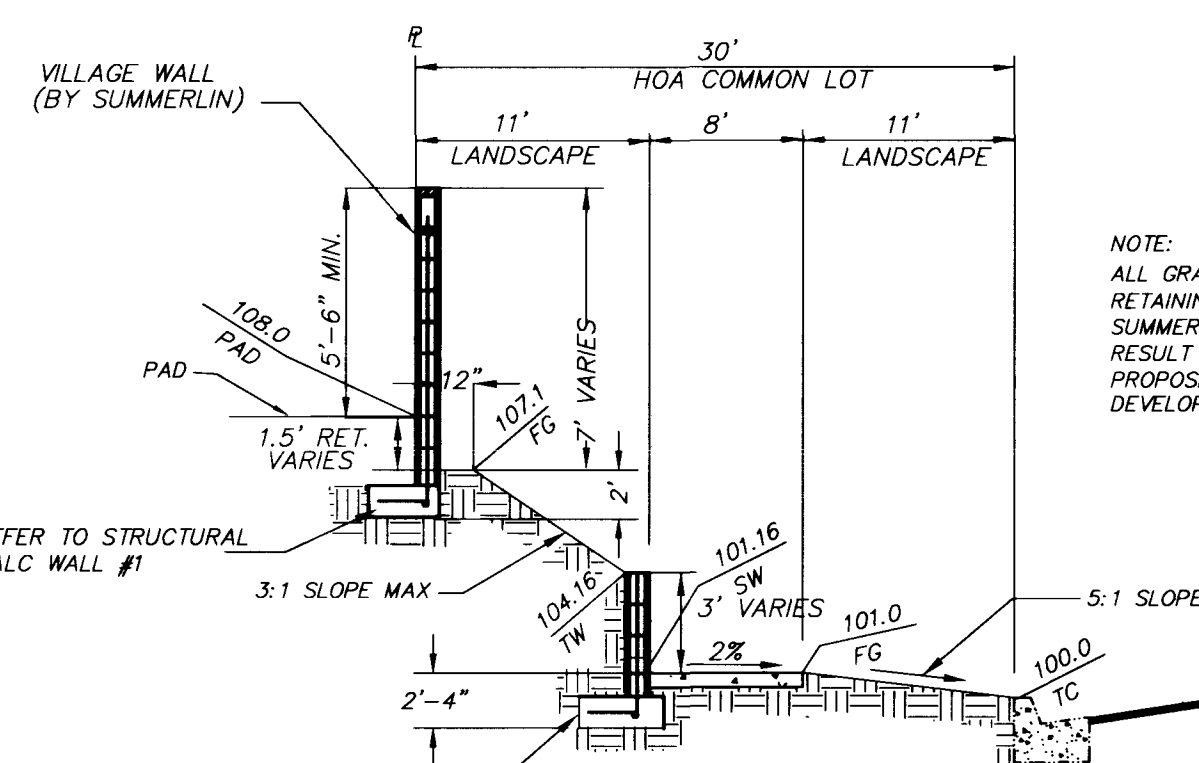


H TYPICAL WALL SECTION (SAGEBERRY DRIVE)
NO SCALE

NOTE: IF MORE THAN 7' HIGH WALL IS NEEDED,
DUAL RETAINING WALLS WILL BE REQUIRED.

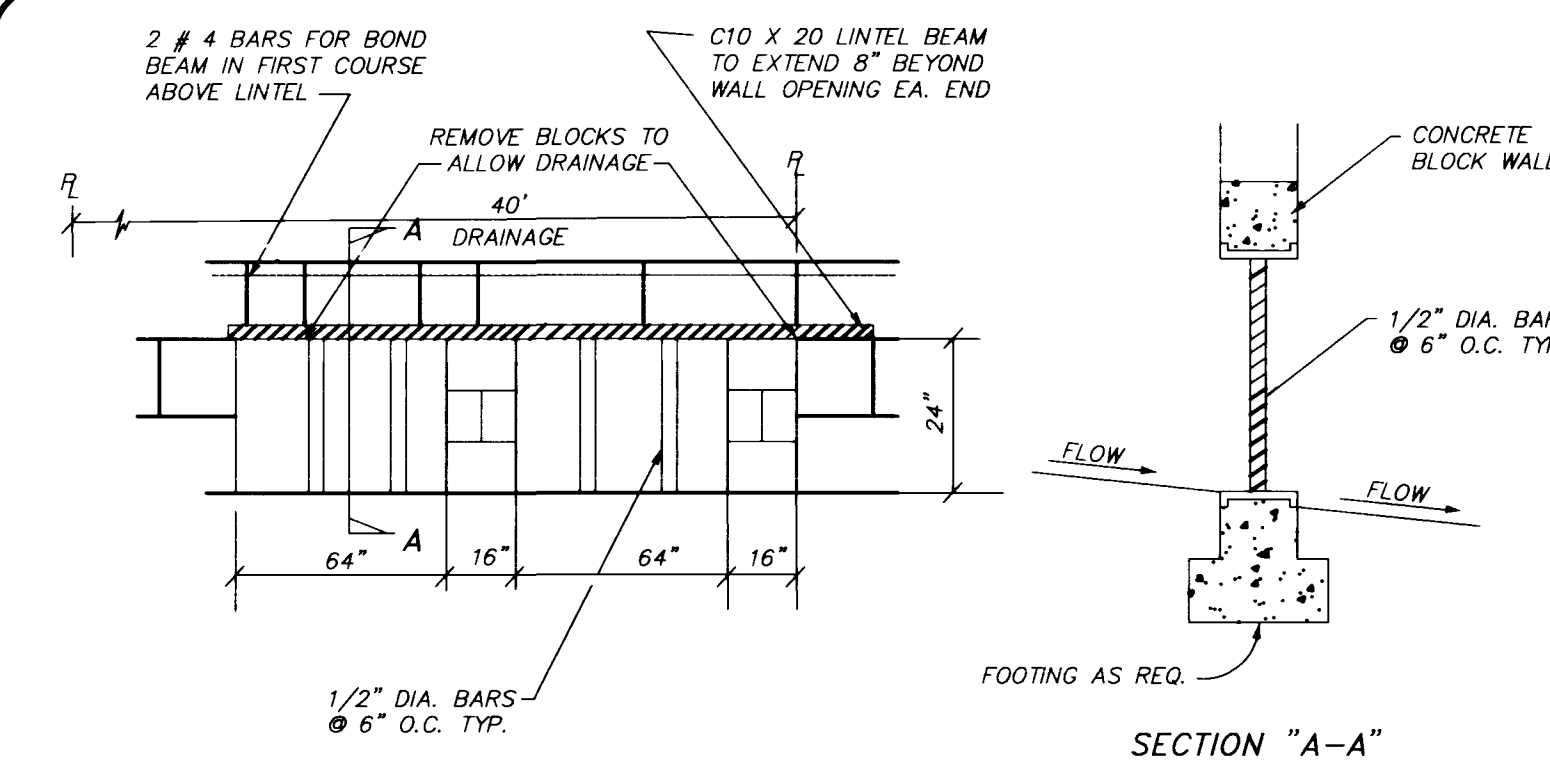


J BLOCK WALL OPENING DETAIL
NO SCALE


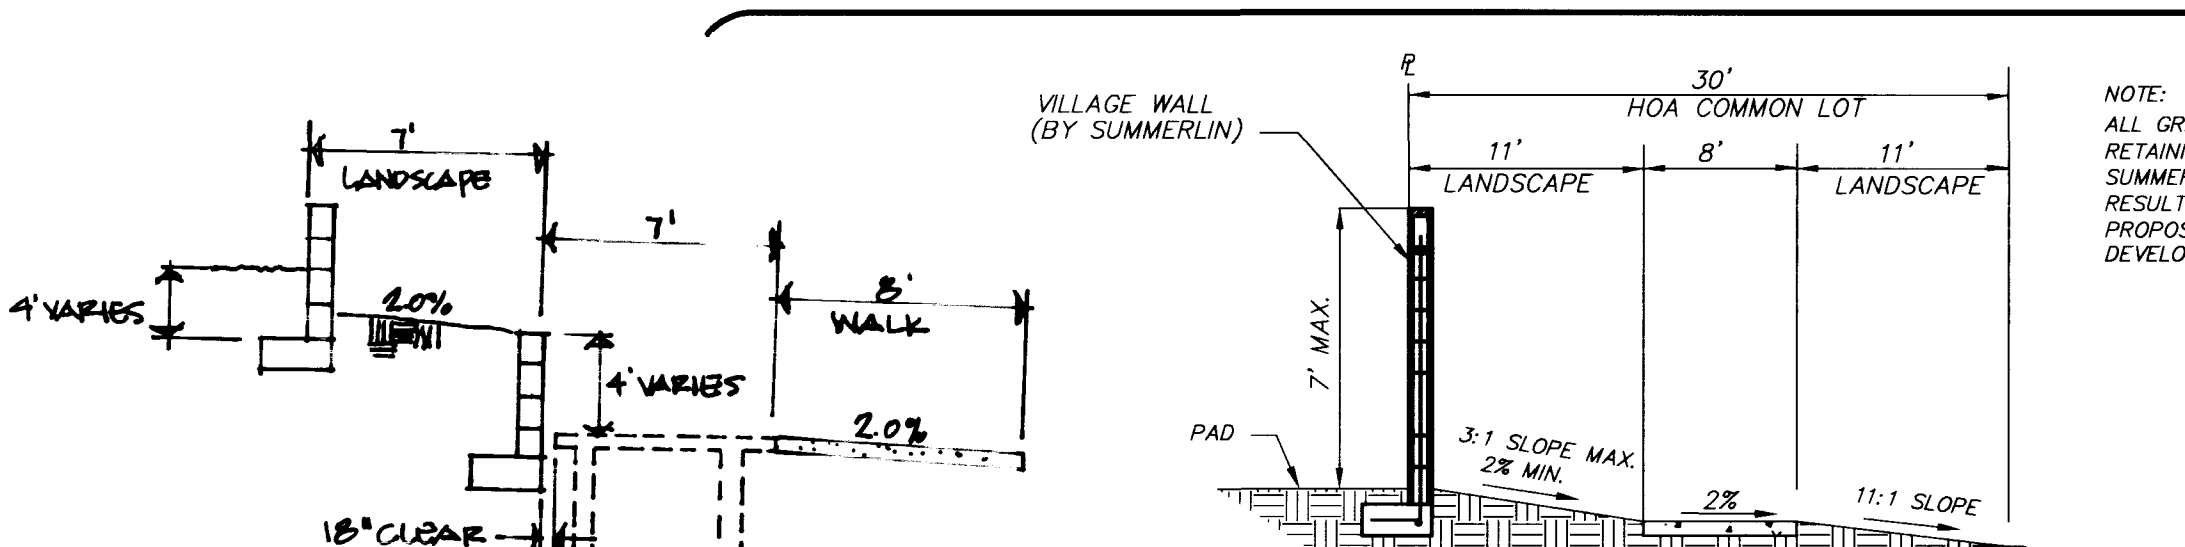


K TYPICAL WALL SECTION (SAGEBERRY DRIVE)
NO SCALE

NOTE: IF MORE THAN 7' HIGH WALL IS NEEDED,
DUAL RETAINING WALLS WILL BE REQUIRED.

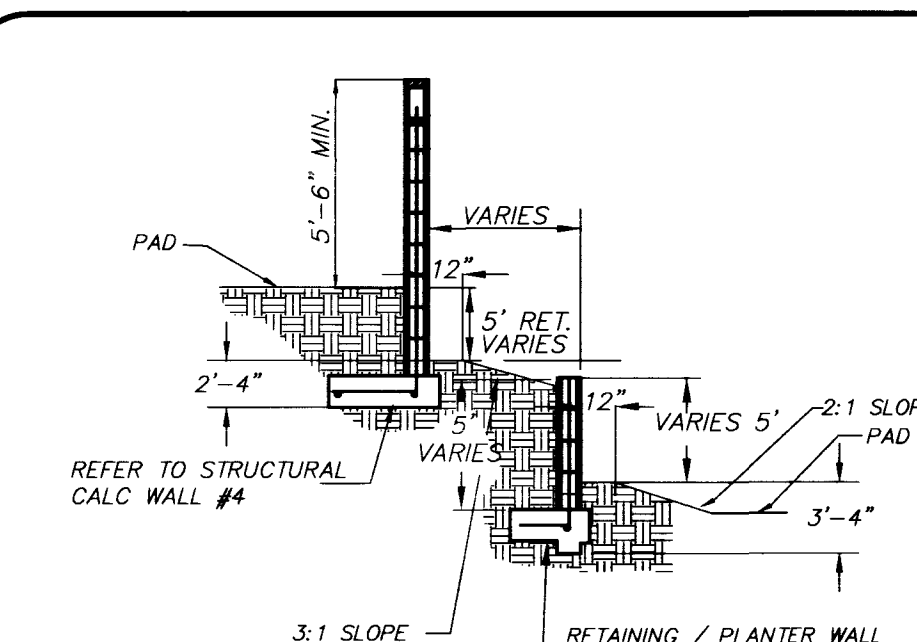


L TYPICAL WALL SECTION
NO SCALE

NOTE: IF MORE THAN 7' HIGH WALL IS NEEDED,
DUAL RETAINING WALLS WILL BE REQUIRED.

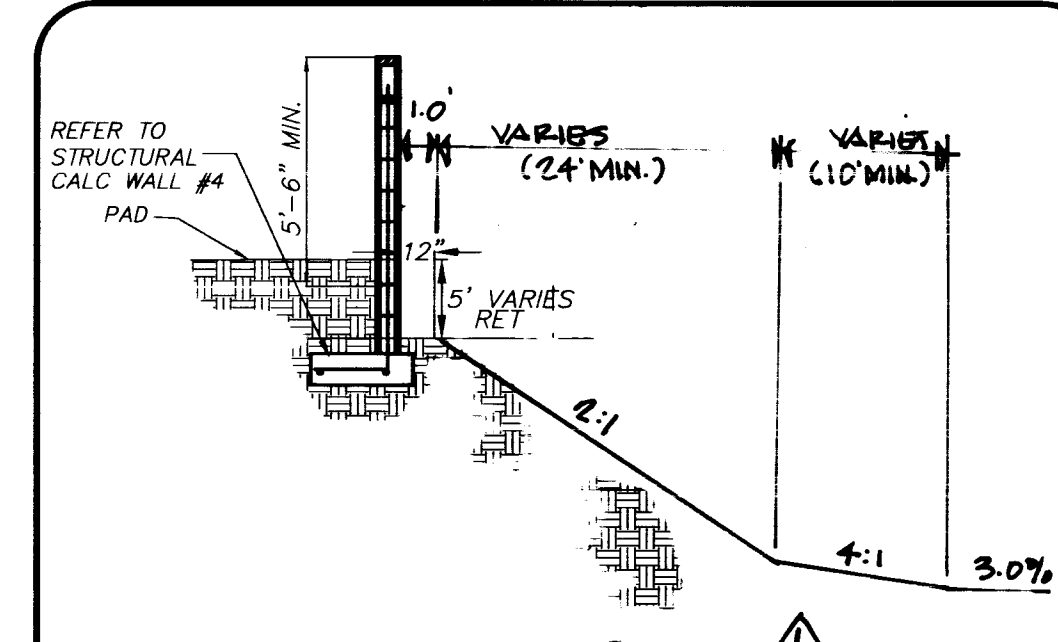

M TYPICAL WALL SECTION
NO SCALE

NOTE: IF MORE THAN 7' HIGH WALL IS NEEDED,
DUAL RETAINING WALLS WILL BE REQUIRED.

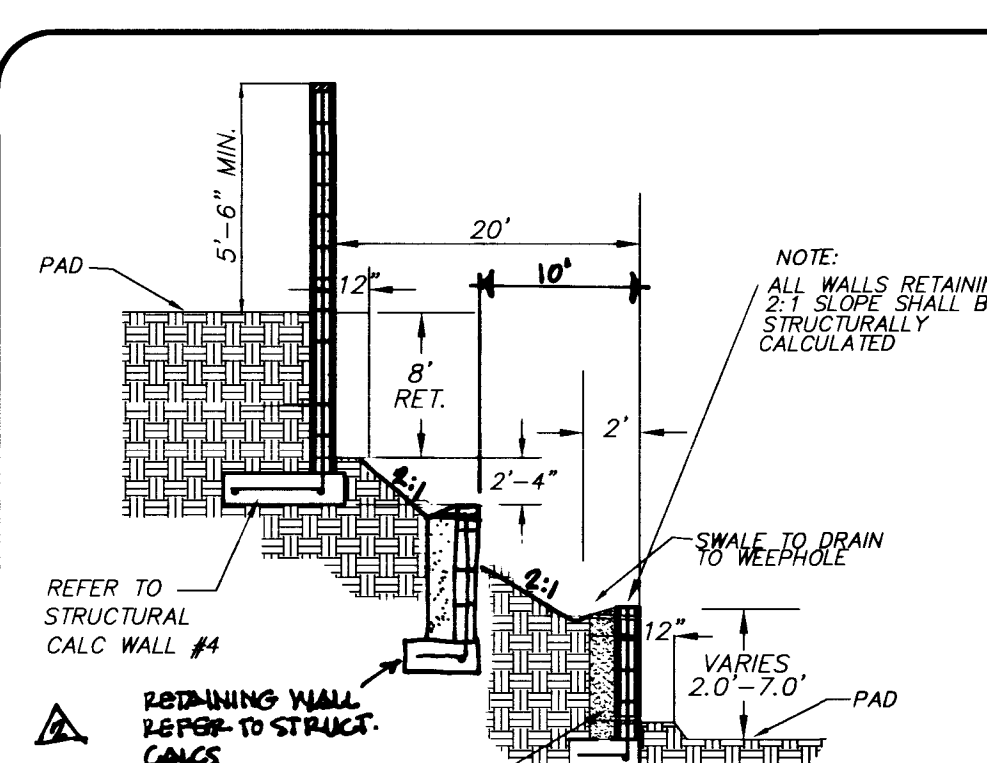


N TYPICAL WALL SECTION
NO SCALE







NOTE: IF MORE THAN 7' HIGH WALL IS NEEDED,
DUAL RETAINING WALLS WILL BE REQUIRED.

APPROVED FOR CONSTRUCTION ESN.018

LAS VEGAS VALLEY WATER DISTRICT DATE

Quality Control checked by: ☐

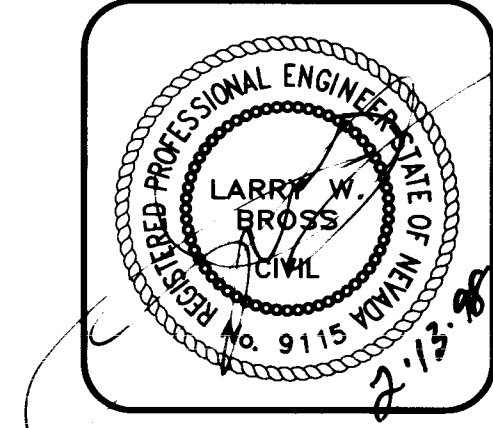

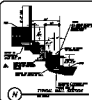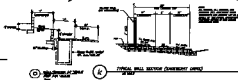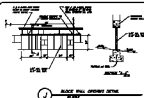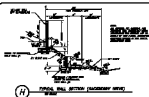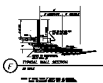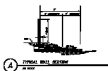



