

H:\CAD\LAND\4820\4820.03 Fr1 Jan 19 15:26:20 1996 PLOTTED BY: R.T.S.



BENCHMARK

CONTROL POINT "SPARKY" A
BRASS CAP SET IN CONCRETE STAMPED
"#12" SET BY GC WALLACE ENGINEERING AND
USED FOR BENCHMARK FOR SUMMERLIN
CONSTRUCTION
ELEVATION = 2825.38 (SUMMERLIN DATUM) - PROJECT DRAIN
ELEVATION EQUATION: SUMMERLIN ELEV. - 0.217 * (HMD) * 29 ELEV.
ELEVATION EQUATION: NVD ELEV. + 2.437 * (HMD) * 88 ELEV.


2 working
days

Call
before you
Dig

1-800-227-2800

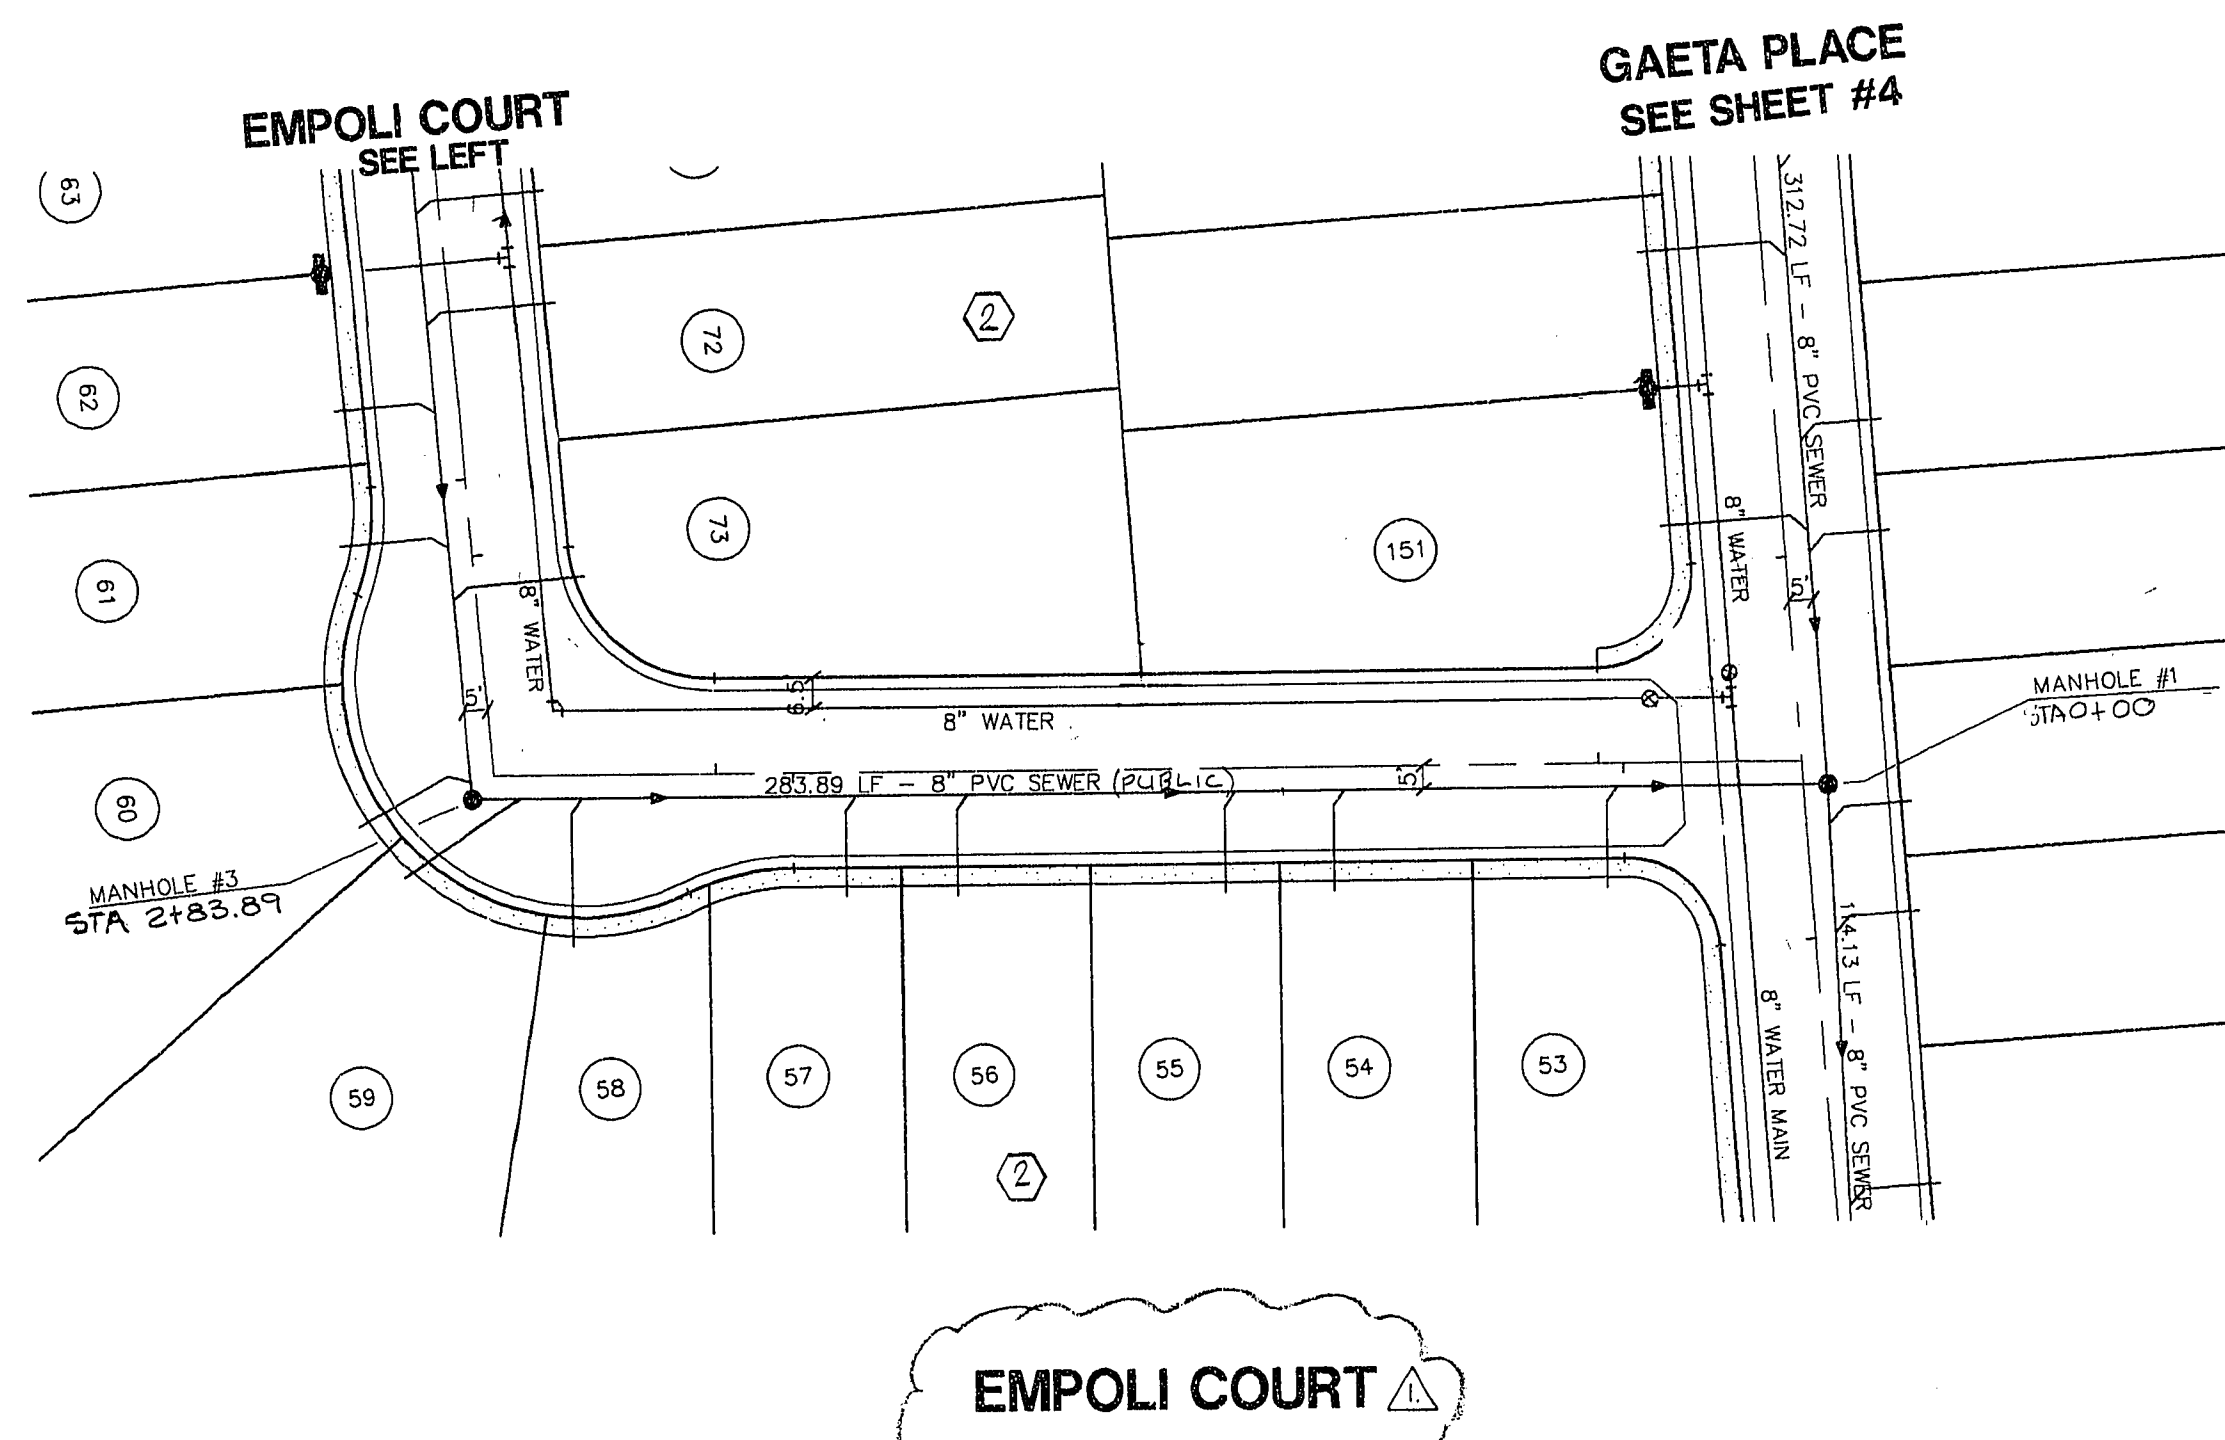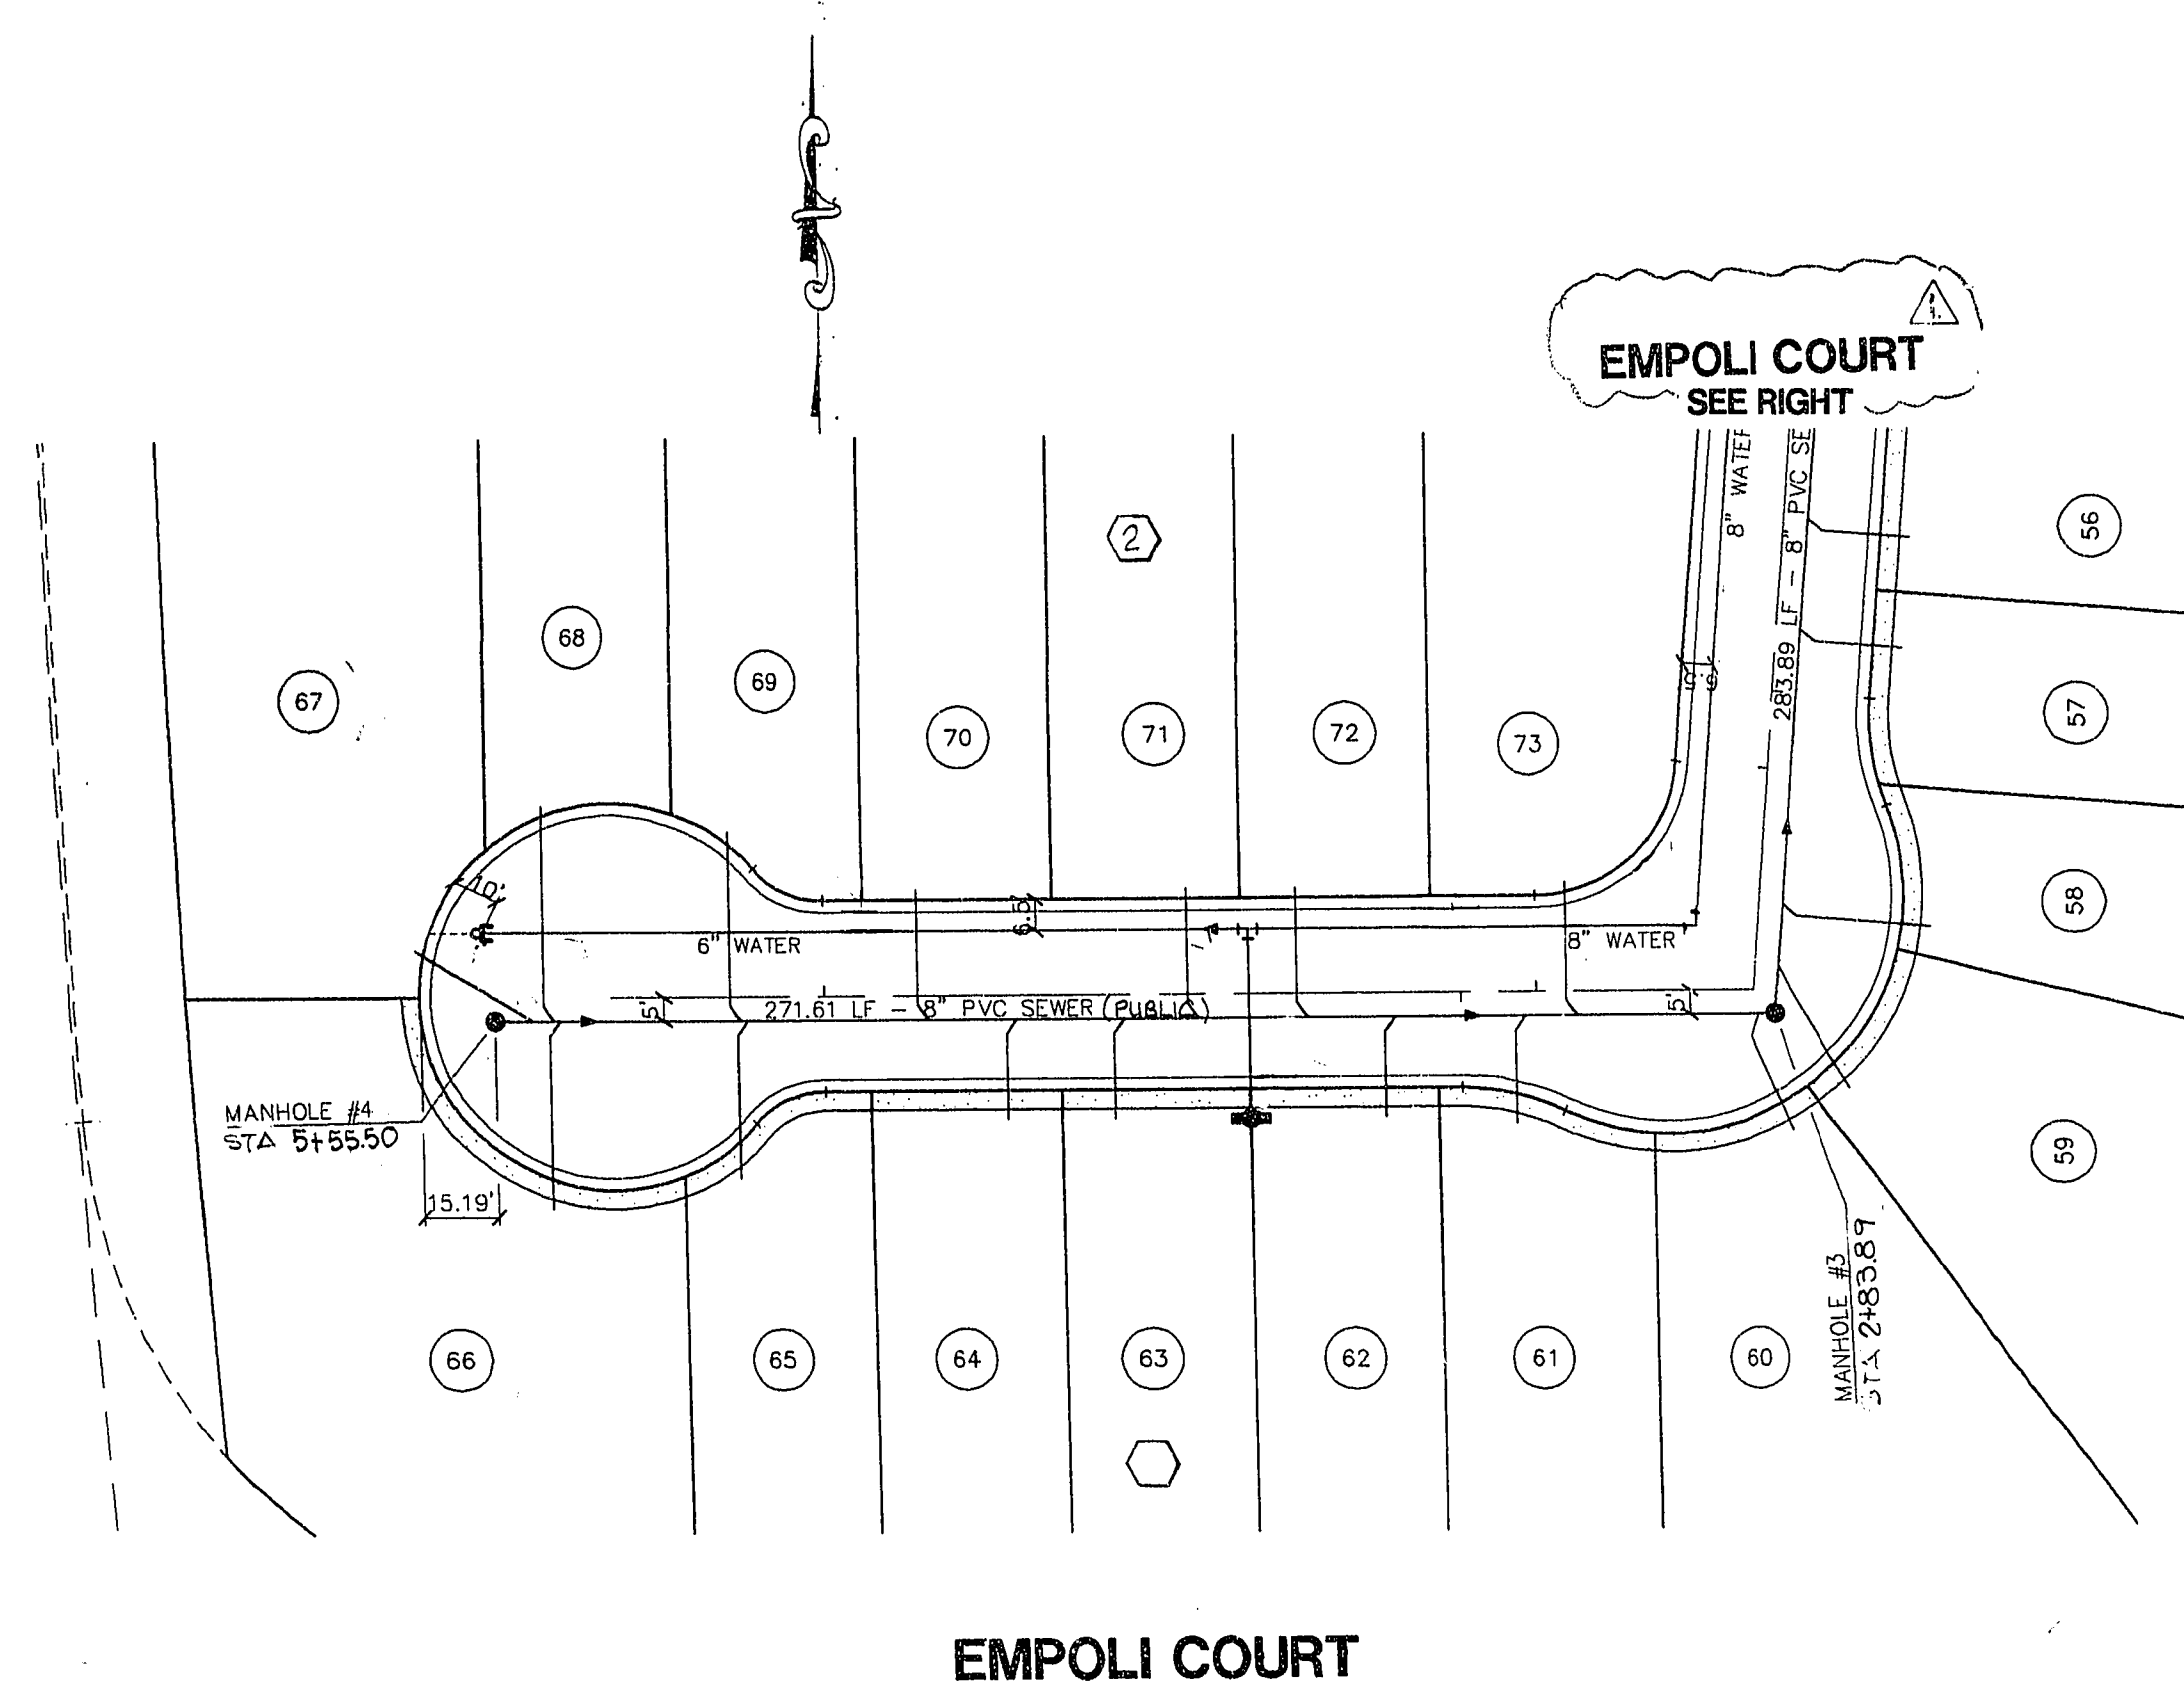


- NOTES:
- 1) HORIZONTAL CONTROL FOR ALL SEWER MANHOLES IS SHOWN ON MASTER UTILITY PLAN SHEET #6
 - 2) ALL SANITARY SEWERS ARE PUBLICLY OWNED AND MAINTAINED

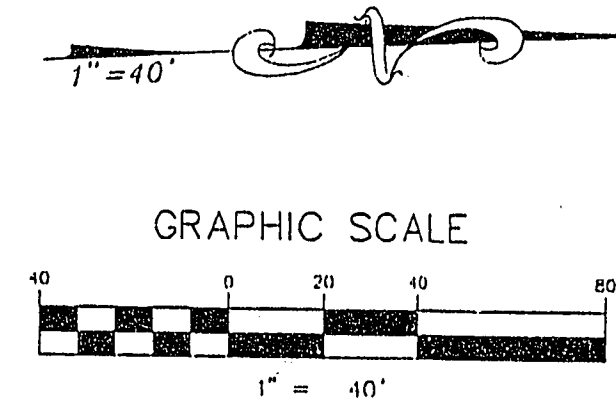

SEWER PLAN - PROFILE EMPOLI COURT

INDIAN HILLS
UNIT 3

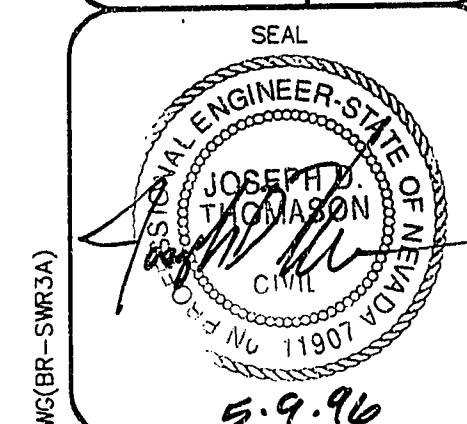

WO NO. 4820-3

BY

DATE JAN. '96

SCALE HORIZ. 1\"/>

SHEET

8

OF 8 SHEETS

PLASTER DEVELOPMENT
CITY OF LAS VEGAS



CONSULTING ENGINEERS • PLANNERS • LAND SURVEYORS
2727 SOUTH RAINBOW BOULEVARD
LAS VEGAS, NEVADA 89102-5148 PHONE (702) 873-7550 FAX (702) 362-2597

REV	DATE	BY	REASON
1	7-31-96	MDM	REV STREET NAME
2			
3			
4			