


**RECORD OF SURVEY
MONUMENT TIE MAP**
LOS LOMAS AT THE PASEOS PARCEL "F" @ VILLAGE 23A
A COMMON INTEREST COMMUNITY

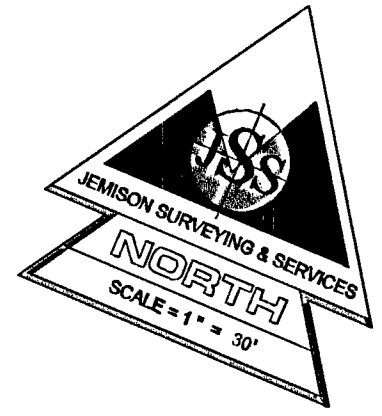

LEGEND

- (NOTE: SOME SYMBOLS HAVE BEEN EXAGGERATED IN SCALE FOR CLARITY)
- FOUND MONUMENT PLS 8352 UNLESS NOTED OTHERWISE
 - SET TYPE IV REFERENCE MONUMENT PLS 10598
 - STREET CENTERLINE
 - - - RIGHT-OF-WAY/LOT LINE

124953

058-4791