


GRAPHIC SCALE

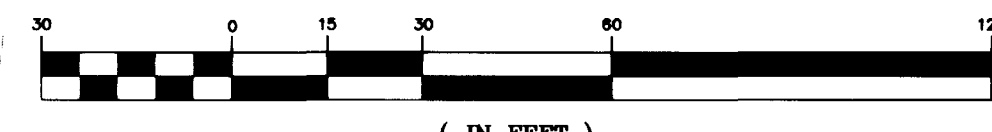

AVOID HITTING OVERHEAD POWER LINES. IT'S COSTLY.  
**CALL BEFORE YOU DIG**  
 1-702-593-6111

Avoid cutting underground utility lines. It's costly.  
**Call before you Dig.**  
 1-800-227-2600  
 UNDERGROUND SERVICE (USA)




No.	Radius	Delta	Length	Tangent
(1)	30.00	86°49'49"	45.46'	28.38'
(2)	30.00	87°02'43"	45.58'	28.49'
(3)	6.00	180°00'00"	18.85'	12.00'
(4)	6.00	180°00'00"	18.85'	12.00'
(5)	25.00	76°37'49"	33.44'	19.75'
(6)	25.00	15°52'45"	6.93'	3.49'
(7)	1167.00	00°23'56"	8.12'	4.06'
(8)	19.50	31°37'49"	10.76'	5.52'
(9)	40.50	15°22'19"	10.87'	5.47'
(10)	40.50	56°03'28"	39.62'	21.56'
(11)	40.50	45°17'46"	32.02'	16.90'
(12)	40.50	75°40'28"	53.49'	31.46'
(13)	40.50	50°39'33"	35.81'	19.17'
(14)	40.50	32°08'10"	22.72'	11.67'
(15)	19.50	62°31'28"	21.28'	11.84'
(16)	1206.00	00°06'52"	2.41'	1.21'
(17)	20.00	88°14'50"	30.80'	19.40'
(18)	617.50	06°49'24"	73.54'	36.81'
(19)	598.00	06°49'24"	71.22'	35.65'
(20)	578.50	06°04'33"	61.35'	30.70'
(21)	20.00	88°03'37"	30.74'	19.33'
(22)	1206.00	01°09'52"	24.51'	12.26'
(23)	1206.00	01°46'16"	37.28'	18.64'
(24)	1206.00	01°52'00"	39.29'	19.65'
(25)	1186.50	11°09'14"	230.98'	115.86'
(26)	1167.00	01°55'55"	39.35'	19.88'
(27)	1167.00	01°44'44"	35.55'	17.78'
(28)	25.00	25°08'20"	10.97'	5.57'
(29)	25.00	67°34'17"	29.48'	16.73'

**BENCHMARKS**  
 G.C. WALLACE PROJECT BENCHMARK NO. 107, A 2" BRASS DISK IN CONCRETE, LYING SOUTH 44°00'38" EAST, 641.6' FROM THE INTERSECTION OF HUALAPAI WAY AND TOWN CENTER DRIVE.  
 ELEVATION = 2877.96  
 CITY OF LAS VEGAS BENCHMARK  
 QLV001954 RIVET & PLATE IN TOP OF CURB NW SIDE OF TOWN CENTER DR. AND SOUTH CIRCLE ISLAND.  
 2725.923 NAVD 1929 DATUM  
 2728.37 NAVD 1988 DATUM (831.6074 M)  
 2726.19 SUMMERLIN DATUM • PROJECT DATUM  
 SUMMERLIN DATUM = NAVD - 2.18'

**BASIS OF BEARINGS**  
 SOUTH 11°18'20" EAST, BEING THE BEARING OF THE CENTERLINE OF PAVILION CENTER DRIVE AS SHOWN BY "THE ARBORS AT SUMMERLIN VILLAGE 11/12 UNIT 2A" ON FILE IN BOOK 75, PAGE 75 OF PLATS IN THE CLARK COUNTY RECORDER'S OFFICE CLARK COUNTY, NEVADA.

**NAPA HILLS DRIVE**  
 PUBLIC STREET  
 SCALE: HORIZ: 1"=30'  
 VERT: 1"=3'

**SUTTER HILLS AVENUE**  
 PUBLIC STREET  
 SCALE: HORIZ: 1"=30'  
 VERT: 1"=3'

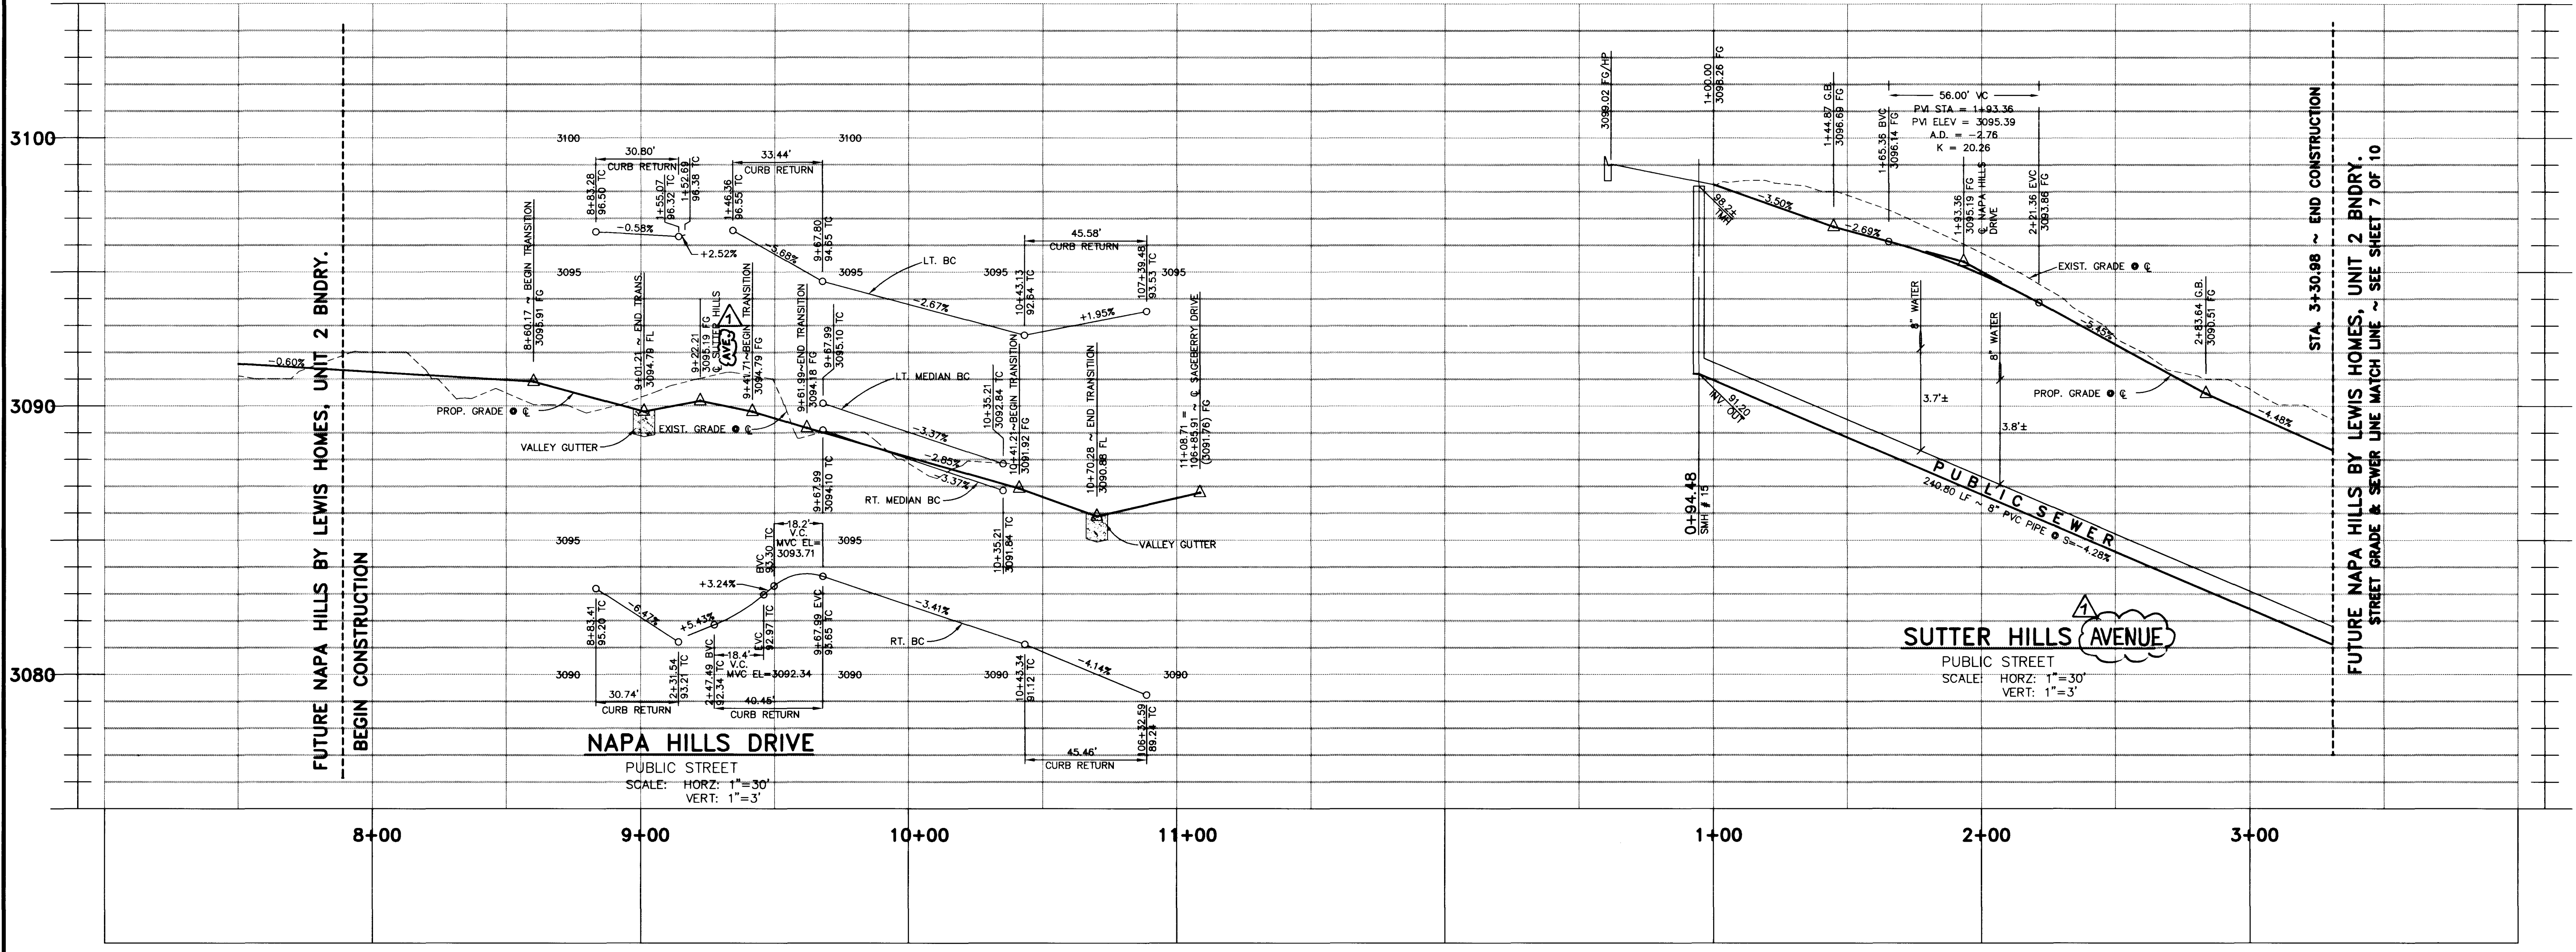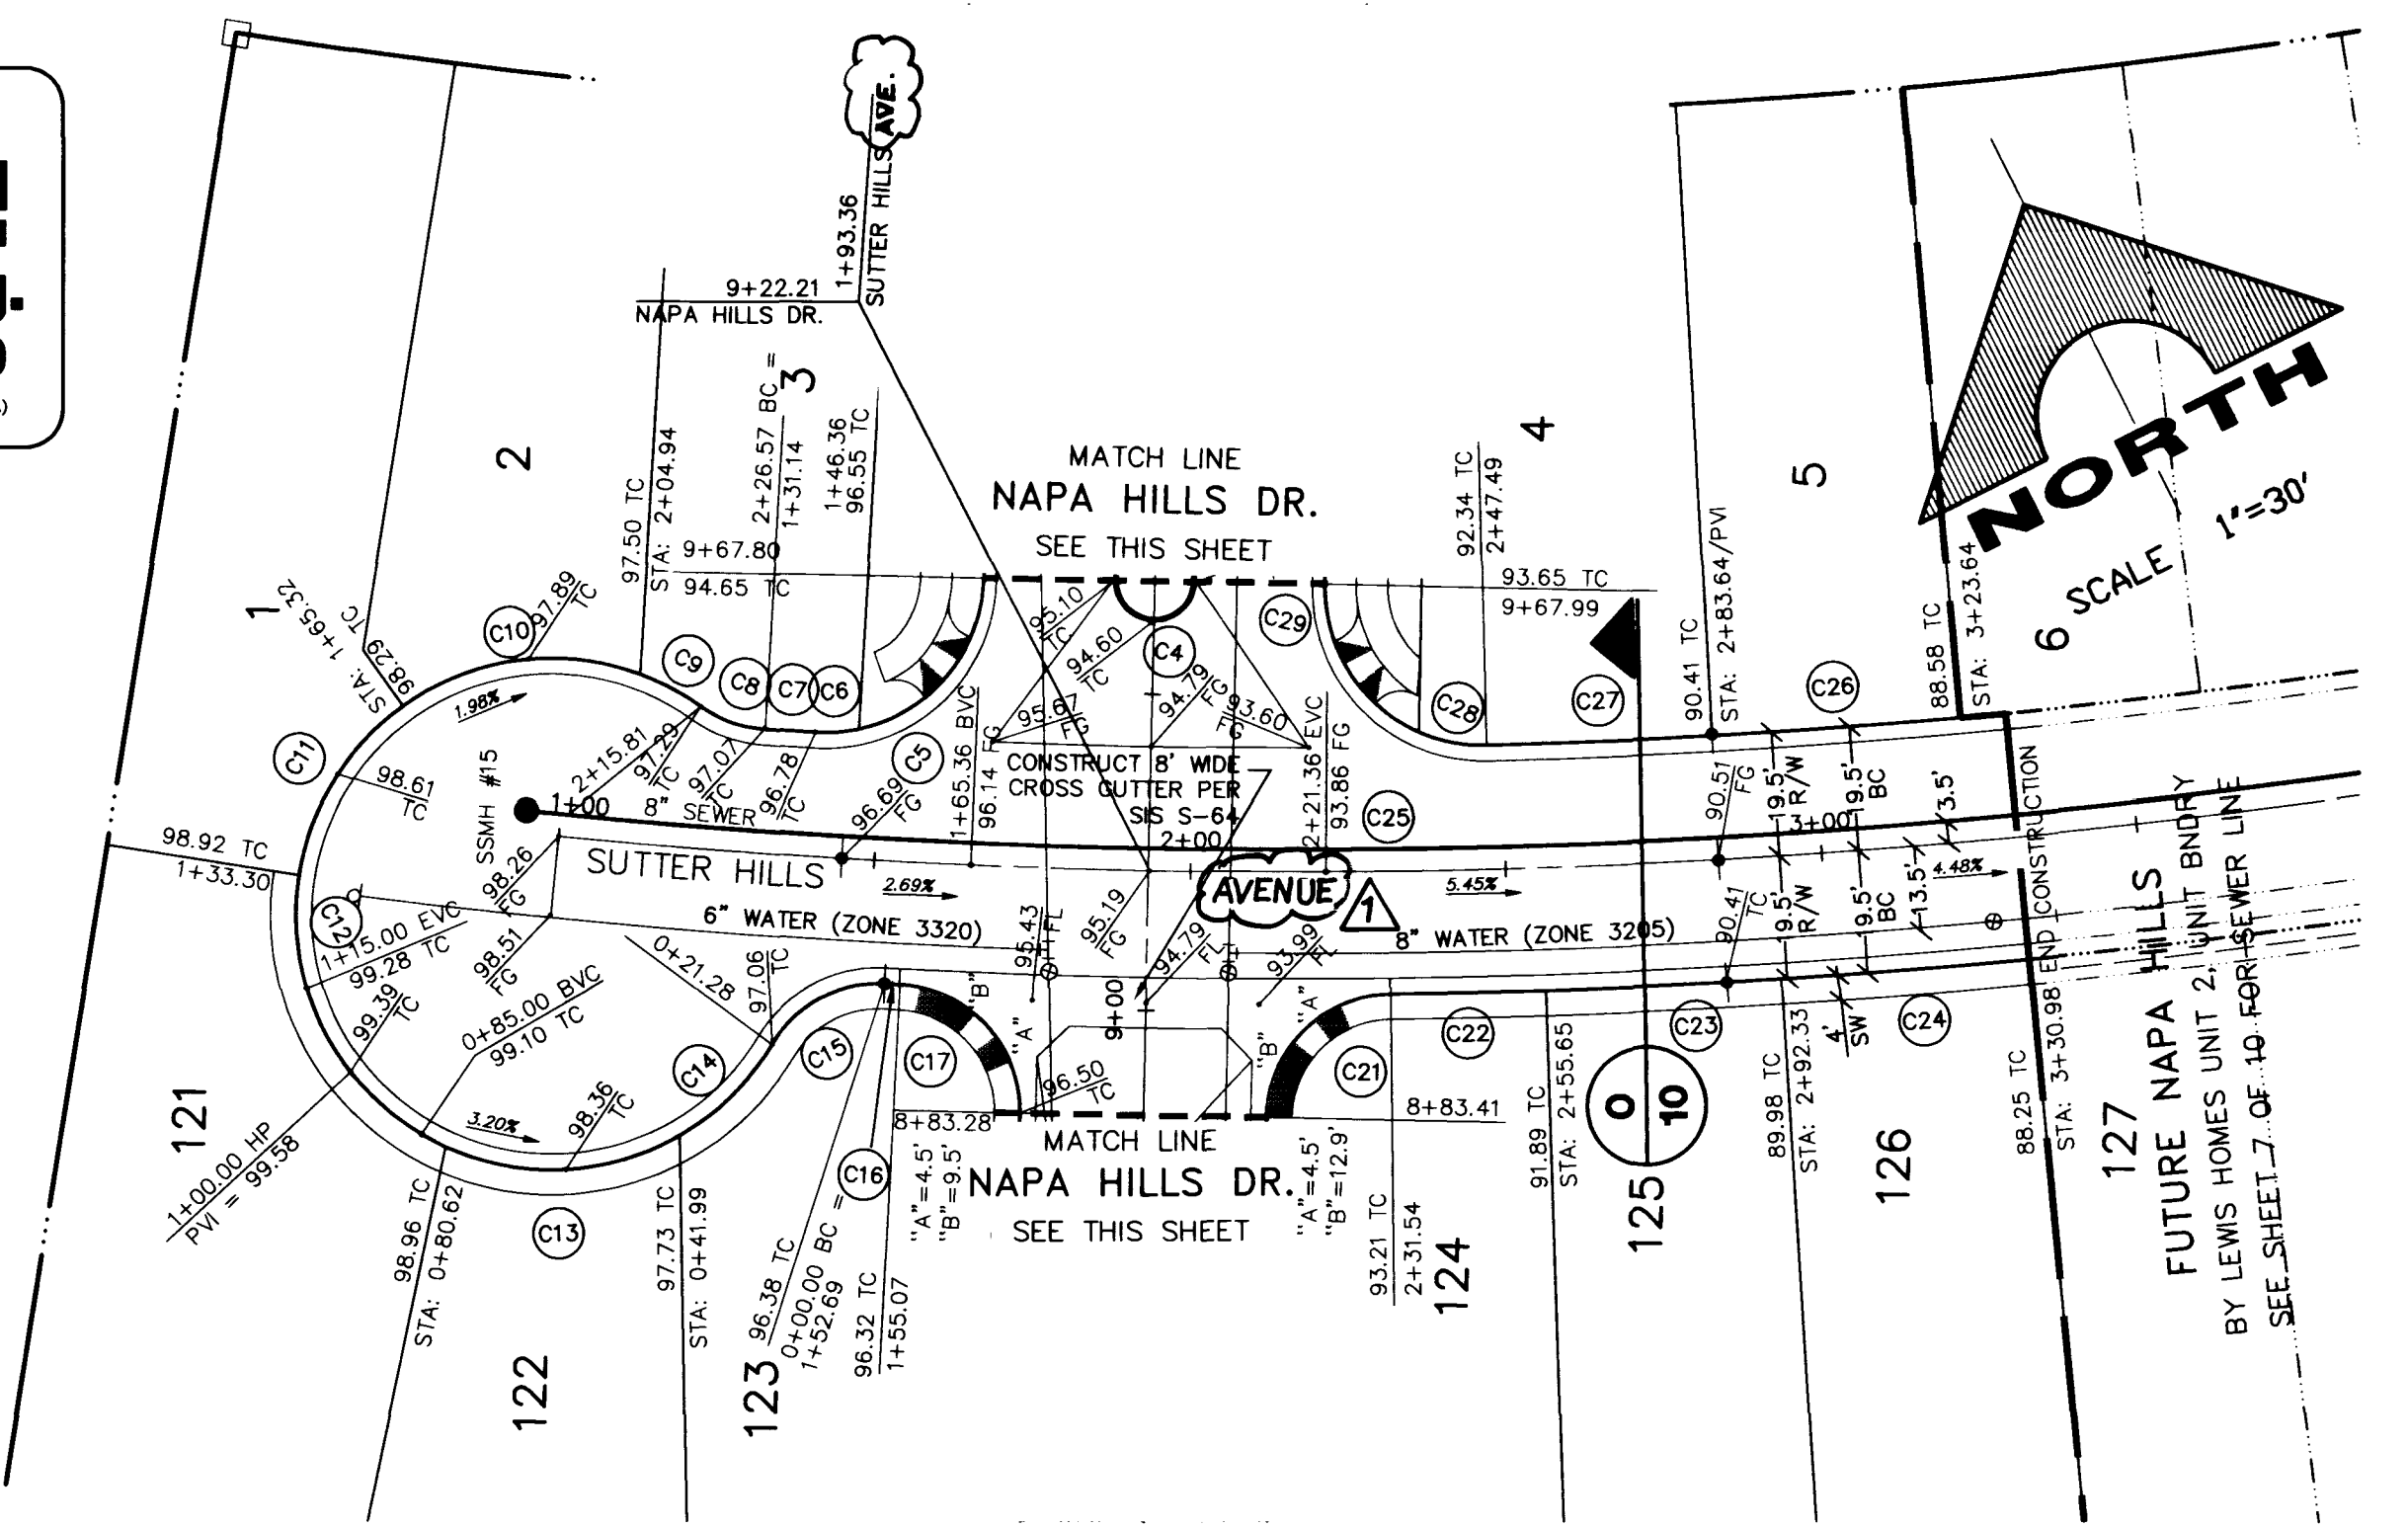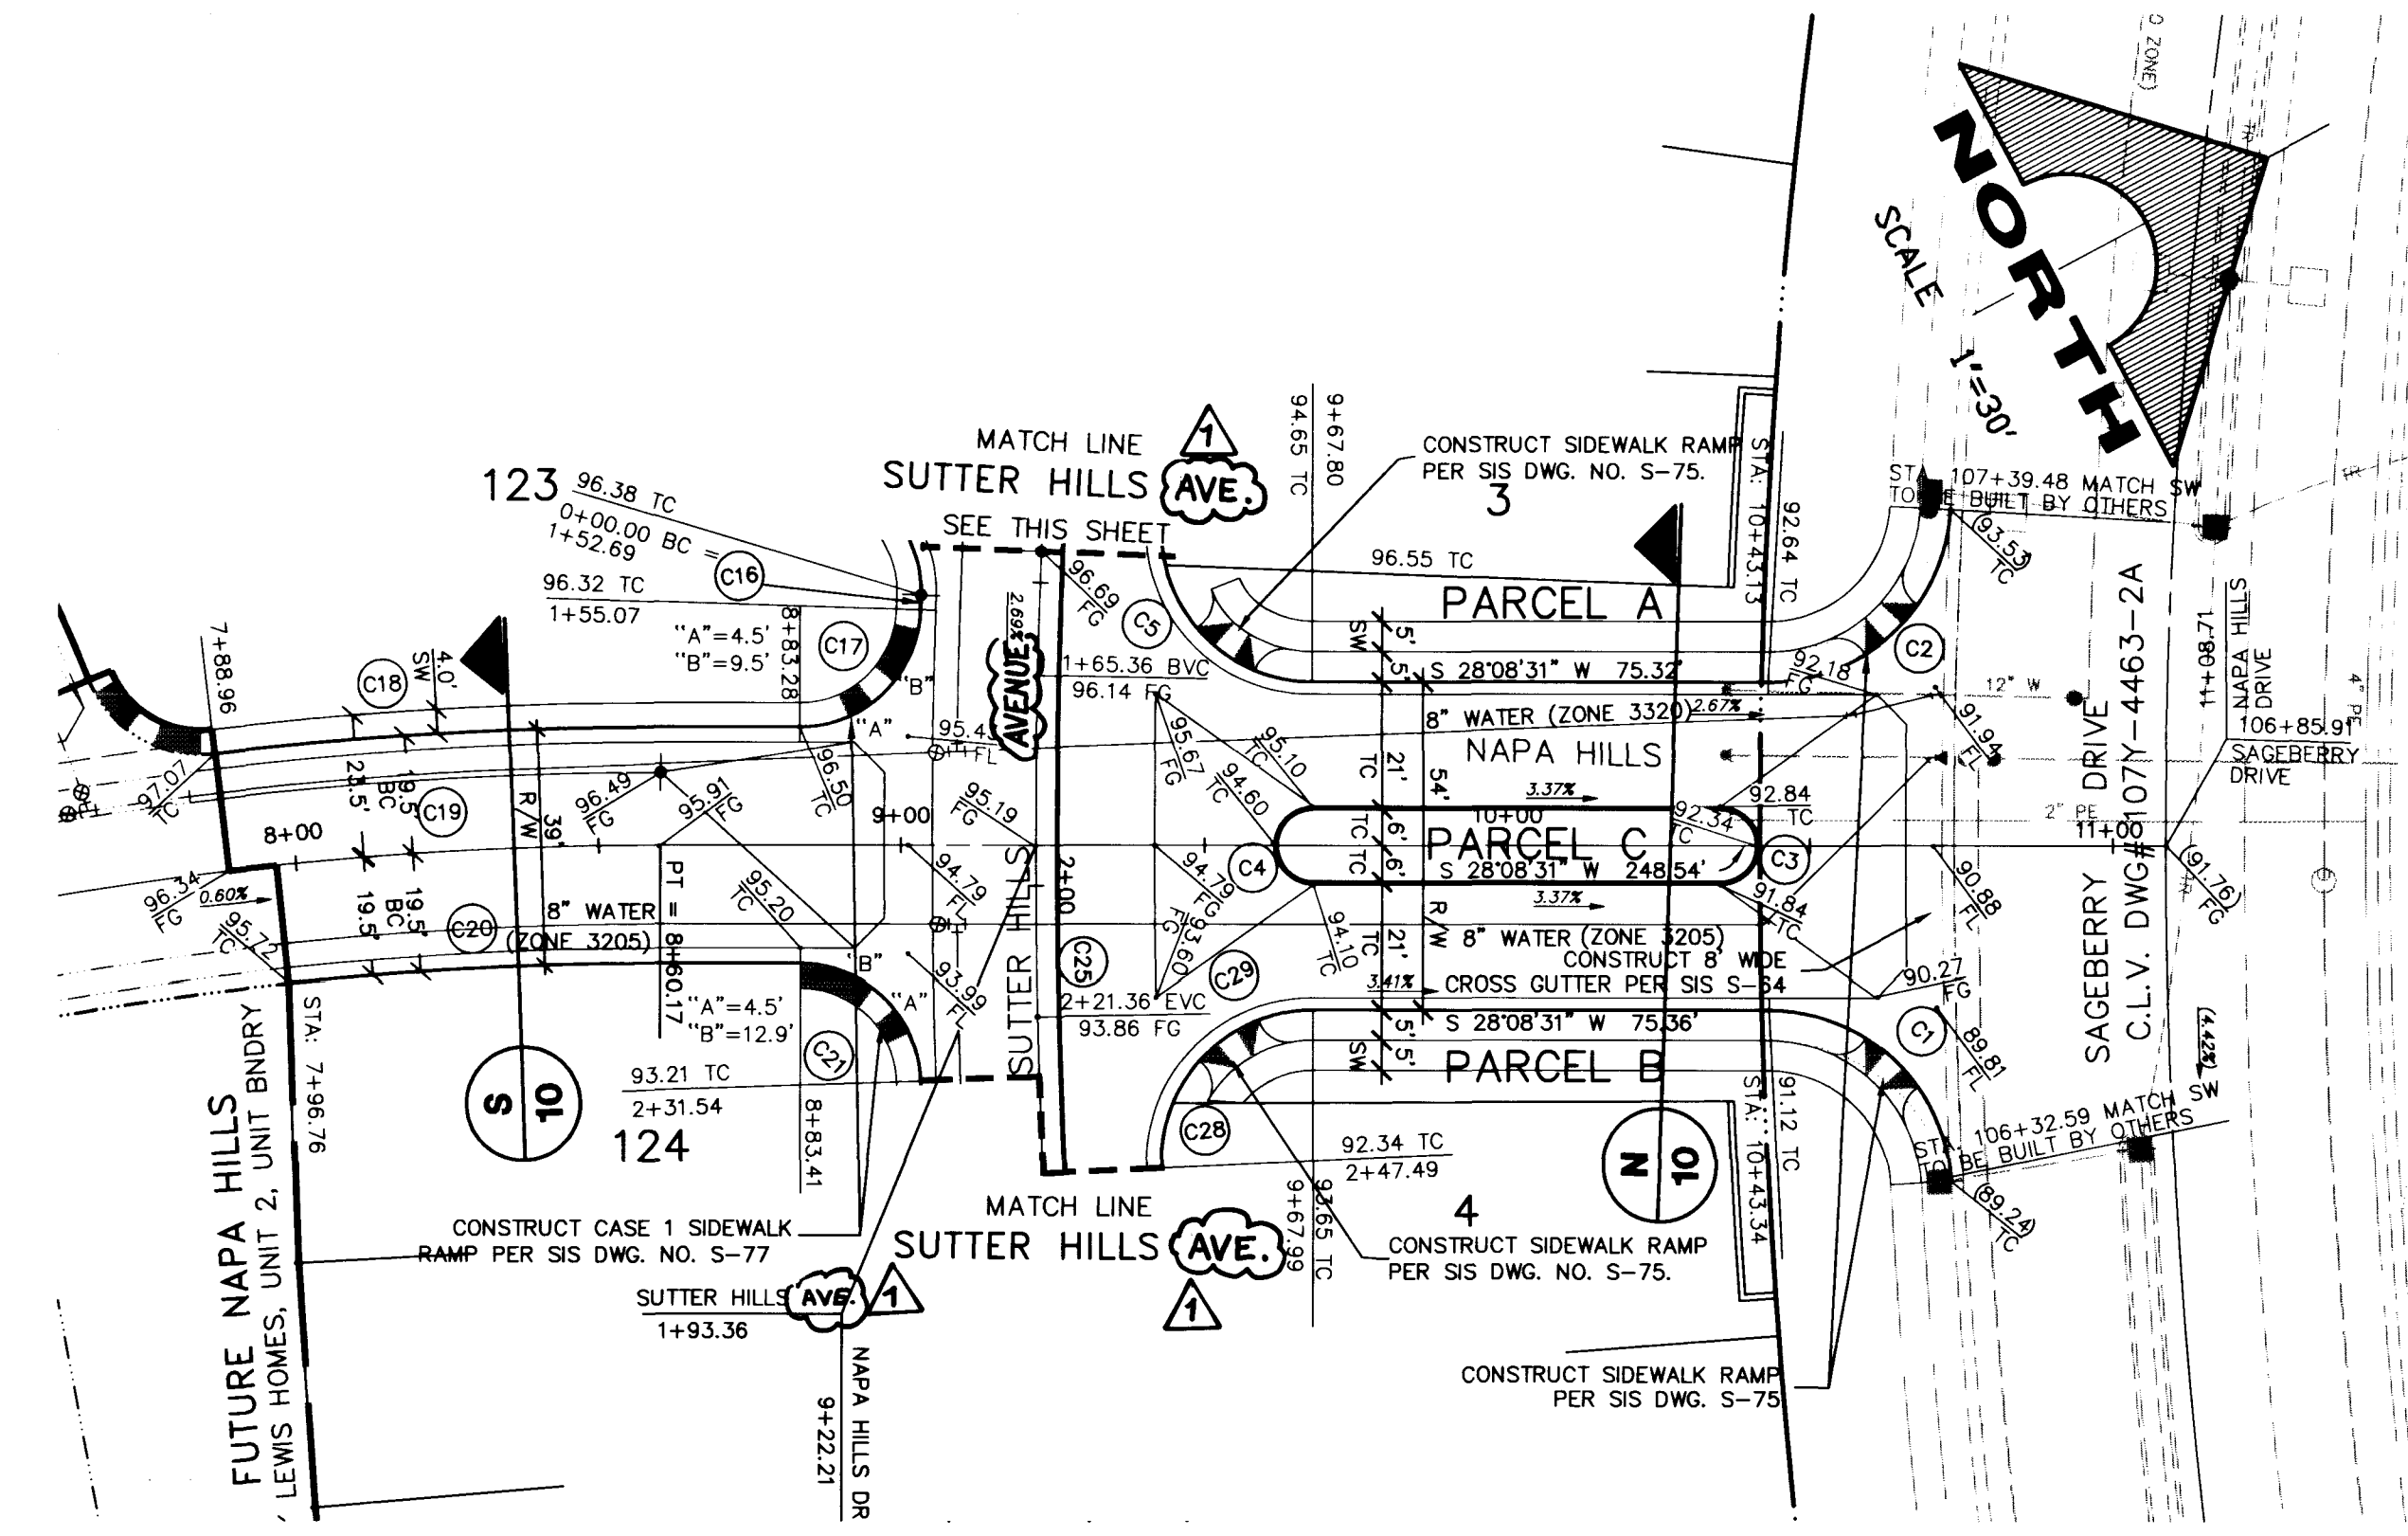



RECOMMENDED DATE: 5/21/98  
 DATE: 6/19/98  
 P.E. NEL

REVISIONS:  
 1. REV. DATE: 6/19/98  
 2. REV. DATE: 6/19/98  
APPROVAL:  
 H.S. APPROVAL  
 G.C. WALLACE, INC. ENGINEERING/ARCHITECTURE  
 1855 SOUTH RANNEY BLVD., LAS VEGAS, NEVADA 89102  
 PHONE: (702) 883-1800

**NAPA HILLS BY LEWIS HOMES UNIT NO. 1**  
**NAPA HILLS DR. & SUTTER HILLS DR.**  
**PLAN AND PROFILE**  
**7+96.76 TO 11+08.71 & 100 TO 330.98**

SHEET  
**6**  
 OF 10 SHEETS

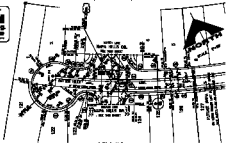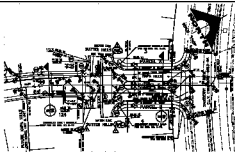







