GRAPHIC SCALE

30 0 15 30 60 120

(IN FEET)
1 inch = 30 ft.

BENCHMARKS

G.C. WALLACE PROJECT BENCHMARK NO. 107, A 2" BRASS DISK IN CONCRETE, LYING SOUTH 44°00'38" EAST, 641.6' FROM THE INTERSECTION OF HUALAPAI WAY AND TOWN CENTER DRIVE.

ELEVATION = 2877.96
CITY OF LAS VEGAS BENCHMARK
OLV0019S4 RIVET & PLATE IN TOP OF CURB NW SIDE OF TOWN CENTER DR. AND SOUTH CIRCLE ISLAND.
2725.923 NGVD 1929 DATUM
2728.37 NAVD 1988 DATUM (831.6074 M)
2726.19 SUMMERLIN DATUM * PROJECT DATUM
SUMMERLIN DATUM = NAVD − 2.18'

BASIS OF BEARINGS

SOUTH 11°16'20" EAST, BEING THE BEARING OF THE CENTERLINE OF PAVILION CENTER DRIVE AS SHOWN BY "THE ARBORS AT SUMMERLIN VILLAGE 11/12 UNIT 2A" ON FILE IN BOOK 75, PAGE 75 OF PLATS IN THE CLARK COUNTY RECORDER'S OFFICE CLARK COUNTY, NEVADA.

AVOID CUTTING UNDERGROUND UTILITY LINES. IT'S COSTLY.
Call before you Dig.
1-800-227-2600
UNDERGROUND SERVICE ALERT (USA)

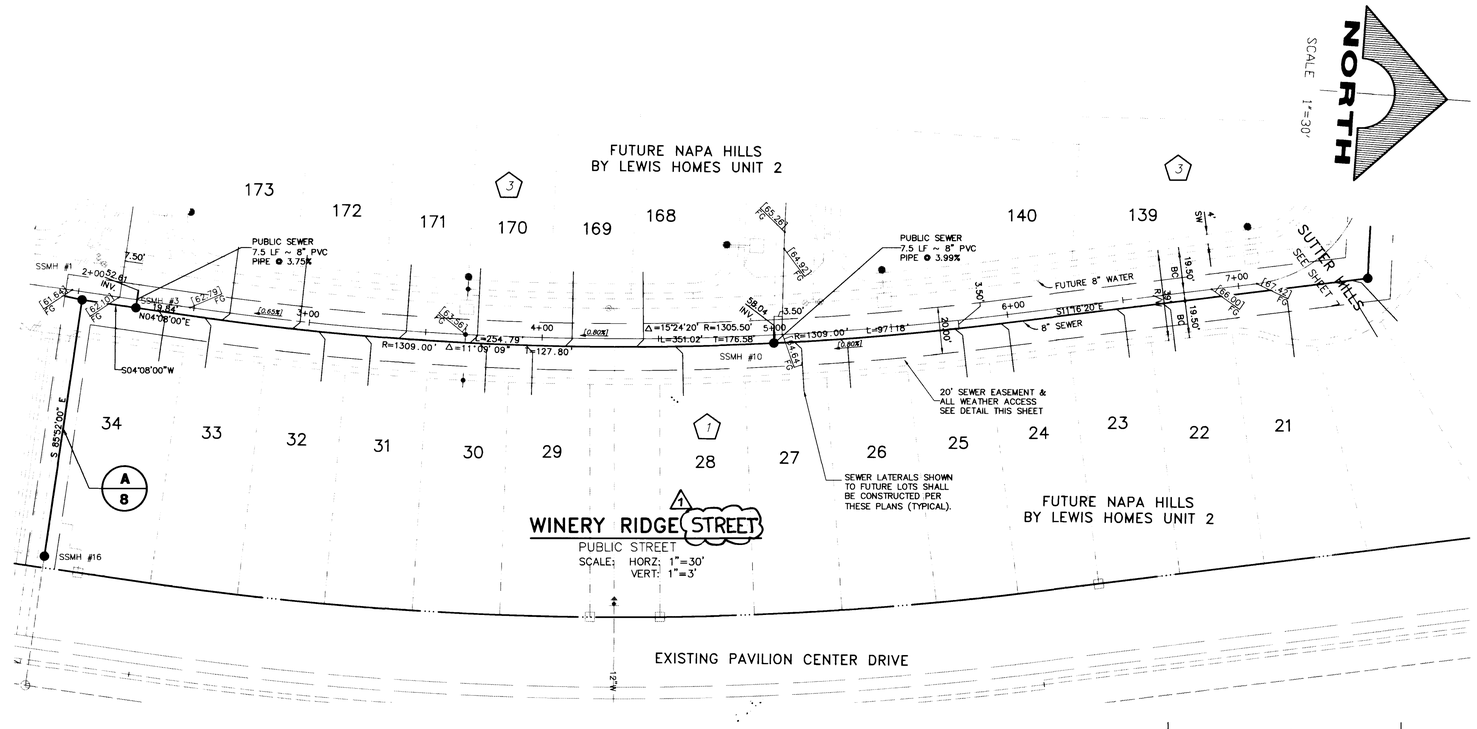

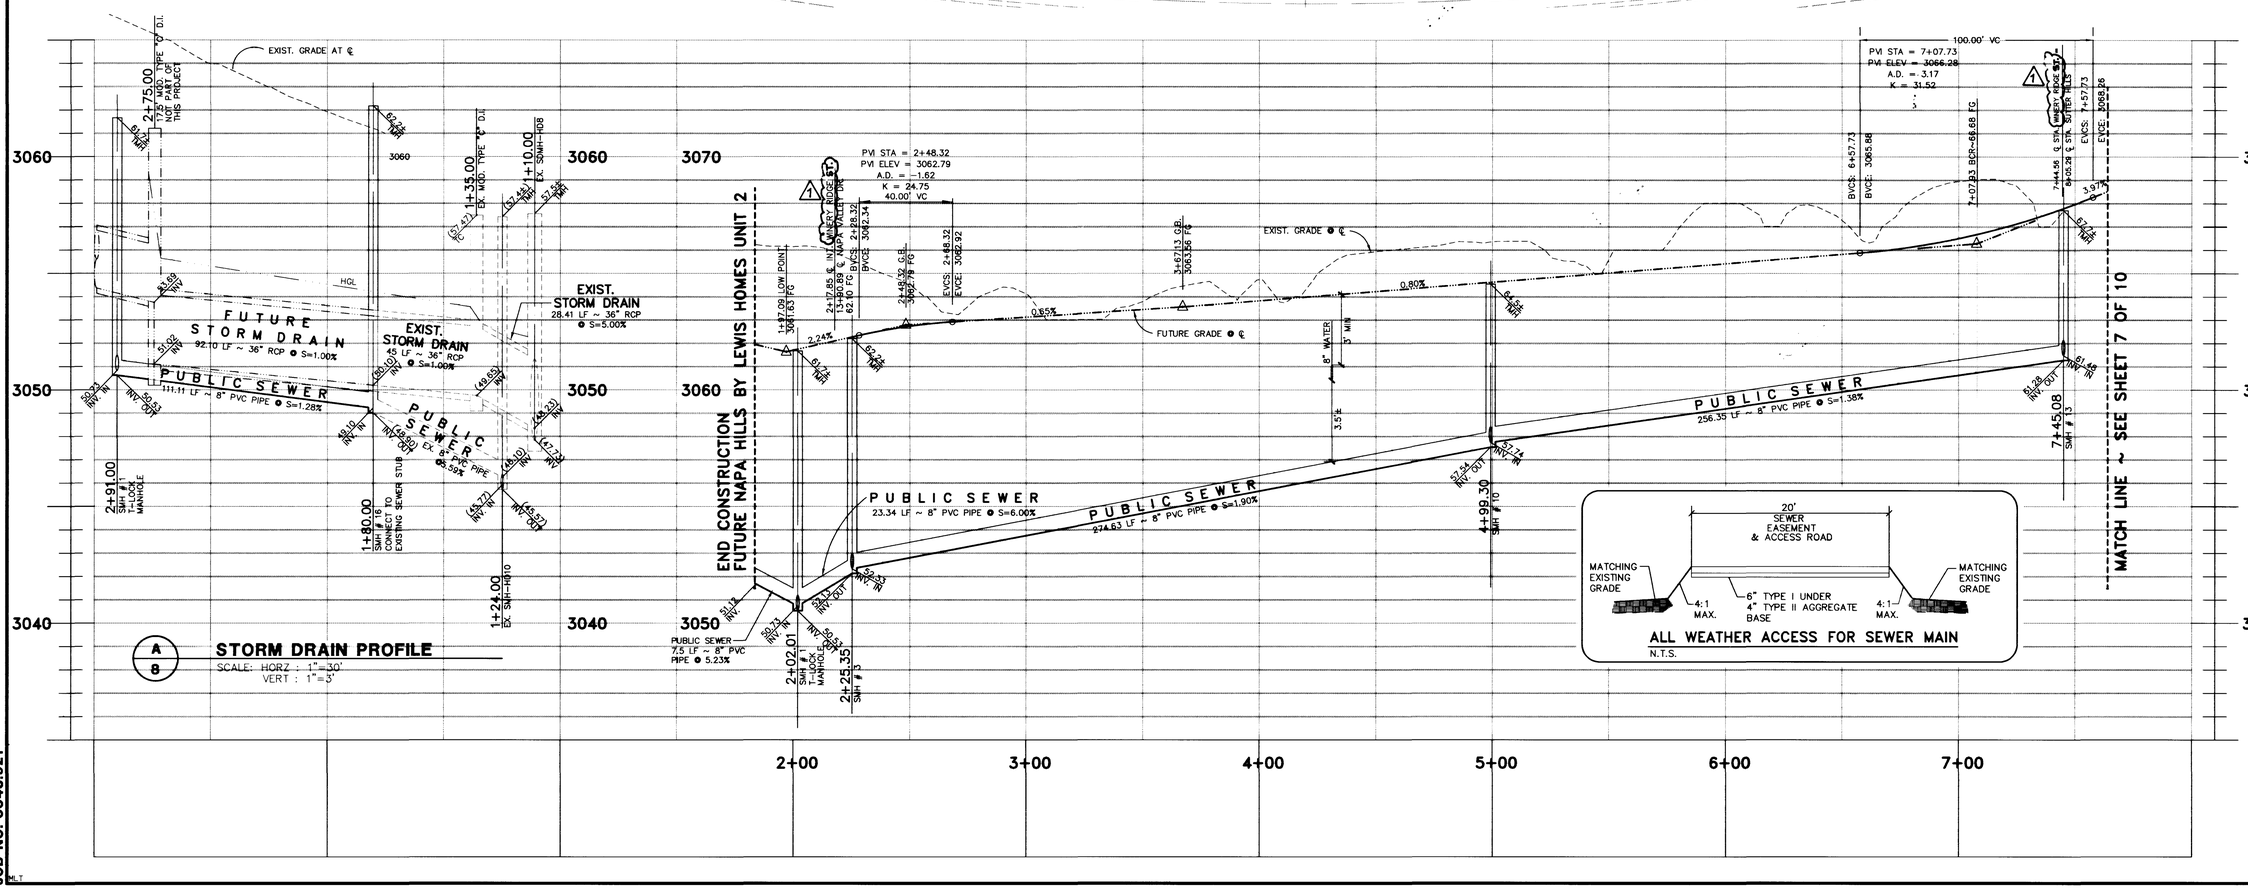

G.C. WALLACE, INC.
Engineering/Architecture
1555 SOUTH RAINBOW BLVD./LAS VEGAS, NEVADA 89146
PHONE (702) 383-1280

REV.	DATE	DESCRIPTION	DATE	APPROVAL
1	6/16/98	REV. STREET NAMES	6/21/98	KS

RECOMMENDED 5/26/98 DATE P.E. NO.

NAPA HILLS BY LEWIS HOMES
UNIT NO. 1
WINERY RIDGE STREET SANITARY SEWER
SEWER PLAN AND PROFILE
1+00 TO 7+44.56

SHEET 8 OF 10 SHEETS

PLOTTED: 02/24/98

JOB NO. 5543.921

8553

107Y-4560-1

GRAPHIC SCALE

BENCHMARKS

BASIS OF BEARINGS

Call before you Dig.




WINERY RIDGE STREET

PUBLIC STREET


NORTH


PUBLIC SEWER

ALL WEATHER ACCESS FOR SEWER MAIN


C.C. WALLACE, INC.


UNIT NO. 1

SANITARY SEWER PROFILE

SHEET 8

