


AVOID CUTTING UNDERGROUND UTILITY LINES. IT'S COSTLY.
Call before you Dig.
 1-800-227-2600
 UNDERGROUND SERVICE ALERT (USA)

BENCHMARKS
 G.C. WALLACE PROJECT BENCHMARK NO. 107, A 2" BRASS DISK IN CONCRETE, LYING SOUTH 44°00'38" EAST, 641.6' FROM THE INTERSECTION OF HUALAPAI WAY AND TOWN CENTER DRIVE.
 ELEVATION = 2877.96
 CITY OF LAS VEGAS BENCHMARK
 OLVD01954 RIVET & PLATE IN TOP OF CURB NW SIDE OF TOWN CENTER DR. AND SOUTH CIRCLE ISLAND.
 2725.923 NAVD 1929 DATUM
 2728.37 NAVD 1988 DATUM (831.6074 M)
 2726.19 SUMMERLIN DATUM * PROJECT DATUM
 SUMMERLIN DATUM = NAVD - 2.18'

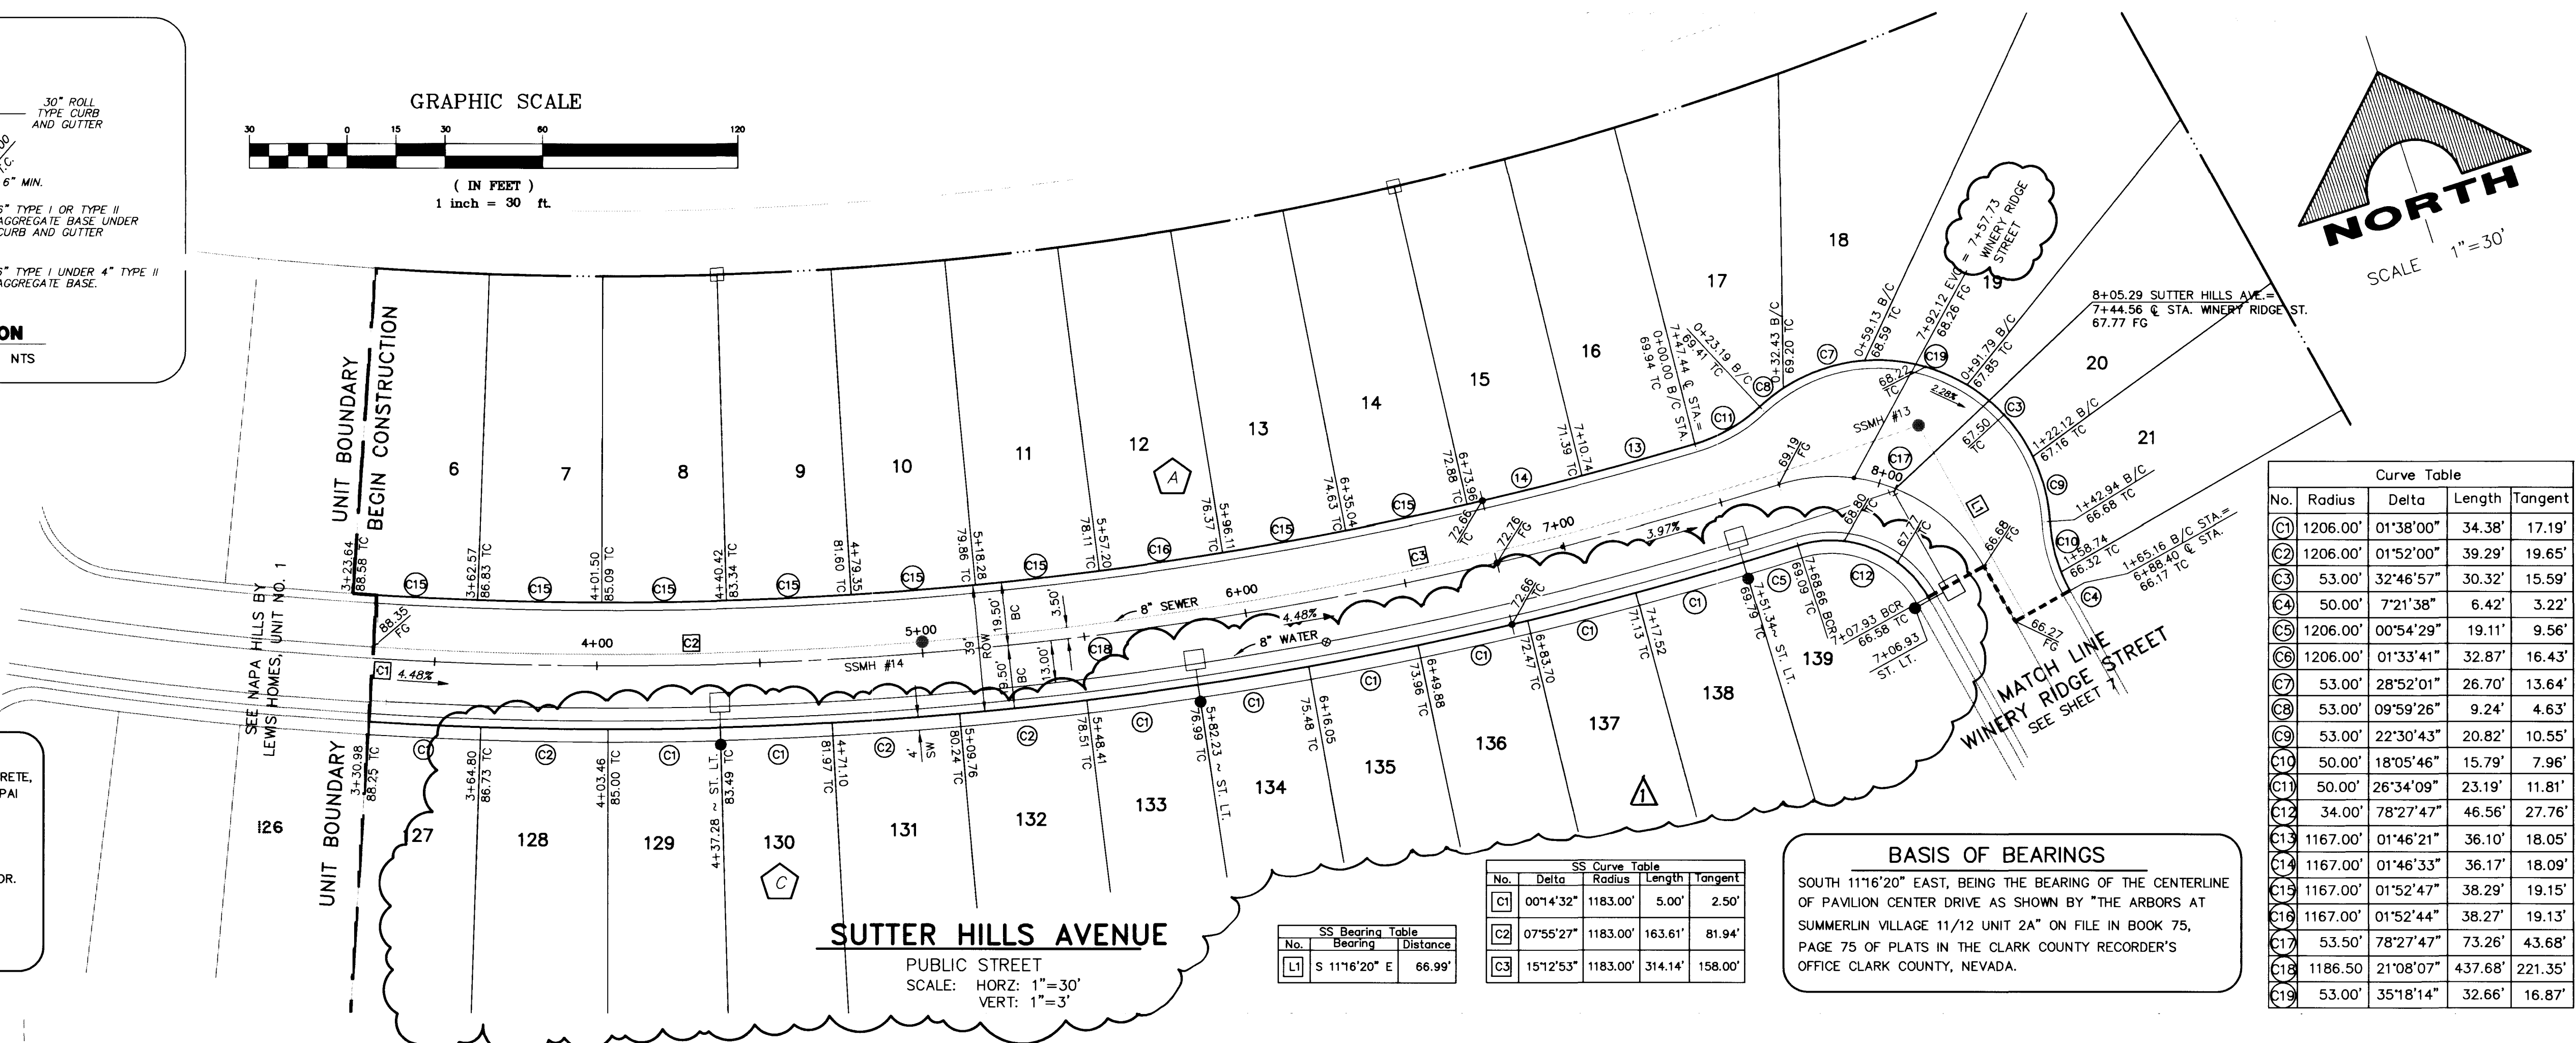


Curve Table

No.	Radius	Delta	Length	Tangent
(1)	1206.00'	01°38'00"	34.38'	17.19'
(2)	1206.00'	01°52'00"	39.29'	19.65'
(3)	53.00'	32°46'57"	30.32'	15.59'
(4)	50.00'	7°21'38"	6.42'	3.22'
(5)	1206.00'	00°54'29"	19.11'	9.56'
(6)	1206.00'	01°33'41"	32.87'	16.43'
(7)	53.00'	28°52'01"	26.70'	13.64'
(8)	53.00'	09°59'26"	9.24'	4.63'
(9)	53.00'	22°30'43"	20.82'	10.55'
(10)	50.00'	18°05'46"	15.79'	7.96'
(11)	50.00'	26°34'09"	23.19'	11.81'
(12)	34.00'	78°27'47"	46.56'	27.76'
(13)	1167.00'	01°46'21"	36.10'	18.05'
(14)	1167.00'	01°46'33"	36.17'	18.09'
(15)	1167.00'	01°52'47"	38.29'	19.15'
(16)	1167.00'	01°52'44"	38.27'	19.13'
(17)	53.50'	78°27'47"	73.26'	43.68'
(18)	1186.50'	21°08'07"	437.68'	221.35'
(19)	53.00'	35°18'14"	32.66'	16.87'

SS Curve Table

No.	Delta	Radius	Length	Tangent
(1)	00°14'32"	1183.00'	5.00'	2.50'
(2)	07°55'27"	1183.00'	163.61'	81.94'
(3)	15°12'53"	1183.00'	314.14'	158.00'

BASIS OF BEARINGS
 SOUTH 11°16'20" EAST, BEING THE BEARING OF THE CENTERLINE OF PAVILION CENTER DRIVE AS SHOWN BY "THE ARBORS AT SUMMERLIN VILLAGE 11/12 UNIT 2A" ON FILE IN BOOK 75, PAGE 75 OF PLATS IN THE CLARK COUNTY RECORDER'S OFFICE CLARK COUNTY, NEVADA.

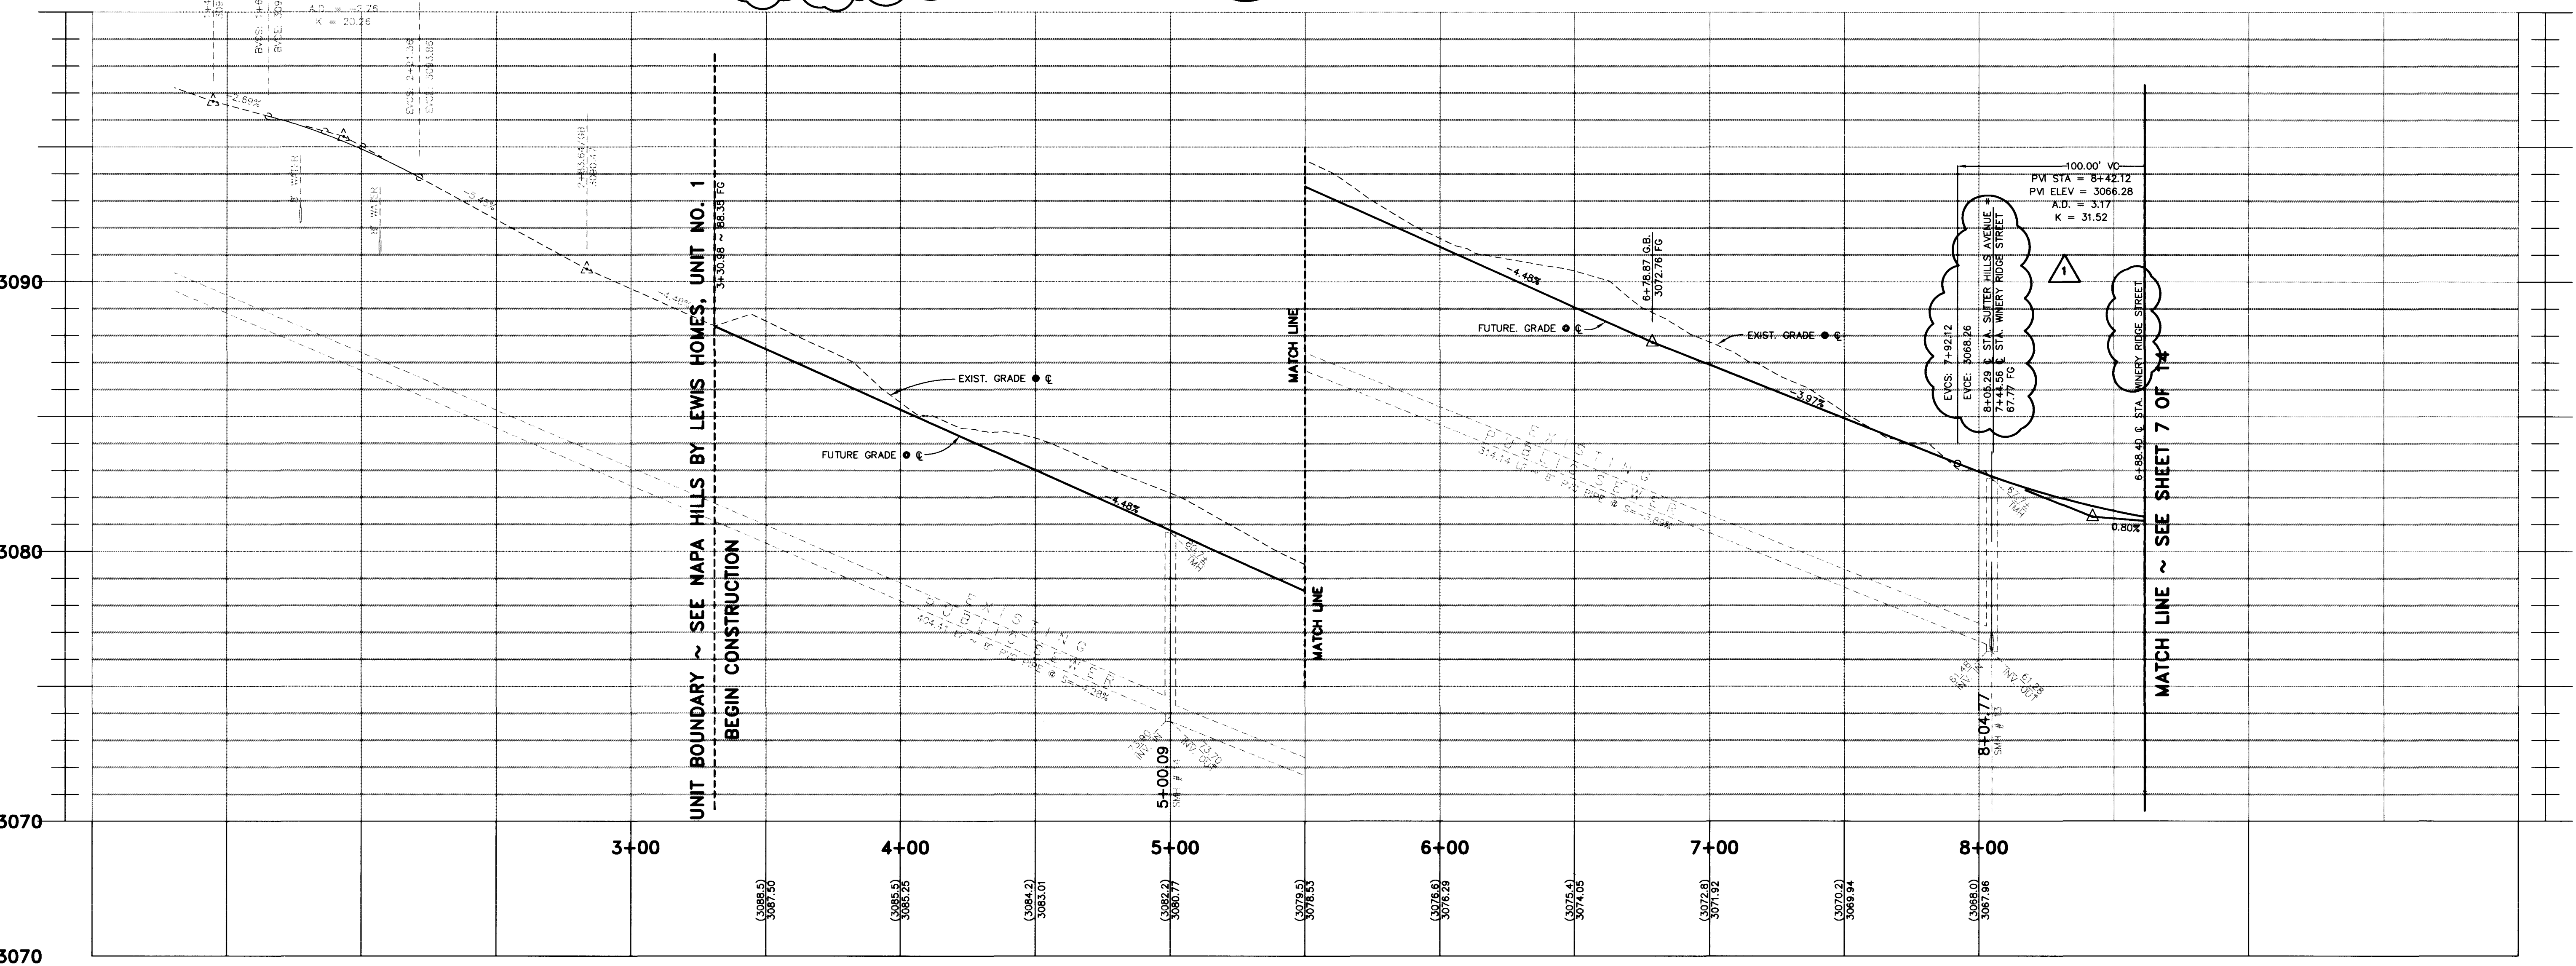

RECOMMENDED DATE: 5/27/18
 DATE: 5/27/18
 P.E. NO.:
G.C. WALLACE, INC.
 Engineering/Architecture
 1855 SOUTH SANDY BLVD./SUITE 1000 LAS VEGAS, NEVADA 89102
 PHONE (702) 363-1120

NAPA HILLS BY LEWIS HOMES UNIT NO. 2
SUTTER HILLS AVENUE
PLAN & PROFILE
3+30.98 TO 8+05.29 & 1+00 TO 2+38.84

SHEET **5**
 OF 14 SHEETS

JOB NO. 5543.921


8560

107Y-4560-2






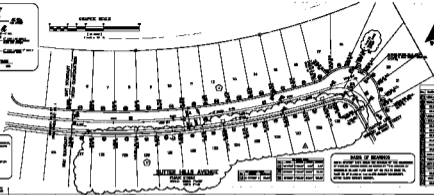

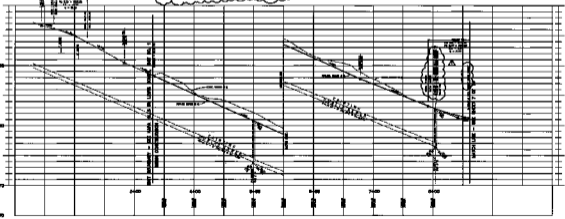


