


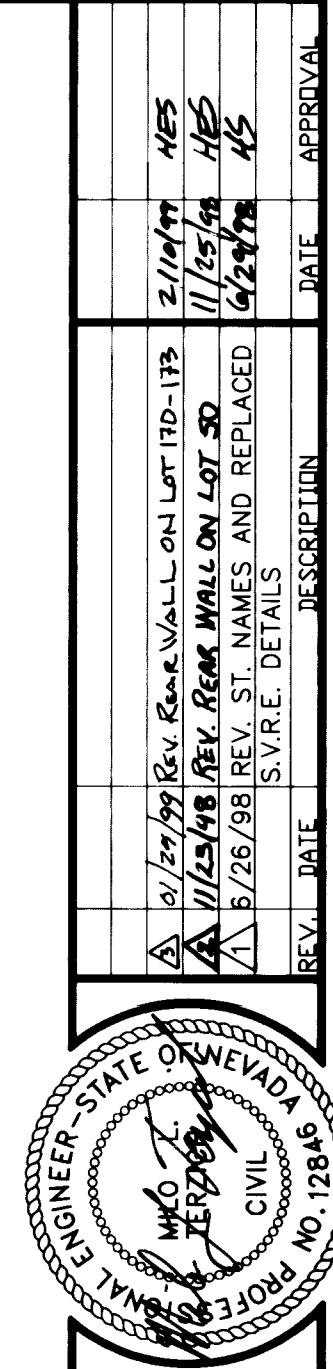

RECOMMENDED
5/27/98
DATE
E. NO.

5555 SOUTH RAINBOW BLVD./LAS VEGAS, NEVADA 89102
PHONE (702) 363-1200



G. C. WALLACE, INC.
Engineering/Architecture


UND
LY

NAPA HILLS BY LEWIS HOMES


UNIT NO. 2

GRADING PLAN I I I

SHEET
12
OF 14 SHEETS

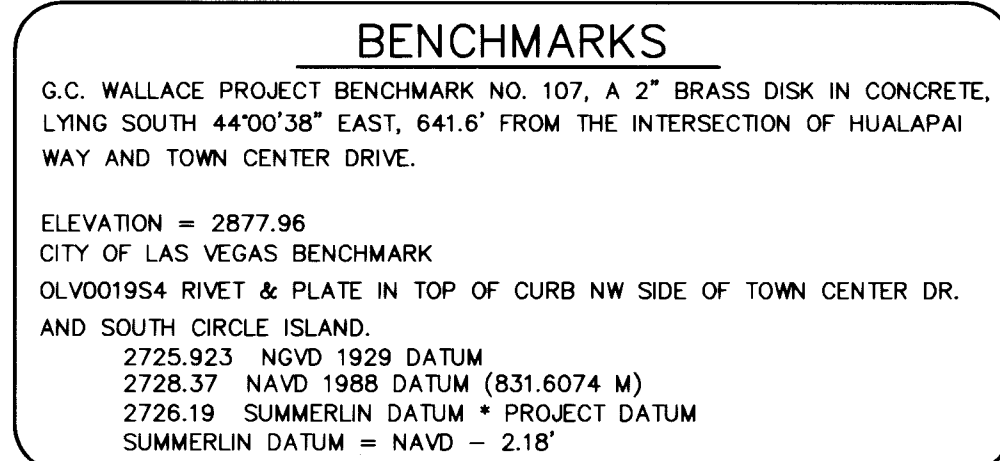

SOUTH 11°16'20" EAST, BEING THE BEARING OF THE CENTERLINE OF PAVILION CENTER DRIVE AS SHOWN BY "THE ARBORS AT SUMMERLIN VILLAGE 11/12 UNIT 2A" ON FILE IN BOOK 75, PAGE 75 OF PLATS IN THE CLARK COUNTY RECORDER'S OFFICE CLARK COUNTY, NEVADA.

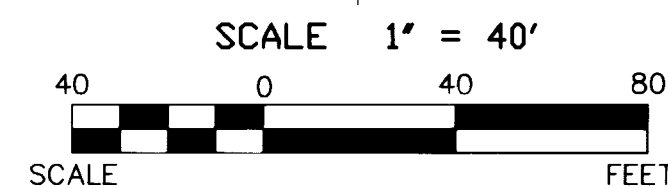

I certify that this grading plan conforms to the approved drainage study for this site on file at the City of Las Vegas

Milo L. Terzich (DATE) 5/27/98
MILO L. TERZICH, P.E. Lic. No. 12846

**Call
before you
Dig.
1-800-227-2600
UNDERGROUND SERVICE (USA)**

OF 14 SHEETS

JOB NO. 5543.921

11644 NO. 13636 (S)

107 Y-456C-2

