

BENCHMARK

CITY OF LAS VEGAS BENCHMARK STATION 51V09 34NE6

RIVET AND PLATE IN TOP OF CURB AT THE NORTHEAST CORNER OF DESERT FOOTHILLS AND ALTA DRIVE.

ELEVATION = 1007.97 METERS (NAVD'88)



ELEVATION = 3304.45 US SURVEY FEET (NAVD'88)

BASIS OF BEARINGS

NORTH 89°46'49" EAST, BEING THE BEARING OF THE NORTH LINE OF SECTION 27, TOWNSHIP 20 SOUTH, RANGE 59 EAST, M.D.M., CITY OF LAS VEGAS, CLARK COUNTY, NEVADA AS SHOWN BY MAP THEREOF ON FILE IN FILE 91, PAGE 28 OF PARCEL MAPS IN THE COUNTY RECORDER'S OFFICE, CLARK COUNTY, NEVADA.


NOTE

SEE SHEET P-4 FOR CENTERLINE DATA, CURB DATA, AND UTILITY PROFILES.

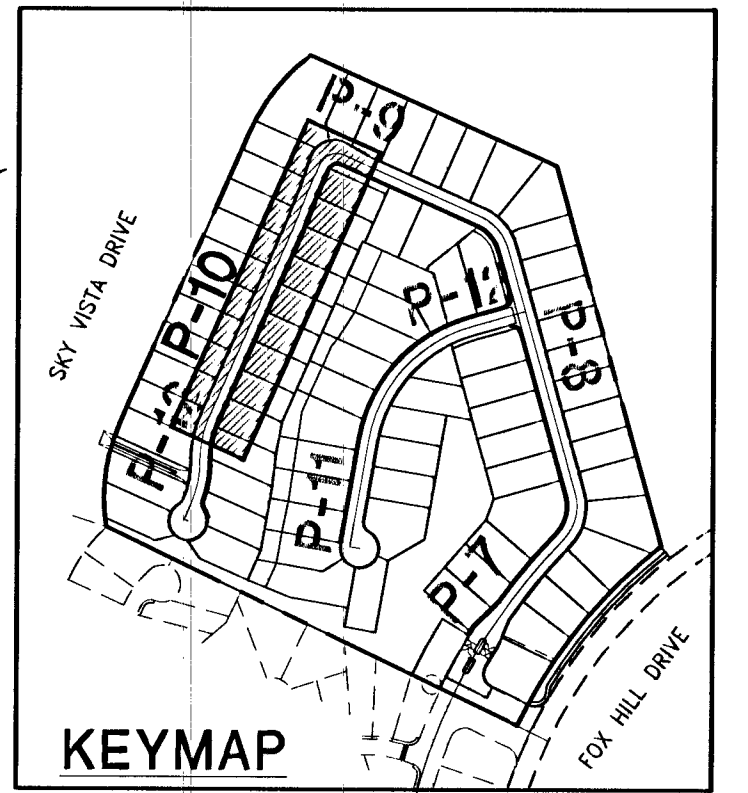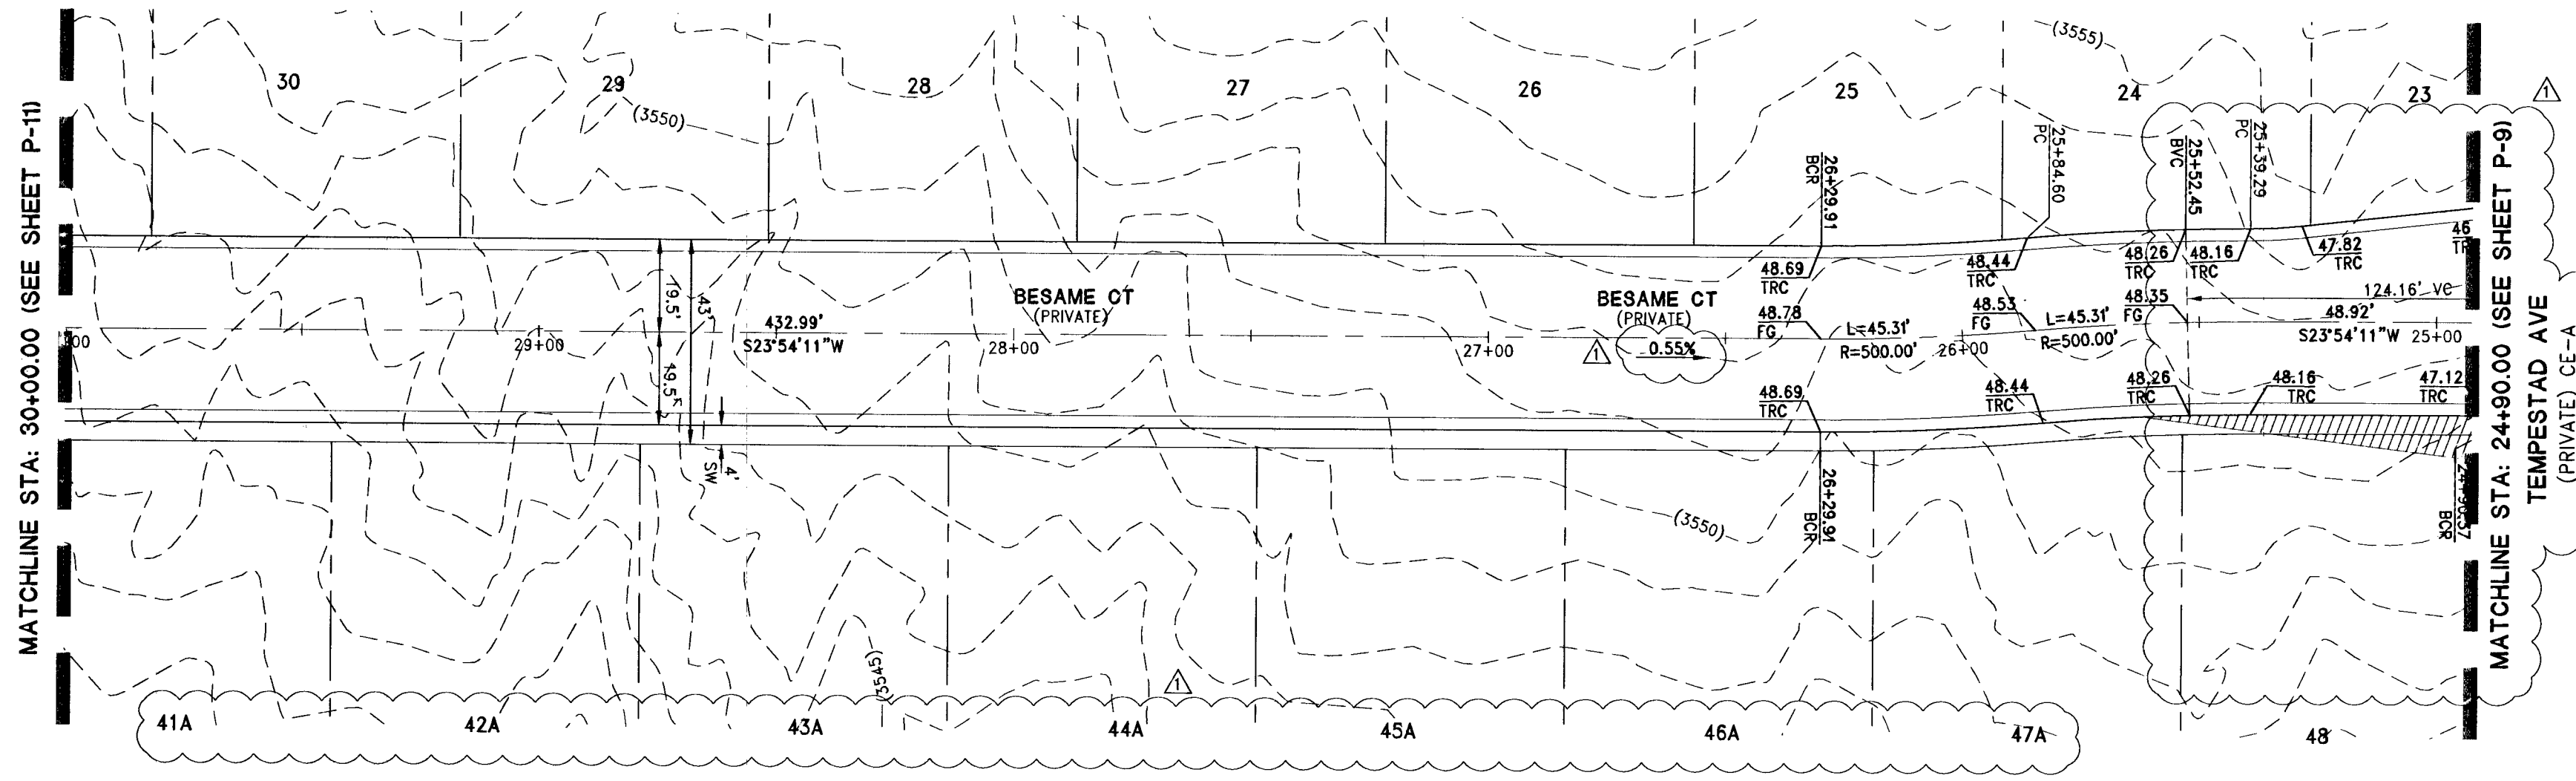

KEYMAP
30' 15' 0' 30' 60'
HORIZONTAL SCALE: 1" = 30'
VERTICAL SCALE: 1" = 5'

BESAME CT (PRIVATE) CE-A

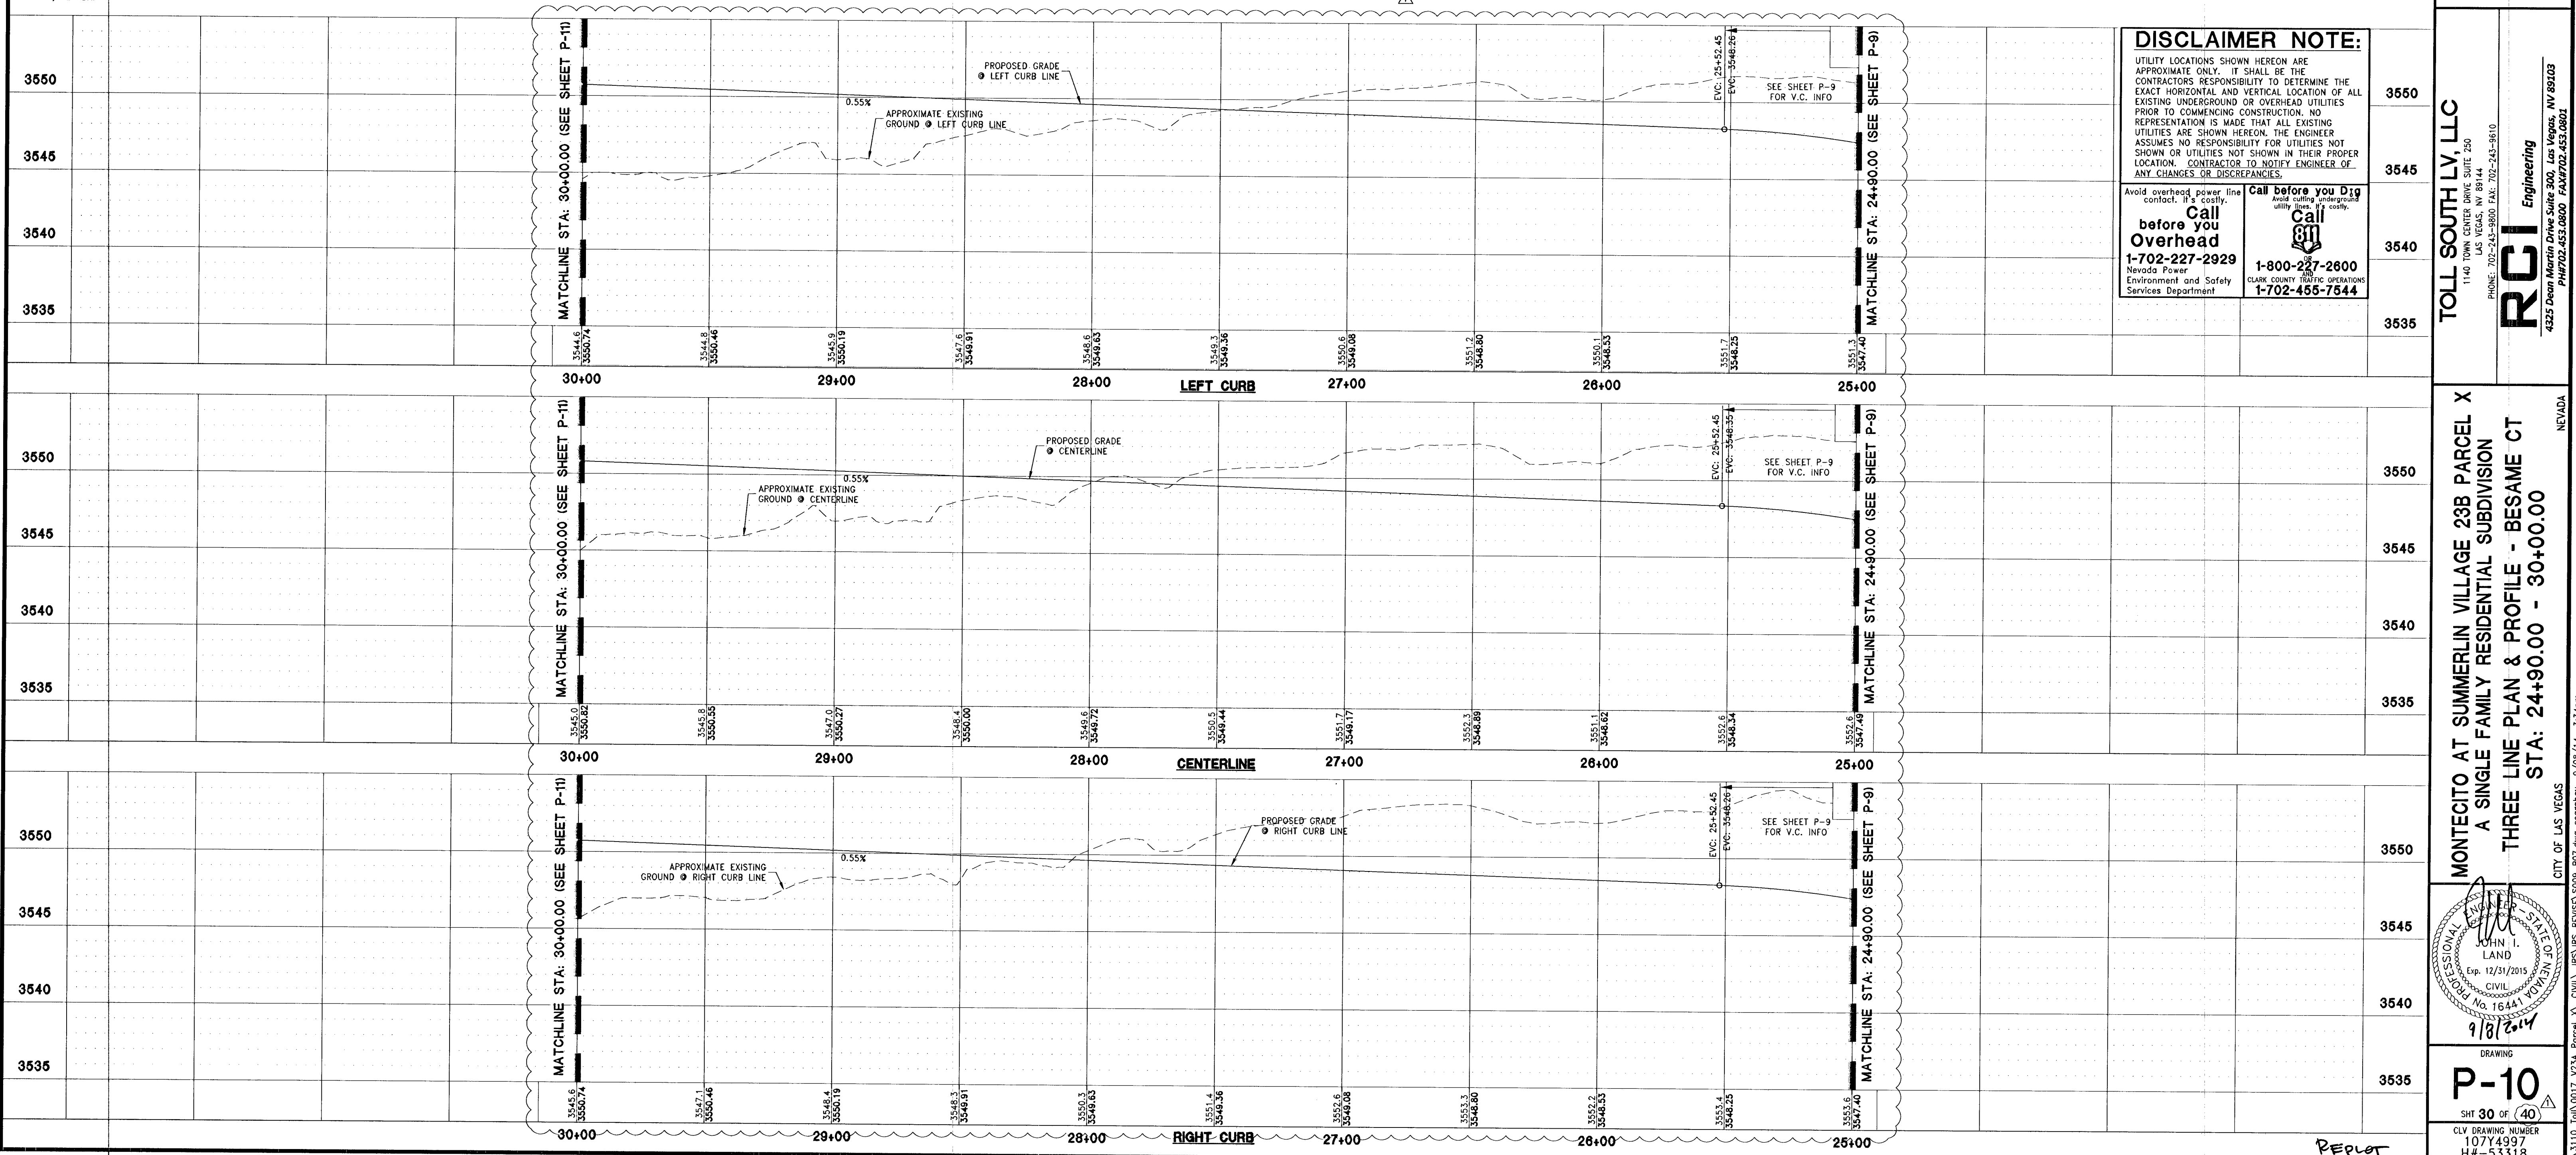

DISCLAIMER NOTE:

UTILITY LOCATIONS SHOWN HEREON ARE APPROXIMATE ONLY. IT SHALL BE THE CONTRACTOR'S RESPONSIBILITY TO DETERMINE THE EXACT HORIZONTAL AND VERTICAL LOCATION OF ALL EXISTING UNDERGROUND OR OVERHEAD UTILITIES PRIOR TO COMMENCING CONSTRUCTION. NO REPRESENTATION IS MADE THAT ALL EXISTING UTILITIES ARE SHOWN HEREON. THE ENGINEER ASSUMES NO RESPONSIBILITY FOR UTILITIES NOT SHOWN OR UTILITIES NOT SHOWN IN THEIR PROPER LOCATION. CONTRACTOR TO NOTIFY ENGINEER OF ANY CHANGES OR DISCREPANCIES.

before you Call
1-702-227-2929
Nevada Power
Environment and Safety
Services Department

Call before you Dig
1-800-227-2600
CLARK COUNTY TRAFFIC OPERATIONS
1-702-455-7544

TOLL SOUTH LV, LLC
PHONE: 702-243-3800 FAX: 702-243-3810

RCI Engineering
4322 Dean Martin Drive Suite 300, Las Vegas, NV 89103
PH702.453.0800 FAX702.453.0801

MONTECITO AT SUMMERLIN VILLAGE 23B PARCEL X
A SINGLE FAMILY RESIDENTIAL SUBDIVISION
THREE LINE PLAN & PROFILE - BESAME CT

PROFESSIONAL ENGINEER
JOHN I. LAND
No. 16441
CIVIL

DRAWING
P-10
SHT 30 OF 40
CLV DRAWING NUMBER
1074997
H#-53318

CLV PROJECT #