

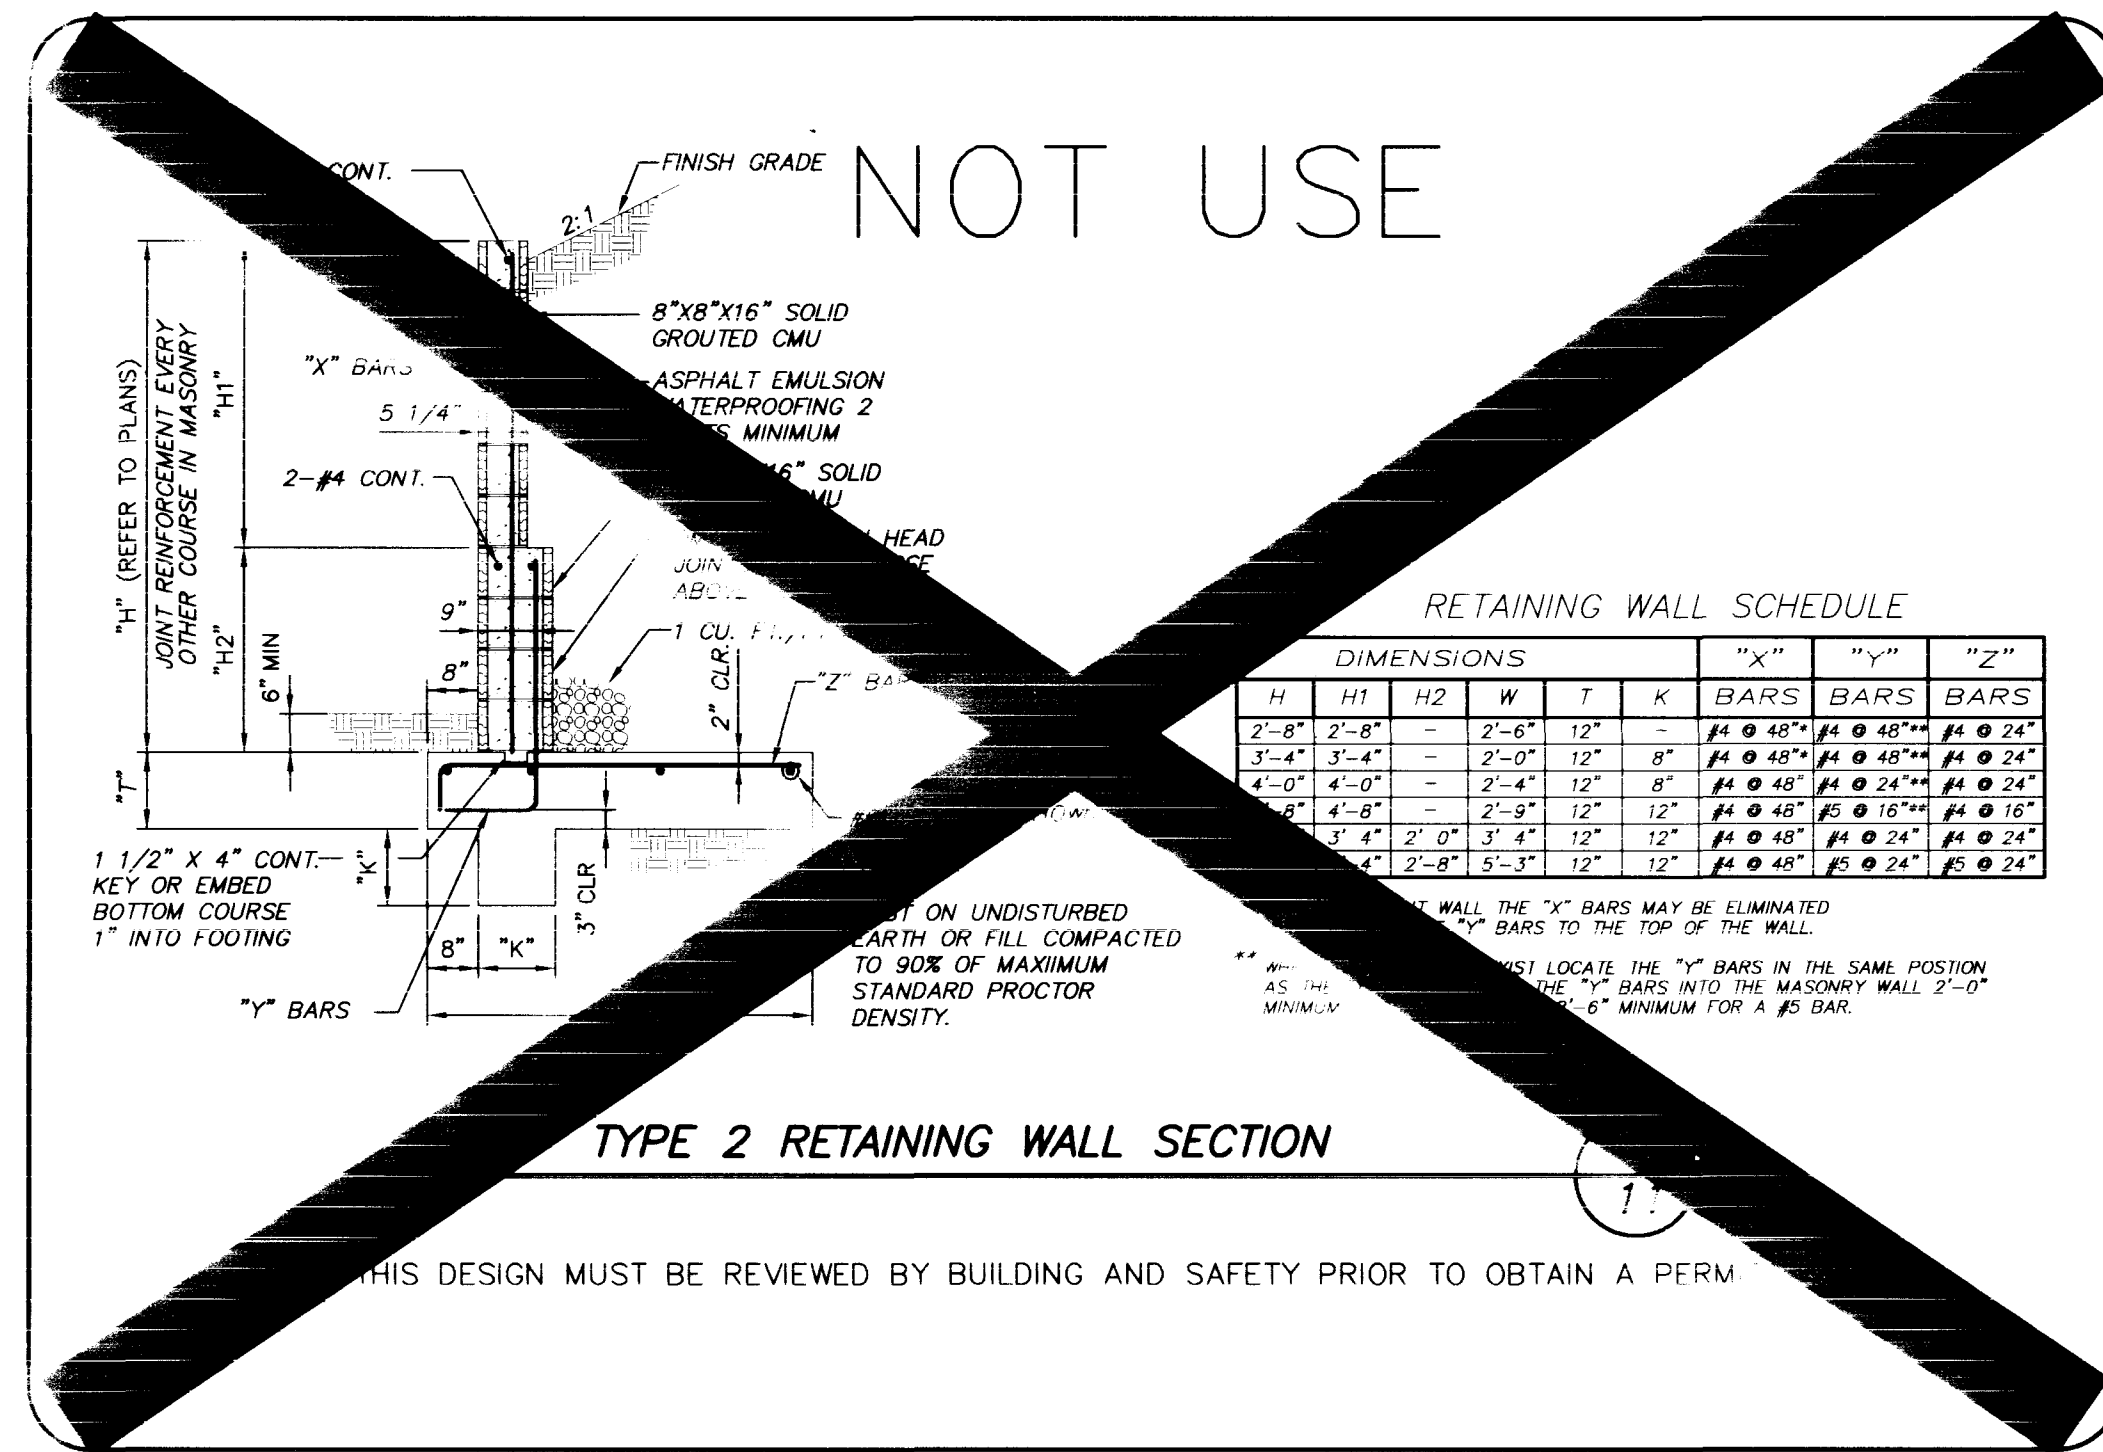
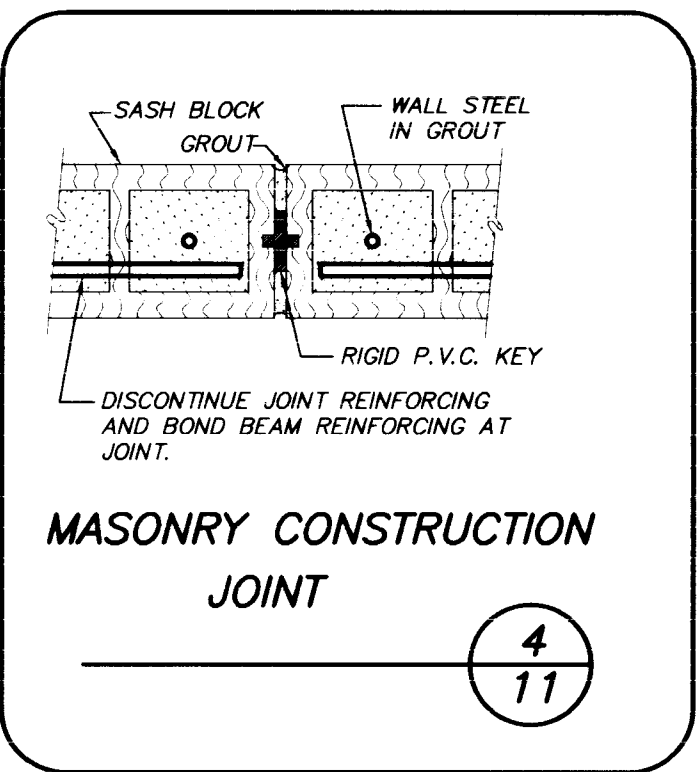


REV.	DATE	BY

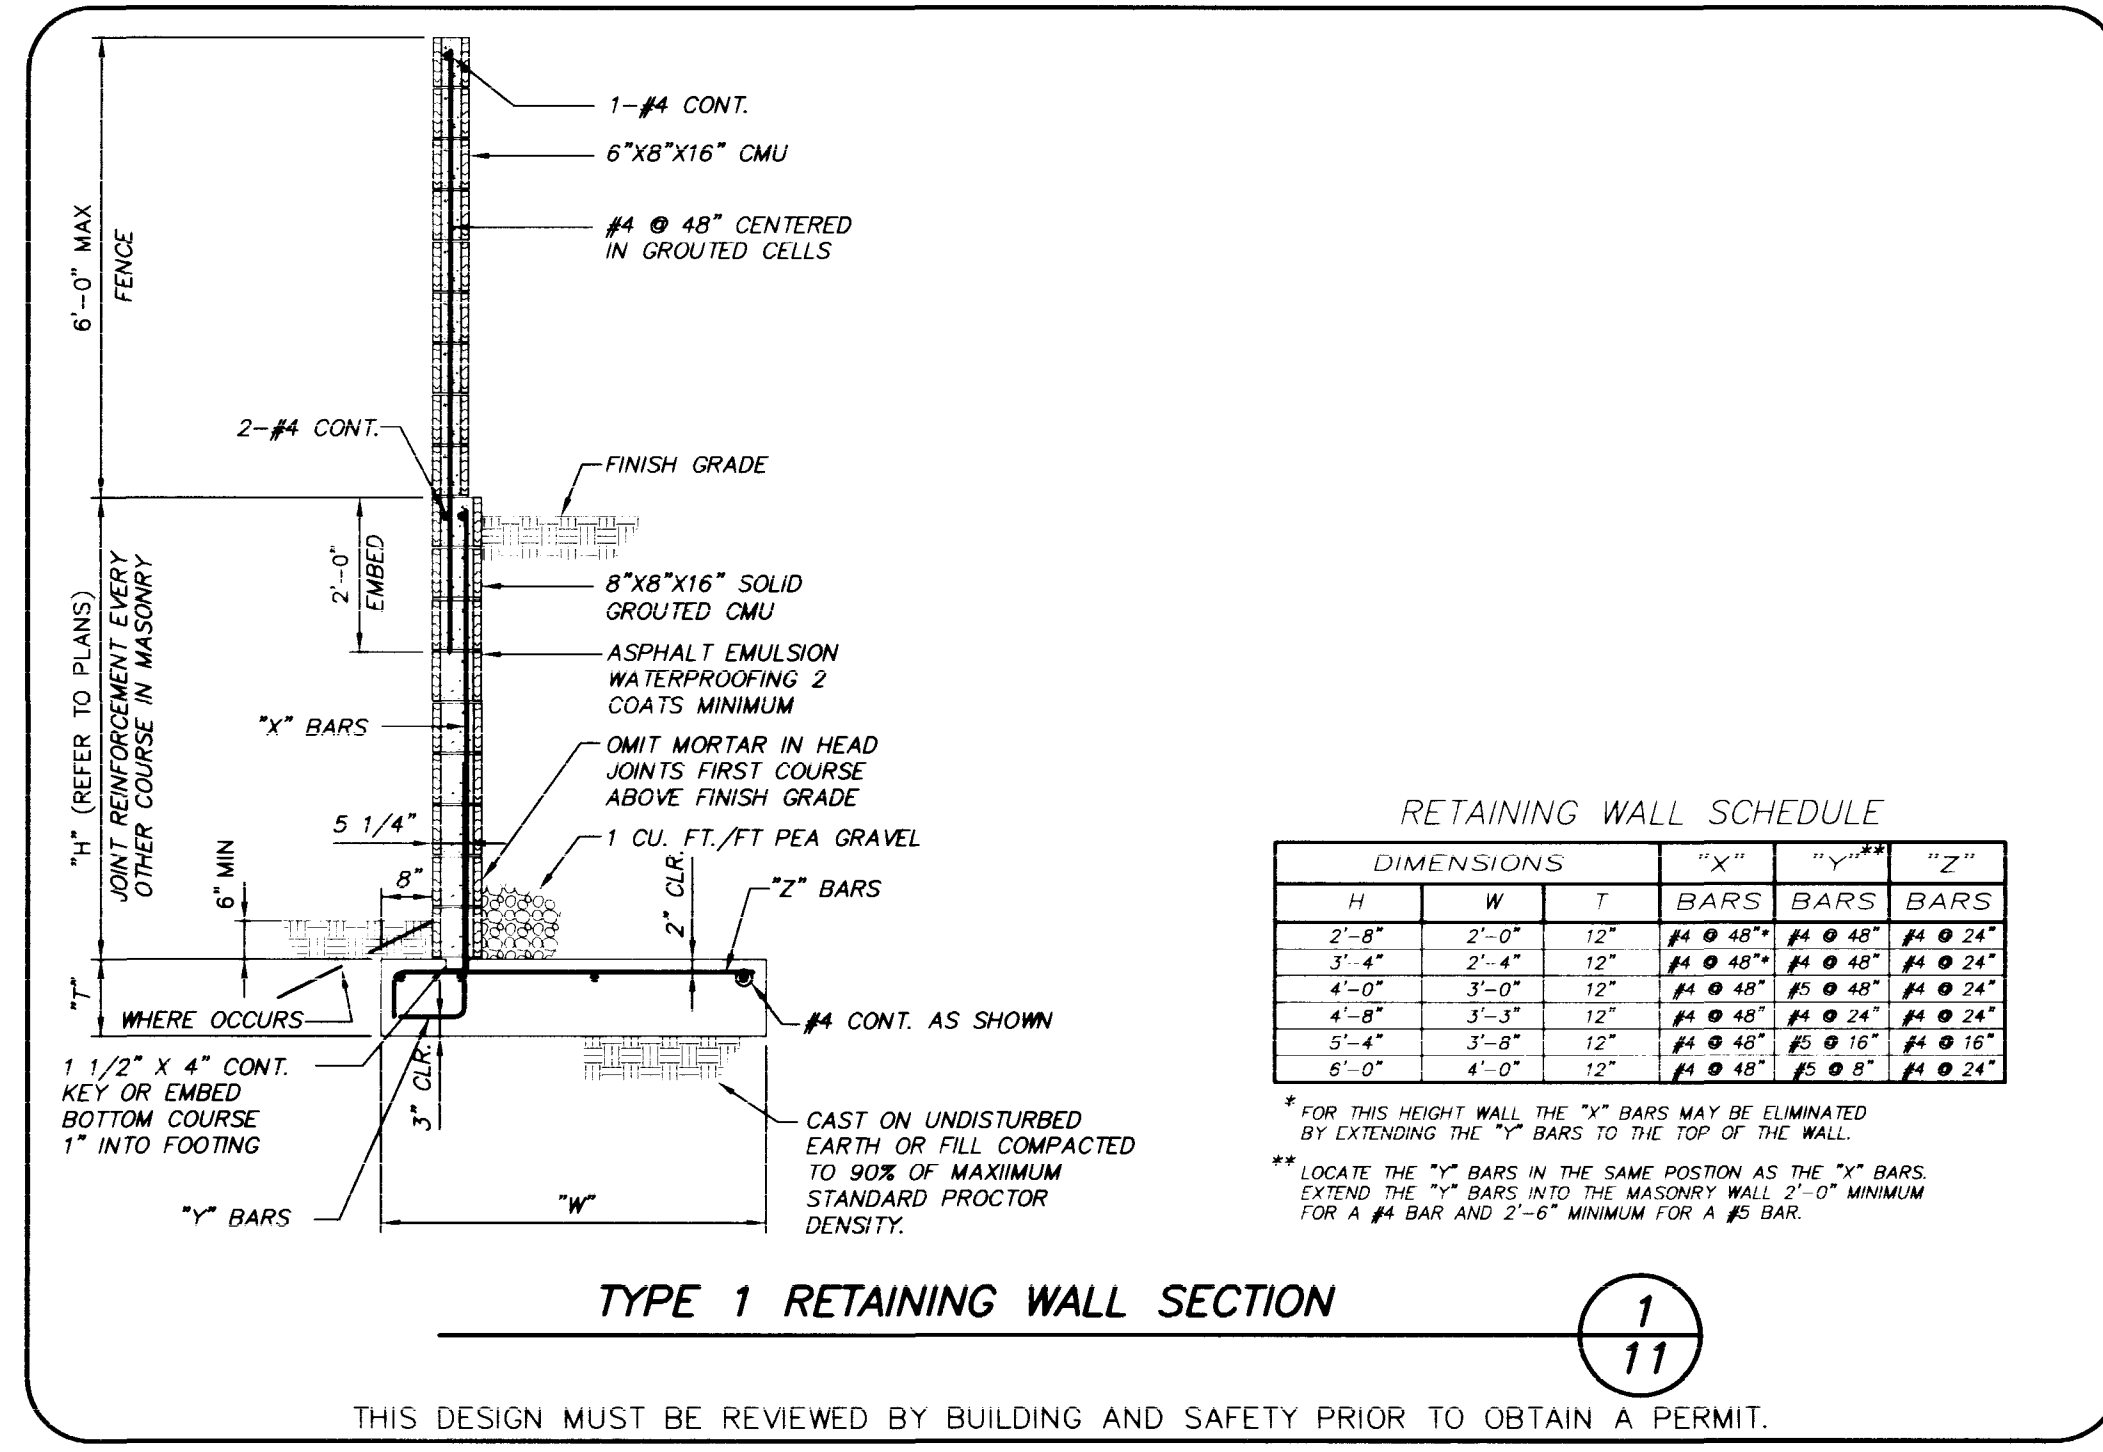

- NOTES:**
- MASONRY UNITS SHALL BE ASTM C-90, GRADE N-1 HOLLOW CONCRETE UNITS. MASONRY DESIGN STRESS IS AS FOLLOWS:  $f_m = 1500$  PSI (HALF STRESSES ARE USED UNLESS SPECIAL INSPECTION IS CALLED FOR.)
  - MORTAR SHALL BE ASTM C270, TYPE "M" OR "S", WITH A MINIMUM STRENGTH OF 1800 psi AT 28 DAYS.
  - GROUT SHALL HAVE A MINIMUM STRENGTH OF 2000 PSI AT 28 DAYS USING TYPE V CEMENT PER ASTM C-150.
  - CONCRETE SHALL HAVE A MINIMUM STRENGTH OF 3000 PSI AT 28 DAYS USING TYPE V CEMENT PER ASTM C-150. (DESIGN BASED ON  $f_c = 2500$  psi, WITH NO SPECIAL INSPECTION).
  - REINFORCING STEEL SHALL CONFORM TO ASTM A-615, GRADE 60.
  - UNLESS OTHERWISE NOTED, ALL MATERIALS SHALL CONFORM TO THE UNIFORM BUILDING CODE, LATEST EDITION, AND PER STANDARD SPECIFICATIONS FOR THE CITY OF LAS VEGAS, NEVADA.
  - SOLID GROUT ALL MASONRY UNITS BELOW HIGHEST FINISH GRADE AT THE WALL.
  - ALL WALLS ARE SUBJECT TO APPROVAL BY THE CITY OF LAS VEGAS, NEVADA BUILDING DEPARTMENT.
  - WALLS SHALL BE STEPPED ONLY AS SHOWN ON THE PLANS.
  - ALL CORNERS OR ANGLES SHALL BE TIED TOGETHER WITH REINFORCING STEEL AND GROUTED SOLID.
  - HORIZONTAL JOINT REINFORCING SHALL BE 9-GA. LADDER TYPE WITH LAP SPACES OF 12" MINIMUM, INCLUDING CORNERS AND INTERSECTIONS.
  - BOND BEAMS AND JOINT REINFORCING SHALL NOT BE CONTINUOUS THROUGH WALL CONSTRUCTION JOINTS.
  - WHERE VERTICAL GROUT LIFTS ARE NOT CONTINUOUS FOR THE ENTIRE HEIGHT OF THE WALL, TERMINATE LIFT 1" BELOW TOP OF TOP BLOCK TO FORM A KEY FOR FUTURE LIFTS.
  - LOCATE KEYED JOINT IN RETAINING WALL AT A MAXIMUM SPACING OF 24'-0".
  - BACKFILL BEHIND WALLS SHALL BE COMPACTED TO 90% OF STANDARD PROCTOR DENSITY.
  - IF ACTUAL HEIGHT OF WALL IS NOT LISTED IN TABLE BELOW, USE STEEL AND DIMENSIONS FOR NEXT HIGHEST WALL LISTED.
  - PROJECT SOILS REPORT: TERRACON CONSULTANTS WESTERN, INC. PROJECT NO. 6496323 JUNE 28, 1996
- ALLOWABLE SOILS BEARING PRESSURE = 1500 psf (2000 psf W/18" MIN DEPTH BELOW FINISH GRADE)  
 SOIL ACTIVE PRESSURE = 35 psf (LEVEL)  
 SOIL PASSIVE PRESSURE = 250 psf/ft  
 COEFFICIENT OF FRICTION = 0.4

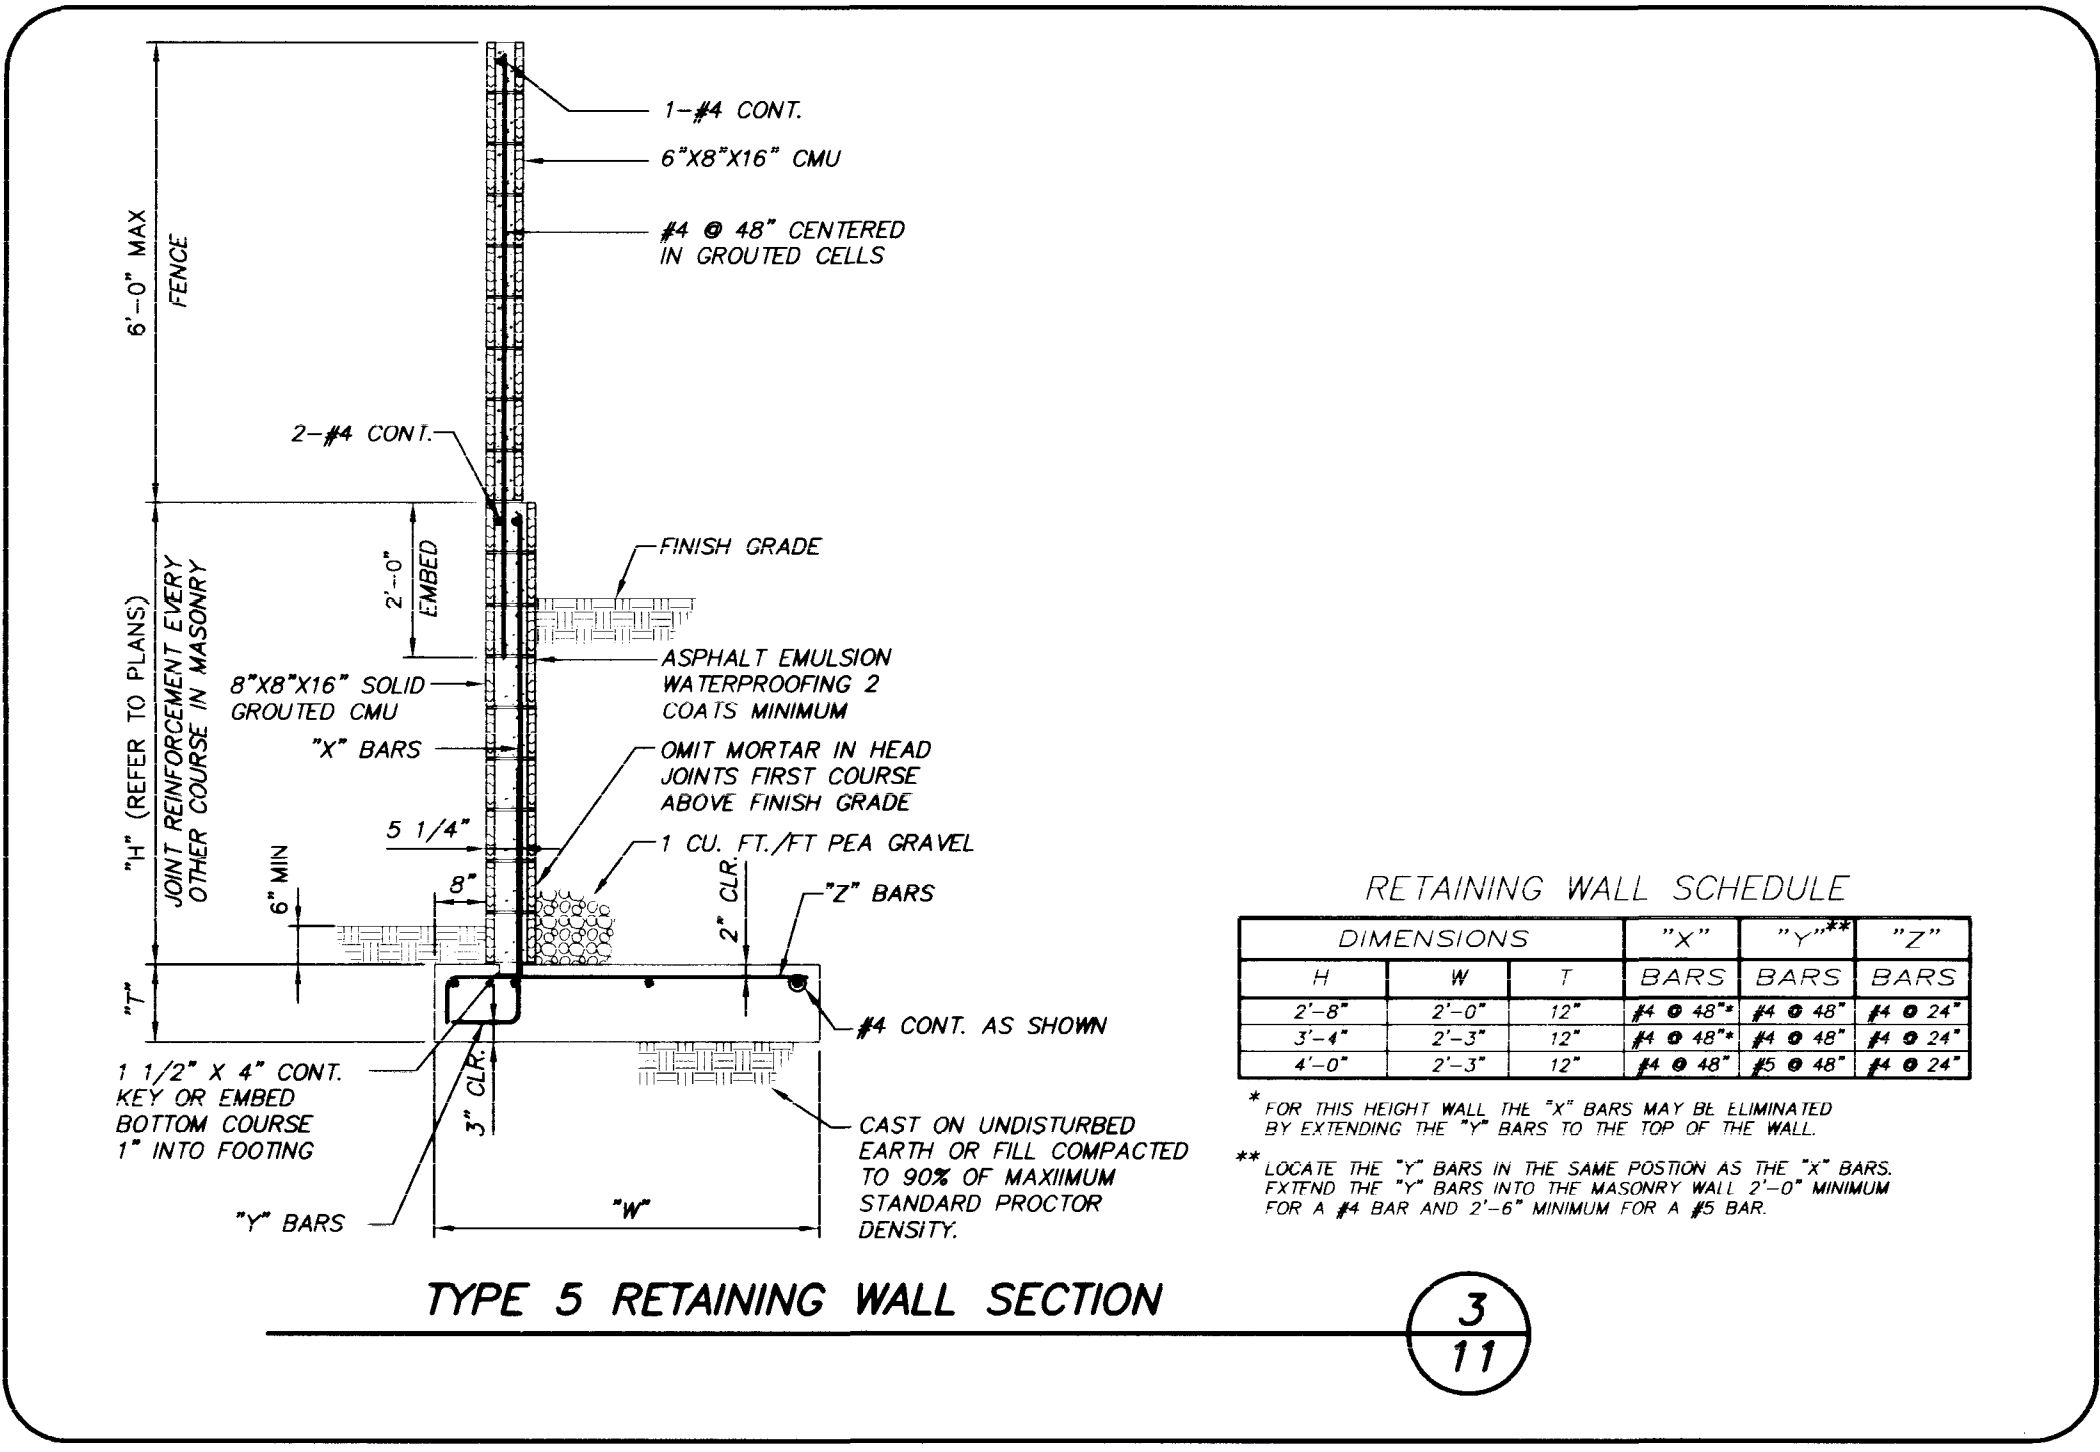

**RETAINING WALL DETAILS**

**COLEMAN HOMES OAKHILLS AT SUMMERLIN PHASE III**

DRAWN BY: GCR 05/15/98  
 DESIGNED BY: GCR  
 CHECKED BY:  
 PROJECT NO: 743162

SCALE: N/A  
 HOR. / VER. N/A

SEAL  
 PROFESSIONAL ENGINEER - STATE OF NEVADA  
 C. RUSSELL DAVIS  
 No. 8255  
 8/21/99

SHEET G-6  
 11 OF 13 SHEETS  
 DRAWING NO. 107Y-4506-3

