



Call before  
you Dig  
1-800-227-2600


Call before  
you Overhead  
1-702-593-6111

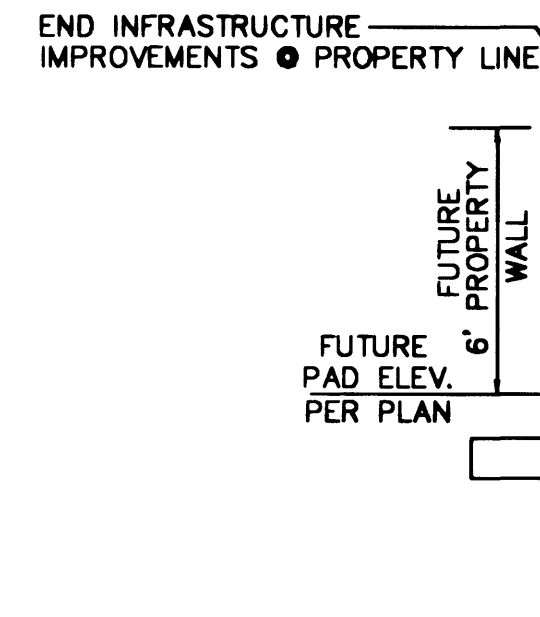


**A MULTI-USE TRAIL EASEMENT CROSS-SECTION**  
NOT-TO-SCALE (GRAND TETON DRIVE)

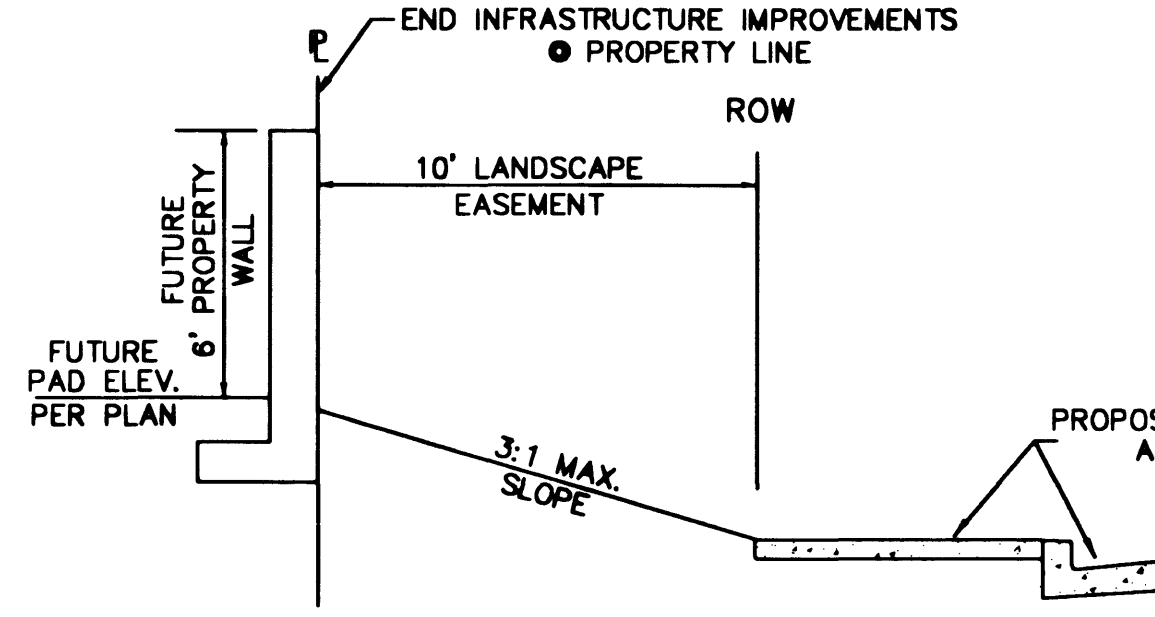


**C LANDSCAPE EASEMENT CROSS-SECTION**  
NOT-TO-SCALE (PALM GROVE LANE)

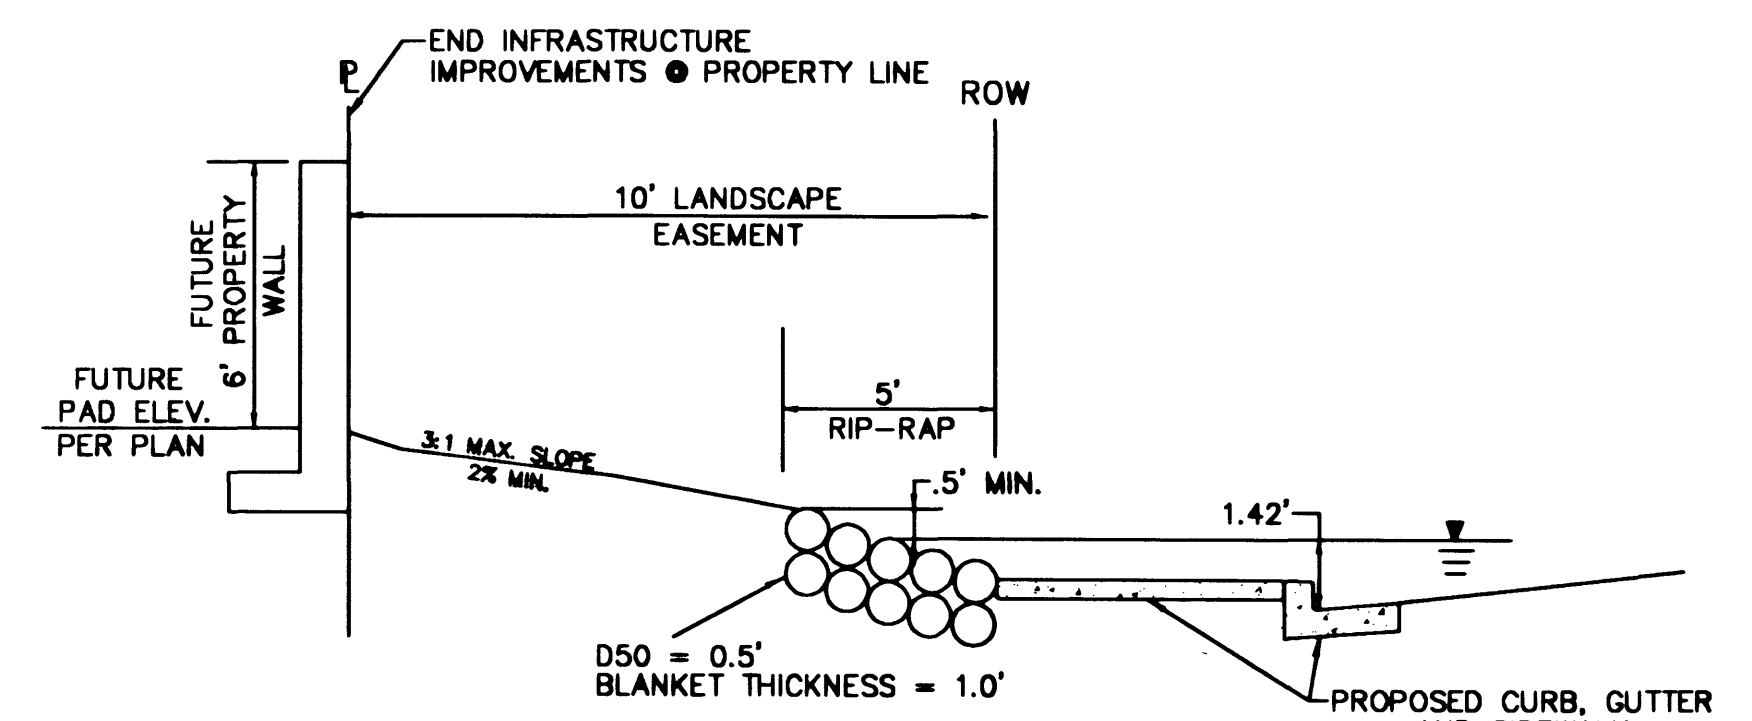


**D SECTION D (CIMARRON DRIVE)**  
NOT-TO-SCALE

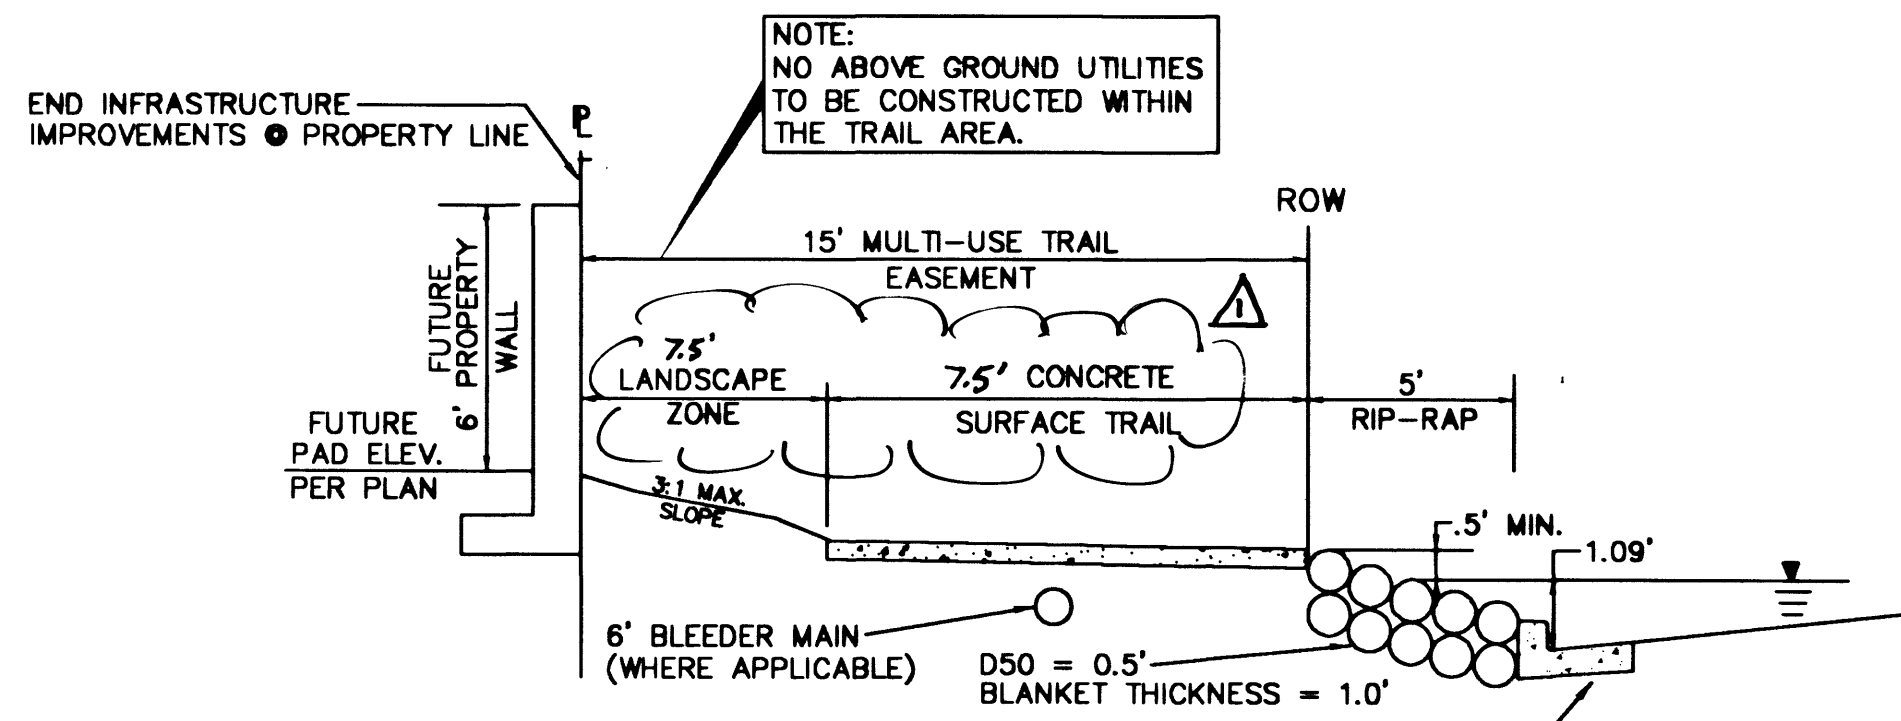


**E MULTI-USE TRAIL EASEMENT CROSS-SECTION**  
NOT-TO-SCALE (GRAND TETON DRIVE)

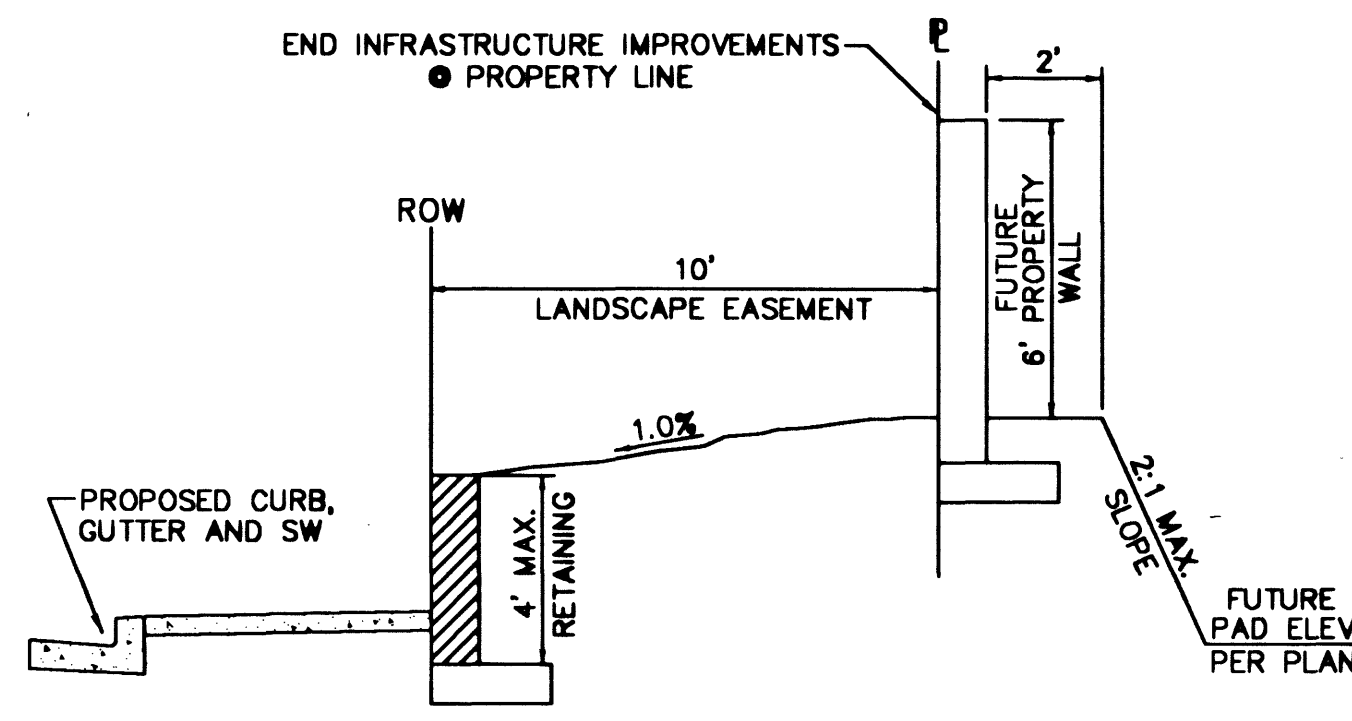


**H SECTION H (QUAIL POINTE DRIVE)**  
NOT-TO-SCALE

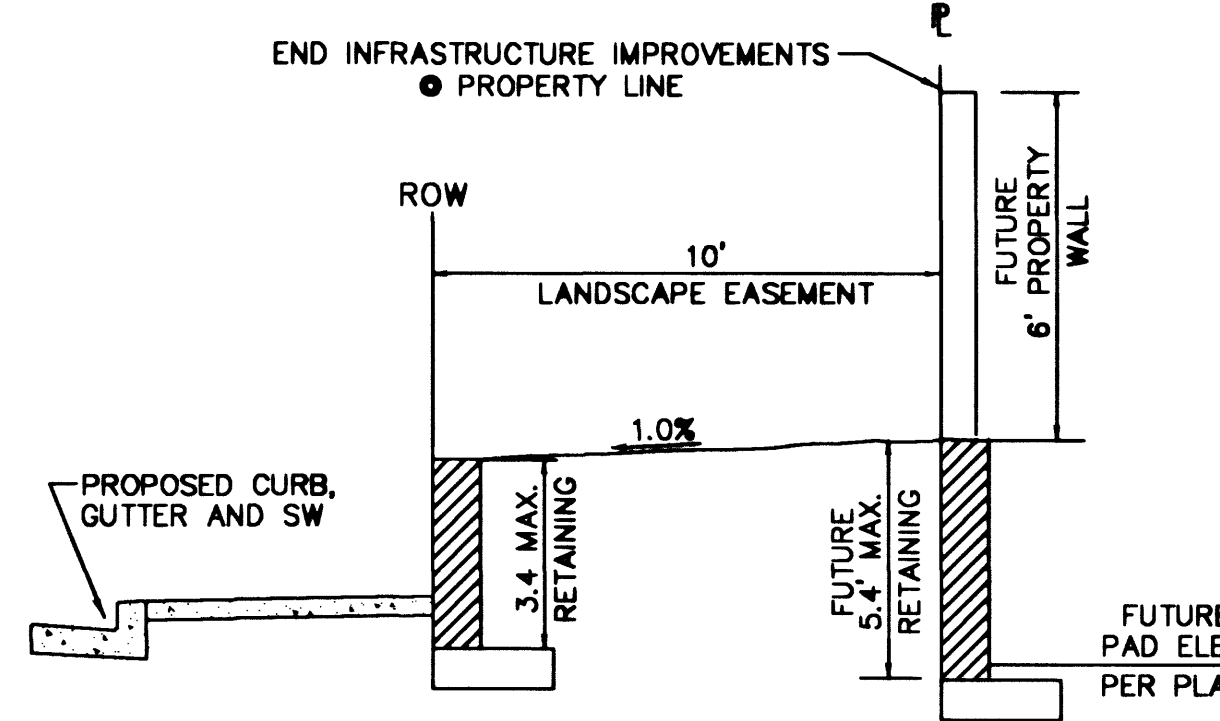


**J SECTION J**  
NOT-TO-SCALE  
QUAIL POINTE DR.

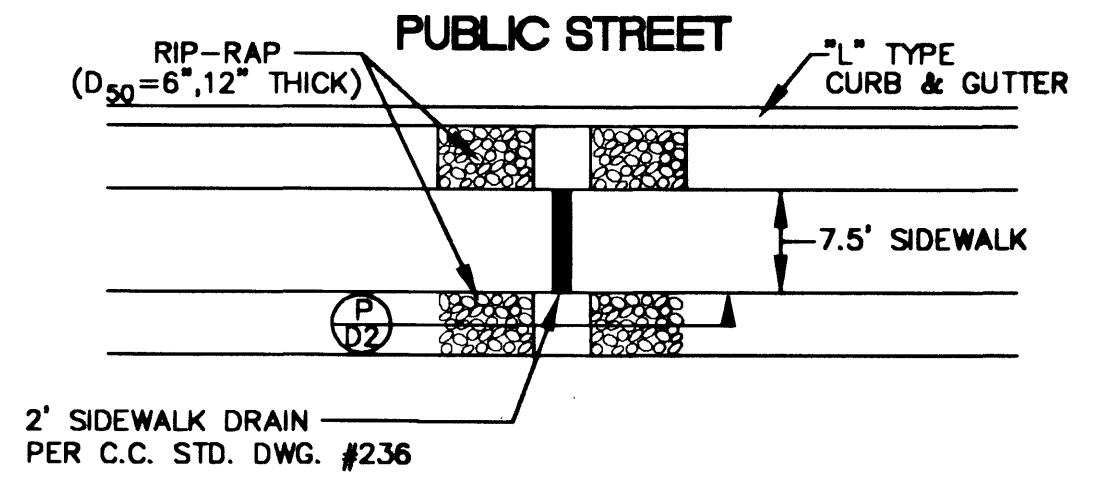


**O PUBLIC DRAINAGE EASEMENT DETAIL**  
NOT TO SCALE

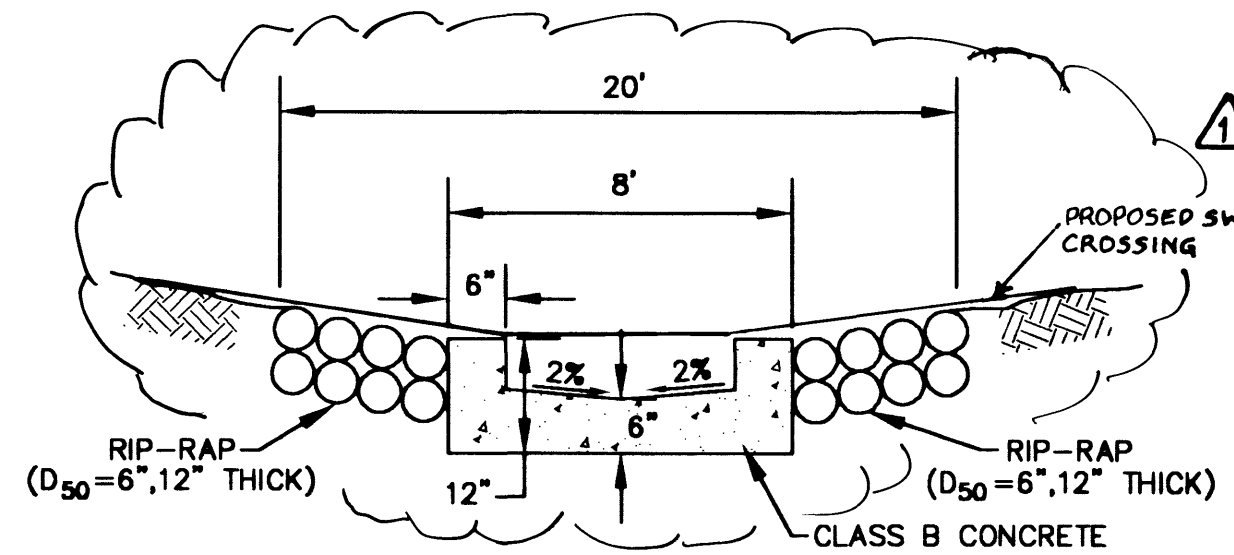


**P RIP-RAP / CONCRETE FLUME SECTION**  
NOT TO SCALE

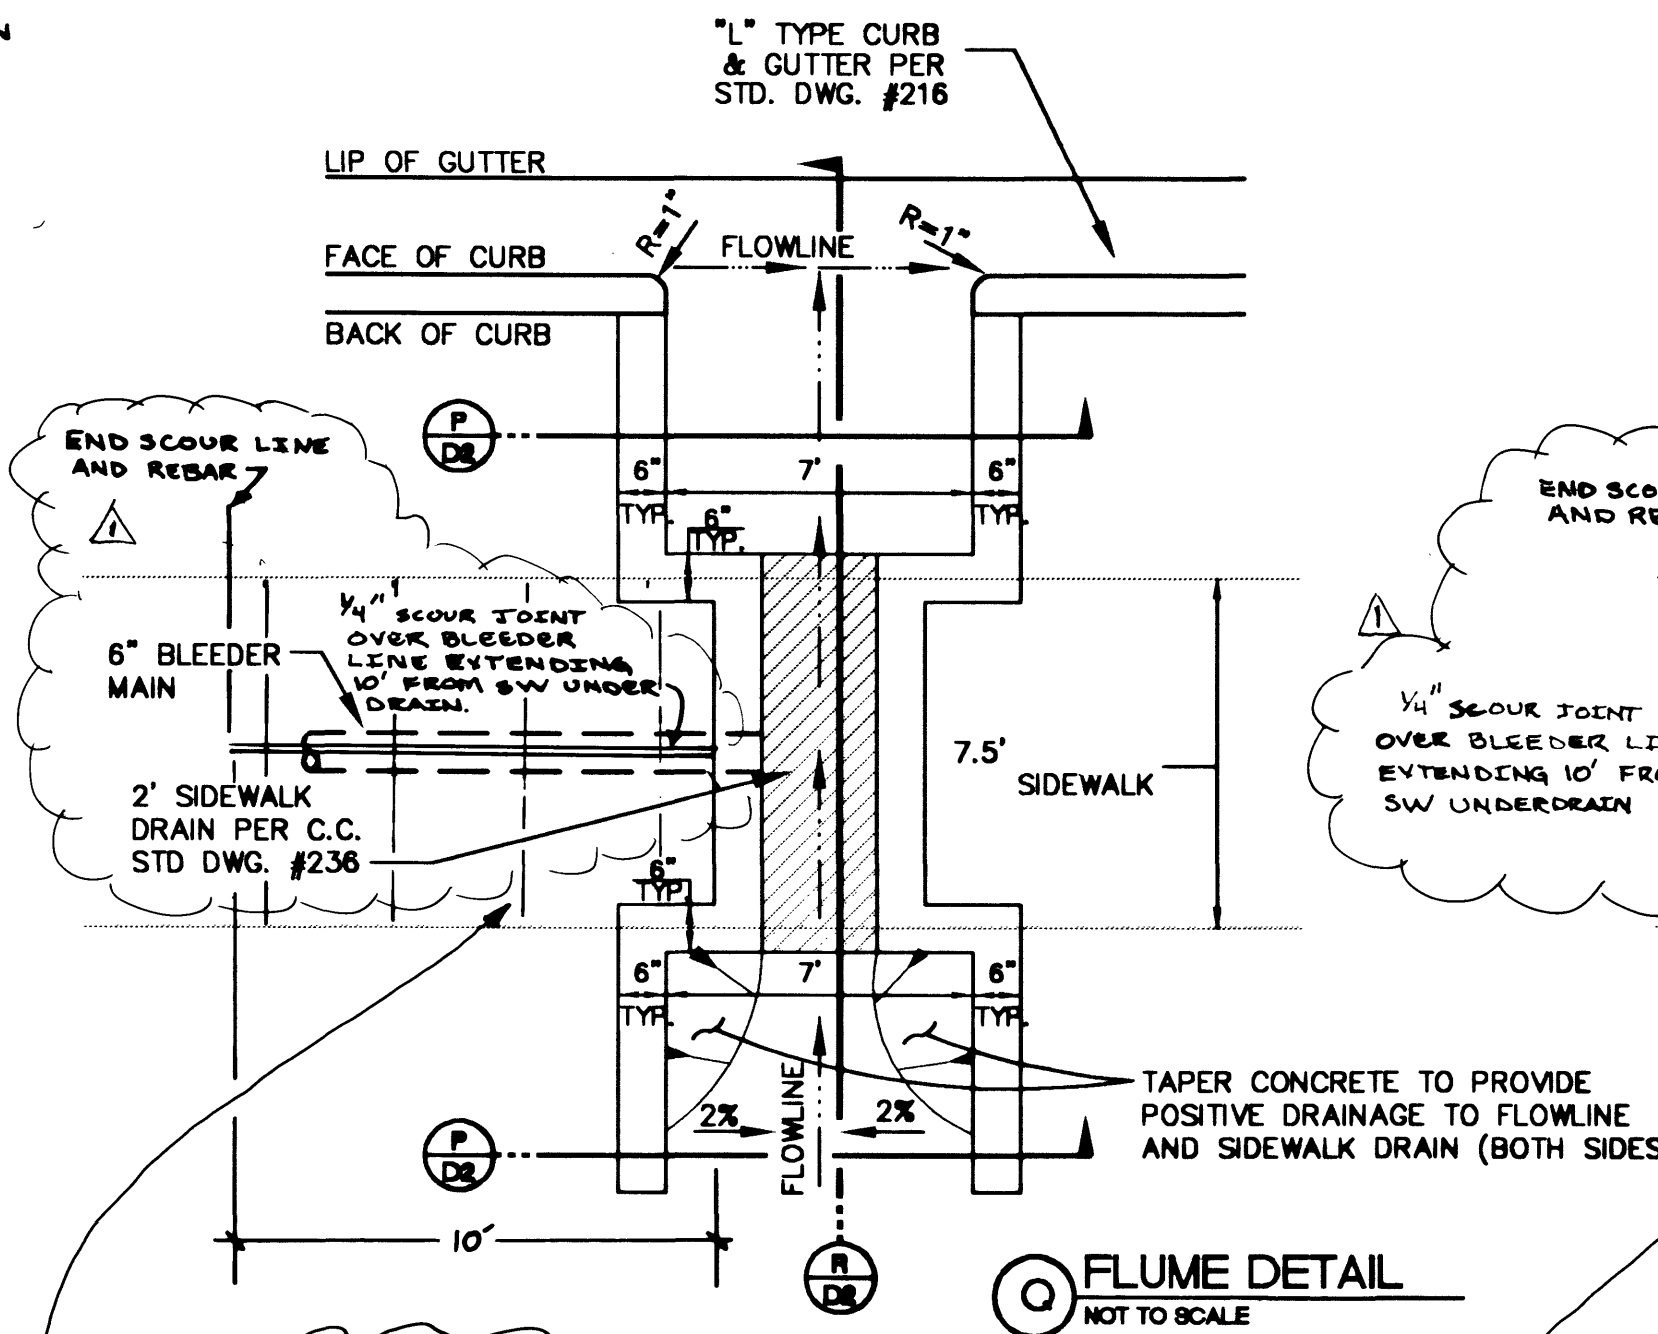


**Q FLUME DETAIL**  
NOT TO SCALE

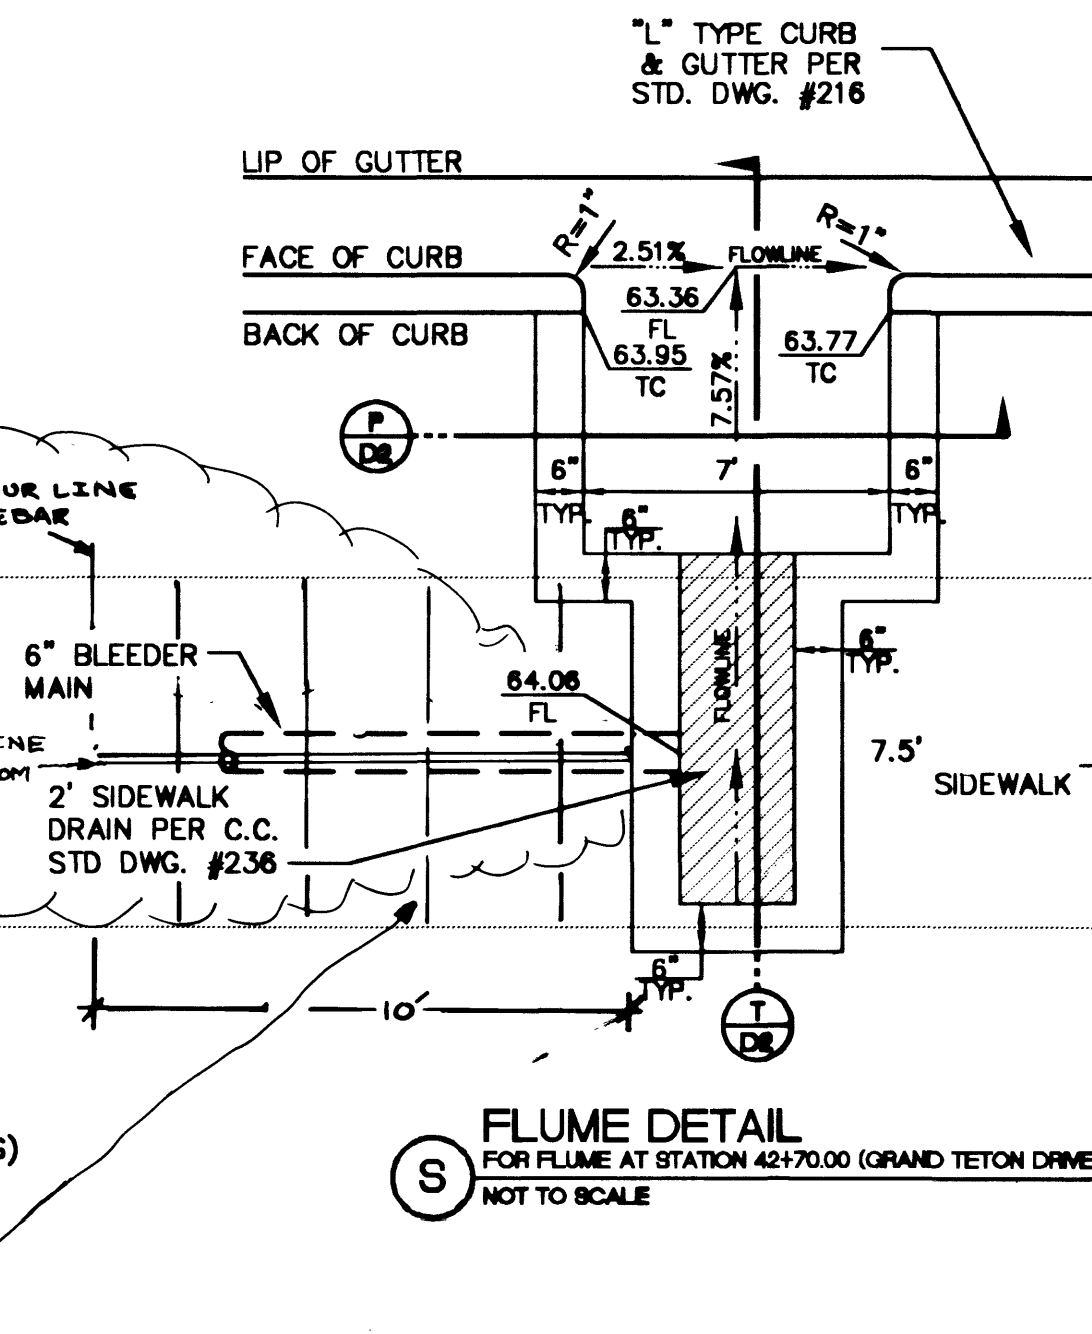


**S FLUME DETAIL**  
FOR FLUME AT STATION 42+70.00 (GRAND TETON DRIVE)  
NOT TO SCALE

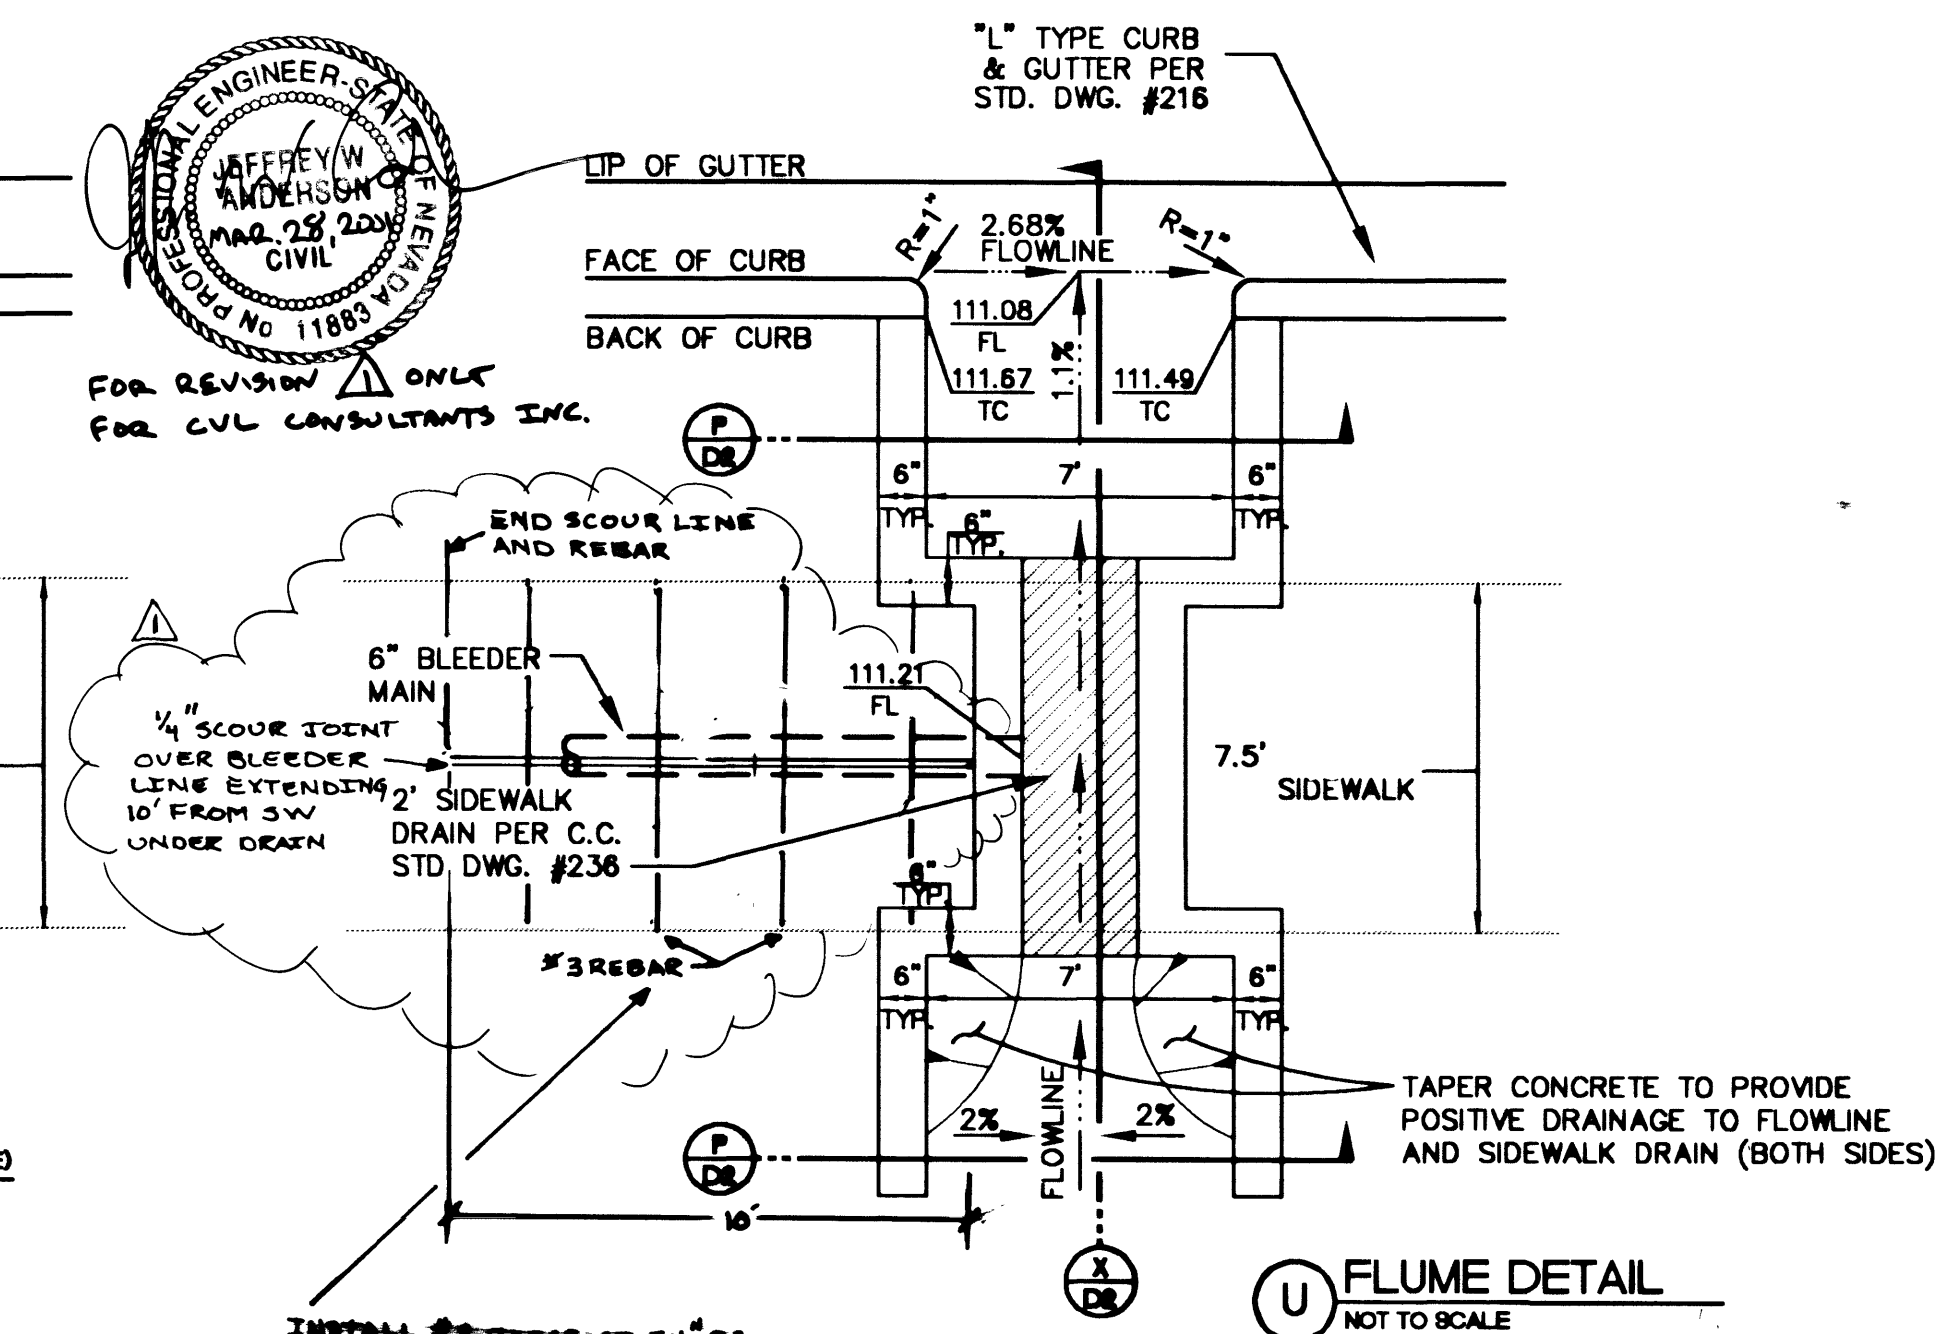


**U FLUME DETAIL**  
FOR FLUME AT STA 2H+20.00 (GRAND TETON DRIVE)  
NOT TO SCALE

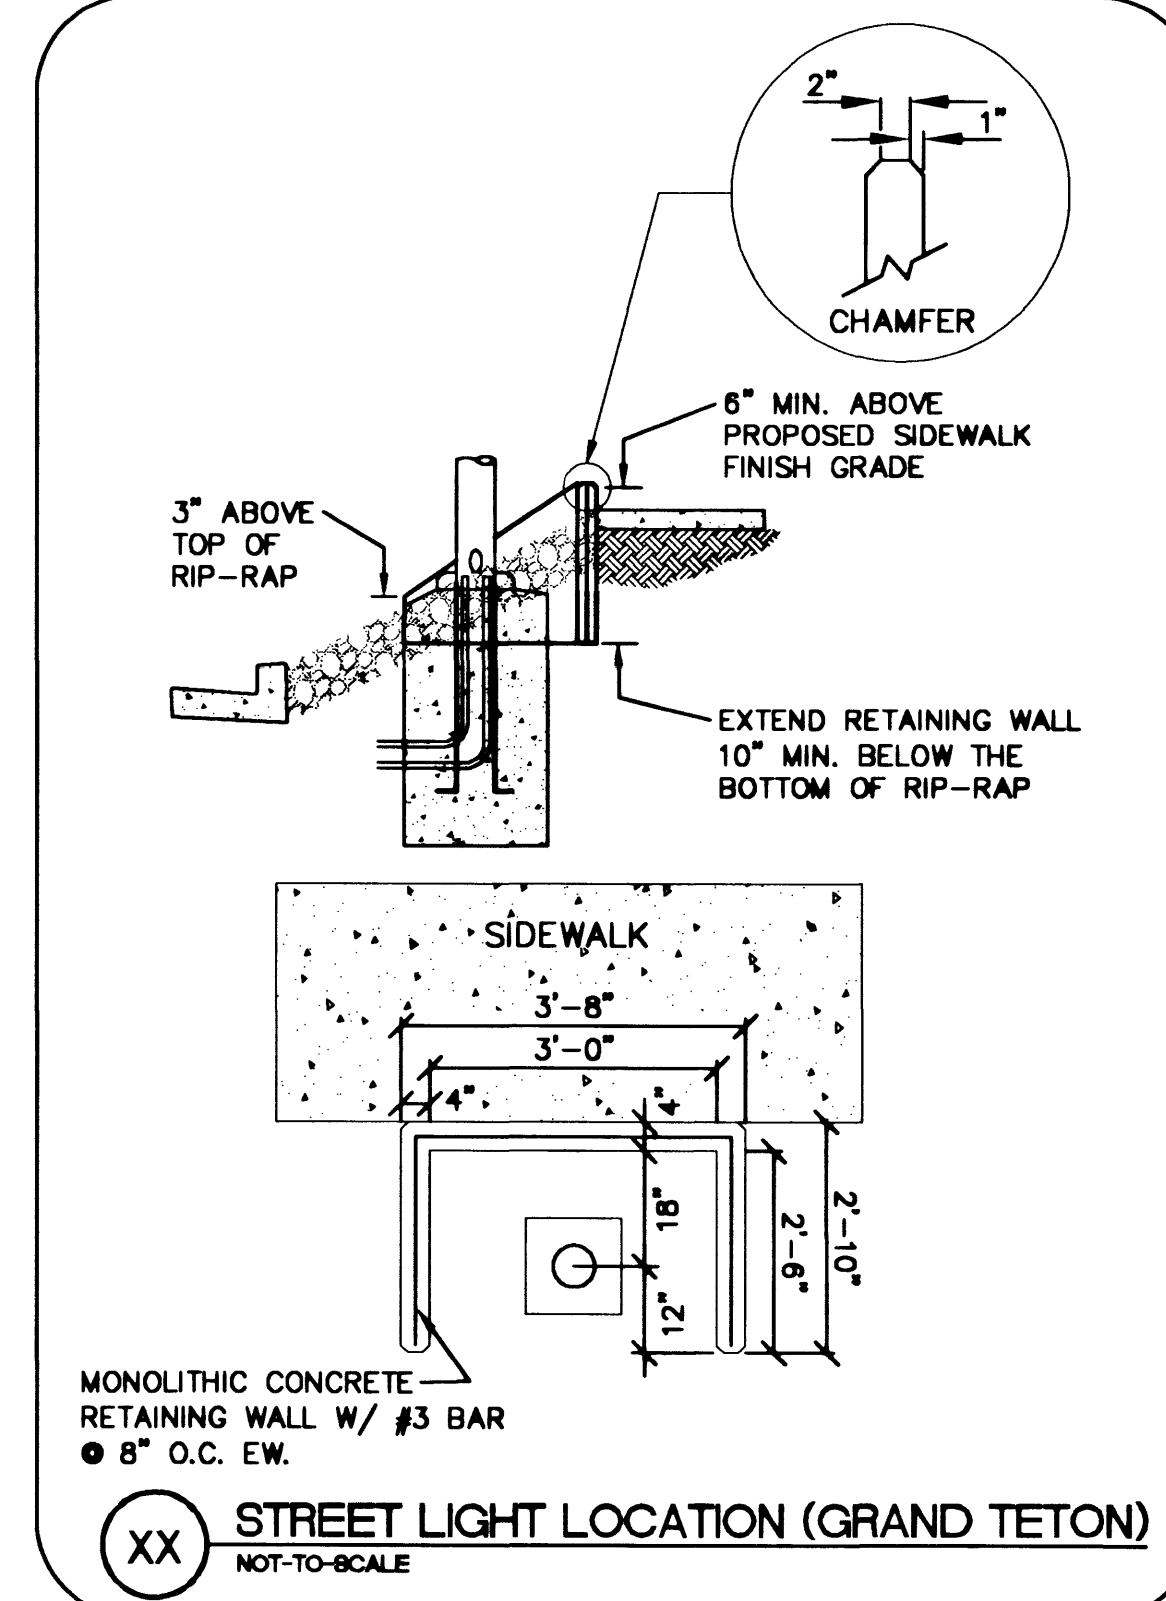


**XX STREET LIGHT LOCATION (GRAND TETON)**  
NOT-TO-SCALE

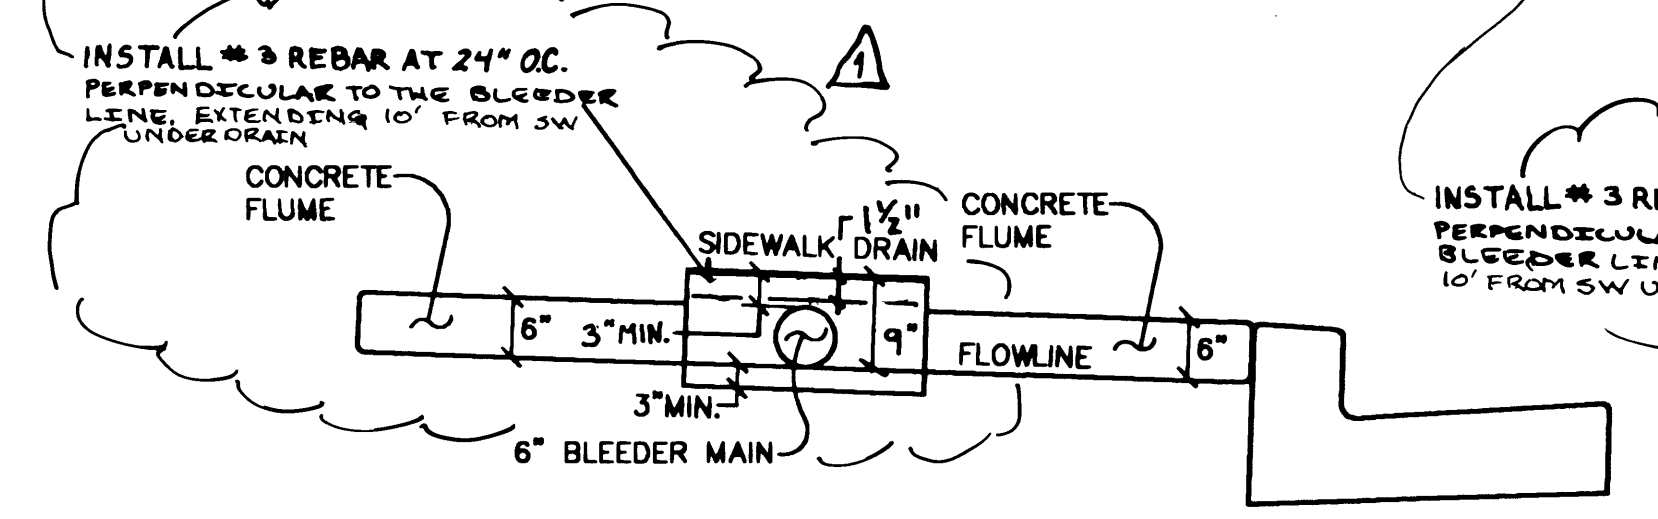

**R FLUME/SIDEWALK DRAIN CROSS SECTION**  
NOT-TO-SCALE

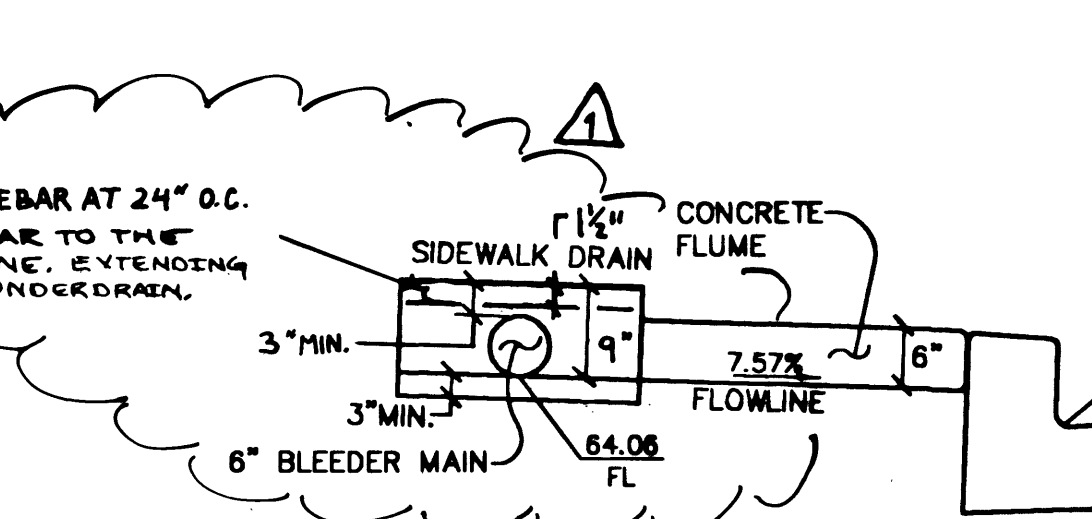

**T FLUME/SIDEWALK DRAIN CROSS SECTION**  
NOT-TO-SCALE

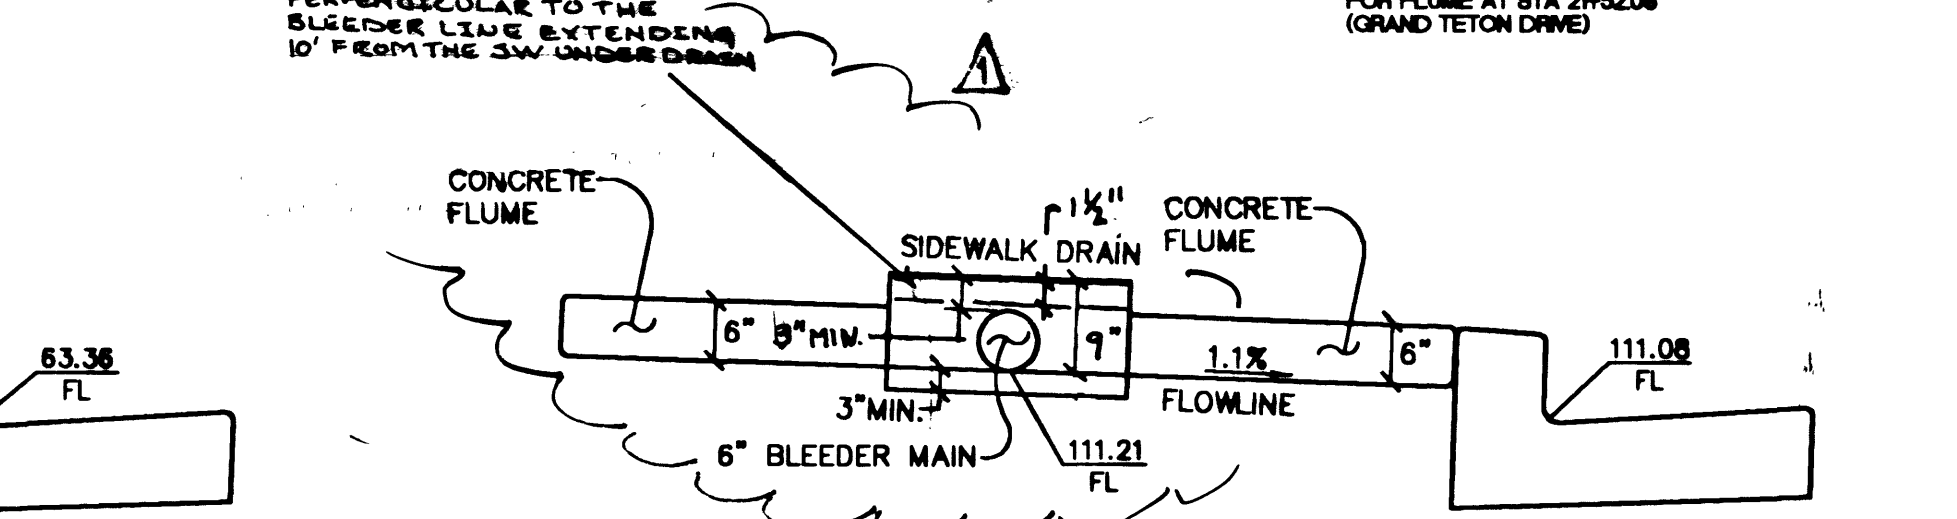

**X FLUME/SIDEWALK DRAIN CROSS SECTION**  
NOT-TO-SCALE

|                    |       |           |       |             |      |               |       |
|--------------------|-------|-----------|-------|-------------|------|---------------|-------|
| DESIGNED BY:       | CB/CA | DRAWN BY: | RS/OS | CHECKED BY: | AMV  | PROJECT DATE: | 08/99 |
| BY DATE/APP. DATE: |       |           |       |             |      |               |       |
| REVISION           | NO.   | DATE      | BY    | APP.        | DATE | BY            | APP.  |

QUAIL RUN AND THE WILLOWS  
CITY OF LAS VEGAS

NEVADA  
ELKHORN SPRINGS

PUBLIC INFRASTRUCTURE  
DETAIL SHEET

CONCORDIA  
HOMES

DISTINCTIVE  
HOMES

6280 S. Valley View Blvd  
Suite 200  
Las Vegas, NV 89118  
Tel: (702) 568-3008  
Fax: (702) 568-0047

CONSULTANTS, INC.  
ENGINEERING • PLANNING • LAND SURVEYING

SHEET  
D2  
24 OF 24

AGENCY DWG. NO.  
1024/4638-1-1

**Call Before You Dig**  
800-4-A-DIG

**Call Before You Dig**  
800-4-A-DIG

