



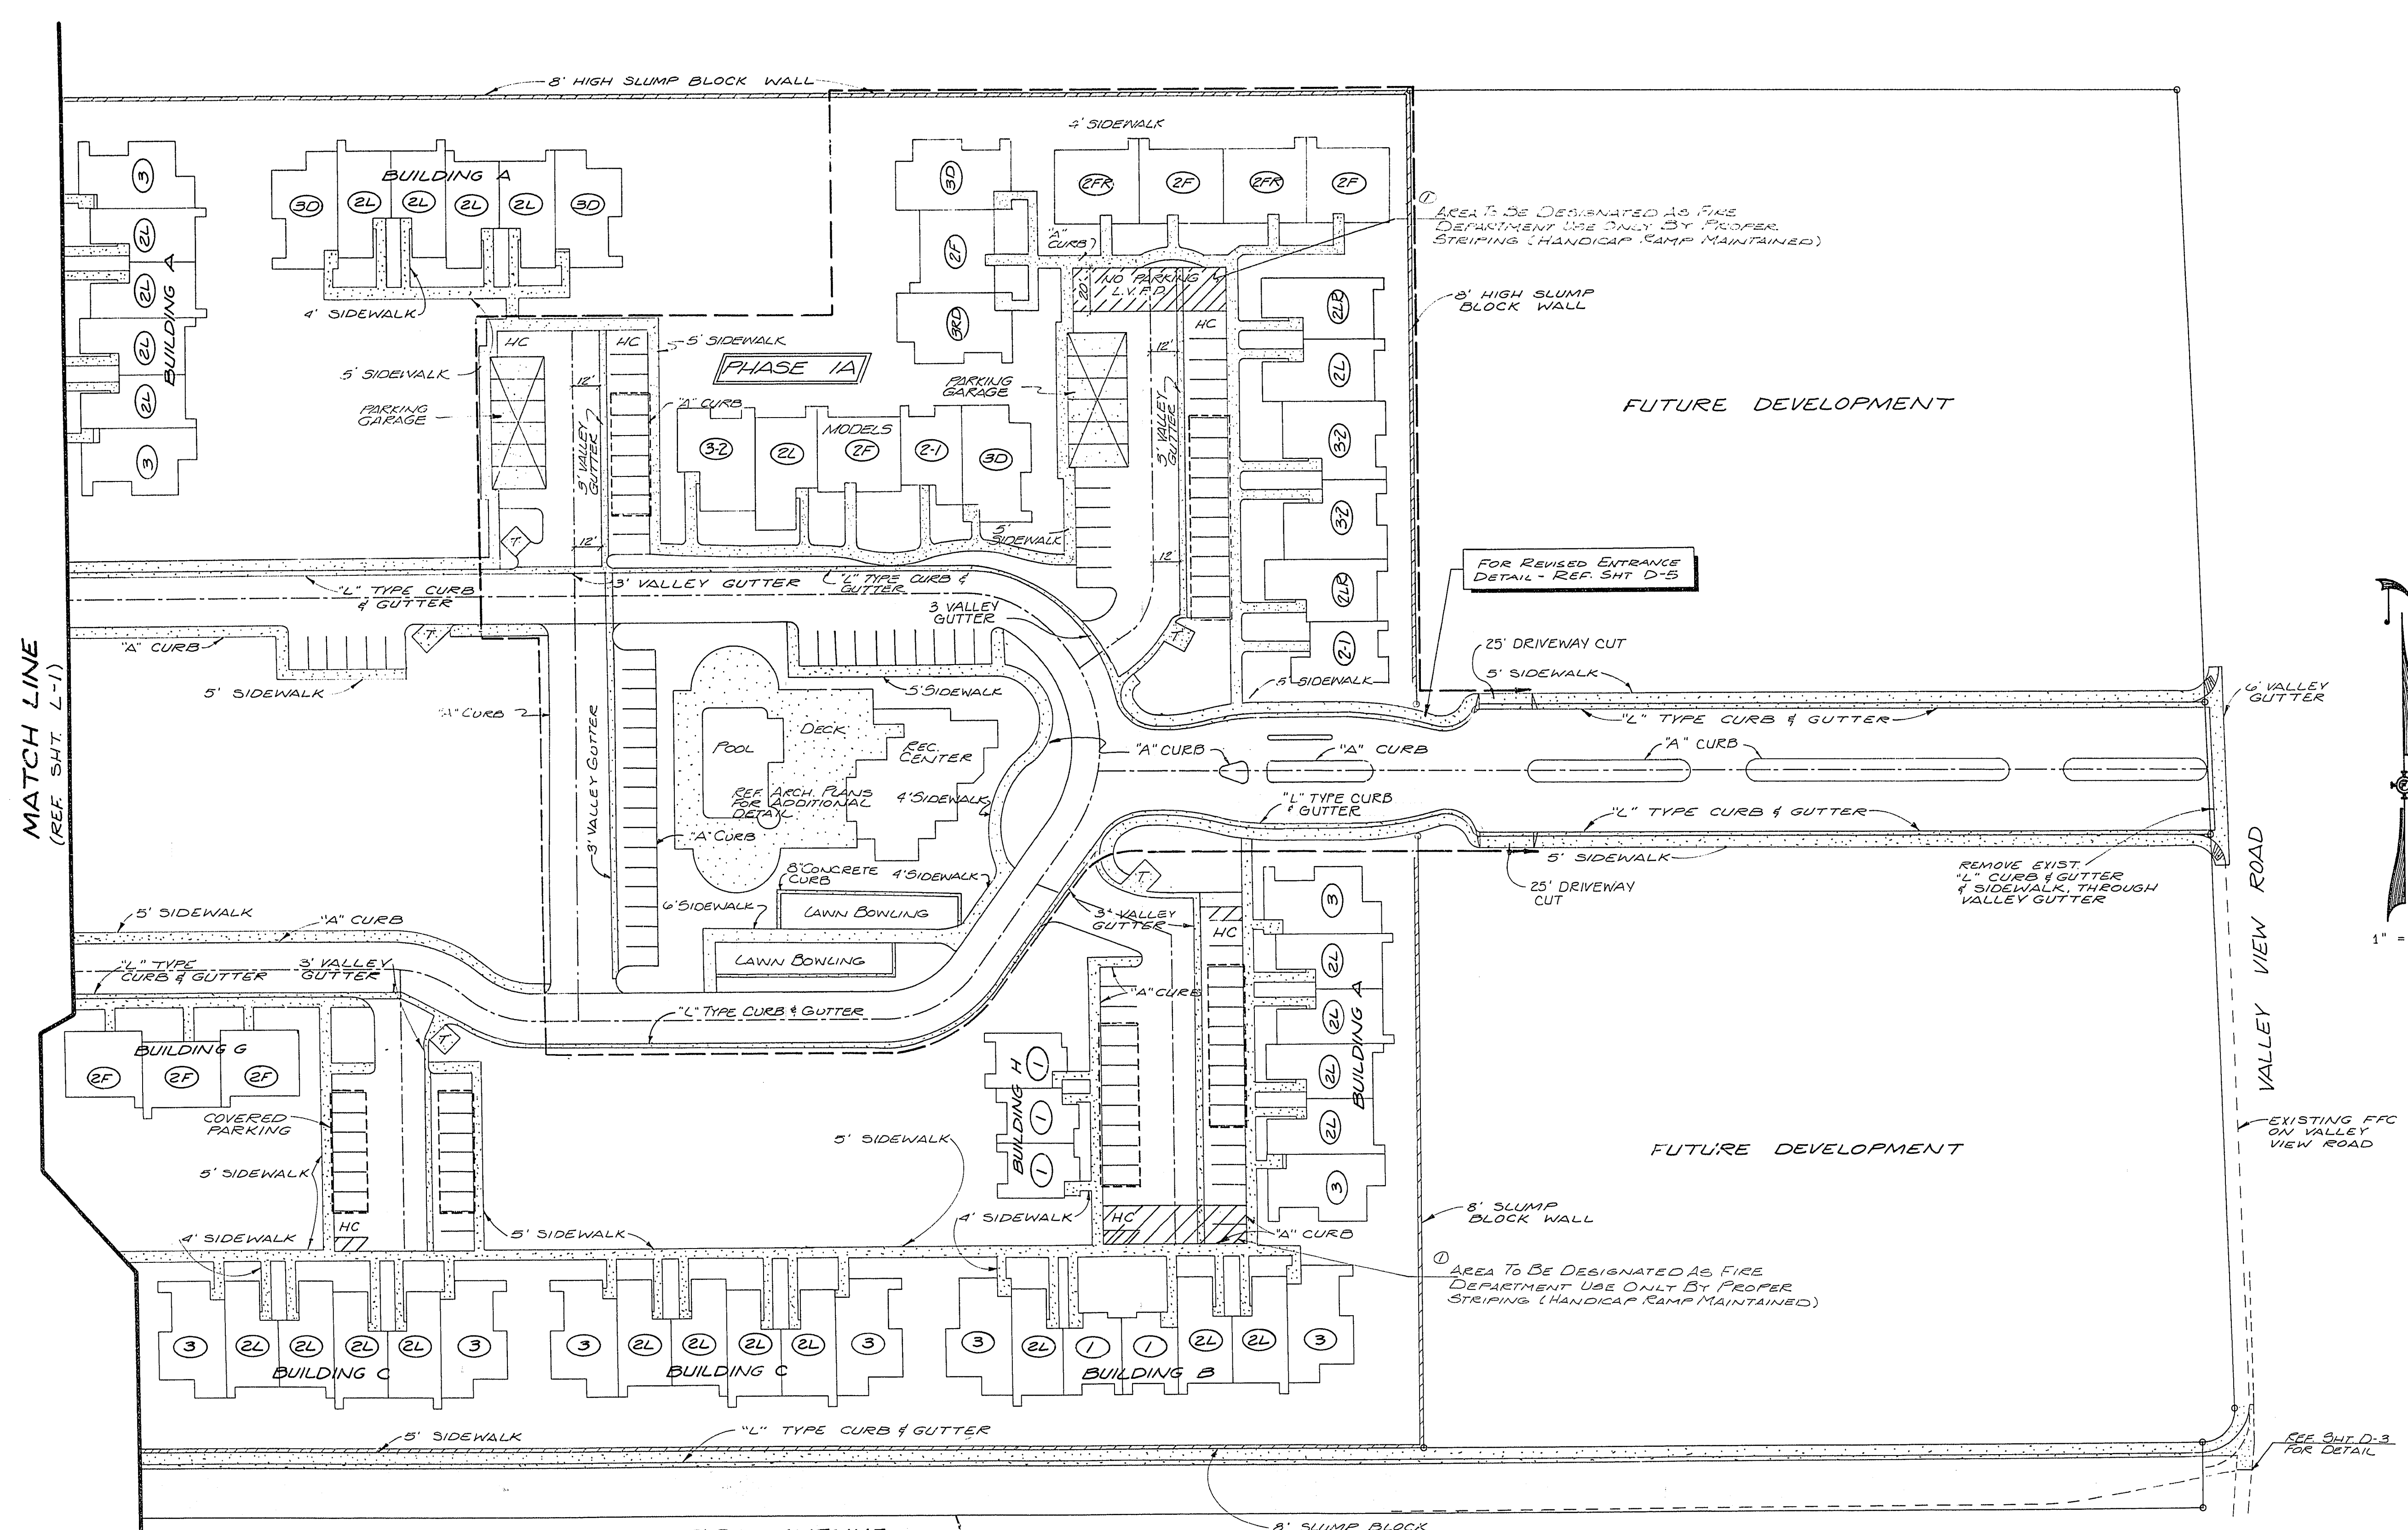

MATCH LINE
(REF. SHT. L-1)



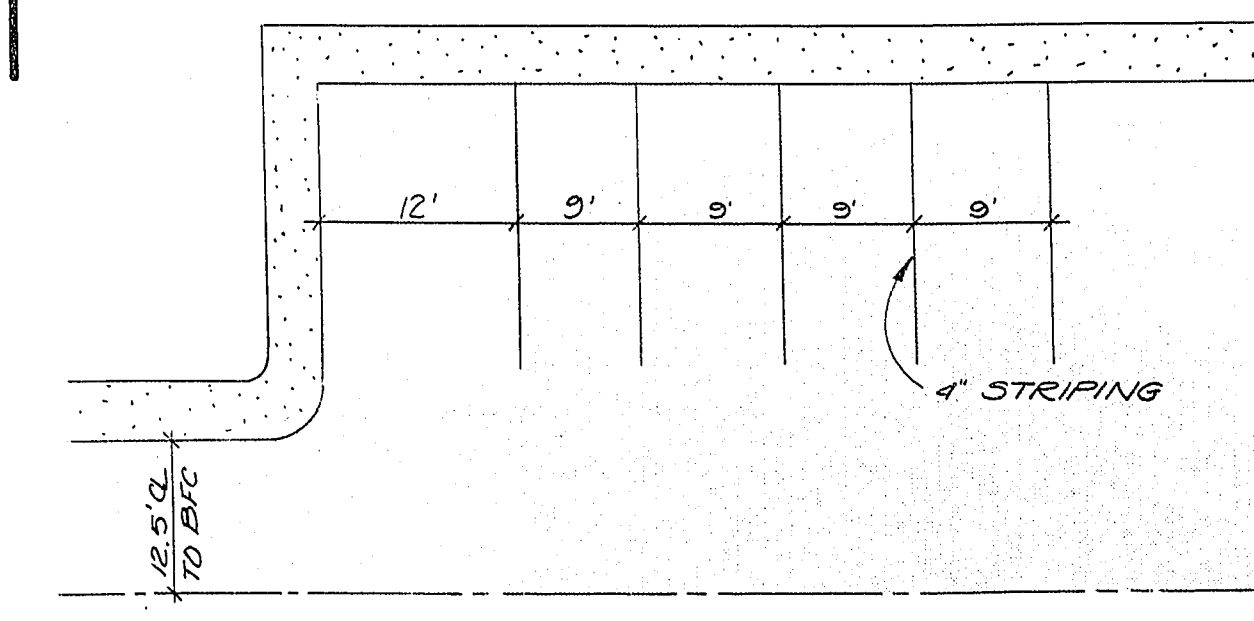


TARA AVENUE

IMPROVEMENTS TO TARA AVE TO BE CONSTRUCTED IN PHASE 1A.

8' SLUMP BLOCK WALL (STAGGERED) (REF. SHT. L-1)

- LEGEND**
- ③ UNIT TYPE
 - HC TRASH ENCLOSURE
 - HC HANDICAP PARKING
 - ASPHALT HANDICAP RAMP
 - HANDICAP RAMP
 - AC PAVEMENT
 - CONCRETE
 - COVERED PARKING
 - PARKING GARAGE (REF. ARCH. PLANS FOR DETAIL)

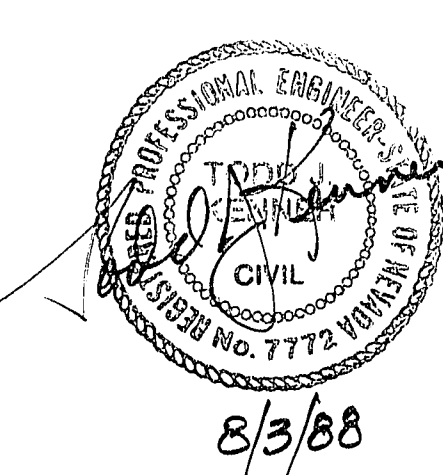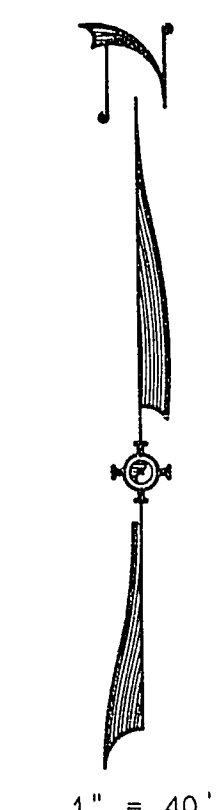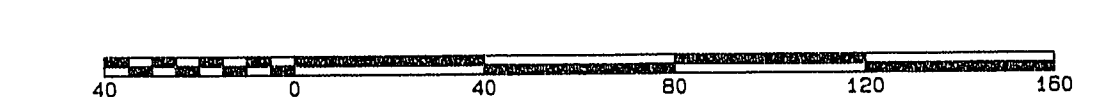

SHEET L-2 OF 19 Sheet 5	
SUMMIT ENGINEERING, ARCHITECTURE CONSULTING ENGINEERS AND SURVEYORS 125 E. HEND AVENUE, SUITE 200 LAS VEGAS, NEVADA 89101	
SCALE: HORIZ. 1"=40' VERT. 1"=10' JOB NO. 7036 DRAWING NO.	QUAIL ESTATES WEST PARKING & PAVING PLAN LAS VEGAS, CLARK COUNTY, NEVADA
DESIGNED BY: MAD DRAWN BY: CHECKED BY: DATE: AUGUST 1987	REV. DATE: DESCRIPTION: BY: APP'D: 1 11/2/87 PARKING AREA FIRE DEPT. KES 2 1/25/88 REVISION PHASE 1A KES 3 2/10/88 REV. ENTRANCE TO SERVICE MAD MAD

13-4-29 1074-4009-2