

CITY OF LAS VEGAS SANITATION NOTES:

- 1) ALL SANITARY SEWER INSTALLATIONS SHALL CONFORM TO THE STANDARD DETAILS AND SPECIFICATIONS OF THE CITY OF LAS VEGAS, AND SHALL ALSO CONFORM TO THE UNIFORM STANDARD SPECIFICATIONS FOR PUBLIC WORKS CONSTRUCTION OF OFF-SITE IMPROVEMENTS, CLARK COUNTY AREA, LATEST EDITION, UNLESS OTHERWISE NOTED.
- 2) CHISEL "S" OR "G" IN CURBS WHERE SEWER OR GAS LATERALS PASS UNDER THE CURB
- 3) POLYVINYL (PVC) SEWER PIPE SHALL MEET ASTM D-3034 SDR 35 SPECIFICATIONS, AND INSTALLED WITH SAND BEDDING AND BACKFILL OR TYPE II GRAVELL.
- 4) ALL MANHOLES IN PAVED STREETS 80' R/W AND LARGER, SHALL HAVE CONCRETE COLLARS.
- 5) TEE SADDLES SHALL BE USED TO CONNECT SEWER LATERALS TO EXISTING MAIN LINES UP TO 12" DIA. SIZE. CONNECTIONS TO 15" OR LARGER MAINS SHALL REQUIRE SPECIAL PROCEDURES.
- 6) A SEWER MAIN CROSSING OVER A WATER MAIN OR LESS THAN 18" UNDER A WATER MAIN MUST BE REINFORCED CONCRETE ENCASED PIPE FOR A DISTANCE NOT LESS THAN TEN FEET (10') TO EACH SIDE OF THE CENTERLINE OF THE WATER MAIN.
- 6) CALL BEFORE YOUR DIG 1-800-227-2600

CLARK COUNTY SANITATION DISTRICT GENERAL NOTES:

- 1) ALL CONSTRUCTION AND MATERIALS SHALL BE IN ACCORDANCE WITH THE LATEST EDITION OF THE DESIGN AND CONSTRUCTION STANDARDS OF THE CLARK COUNTY SANITATION DISTRICT AND THE UNIFORM STANDARD SPECIFICATION FOR PUBLIC WORKS CONSTRUCTION OFF-SITE IMPROVEMENTS, CLARK COUNTY AREA, NEVADA 1986, AS AMENDED. IN ALL CASES, THE DISTRICT'S CRITERIA SHALL SUPERSEDE THE UNIFORM STANDARD SPECIFICATIONS. IT WILL BE THE RESPONSIBILITY OF THE CONTRACTOR TO BE AWARE OF THE CONTENTS OF THE ABOVE SPECIFICATION BOOK.
- 2) CLARK COUNTY SANITATION DISTRICT'S STANDARD DRAWINGS SHALL APPLY TO ALL CONSTRUCTION.
- 3) SEWER MAINS ONLY TO BE LAID IN SEWER TRENCHES.
- 4) IT SHALL BE THE CONTRACTOR'S RESPONSIBILITY TO PERFORM CONSTRUCTION AS PER PLANS. ANY ADDITIONS, DELETIONS, OR CHANGES SHALL FIRST MEET WITH THE APPROVAL OF THE CLARK COUNTY SANITATION DISTRICT.
- 5) IF A LATERAL IS UNDER A DRIVEWAY, CONCRETE SLAB, OR A.C. AREA, A CLEAOUT SHALL BE INSTALLED AND RAISED TO GRADE WITH A SLOTTED BRASS CAP OR WITHIN A WATER METER BOX WHICH HAS A METAL COVER MARKED "SEW. C.O." THIS INSTALLATION SHALL BE IN ACCORDANCE WITH STANDARD DRAWING SD-12. ALL COMPONENTS OF CLEAOUTS SHALL BE THE SAME SIZE AS THE LATERAL.
- 6) SOILS TESTING SHALL BE IN ACCORDANCE WITH ITEM 25 OF THE CONSTRUCTION STANDARDS OF THE DISTRICT'S DESIGN AND CONSTRUCTION STANDARDS.
- 7) ALL EXFILTRATION, INFILTRATION, AND AIR TESTING OF LINES SHALL BE IN ACCORDANCE WITH THE DISTRICT'S DESIGN AND CONSTRUCTION STANDARDS.
- 8) CUT SHEETS MUST BE SUBMITTED TO THE DISTRICT BEFORE CONSTRUCTION WILL BE PERMITTED TO START.
- 9) ALL CONTRACTORS INSTALLING SEWER MAINS THAT WILL BE UNDER THE JURISDICTION OF THE DISTRICT MUST BE CLASS "A" CONTRACTORS.
- 10) ALL LATERAL CONNECTIONS AT THE PROPERTY OR EASEMENT LINE REQUIRE AN INSPECTION BY THE DISTRICT.
- 11) CONTRACTOR IS RESPONSIBLE FOR VERIFICATION OF ALL EXISTING UTILITIES WITHIN THE LIMITS OF CONSTRUCTION, AND PROTECTION OF THOSE UTILITIES DURING CONSTRUCTION.
- 12) LOCATION OF EXISTING SANITARY SEWER DERIVED FROM CLARK CO. SANITATION DISTRICT DOCUMENTS.
- 13) ADD 2000.00 FEET TO ALL ELEVATIONS SHOWN HEREON.


SAN. SEWER LEGEND

- SS SANITARY SEWER LINE W/SIZE & FLOW
- SANITARY SEWER CLEAOUT
- SANITARY SEWER SERVICE LATERAL

NOTE:

1. ALL SANITARY SEWER IS TO BE CONSTRUCTED USING SDR 35 PVC SEWER PIPE
2. ALL BUILDING SERVICES ARE TO BE 4" SDR 35 PVC SEWER PIPE.

1" = 40'

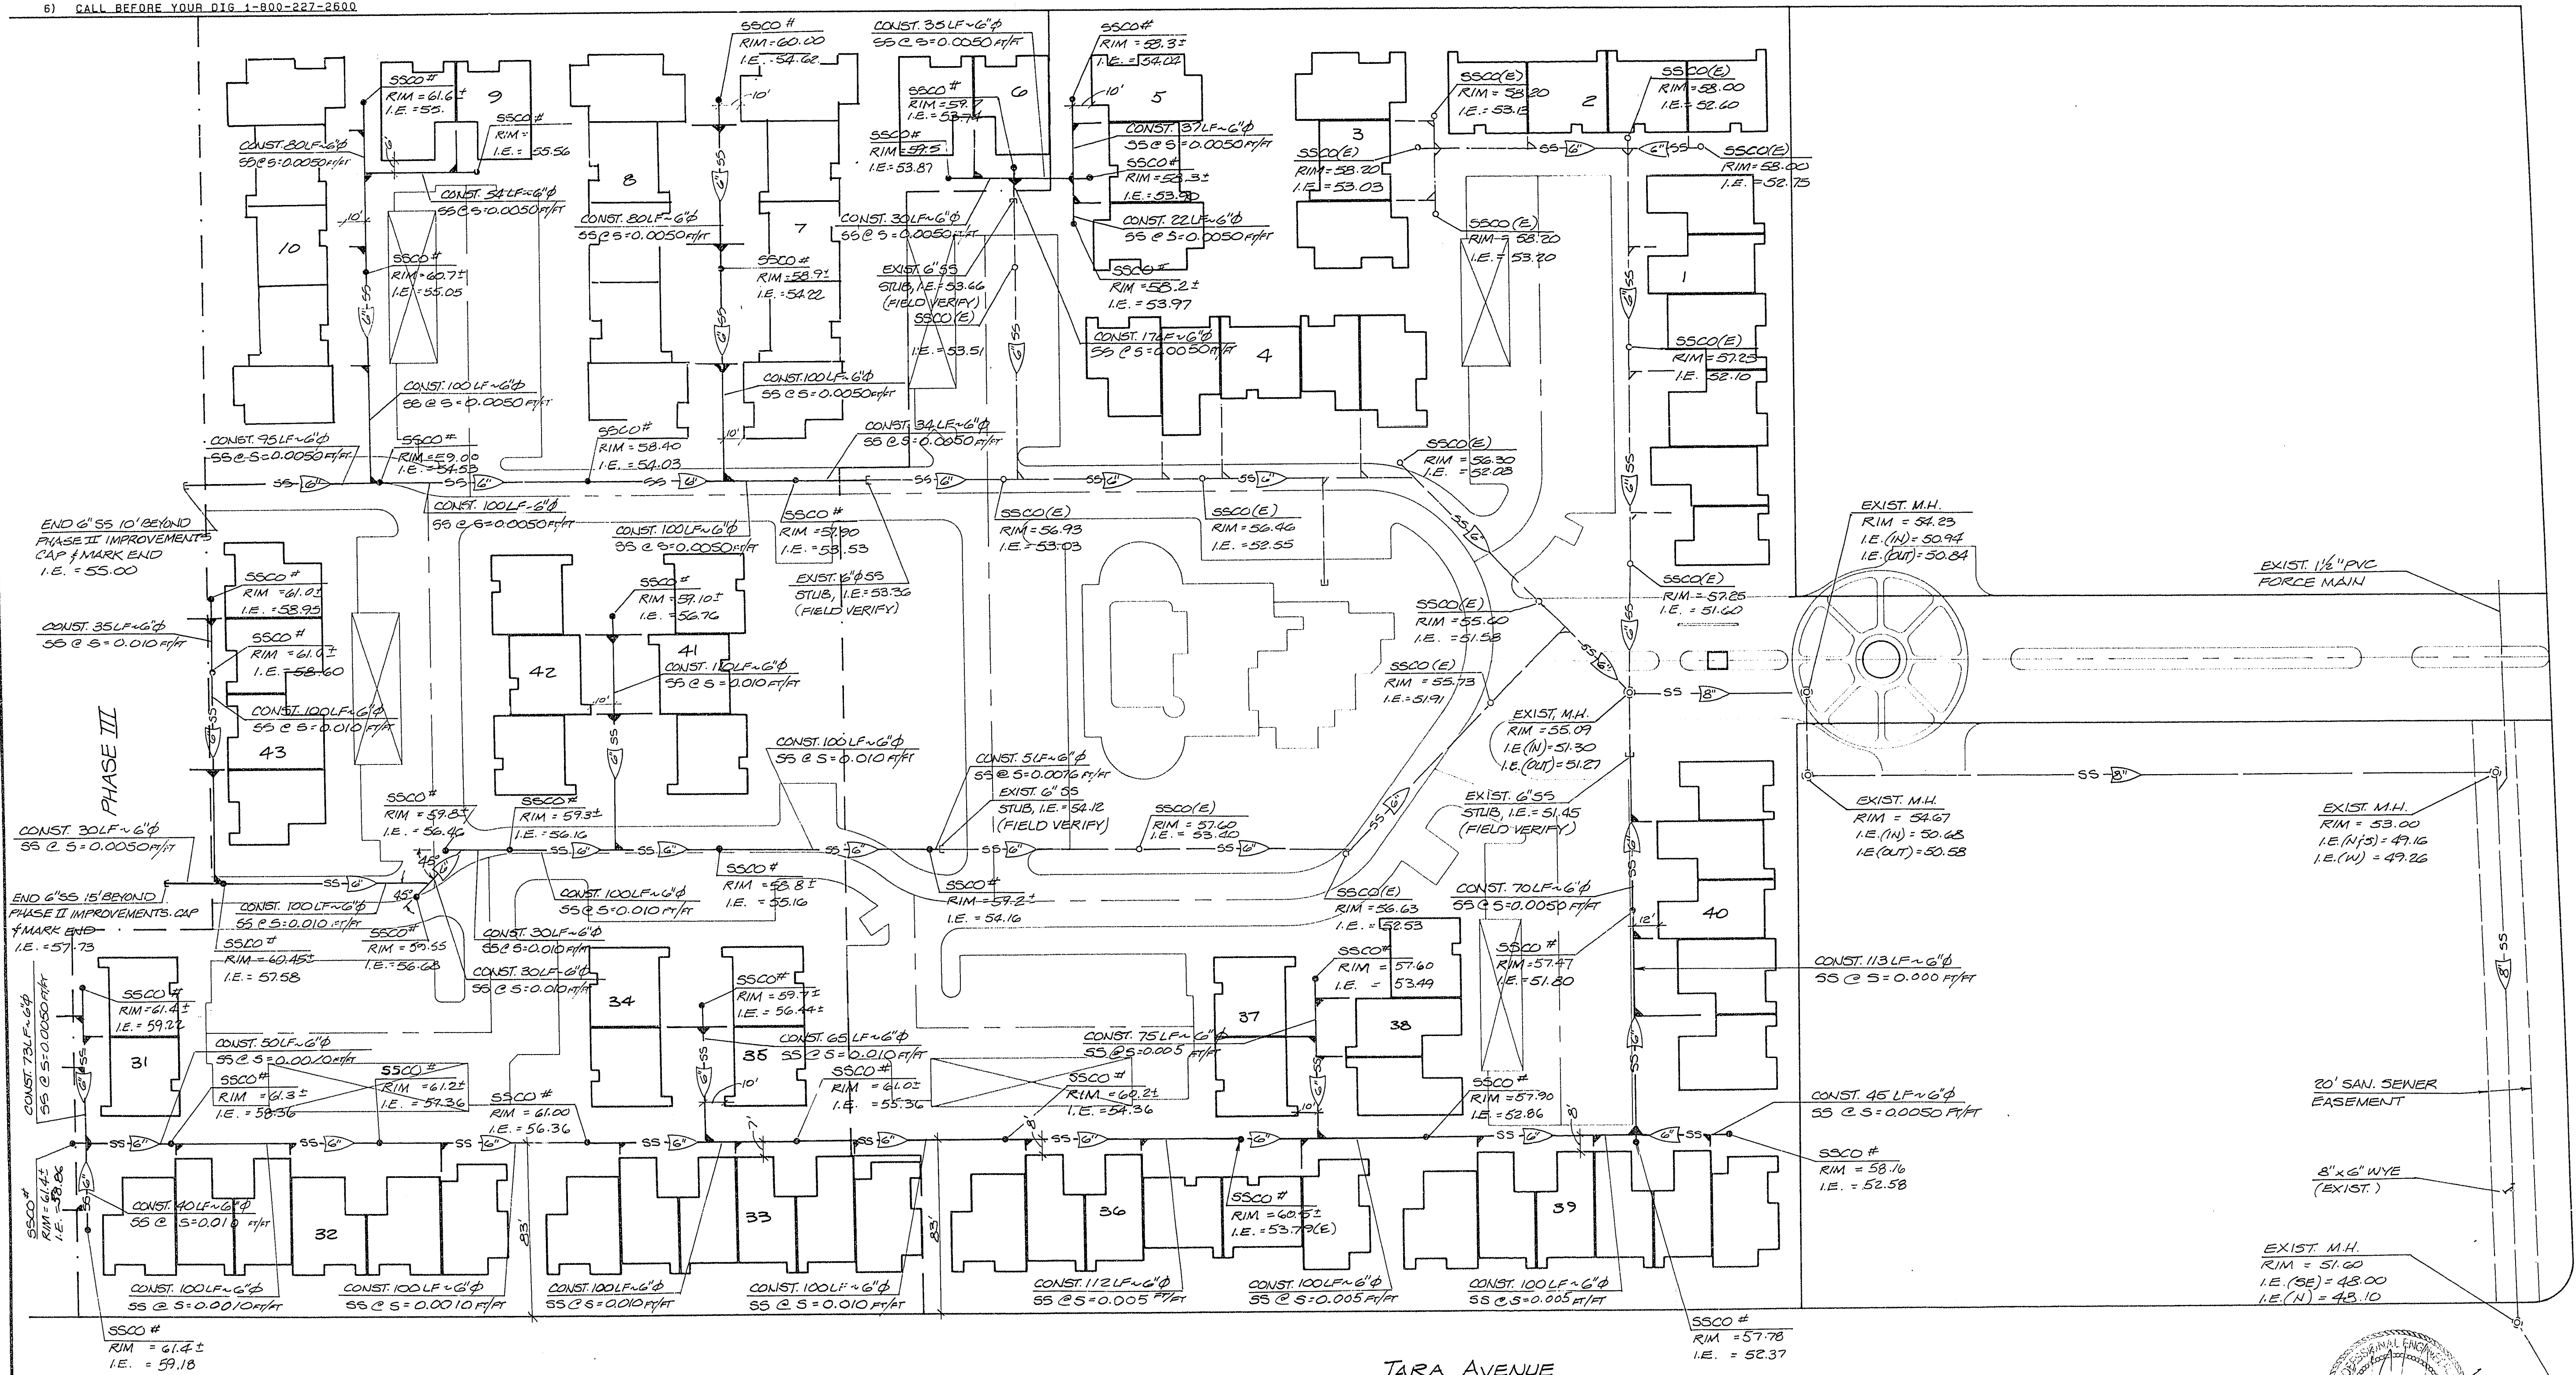

VALLEY VIEW BLVD.


TARA AVENUE

QUAIL ESTATES WEST
UNITS I & II
REVISED SEWER LAYOUT

CLARK COUNTY, NEVADA

REV	DATE	DESCRIPTION	BY	APP'D
1	9-25	REVISED SEWER	TJK	

DESIGNED BY: TJK
DRAWN BY: TJK
CHECKED BY: TJK
DATE: SEPT 1988

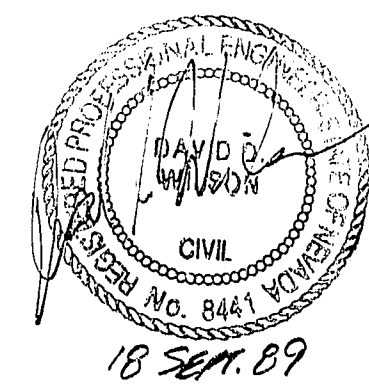

13-9-40 Revised 3074-4009-1 R