



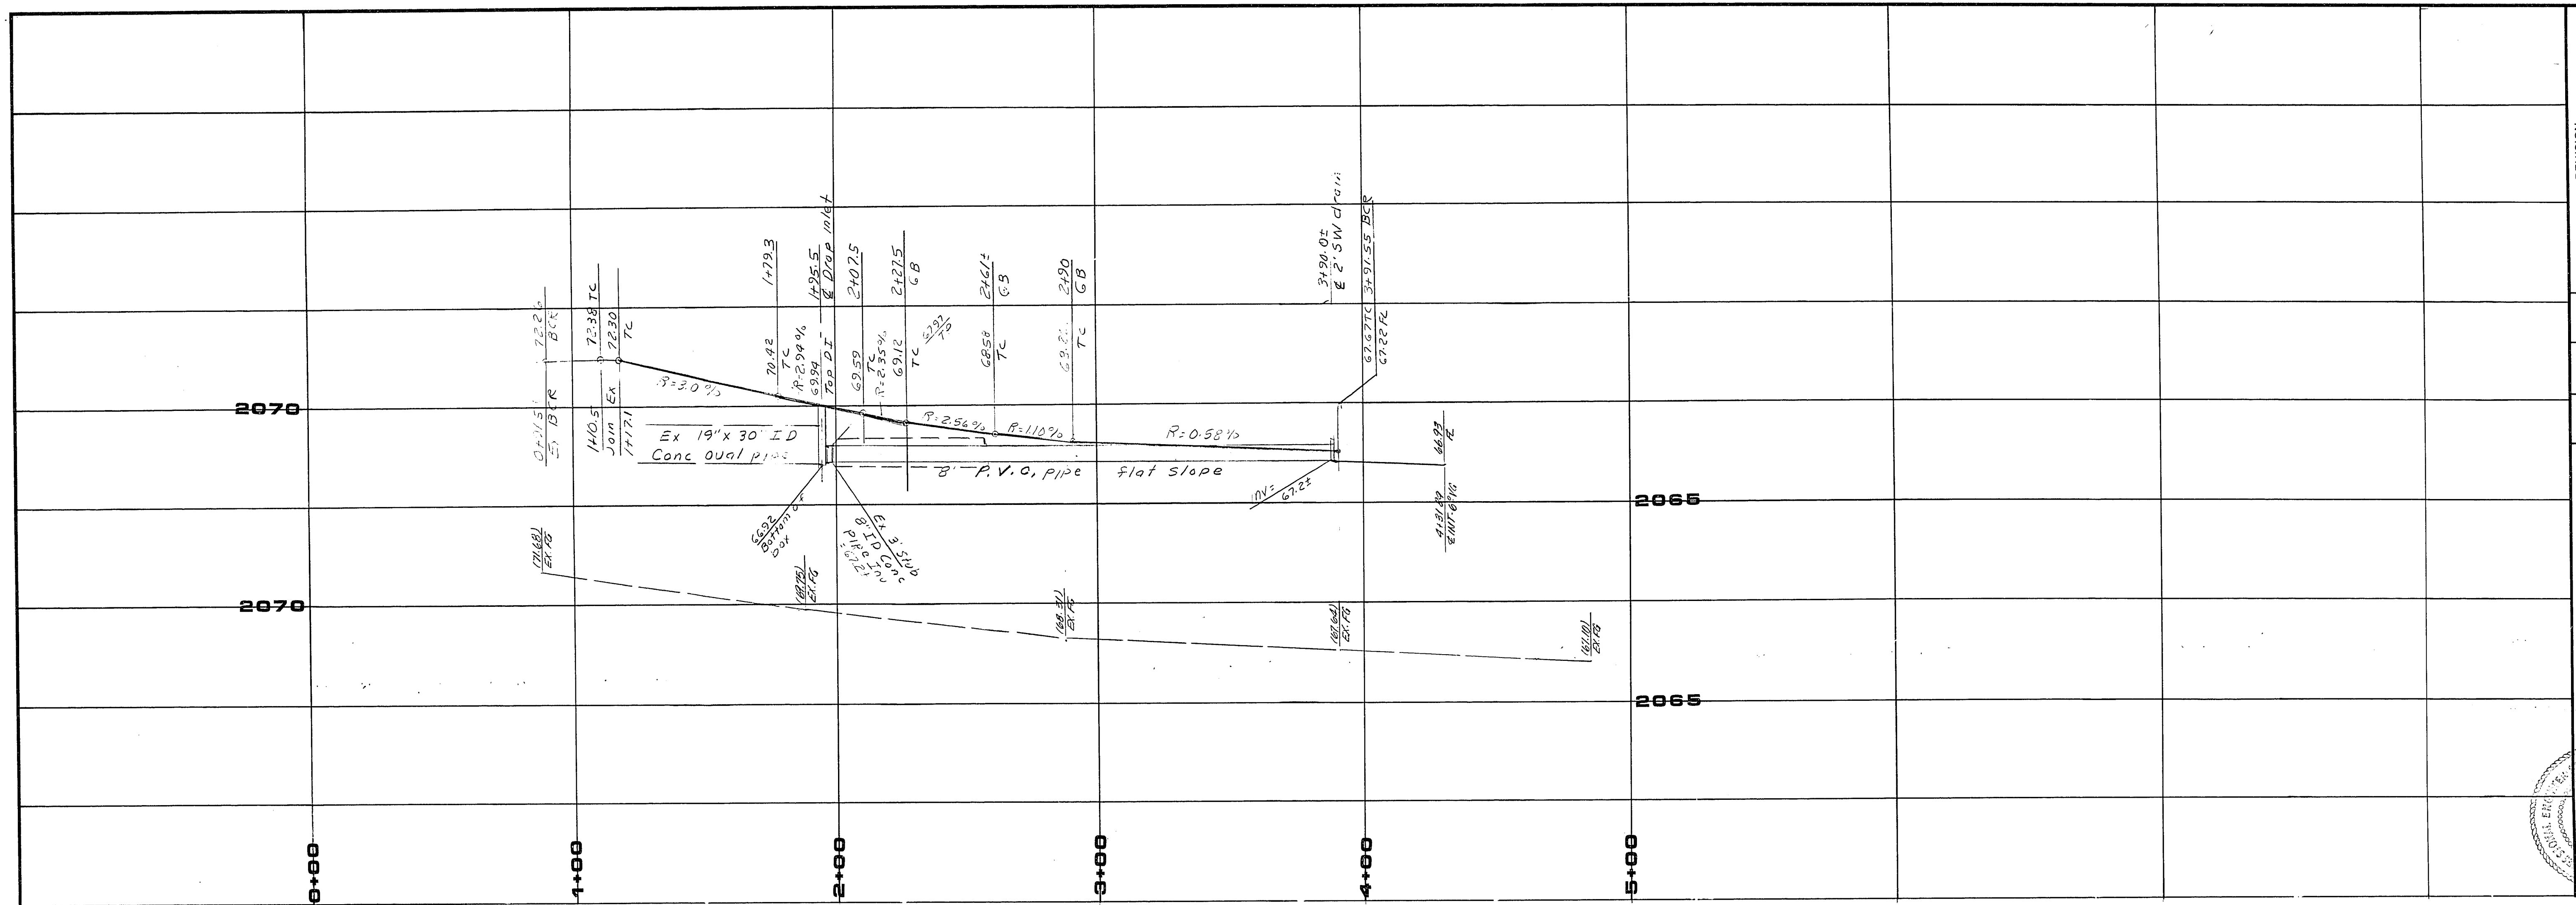

REV	DATE	BY	REVISION
1	1/27/81	R.F.	CLV CHECK PRINT
2	5/28/81	CE	Added 8\"/>

DATE	1/19/91
DATE	

CONSULTING ENGINEERS • PLANNERS
2209 Paradise Road • Las Vegas, Nevada 89104
(702) 735-0227

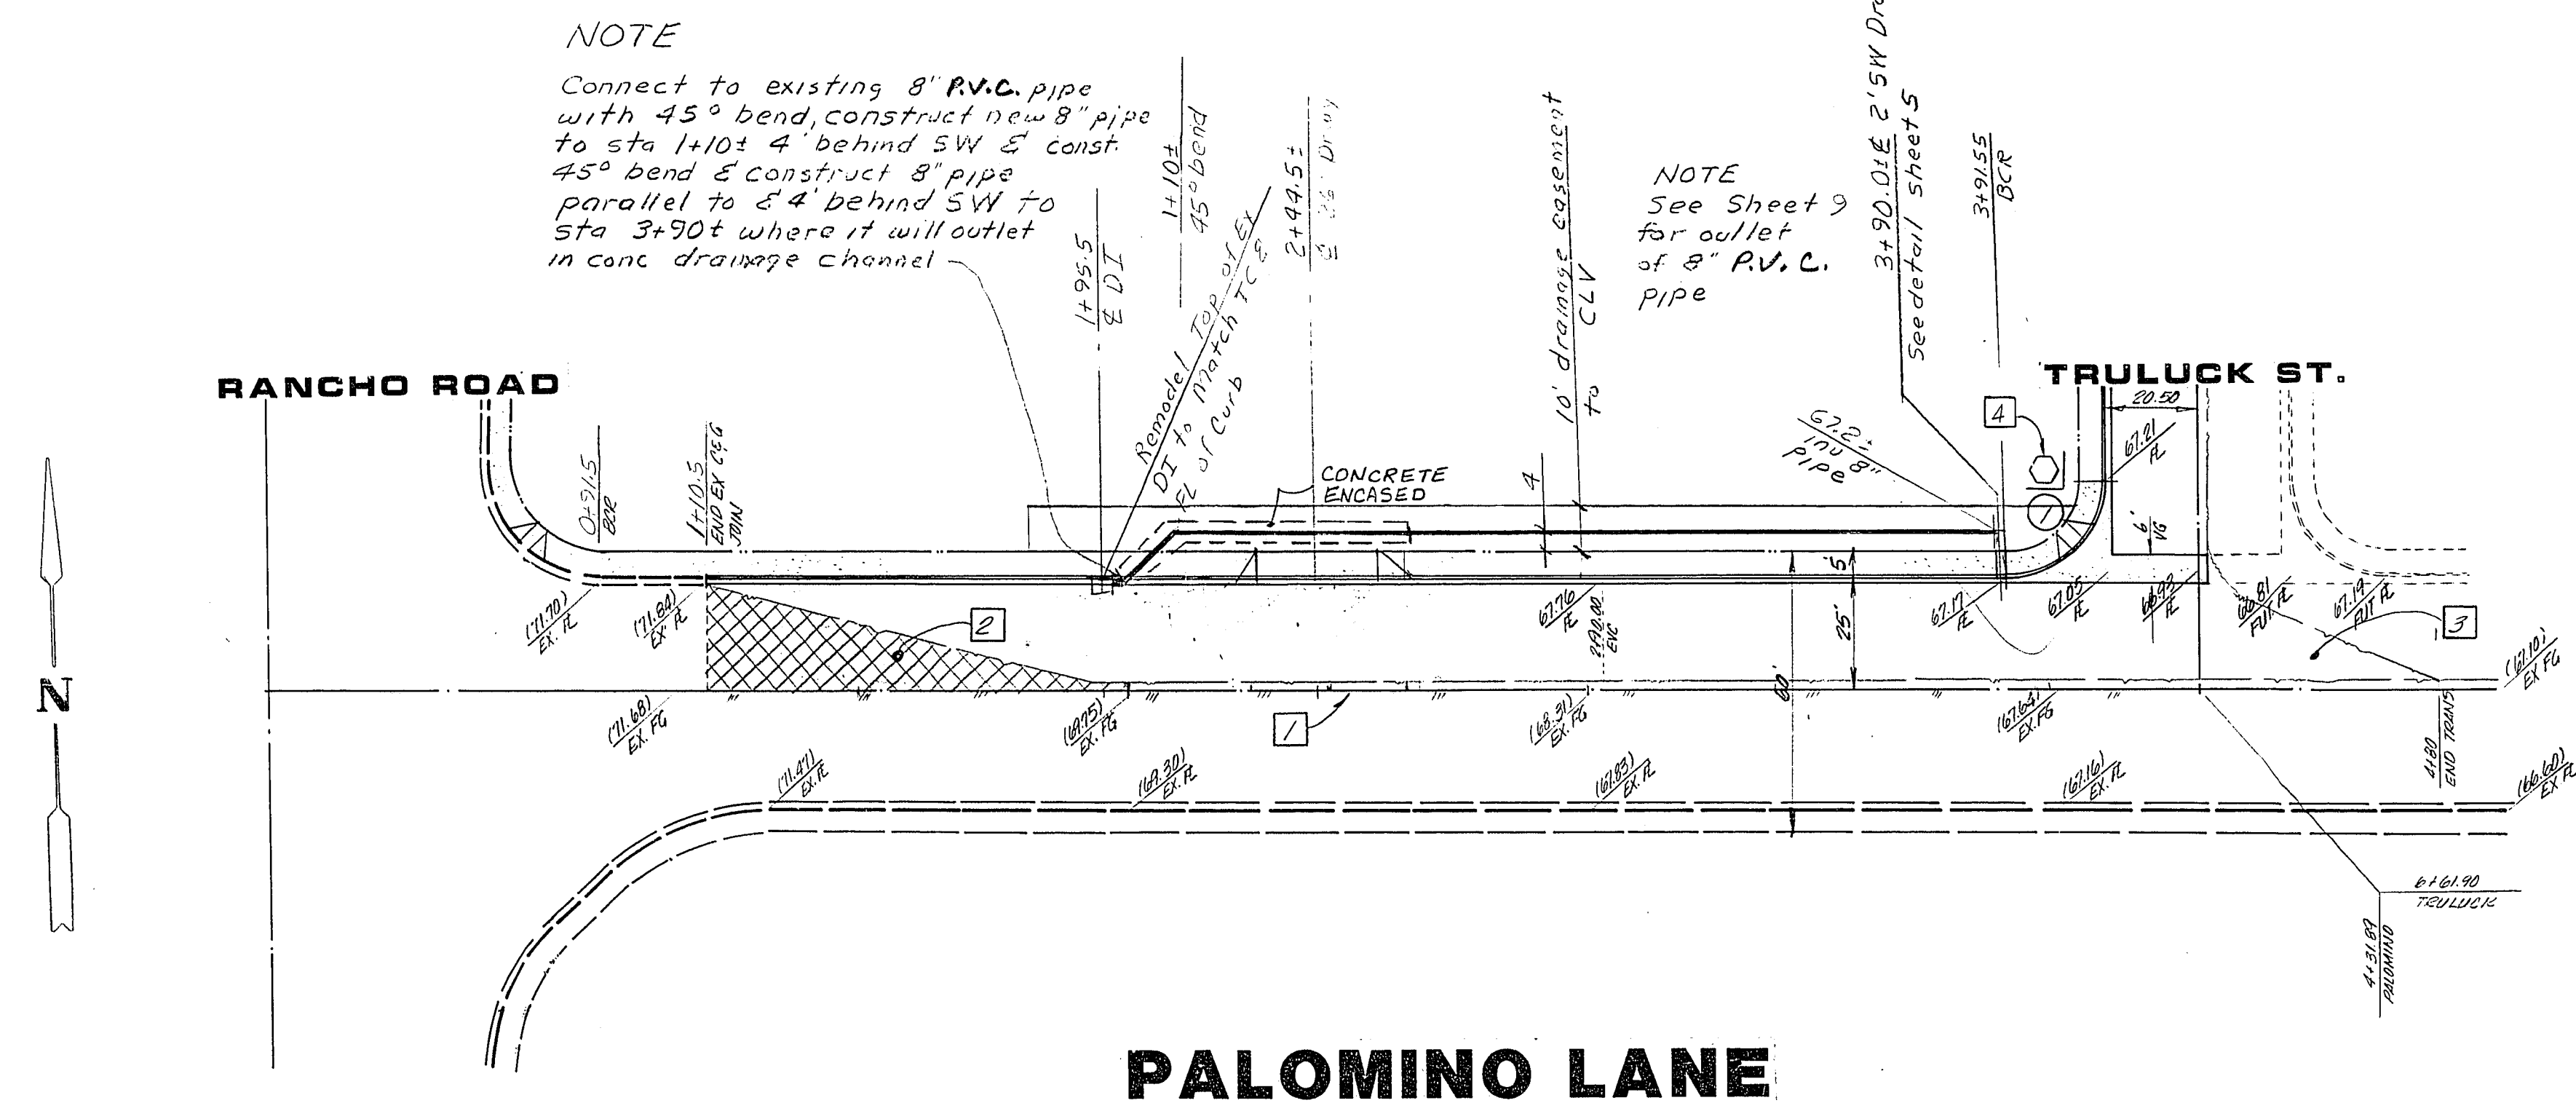

NO.	A	R	L	T
1	89.47.41	20.00	31.34	19.93

- NOTES
- 1. SINK CUT EX AC AT CENTERLINE AND MATCH
 - 2. REMOVE EX AC (CROSSHATCHED AREA)
 - 3. CONST 50' ± TRANSITION
 - 4. INSTALL STOP SIGN & ST. NAME SIGN PER CLV STDs.

APPROVED

CLV CITY ENGINEER DATE

CLV QUALITY CONTROL ENGINEER DATE

CLV TRAFFIC ENGINEER DATE

TITLE STREET PLAN AND PROFILE
PALOMINO LANE

PROJECT QUAIL PARK 2

WO NO. 2852

BY R. Valentini

DATE 1-7-81

SCALE 100' 1"=30'

VERT. 1"=4'

SHEET 4

OF 9 SHEETS