
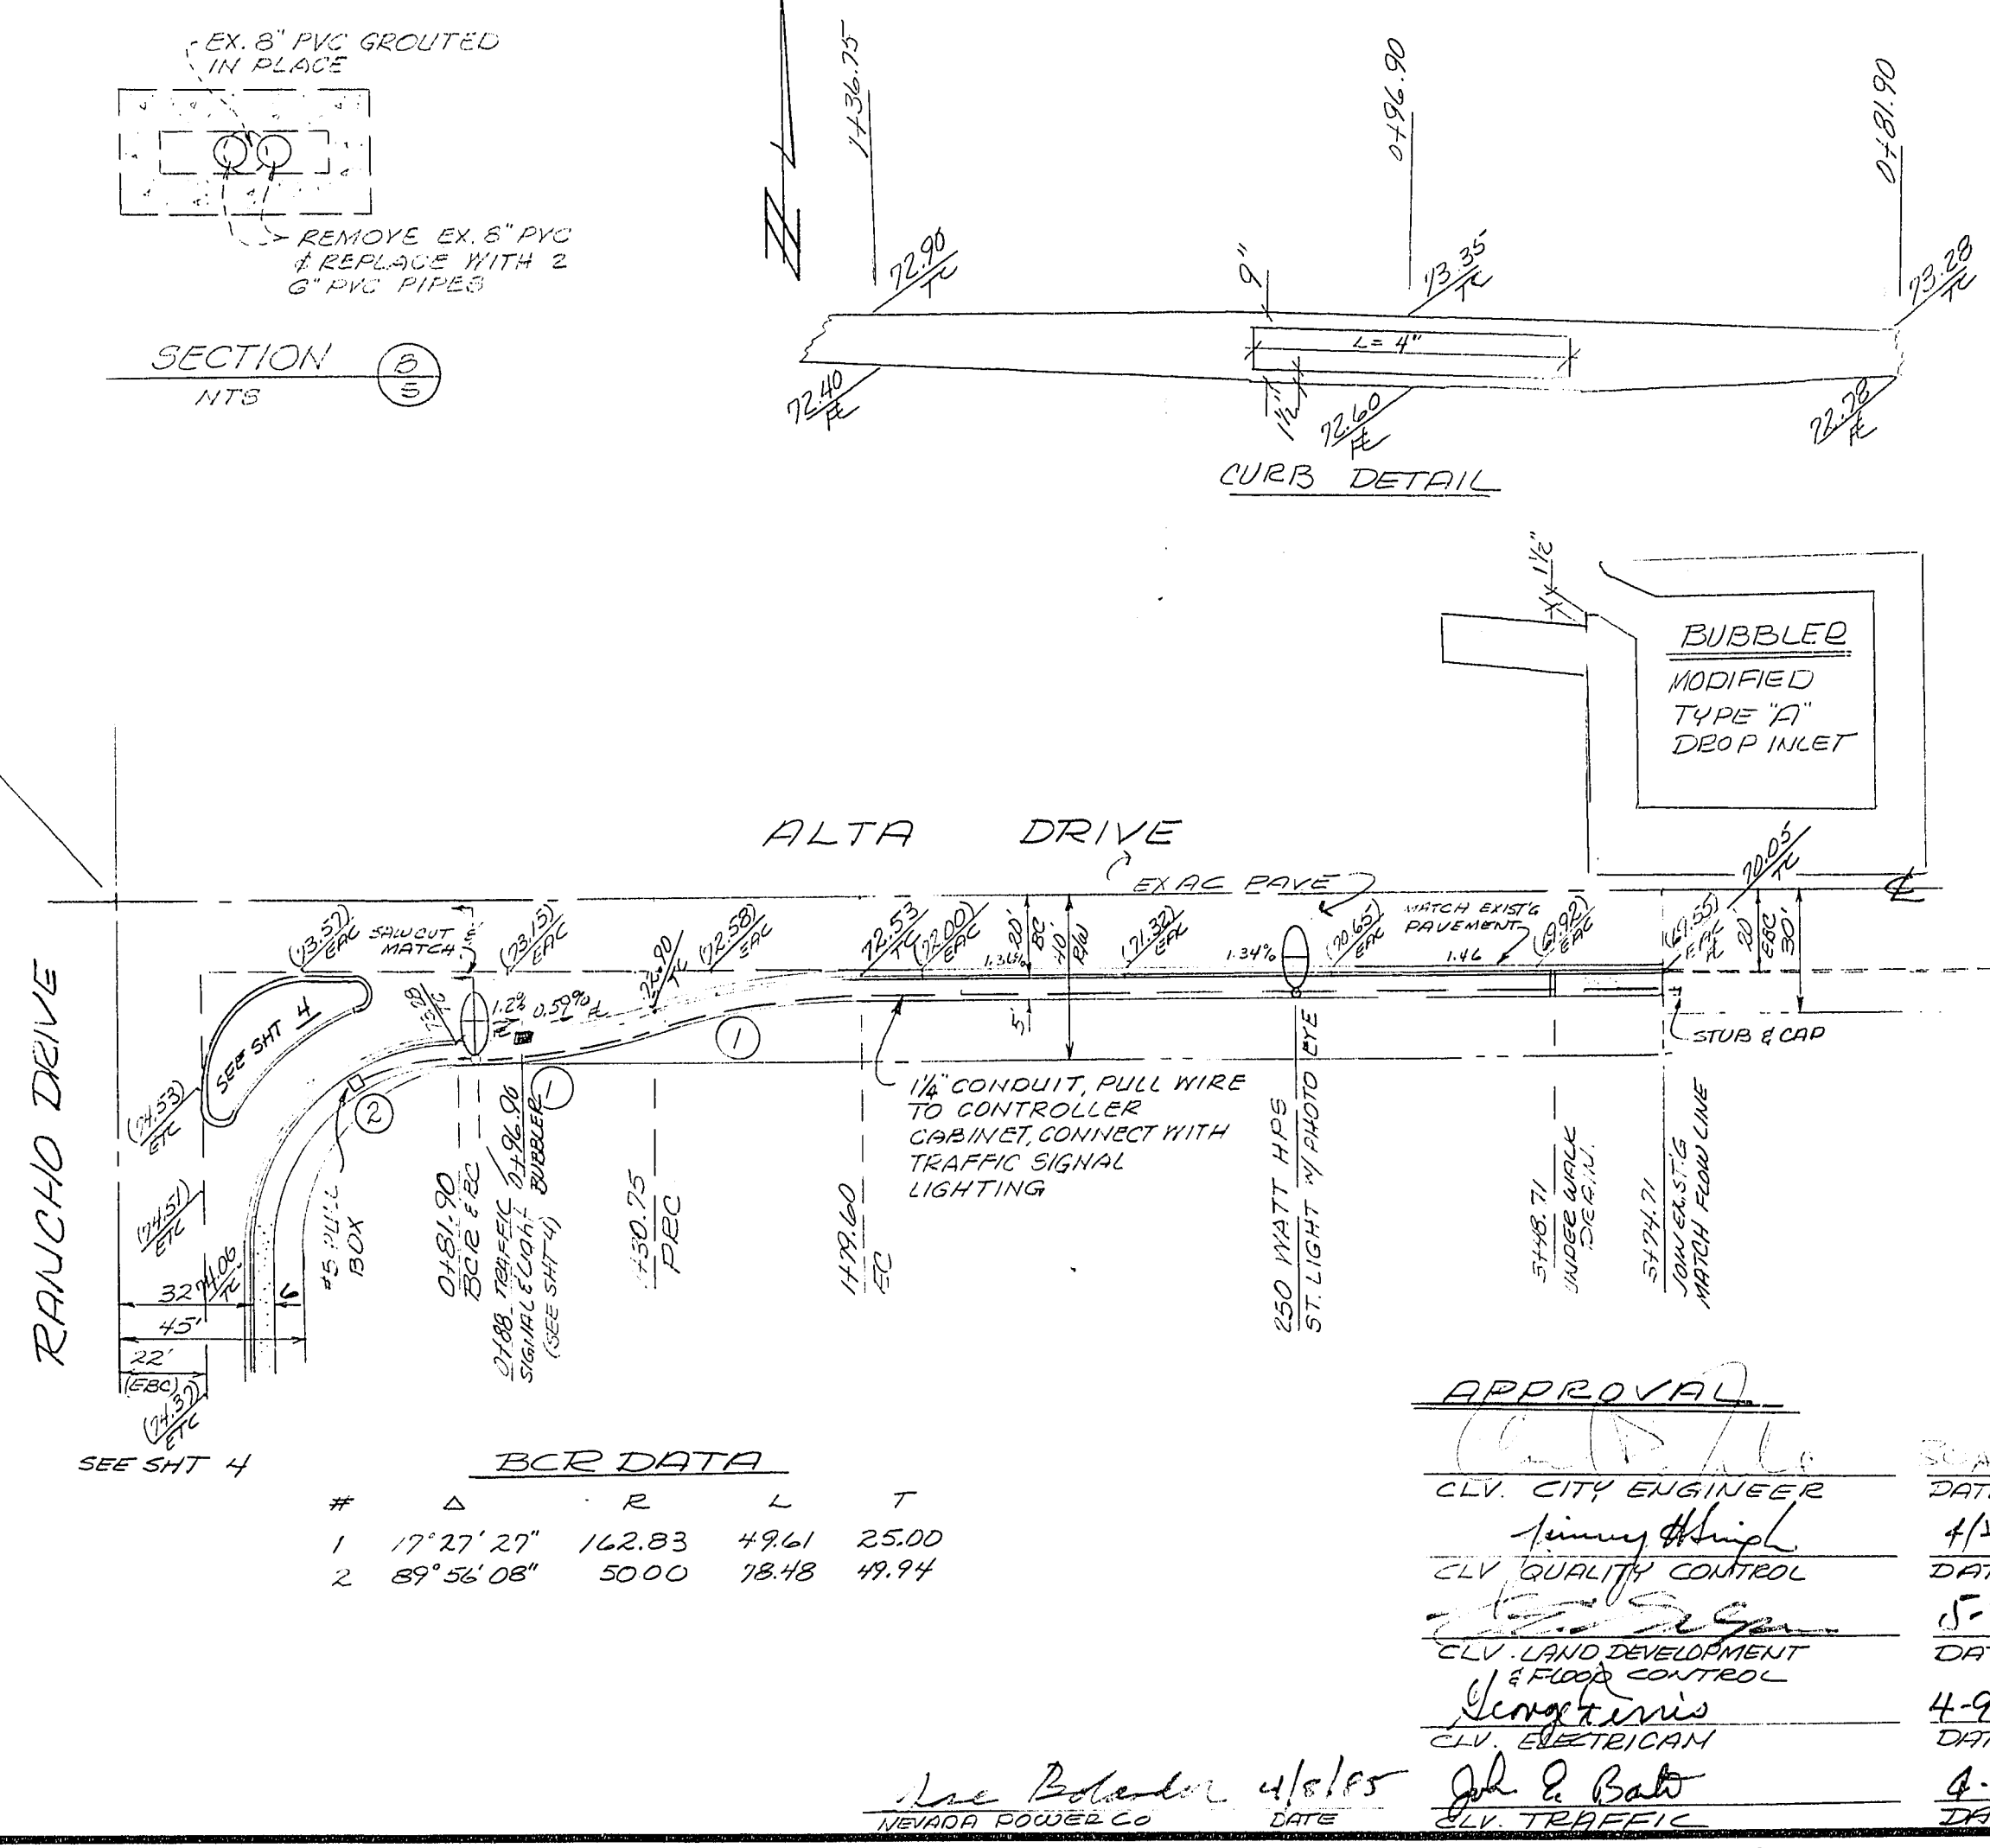
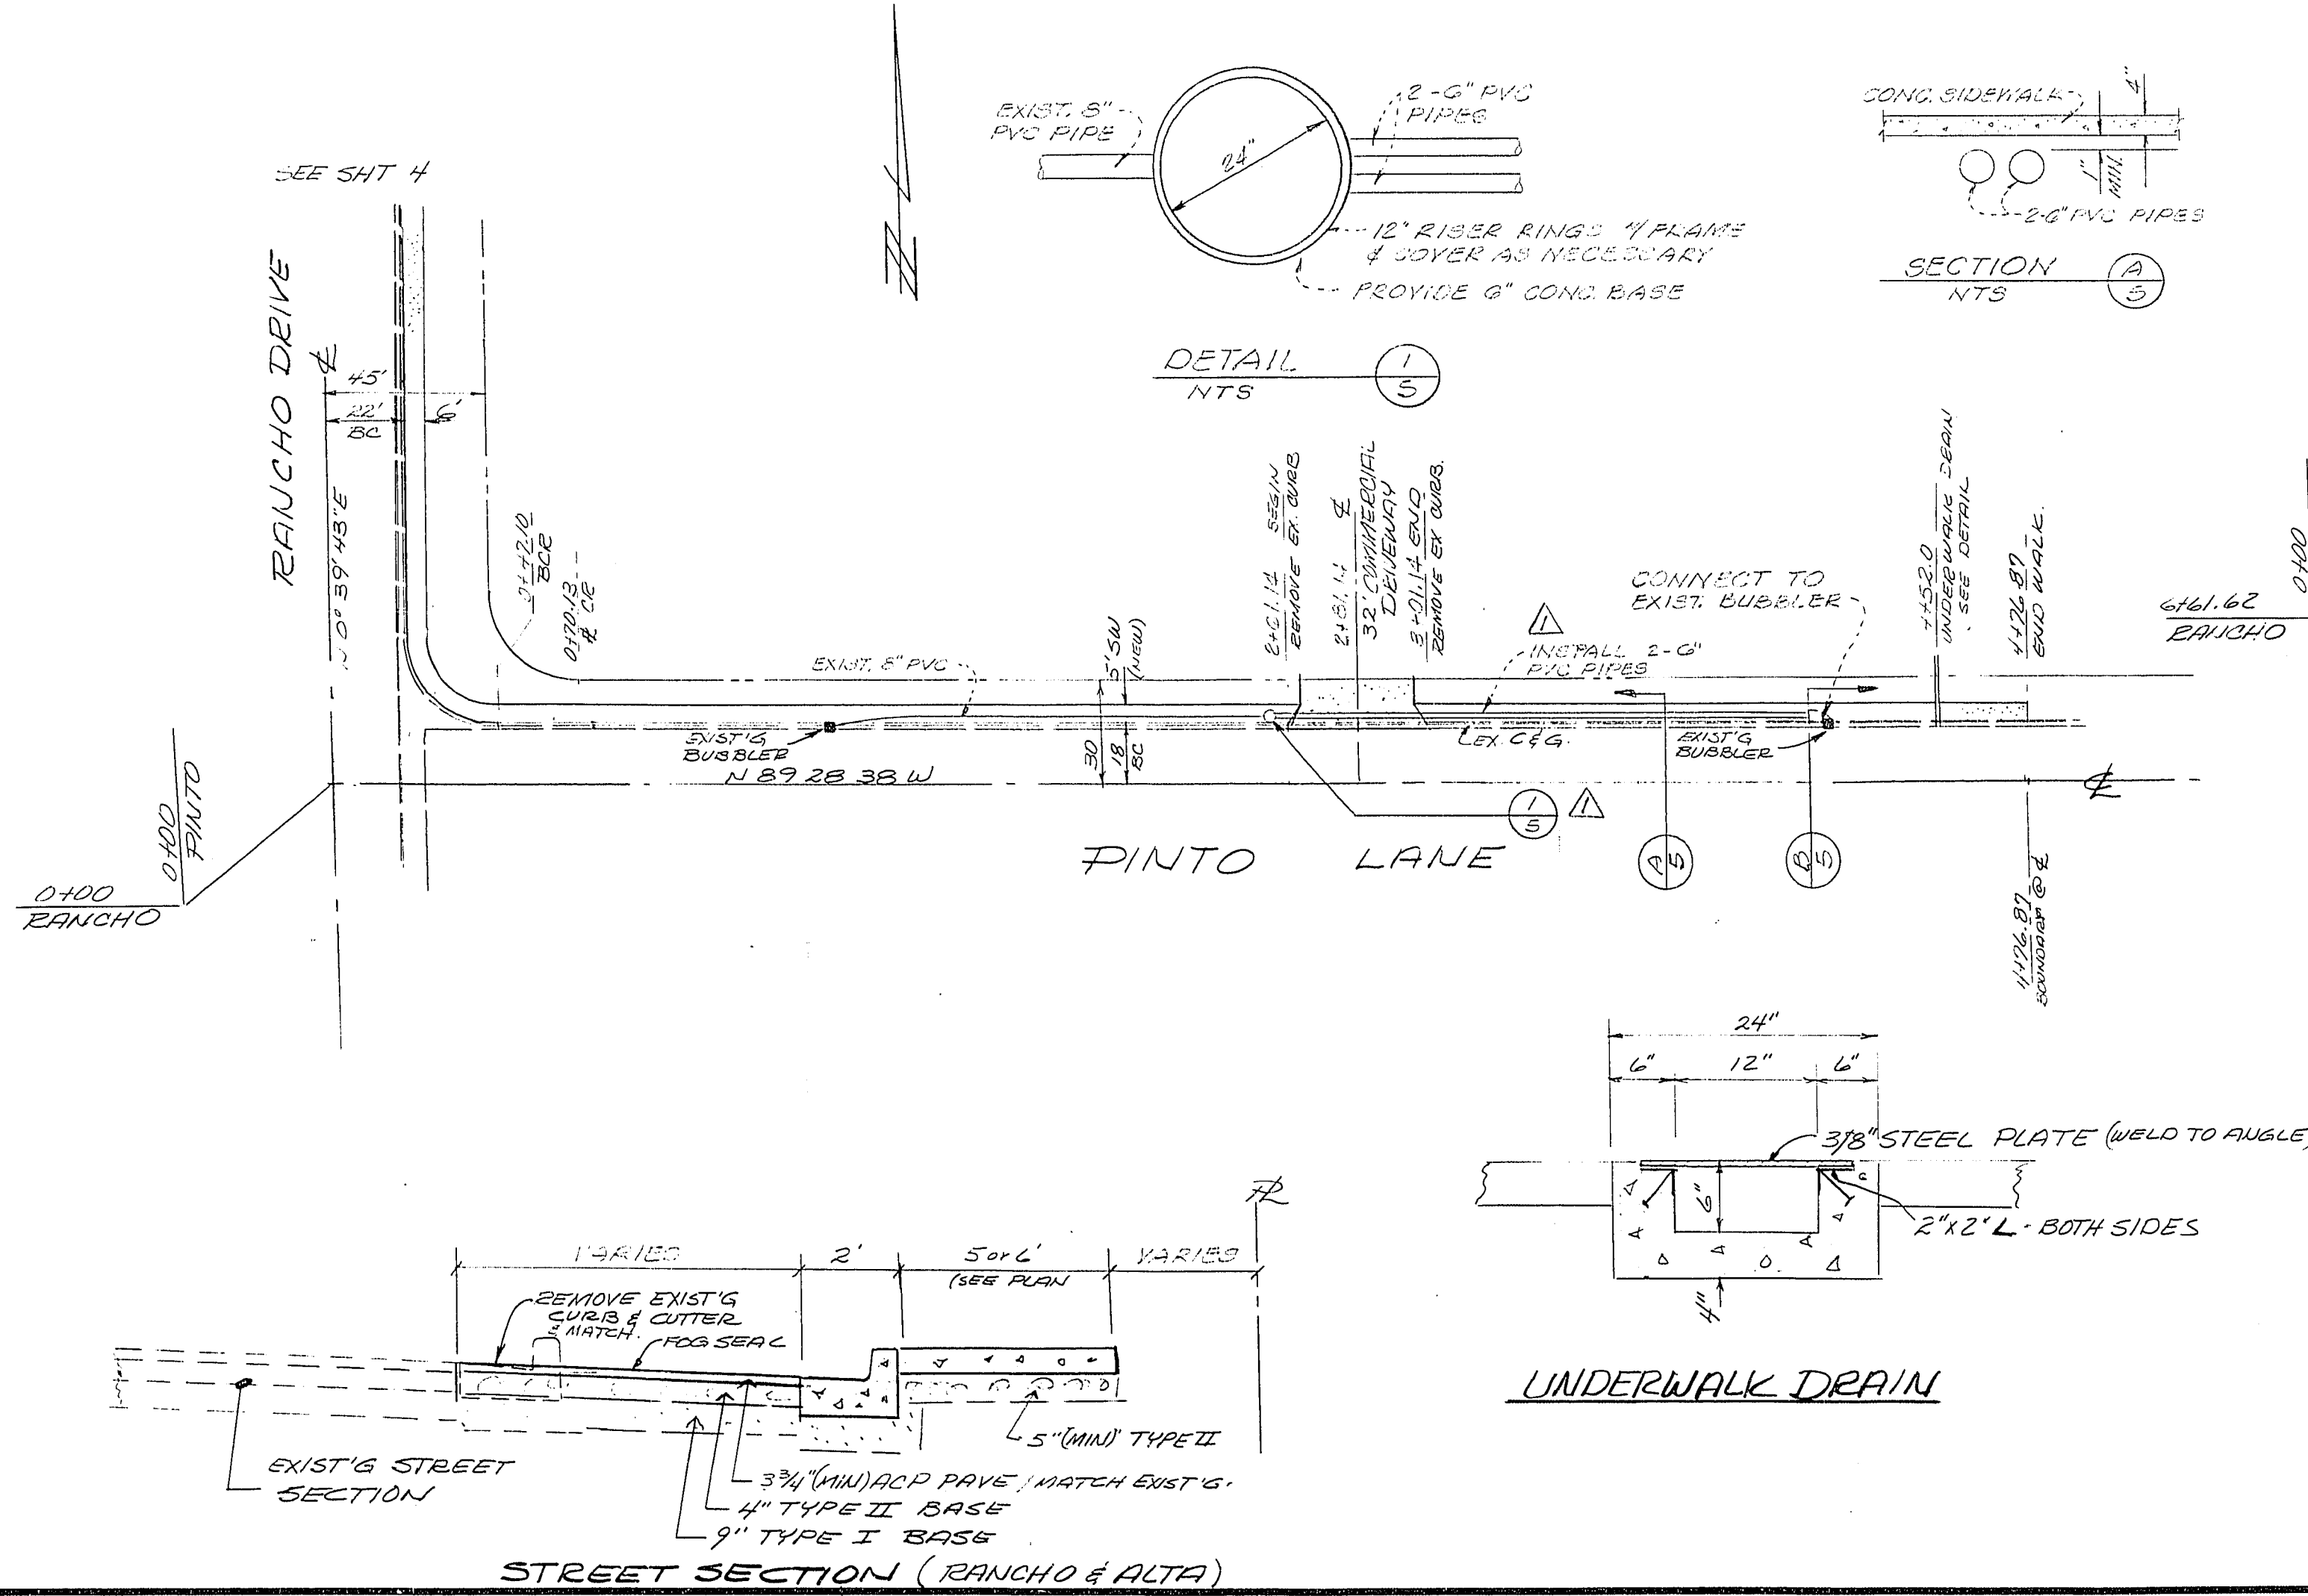


CLV STREET LIGHT NO. 1.

ALL STREET LIGHTING INSTALLATIONS SHALL CONFORM TO THE LATEST ISSUE OF THE STANDARD DETAILS AND SPECIFICATIONS OF THE CITY OF LAS VEGAS, AND SHALL ALSO CONFORM TO THE UNIFORM STANDARD SPECIFICATIONS FOR PUBLIC WORKS CONSTRUCTION OF OFF-SITE IMPROVEMENTS, CLARK COUNTY AREA, 1978, UNLESS OTHERWISE NOTED.

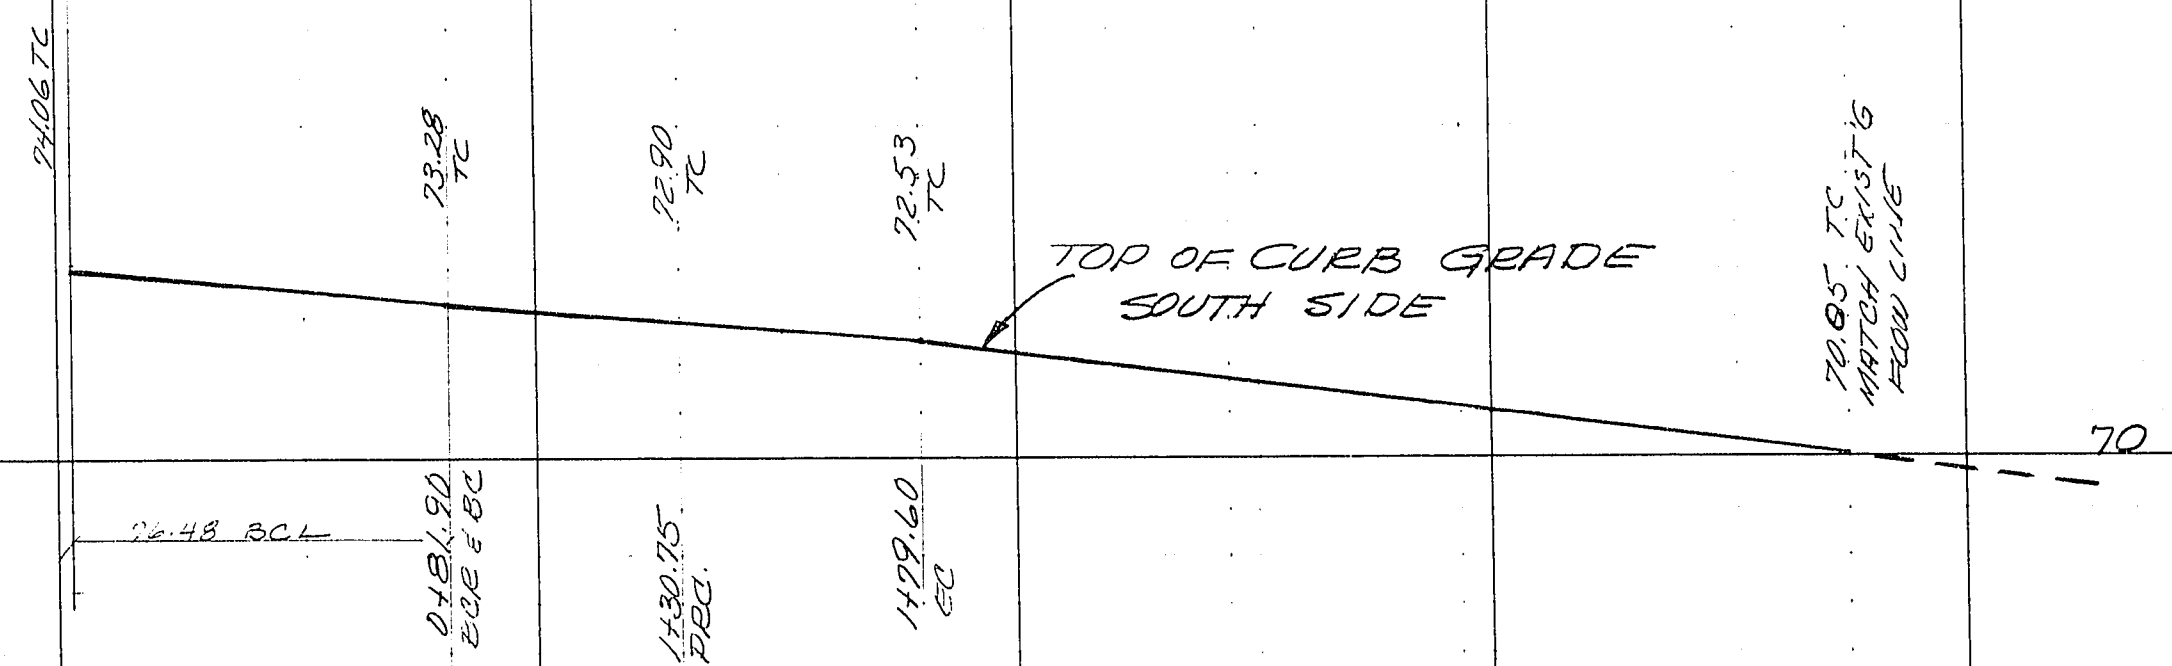

REV	DATE	BY	REVISION
1	9-2-85	R.H.	REVISED PLAN CONFORM WITH 9/1/85 SET
2	6-10-87		ADDED DETAIL (A) & 2-27 PVC PIPES
3			ADDED SECTION (A) & (B)
4	11-18-88		ADD BARRIER DETAIL TO ALTA DE

STREET PLAN & PROFILE

QUAIL PARK

WO NO.	3218
BY	COS
DATE	3/1/85
SCALE	1"=40'
SHEET	
5	
OF	7 SHEETS