NOTES

1.- ALL RETAINING WALL IS THIS PARCEL DEVELOPER'S COST.
2.- ALL FILL MATERIAL AND GRADING NECESSARY WITHIN SUMMERLIN'S H.O.A. COMMON LOT (SEE SECTIONS "A", "F", "N", "Q" AND "S") AS A RESULT OF THIS PARCEL DEVELOPER'S PROPOSED GRADES IS THIS PARCEL DEVELOPER'S COST.
3.- ALL WALLS WITH 5'-0" OR LESS RETAINMENT ARE CITY OF LAS VEGAS STANDARD WALLS.

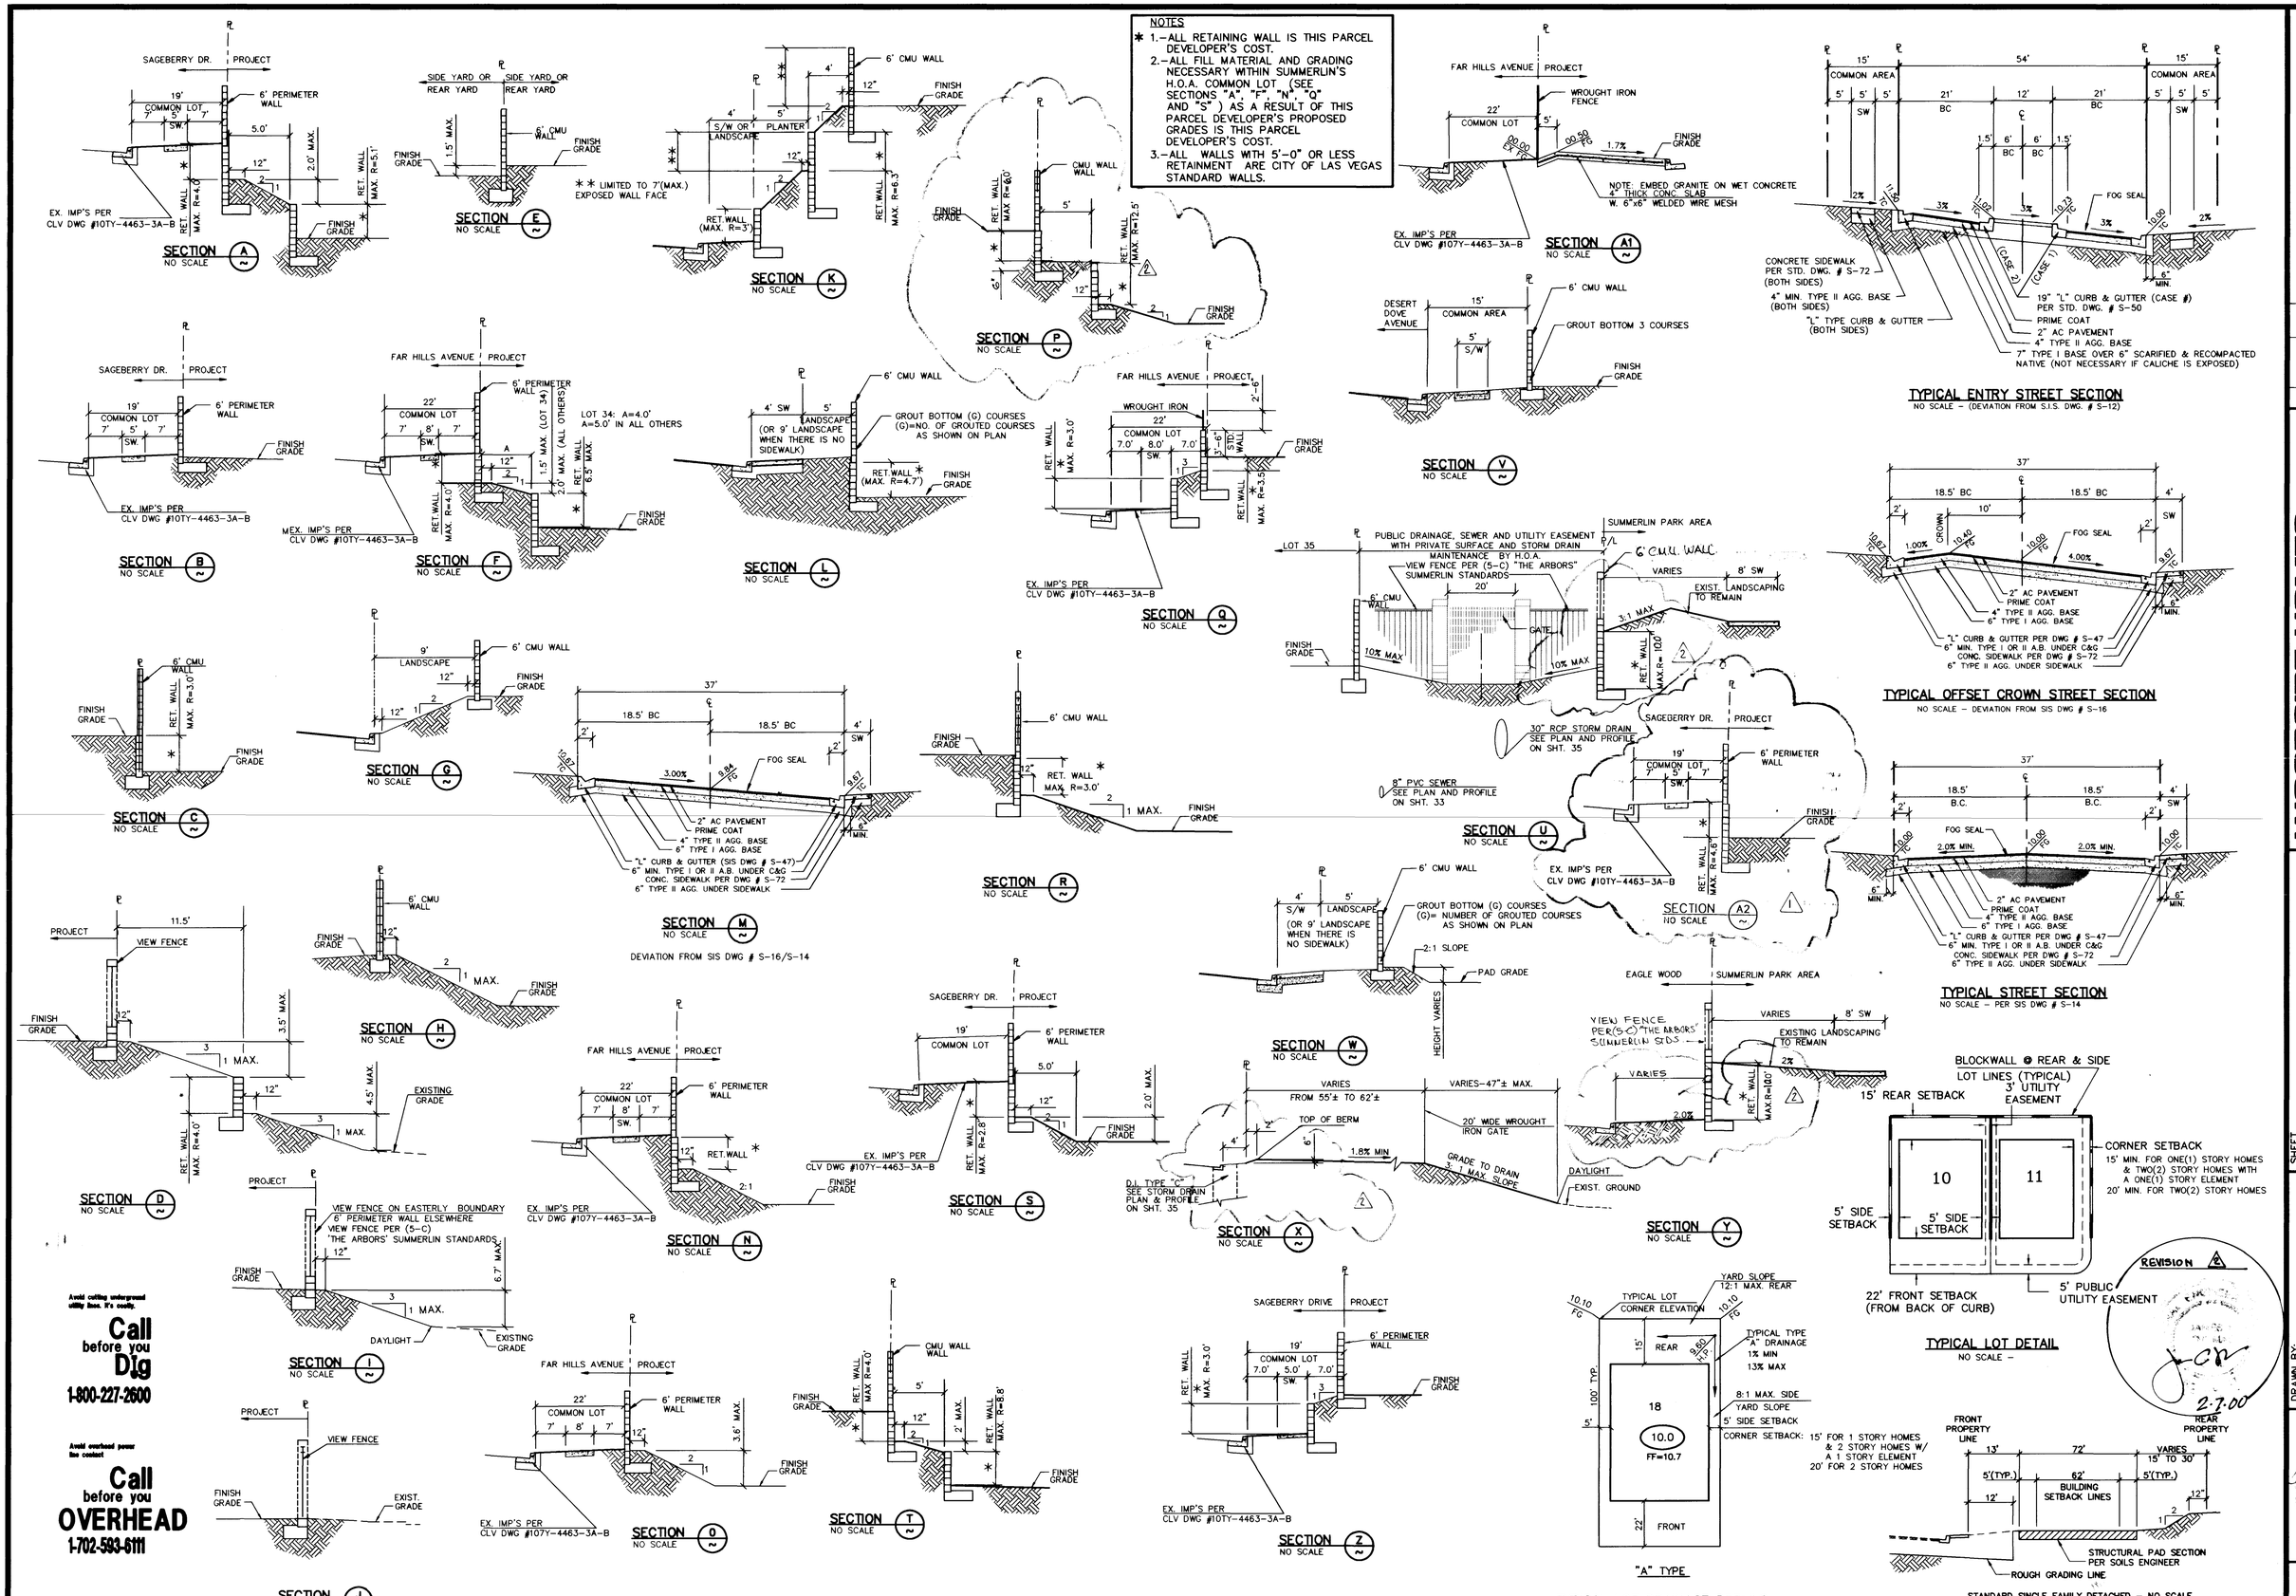

REV	DATE	BY	REVISION
2	2-2-2001	HLA	REVISED SECTIONS 'P', 'U', 'X' AND 'Y' AS SHOWN
1	8/14/98	H.A.	ADDED SECTION A2

WOODSIDE HOMES
3855 S. JONES # 102
LAS VEGAS, NV 89103
(702) 889-7800

vtn nevada
2727 SOUTH RAINBOW BOULEVARD LAS VEGAS, NEVADA 89102-5148
PH. (702) 873-7550 FAX (702) 362-2597
CONSULTING: ENGINEERS ● PLANNERS ● LAND SURVEYORS

SHEET: **GRADING DETAILS**

TITLE: **QUAIL RIDGE**

DRAWN BY: MT/MLA	DECEMBER 1997	
DESIGNED BY: HLA/MT	DECEMBER 1997	
CHECKED BY: DLE	DECEMBER 1997	SCALE: AS SHOWN HORIZ. AS SHOWN VERT.
PROJECT NO:		

SEAL: REGISTERED PROFESSIONAL ENGINEER STATE OF NEVADA — BARRY L. THOMPSON — CIVIL — No. 12527 — 7/10/98

SHEET **G5** 13 OF 35 SHEETS

DRAWING NO. 1074-4552

H:\CAD\LANDEV\52800DETAILS(BR-A)

20762