



MONUMENTATION TIE MAP OF
QUAIL RUN @ ELKHORN SPRINGS - UNIT 2

A COMMON INTEREST COMMUNITY
BEING ALL OF QUAIL RUN @ ELKHORN SPRINGS UNIT-2 AS SHOWN IN BOOK 100 OF PLATS, PAGE 37 OFFICIAL RECORDS OF
CLARK COUNTY, NEVADA, AND LYING IN A PORTION OF THE NORTH HALF IN 1/2 OF THE NORTHEAST QUARTER (NE 1/4)
OF SECTION 16, TOWNSHIP 19 SOUTH, RANGE 60 EAST, M.D.M.
CITY OF LAS VEGAS, CLARK COUNTY, NEVADA.
FM-23-00

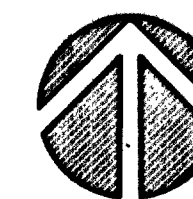


GRAPHIC SCALE

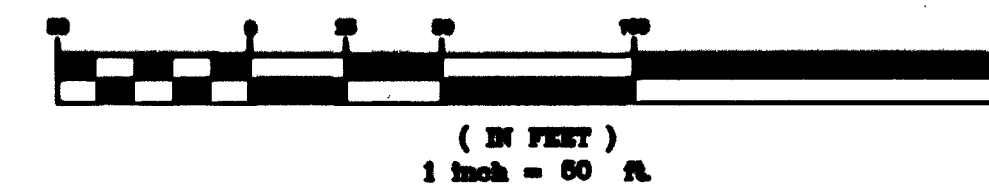

SURVEYOR'S CERTIFICATE

I, CAESAR CANO, A PROFESSIONAL LAND SURVEYOR LICENSED
IN THE STATE OF NEVADA, DO HEREBY CERTIFY THAT THE
MONUMENTS HAVE BEEN SET AND THE TIES ESTABLISHED
AS SHOWN HEREON.

CAESAR CANO
PROFESSIONAL SURVEYOR
NEVADA LICENSE NO. 11175

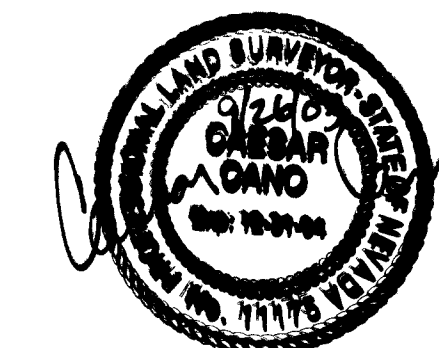

LEGEND


- SET 5/8" REBAR AND ALUM.
CAP, MARKED "PLS 11175"
- SET ALUM. CAP REFERENCE
MONUMENT IN CURB MARKED
"PLS 11175"
- ① BLOCK NUMBER, TYPICAL
- 5 LOT NUMBER, TYPICAL
- ▲ SET 5/8" REBAR AND ALUMINUM
CAP, MARKED "PLS 11175"
- P PRIVATE DRIVE
- - - TIE LINES
- LOT LINE, TYPICAL
- STREET CENTERLINE, TYPICAL
- SUBDIVISION BOUNDARY LINE

BASIS OF BEARINGS

NORTH 84°50'14" WEST, BEING THE BEARING OF THE NORTH LINE OF THE NORTHWEST QUARTER
OF THE NORTHWEST QUARTER (NW 1/4) OF SECTION 16, TOWNSHIP 19 SOUTH, RANGE 60 EAST,
M.D.M., CLARK COUNTY, NEVADA, AS SHOWN IN FILE 93 OF SURVEYS, PAGE 13, OFFICIAL RECORDS
OF CLARK COUNTY, NEVADA.

NOTE

BEARINGS AND DISTANCES ARE THE SAME AS THEY APPEAR ON
THE FINAL MAP OF QUAIL RUN @ ELKHORN SPRINGS - UNIT 2,
FM-23-00

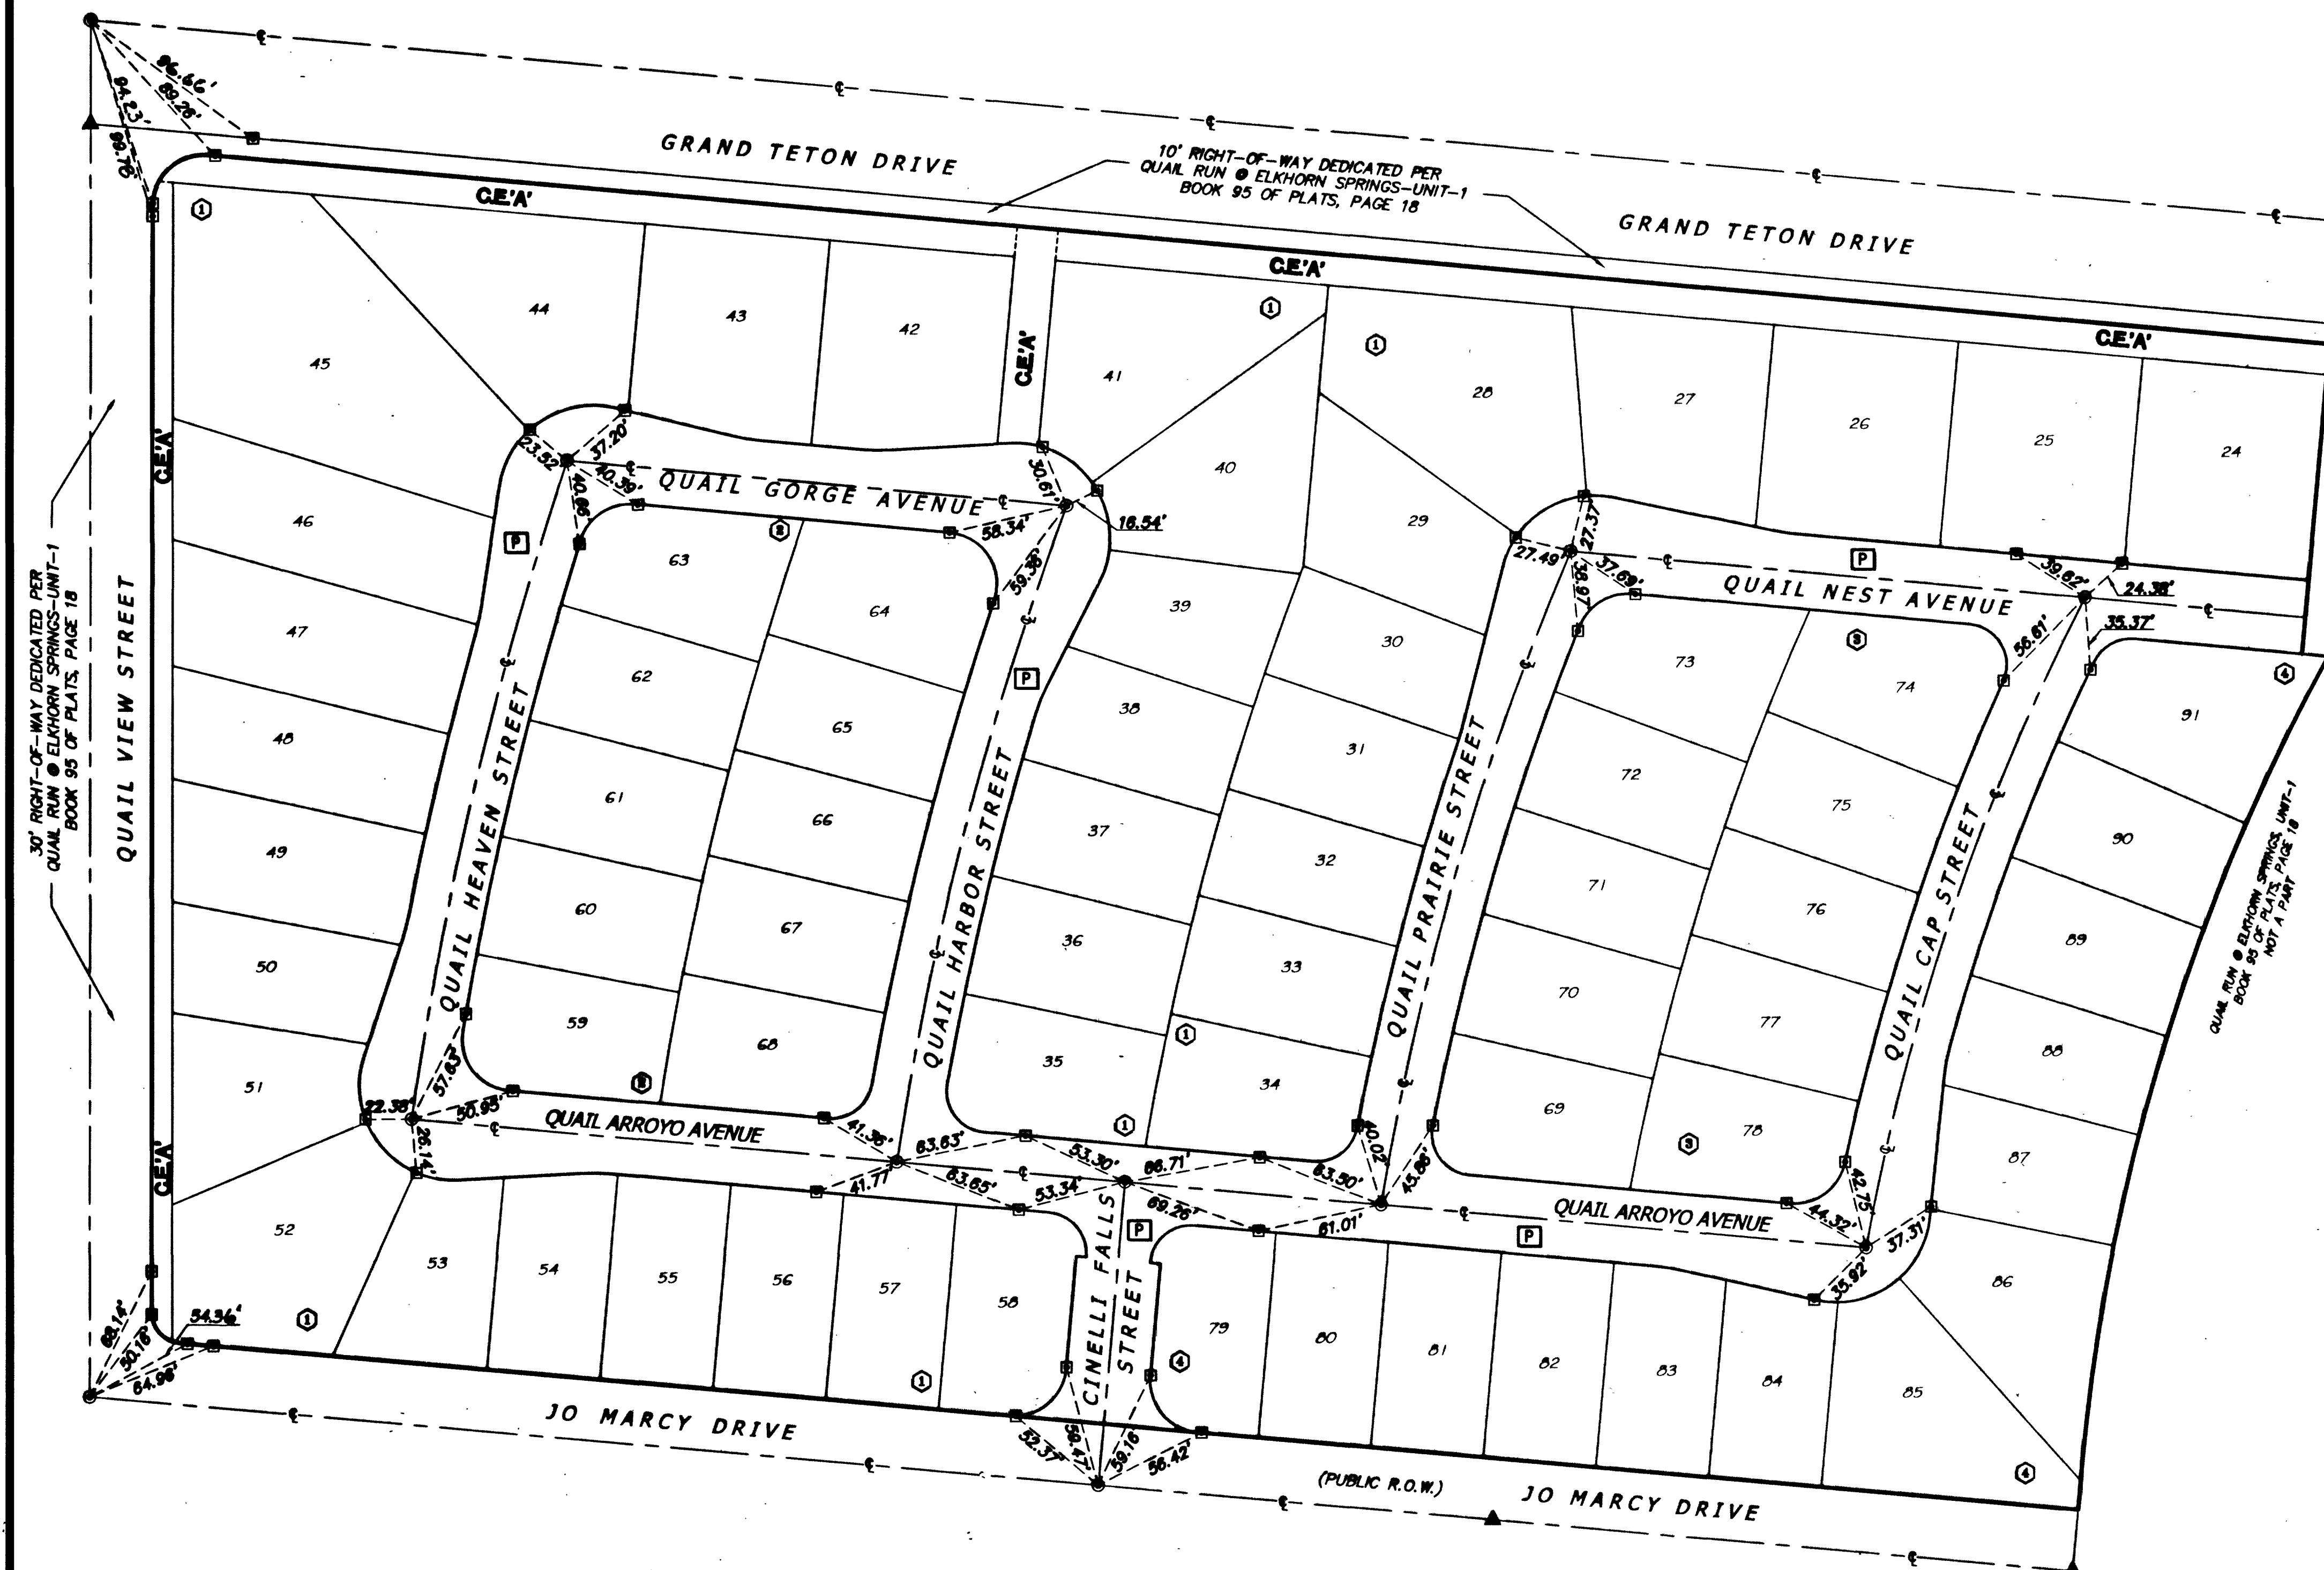

DESIGNED BY T. CEBROS	DRAWN BY T. CEBROS	CHECKED BY C. CANO	PROJECT DATE 3/2003
QUAIL RUN @ ELKHORN SPRINGS - UNIT TWO NEVADA			
MONUMENT TIE MAP BOOK 100 OF PLATS, PAGE 37 FM-23-00			
6280 S. Valley View Blvd Suite 200 Las Vegas, NV 89118 Tel: (702) 368-3008 Fax: (702) 368-0047			
CVL CONSULTANTS, INC. ENGINEERING, PLANNING AND SURVEYING			
SHEET 1 OF 1			
AGENCY DWG. NO. 058-4688-2			