



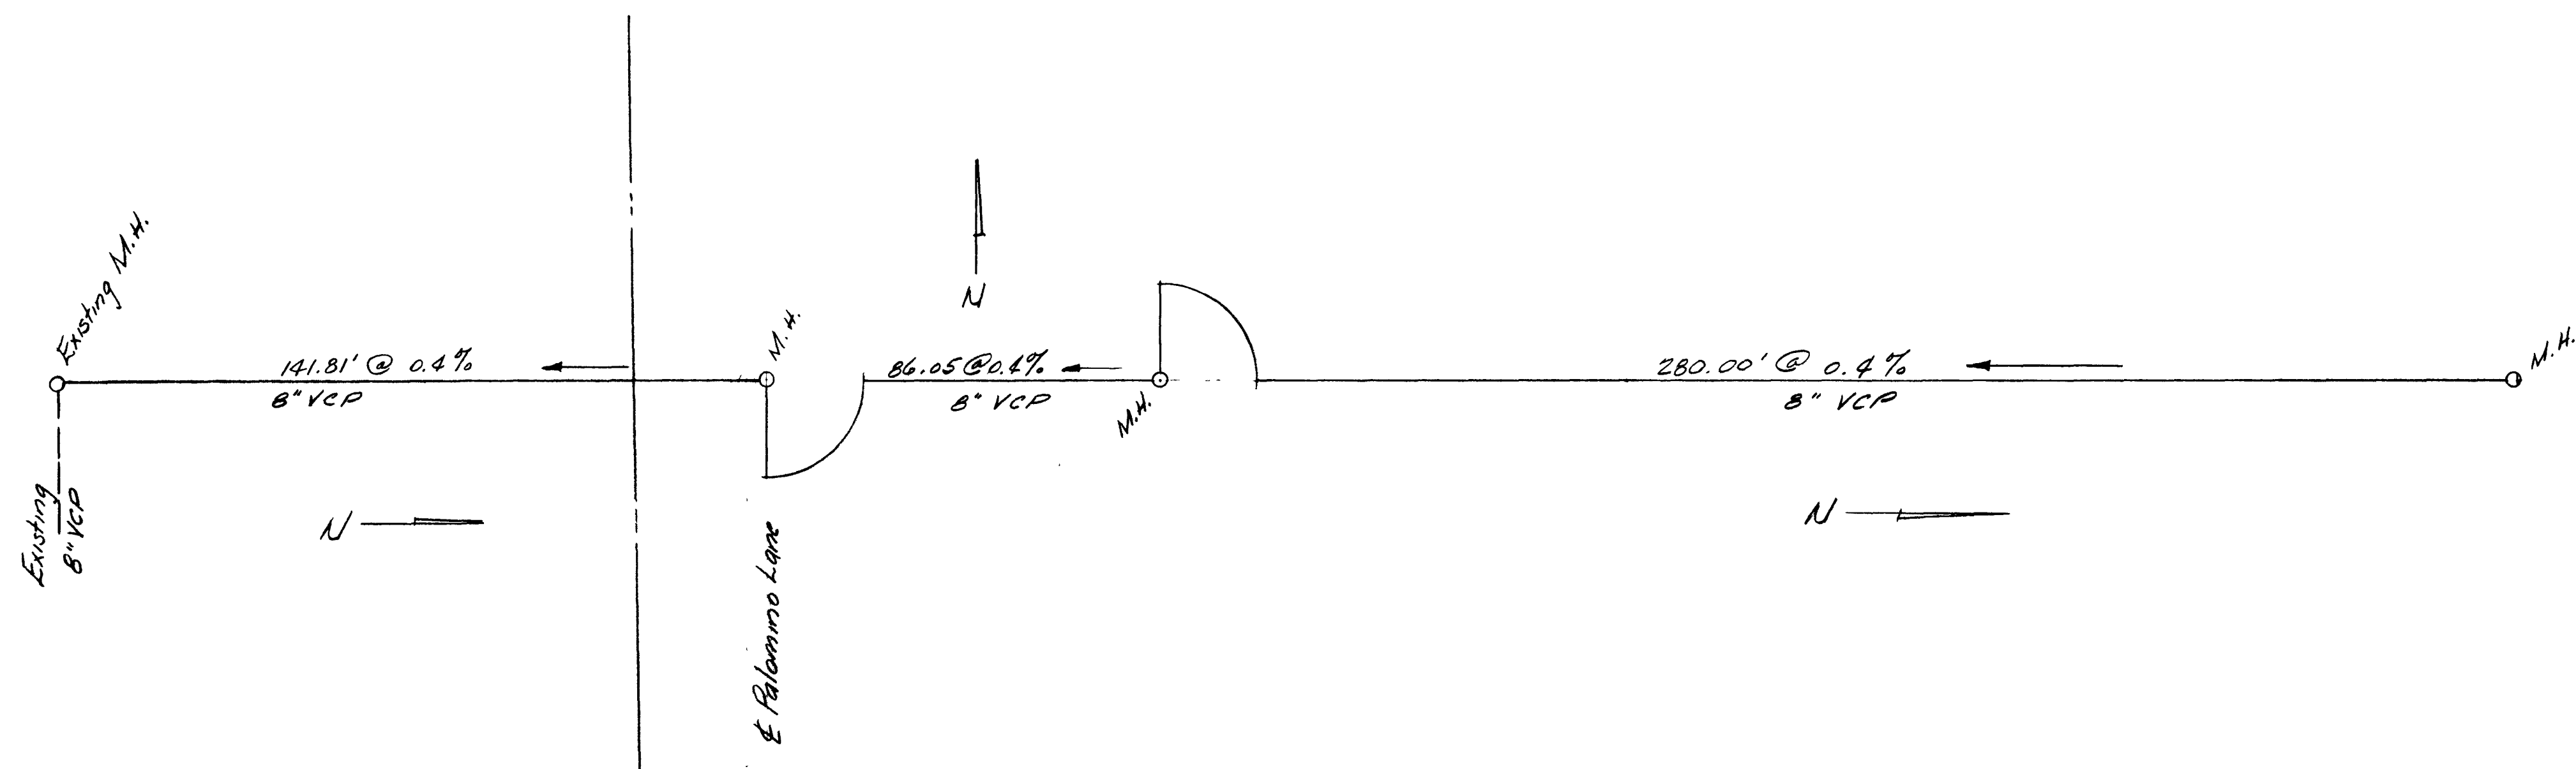

Approved: R. Crawford
 Const. Will not start until Dedication
 of Alleys has been made.

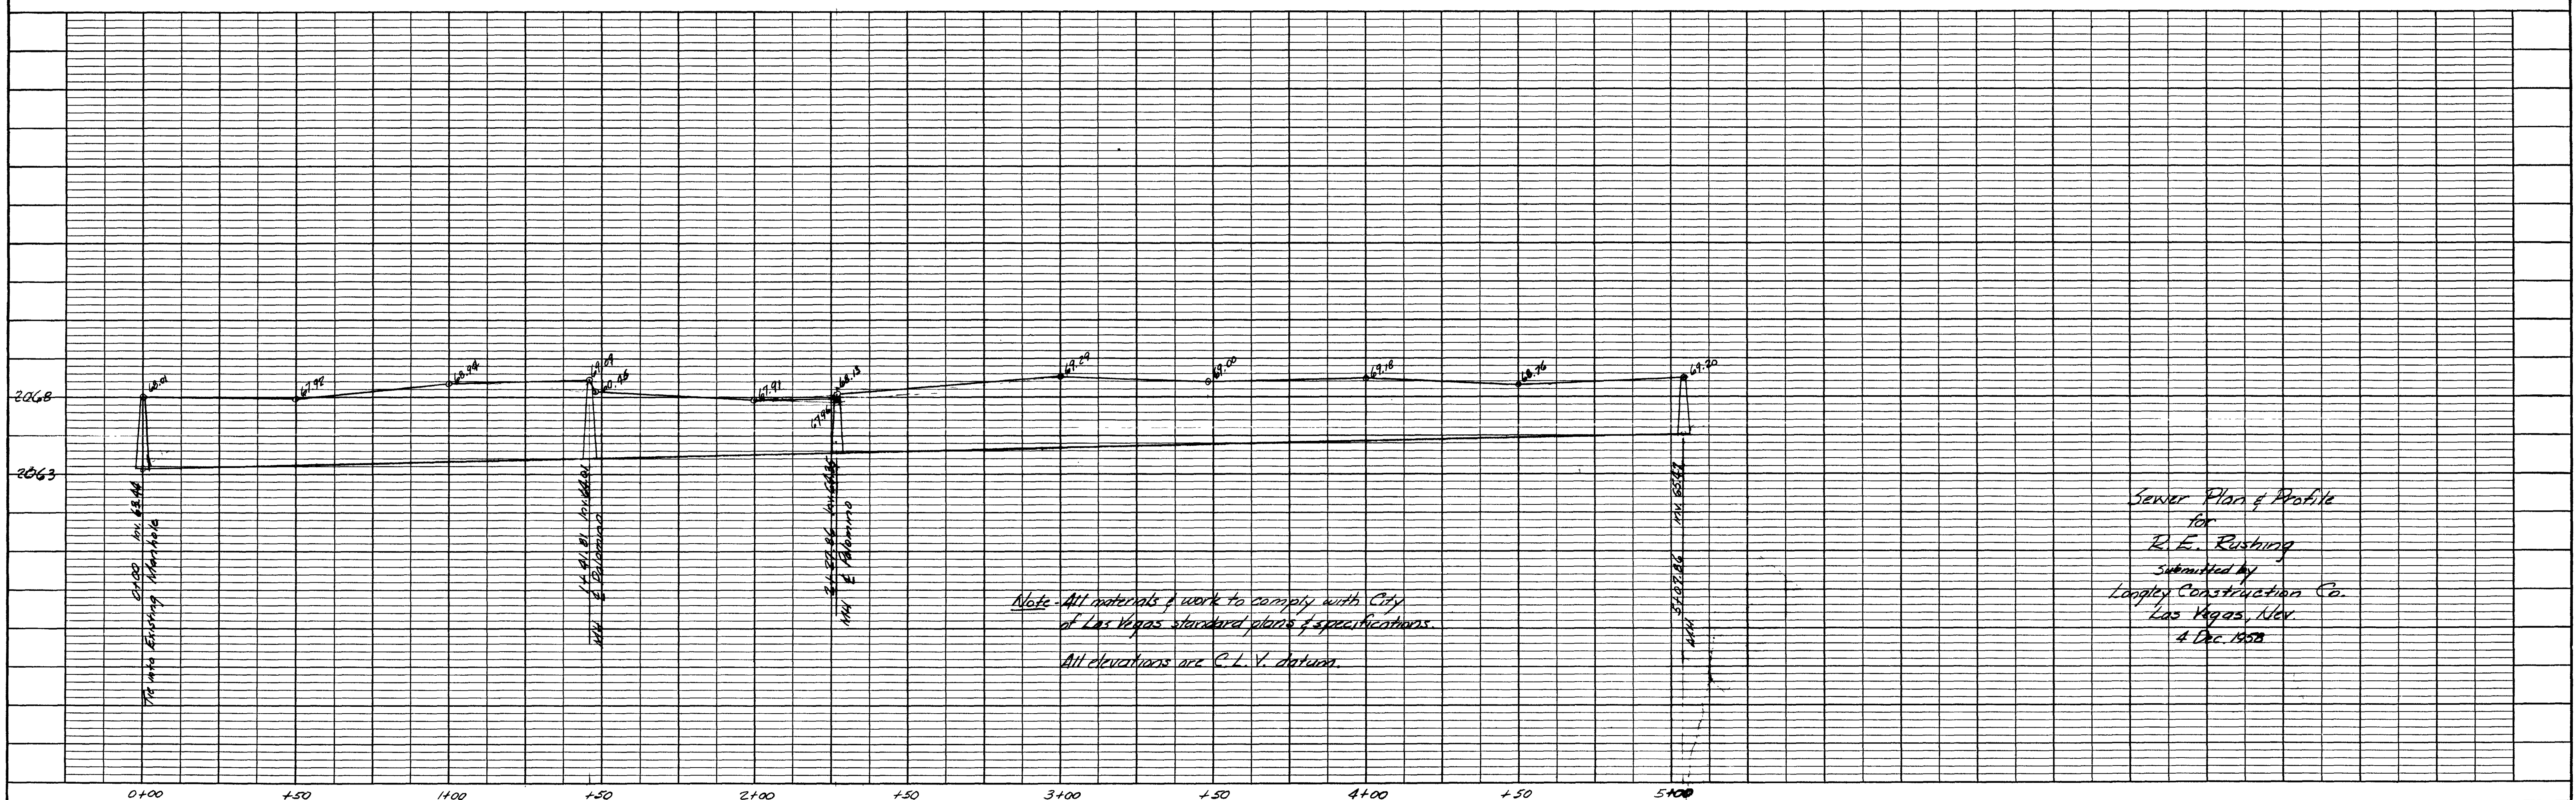

Note: All materials & work to comply with City
 of Las Vegas standard plans & specifications.
 All elevations are C.L.V. datum.

Sewer Plan & Profile
 for
 R. E. Rushing
 submitted by
 Longley Construction Co.
 Las Vegas, Nev.
 4 Dec. 1958

NO.	DATE	BY	CHK'D


307-V238

14-1-49

