


PANEL L1		120/208 VOLT 3 PHASE 4 WIRE		225 AMPERE MAIN L.O.		225 AMPERE BUS	
LOCATION ELECTRICAL RM.		LOAD DESCRIPTION		TYPE CNT		MOUNTING SURFACE	
LINE A	LINE B	LINE C	LINE D	LINE E	LINE F	LINE G	LINE H
1	720		MULTI-PURP. RM	N	4	20	1
3	900		MULTI-PURP. OFFICE	N	5	20	1
5	900		CLASS RM.	N	5	20	1
7	720		OFFICE & STORAGE	N	4	20	1
9	540		KITCHEN	N	3	20	1
11	1080		LIBRARY - I.G.	N	6	20	1
13	900		LOBBY	N	5	20	1
15	720		I.G. RECEIPT	N	4	20	1
17	720		I.G. RECEIPT	N	4	20	1
19	720		OFFICE	N	4	20	1
21	900		CORR. & STORAGE	N	5	20	1
23	1080		REC. & MECH. STOR.	N	6	20	1
25	540		OFFICE	N	3	20	1
27	720		TOILETS & OFFICE	N	4	20	1
29	720		CONFERENCE	N	4	20	1
31	540		OFFICE	N	3	20	1
33	1080		ROOF & HOUSEKPNG	N	7	20	1
35	700		EF-1	N	1	20	1
37	800		EW	N	1	20	1
39	800		TIB	N	1	20	1
41	600		FIRE ALARM CNTRL. PNL	N	1	20	1
4740		5660	5800	DEMAND CODES: C: LONG CONTINUOUS LOAD		N: NON-CONTINUOUS RECEPTACLE	
CONNECTED VA:		A: 12695	B: 12830	C: 12279		TOTAL: 37804 VA	
CONNECTED VA W/ LCL:		A: 13719	B: 13783	C: 13144		TOTAL W/ LCL: 40645 VA	
(NON CONTINUOUS REC. LOADS: 13500.0 VA)		(CONTINUOUS LOADS: 11364.0 VA)		TOTAL AMPS: 112.8 A		HIGH PHASE AMPS W/LCL 114.9 A	

PANEL L2		120/208 VOLT 3 PHASE 4 WIRE		225 AMPERE MAIN L.O.		225 AMPERE BUS	
LOCATION ELECTRICAL RM.		LOAD DESCRIPTION		TYPE CNT		MOUNTING SURFACE	
LINE A	LINE B	LINE C	LINE D	LINE E	LINE F	LINE G	LINE H
1	420		VEST. & FRONT ENT.	C	12	20	1
3	375		MONUMENT SIGN	C	5	20	1
5	375		MONUMENT SIGN	C	5	20	1
7	3950		RANGE & OVEN	N	1	50	2
9	3950		WH-2	N	1	20	1
11	360		KITCHEN	N	2	20	1
13	300		HOOD	N	1	20	1
15			SPARE	N	20	1	1
17			SPARE	N	20	1	1
19			SPARE	N	20	1	1
21			SPARE	N	20	1	1
23			SPARE	N	20	1	1
25			SPACE	N	20	1	1
27			SPACE	N	20	1	1
29			SPACE	N	20	1	1
31			SPACE	N	20	1	1
33			SPACE	N	20	1	1
35			SPACE	N	20	1	1
37			SPACE	N	20	1	1
39			SPACE	N	20	1	1
41			SPACE	N	20	1	1
4730		4625	3375	DEMAND CODES: C: LONG CONTINUOUS LOAD		N: NON-CONTINUOUS RECEPTACLE	
CONNECTED VA:		A: 6180	B: 5715	C: 4920		TOTAL: 16815 VA	
CONNECTED VA W/ LCL:		A: 6513	B: 6036	C: 5355		TOTAL W/ LCL: 17904 VA	
(NON CONTINUOUS REC. LOADS: 0.0 VA)		(CONTINUOUS LOADS: 4355.0 VA)		TOTAL AMPS: 49.7 A		HIGH PHASE AMPS W/LCL 54.3 A	

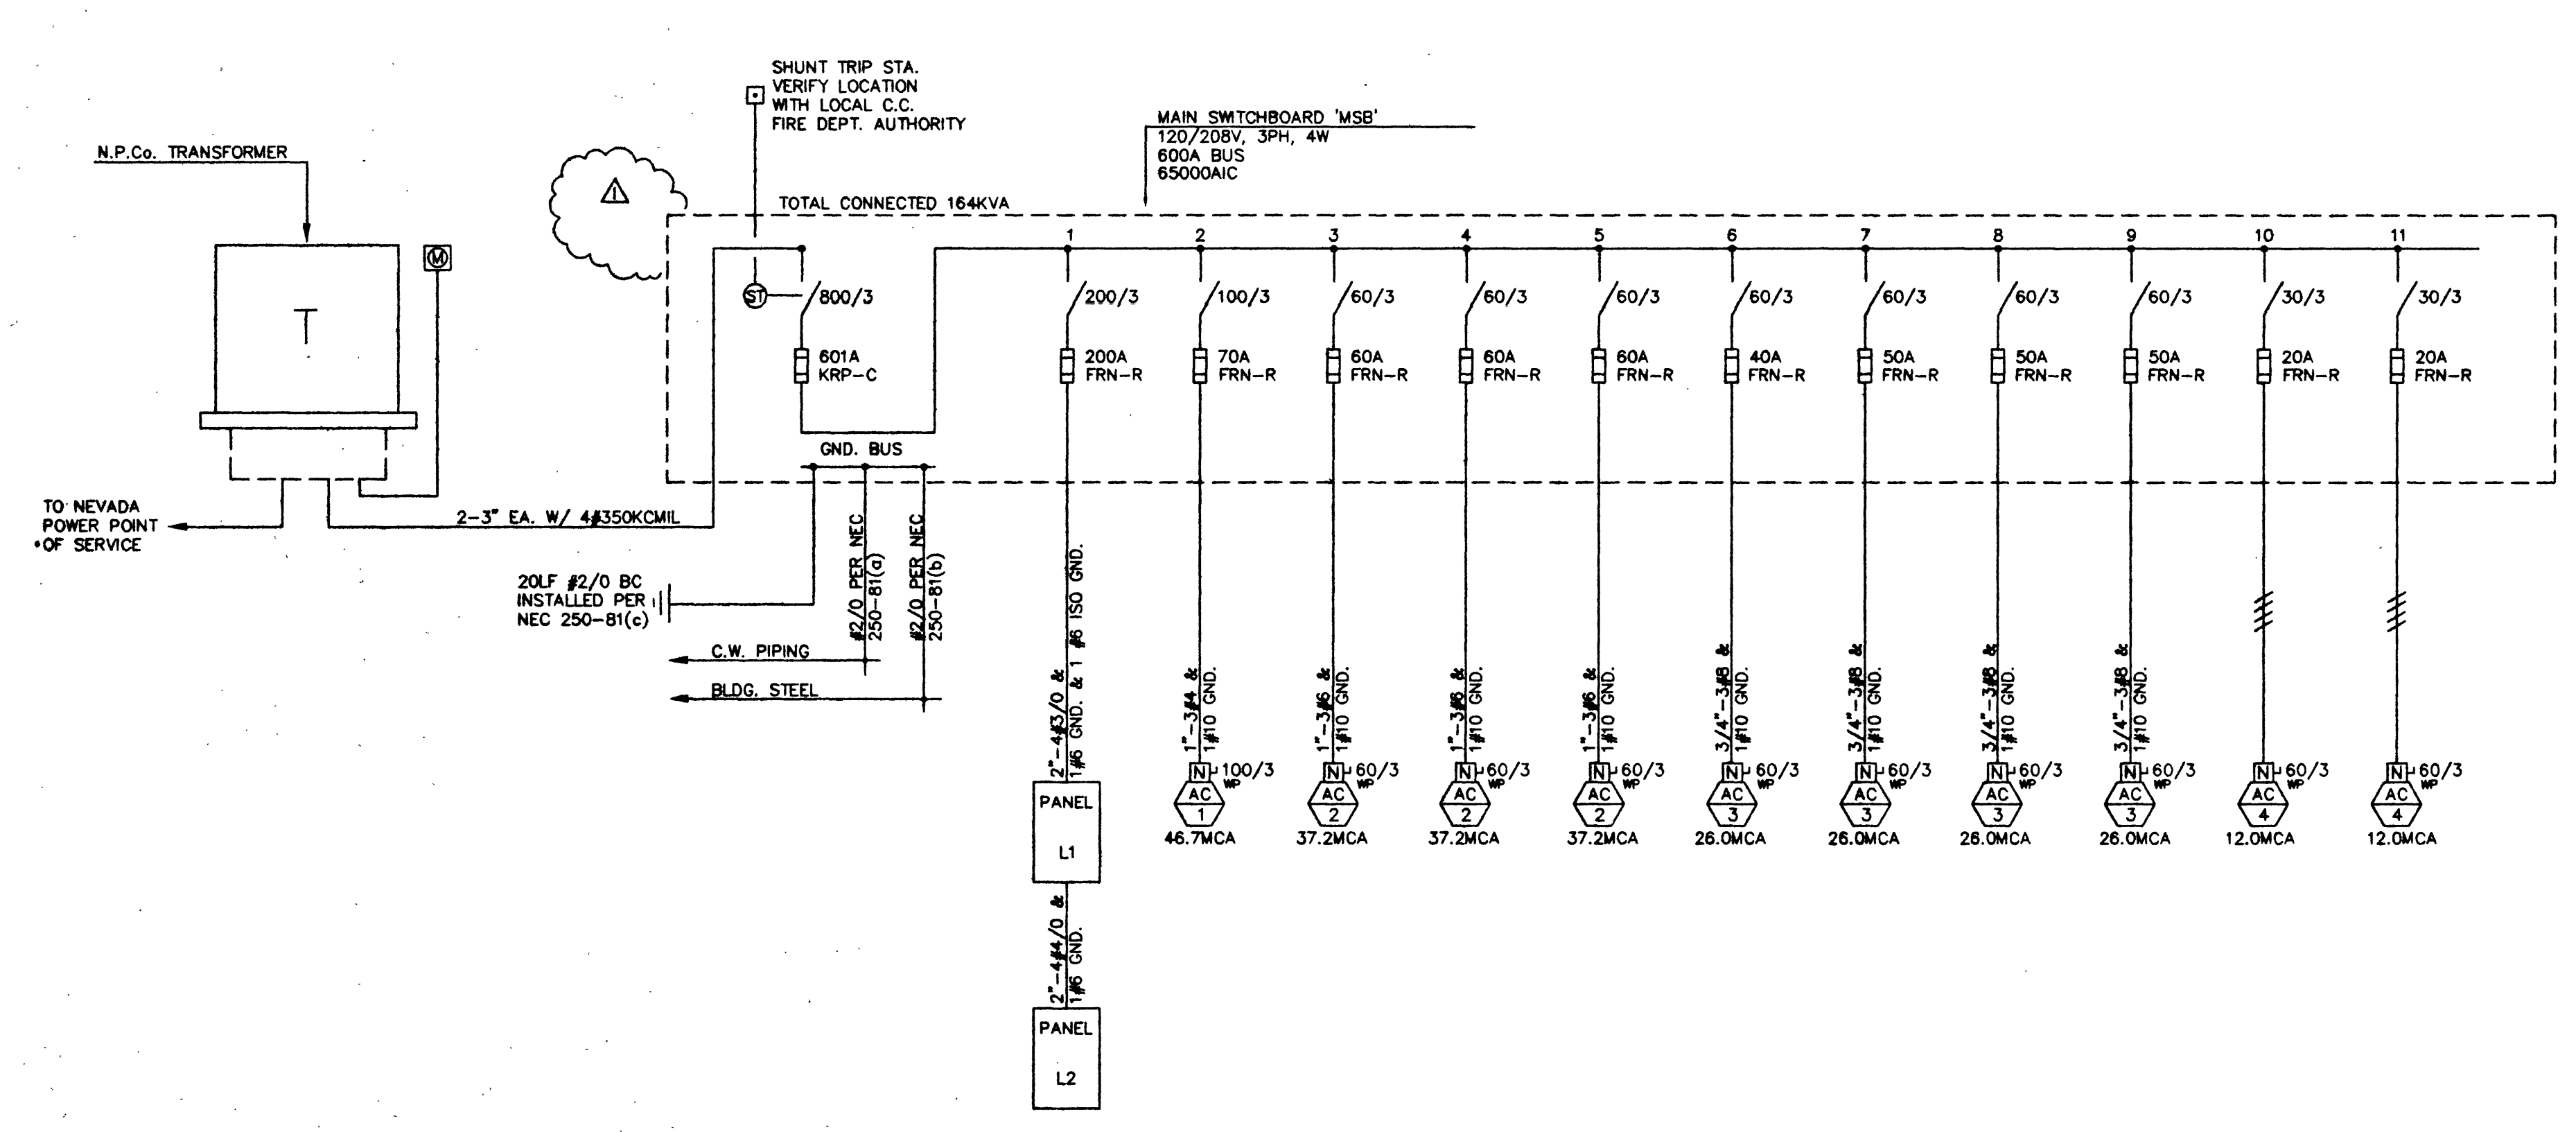

REVISIONS			
REV	DESCRIPTION	DATE	BY
1	ADDENDUM #1	2/22/95	

DOMINGO CAMBEIRO CORPORATION 1994

Morris Engineering, Inc.
3111 South Valley View Blvd.
Suite 0-101
Las Vegas, Nevada 89102
(702) 873-9440
FAX (702) 873-9497

DO NOT SCALE DRAWINGS

All designs, arrangements and plans indicated or presented by this drawing, or instruments of service, are owned by and the property of DOMINGO CAMBEIRO CORPORATION. The plans and/or specifications shall be restricted to the original site for which they were prepared and publication thereof is expressly limited to such use. Reproduction, publication or re-use by any method in whole or in part, is prohibited. None of such designs, arrangements or plans shall be used by or disclosed to any person, firm, agency, or corporation without the written permission of DOMINGO CAMBEIRO CORPORATION. Visual contact with these plans and specifications shall constitute prima facie evidence of acceptance of these restrictions.

SEAL	DRAWN BY: KAS	CHECKED BY: RHR	ISSUED DATE: 01-25-95
------	---------------	-----------------	-----------------------

ELECT. SITE PLAN, SINGLE LINE DIA. AND SCHEDULES

Rafael Rivera
COMMUNITY CENTER
LAS VEGAS, NEVADA

Domingo Cambeiro Corporation
ARCHITECTURE • ENGINEERING • PLANNING • INTERIORS
LAS VEGAS, NEVADA 89121-3805
(702) 732-0084
3555 PECOS-MGLEOD IC.

SHEET NO. **E6101**
R-1
650.40B 37.4+37
JOB NO. 942335
FILE NO. 9235E01.DWG
94202

35255