
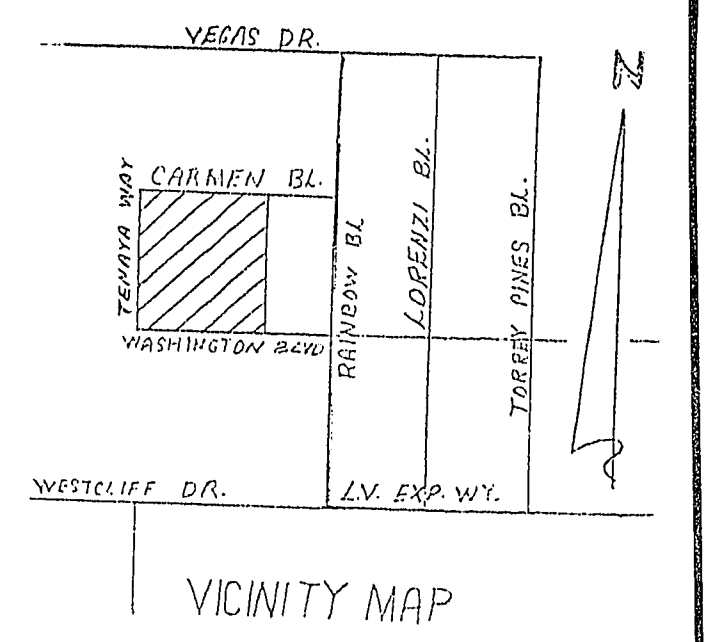


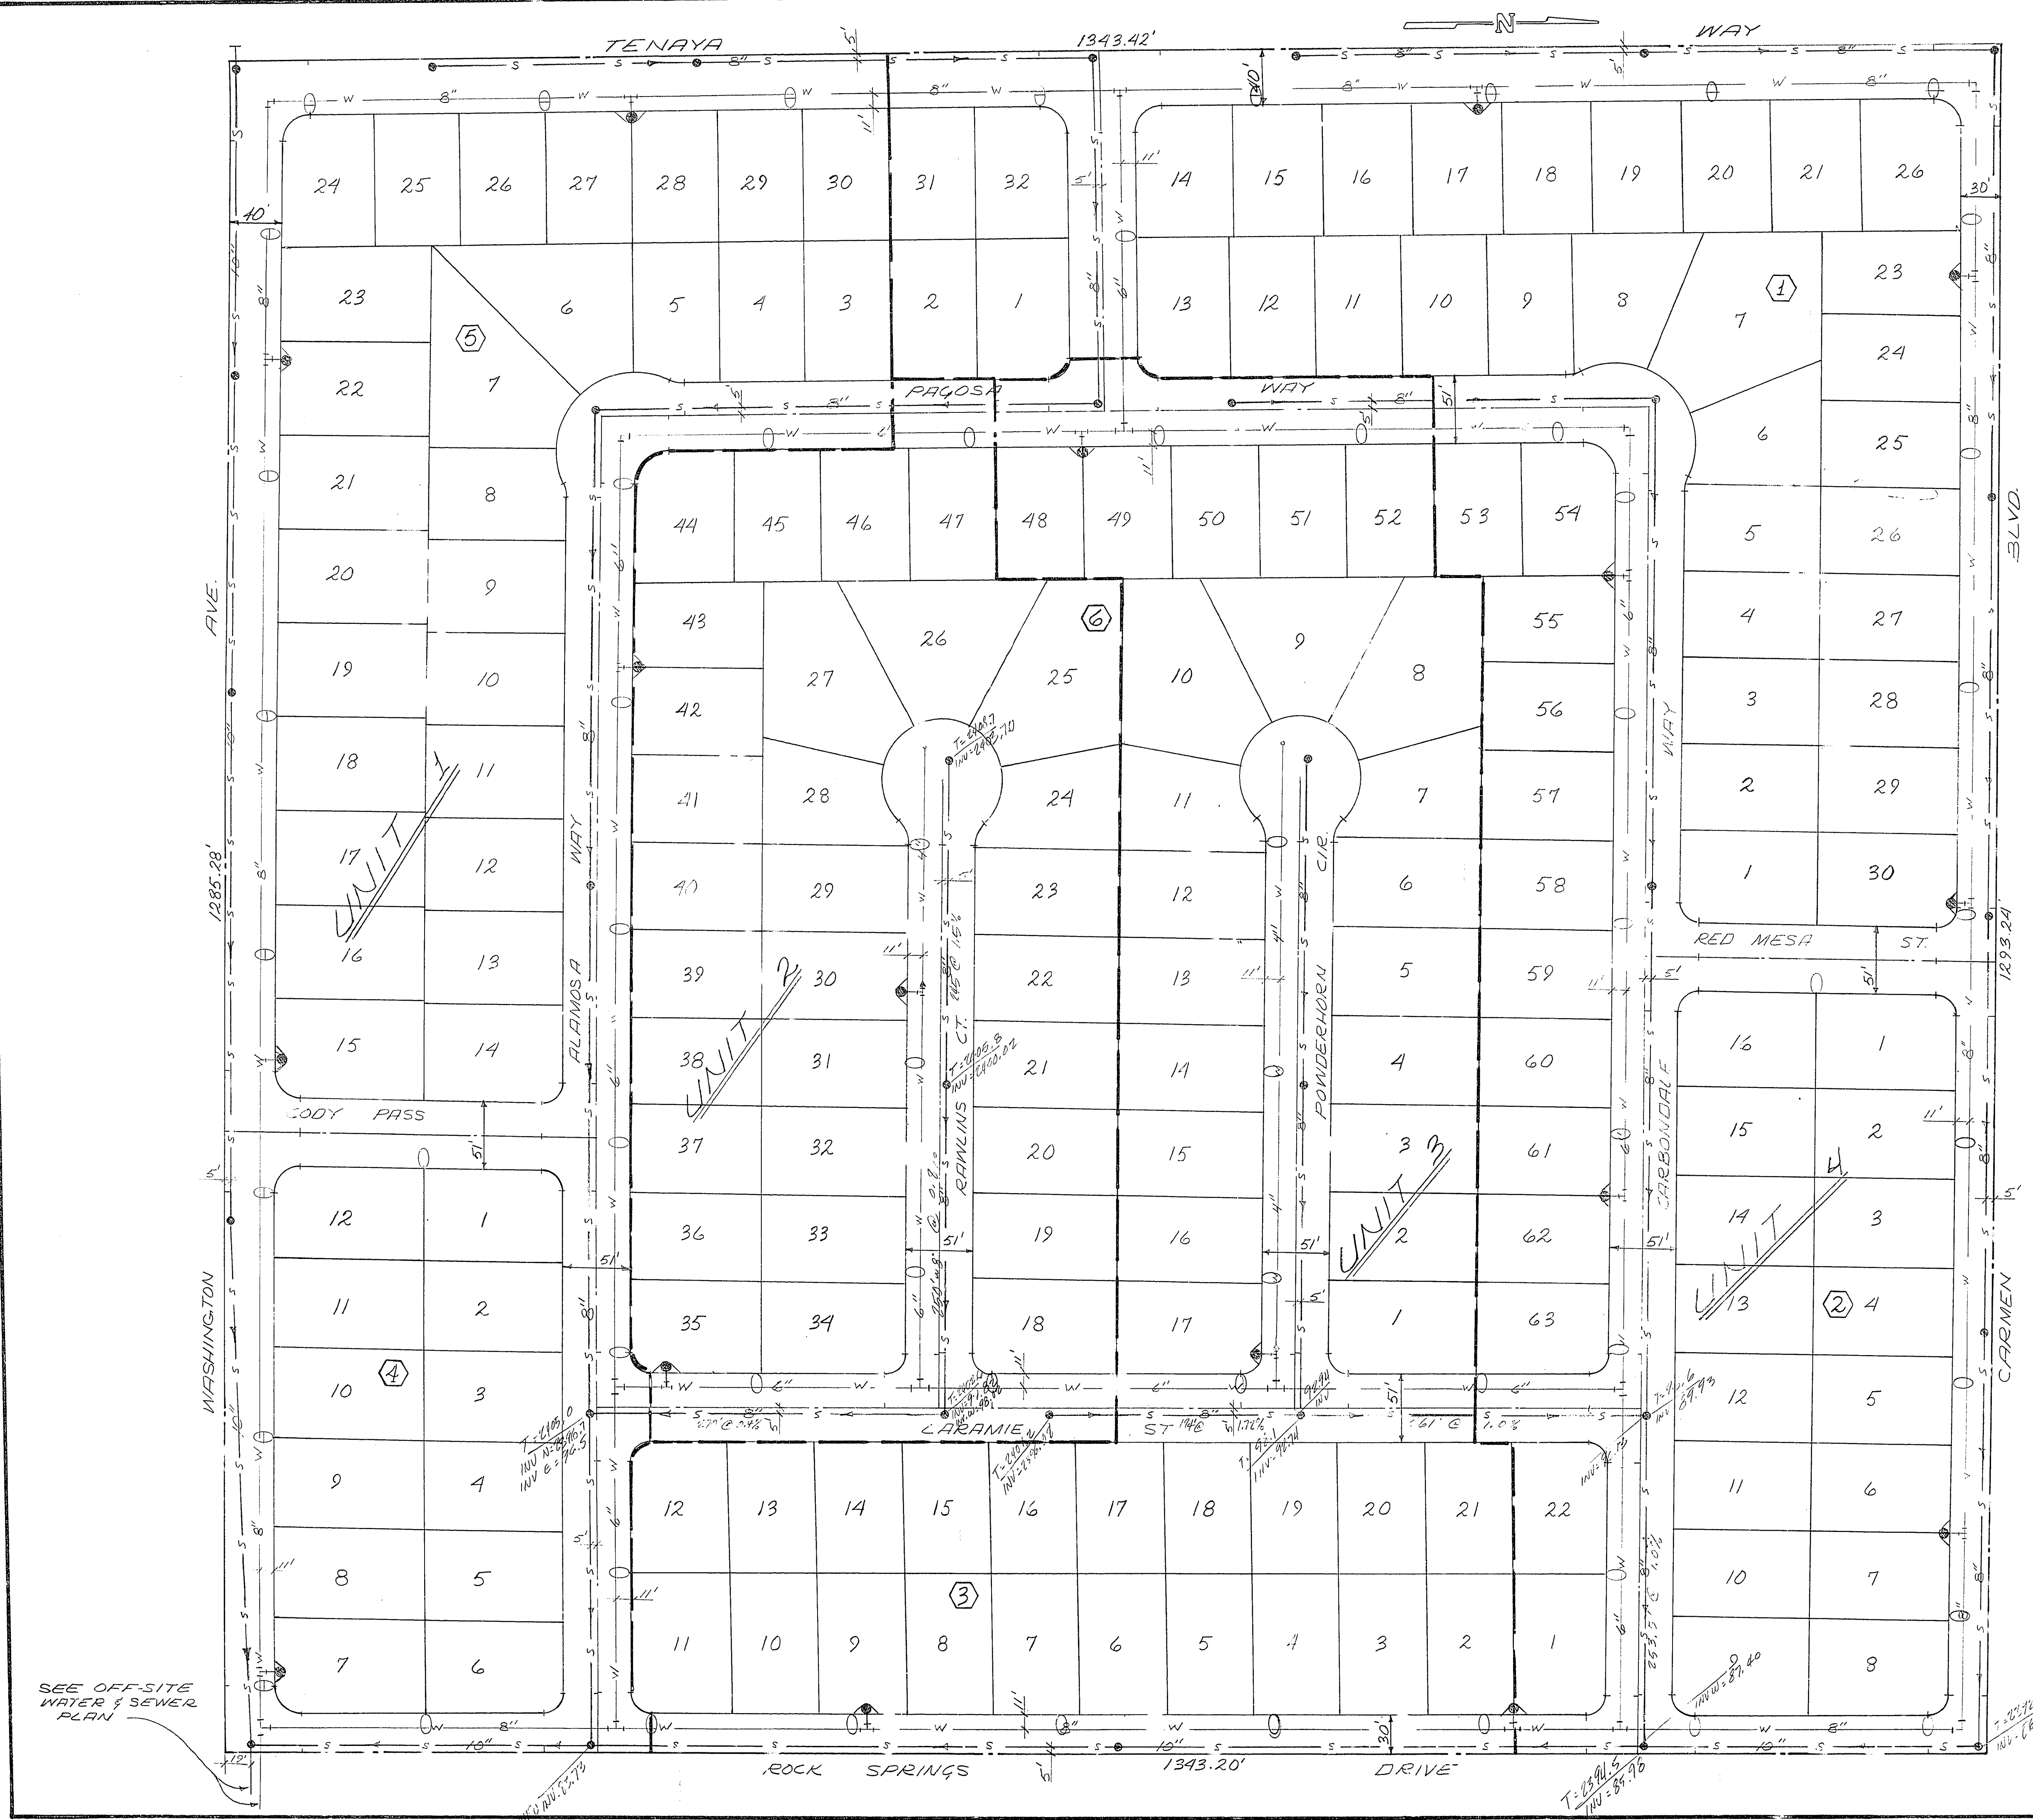

- LEGEND**
- 2 LOT NUMBER
 - (2) BLOCK NUMBER
 - ⊙ FIRE HYDRANT
 - W — WATER MAIN
 - S — SEWER MAIN
 - STREET LIGHT

James L. Hagg
JAMES L. HAGG ENGINEERING PC DATE
REV. CERT. 01/35/12

vtm CONSULTING ENGINEERS • PLANNERS 2401 PARKVIEW ROAD LAS VEGAS, NEVADA 89166 702.733.1027				
RAINBOW WEST UNIT #2 MASTER UTILITIES PLAN				
SCALE: 1"=60'	WO. NO. 2479	DATE 1/31/12	SHEET	OF
HORIZ:	DES.	REV.	11	11
VERT:	CHK.	REV.		

SEE OFF-SITE
WATER & SEWER
PLAN