


MONUMENT TIE MAP


RAMPART BLVD - LAKE MEAD BLVD. TO ALTA DRIVE
LYING WITHIN SECTIONS 20, 29, 31 AND 32, TOWNSHIP 20 SOUTH, RANGE 60
EAST, M.D.M., CITY OF LAS VEGAS, CLARK COUNTY, NEVADA.

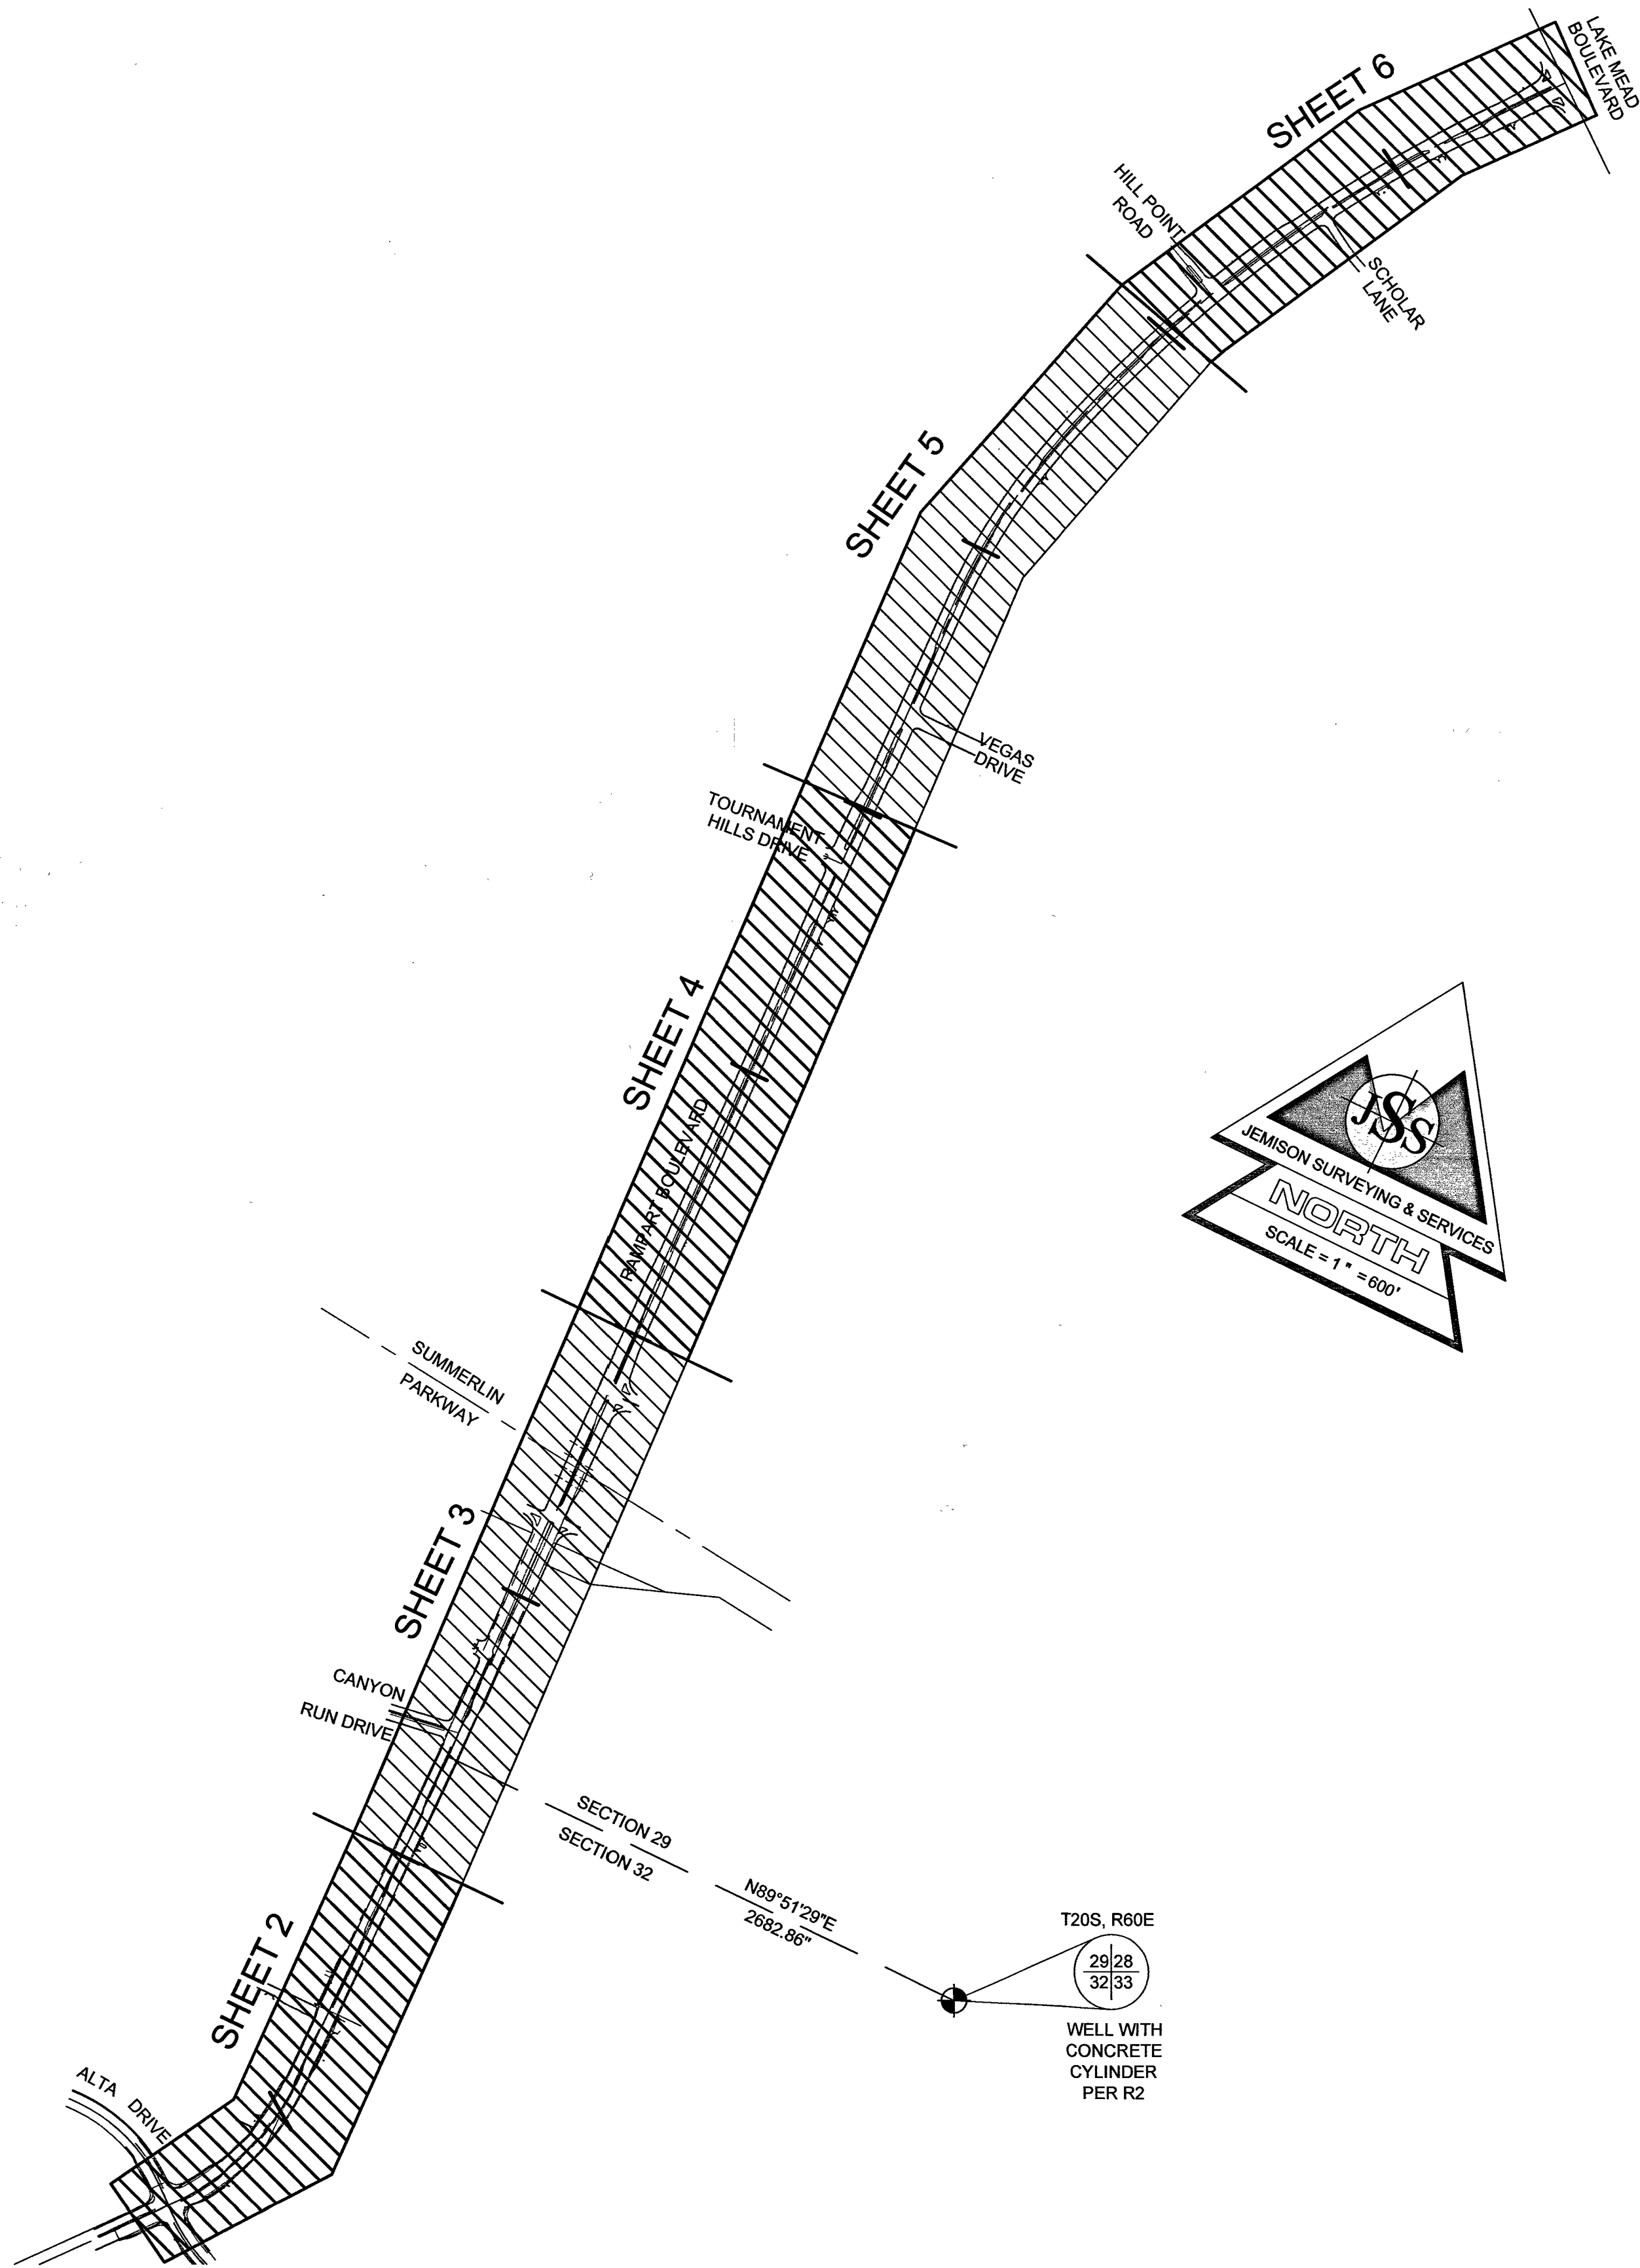

SURVEYOR'S CERTIFICATE

- I, RAYMOND JEMISON, A PROFESSIONAL LAND SURVEYOR REGISTERED IN THE STATE OF NEVADA, CERTIFY THAT:
- THIS PLAT REPRESENTS THE RESULTS OF A SURVEY CONDUCTED UNDER MY SUPERVISION AT THE INSTANCE OF: TAB CONTRACTORS
 - THE LANDS SURVEYED LIE WITHIN SECTIONS 20, 29, 31 & 32, OF TOWNSHIP 20 SOUTH, RANGE 60 EAST, M.D.M., CLARK COUNTY, NEVADA, AND THE SURVEY WAS COMPLETED ON OCTOBER 22, 2015.
 - THIS PLAT COMPLIES WITH THE APPLICABLE STATE STATUTES AND ANY LOCAL ORDINANCES IN EFFECT ON THE DATE THAT THE SURVEY WAS COMPLETED AND THAT THIS SURVEY DOES NOT CONSTITUTE A SUBDIVISION AS DEFINED BY NEVADA REVISED STATUTES.
 - THE MONUMENTS DEPICTED ON THE PLAT ARE OF THE CHARACTER SHOWN, OCCUPY THE POSITIONS INDICATED, ARE OF SUFFICIENT DURABILITY AND THE TIE DISTANCES ESTABLISHED AS SHOWN HEREON.
 - THIS PLAT AND THE SURVEY ON WHICH IT IS BASED, MEET POSITIONAL CERTAINTY ACCURACY REQUIREMENTS FOR A LOW URBAN LAND BOUNDARY SURVEY AS DEFINED BY N.A.C. 625.740 N.A.C. 625.666.

RAYMOND JEMISON
PROFESSIONAL LAND SURVEYOR
NEVADA REG. NO. 10598

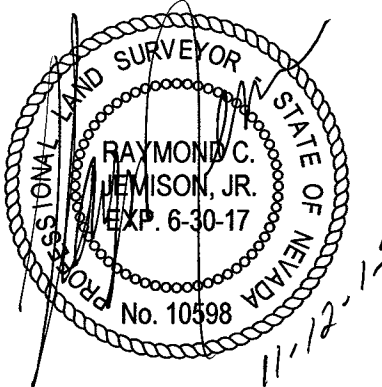

REFERENCE MAPS

- R1 - FILE 191 OF SURVEYS, PAGE 53
R2 - FILE 190 OF SURVEYS, PAGE 80

RECORDER'S NOTE

ANY SUBSEQUENT CHANGES TO THIS MAP SHOULD BE EXAMINED AND MAY BE DETERMINED BY REFERENCE TO THE COUNTY RECORDER'S CUMULATIVE MAP INDEX. NRS 278.5695

LEGEND

- CENTER LINE OF STREET
--- RIGHT-OF-WAY / PROPERTY LINE
(R#) REFERENCE MAP
RM REFERENCE MONUMENT
(ST) STAMPED DISTANCE
(M) MEASURED DISTANCE
△ FOUND REFERENCE MONUMENT
▲ FOUND MONUMENT AS NOTED
○ SET TYPE IV REFERENCE MONUMENT - PLS 10598
● SET TYPE III MONUMENT - PLS 10598
⊕ MONUMENT NOT FOUND - CALCULATED

RECORD OF SURVEY

TIE MAP
RAMPART BOULEVARD
LAKE MEAD BLVD TO ALTA DRIVE


LYING WITHIN SECTIONS 20, 29, 31 AND 32,
TOWNSHIP 20 SOUTH, RANGE 60 EAST, M.D.M.
CITY OF LAS VEGAS, CLARK COUNTY, NEVADA




DATE: 10-28-2015 JOB NUMBER: 253-140801 DRAWN BY: RPS



JEMISON SURVEYING & SERVICES
2690 CRIMSON CANYON DRIVE
LAS VEGAS, NEVADA, 89128
702-360-4838 FAX 702-360-4839

INSTRUMENT NO. _____
OFFICIAL RECORDS
BOOK NO. _____
FILED AT THE REQUEST OF
TAB CONTRACTORS
DATE _____ AT _____
FILE _____ PAGE _____
OF _____
RECORD OF SURVEY
CLARK COUNTY, NEVADA RECORDS
DEBBIE CONWAY
RECORDED
FEE \$ _____ DEPUTY

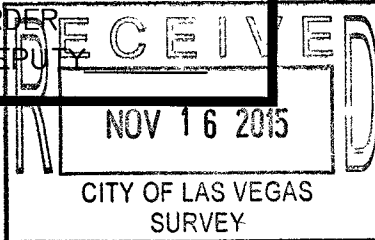

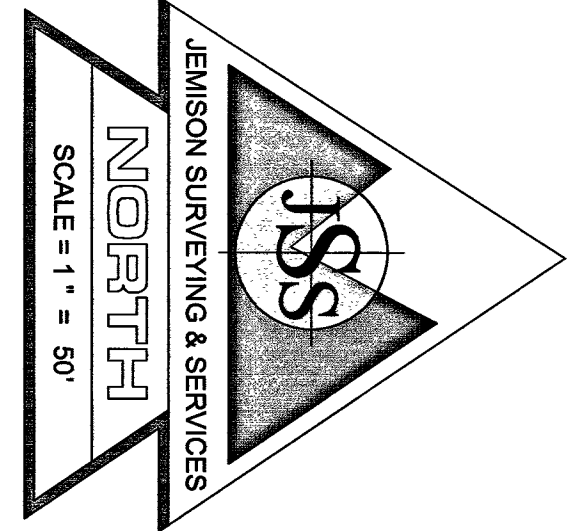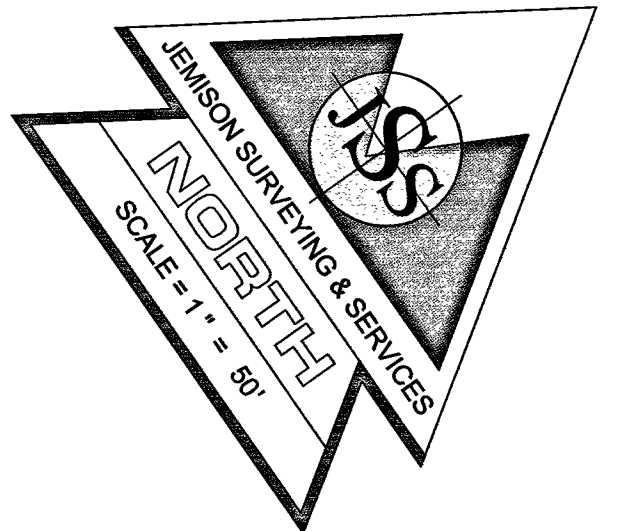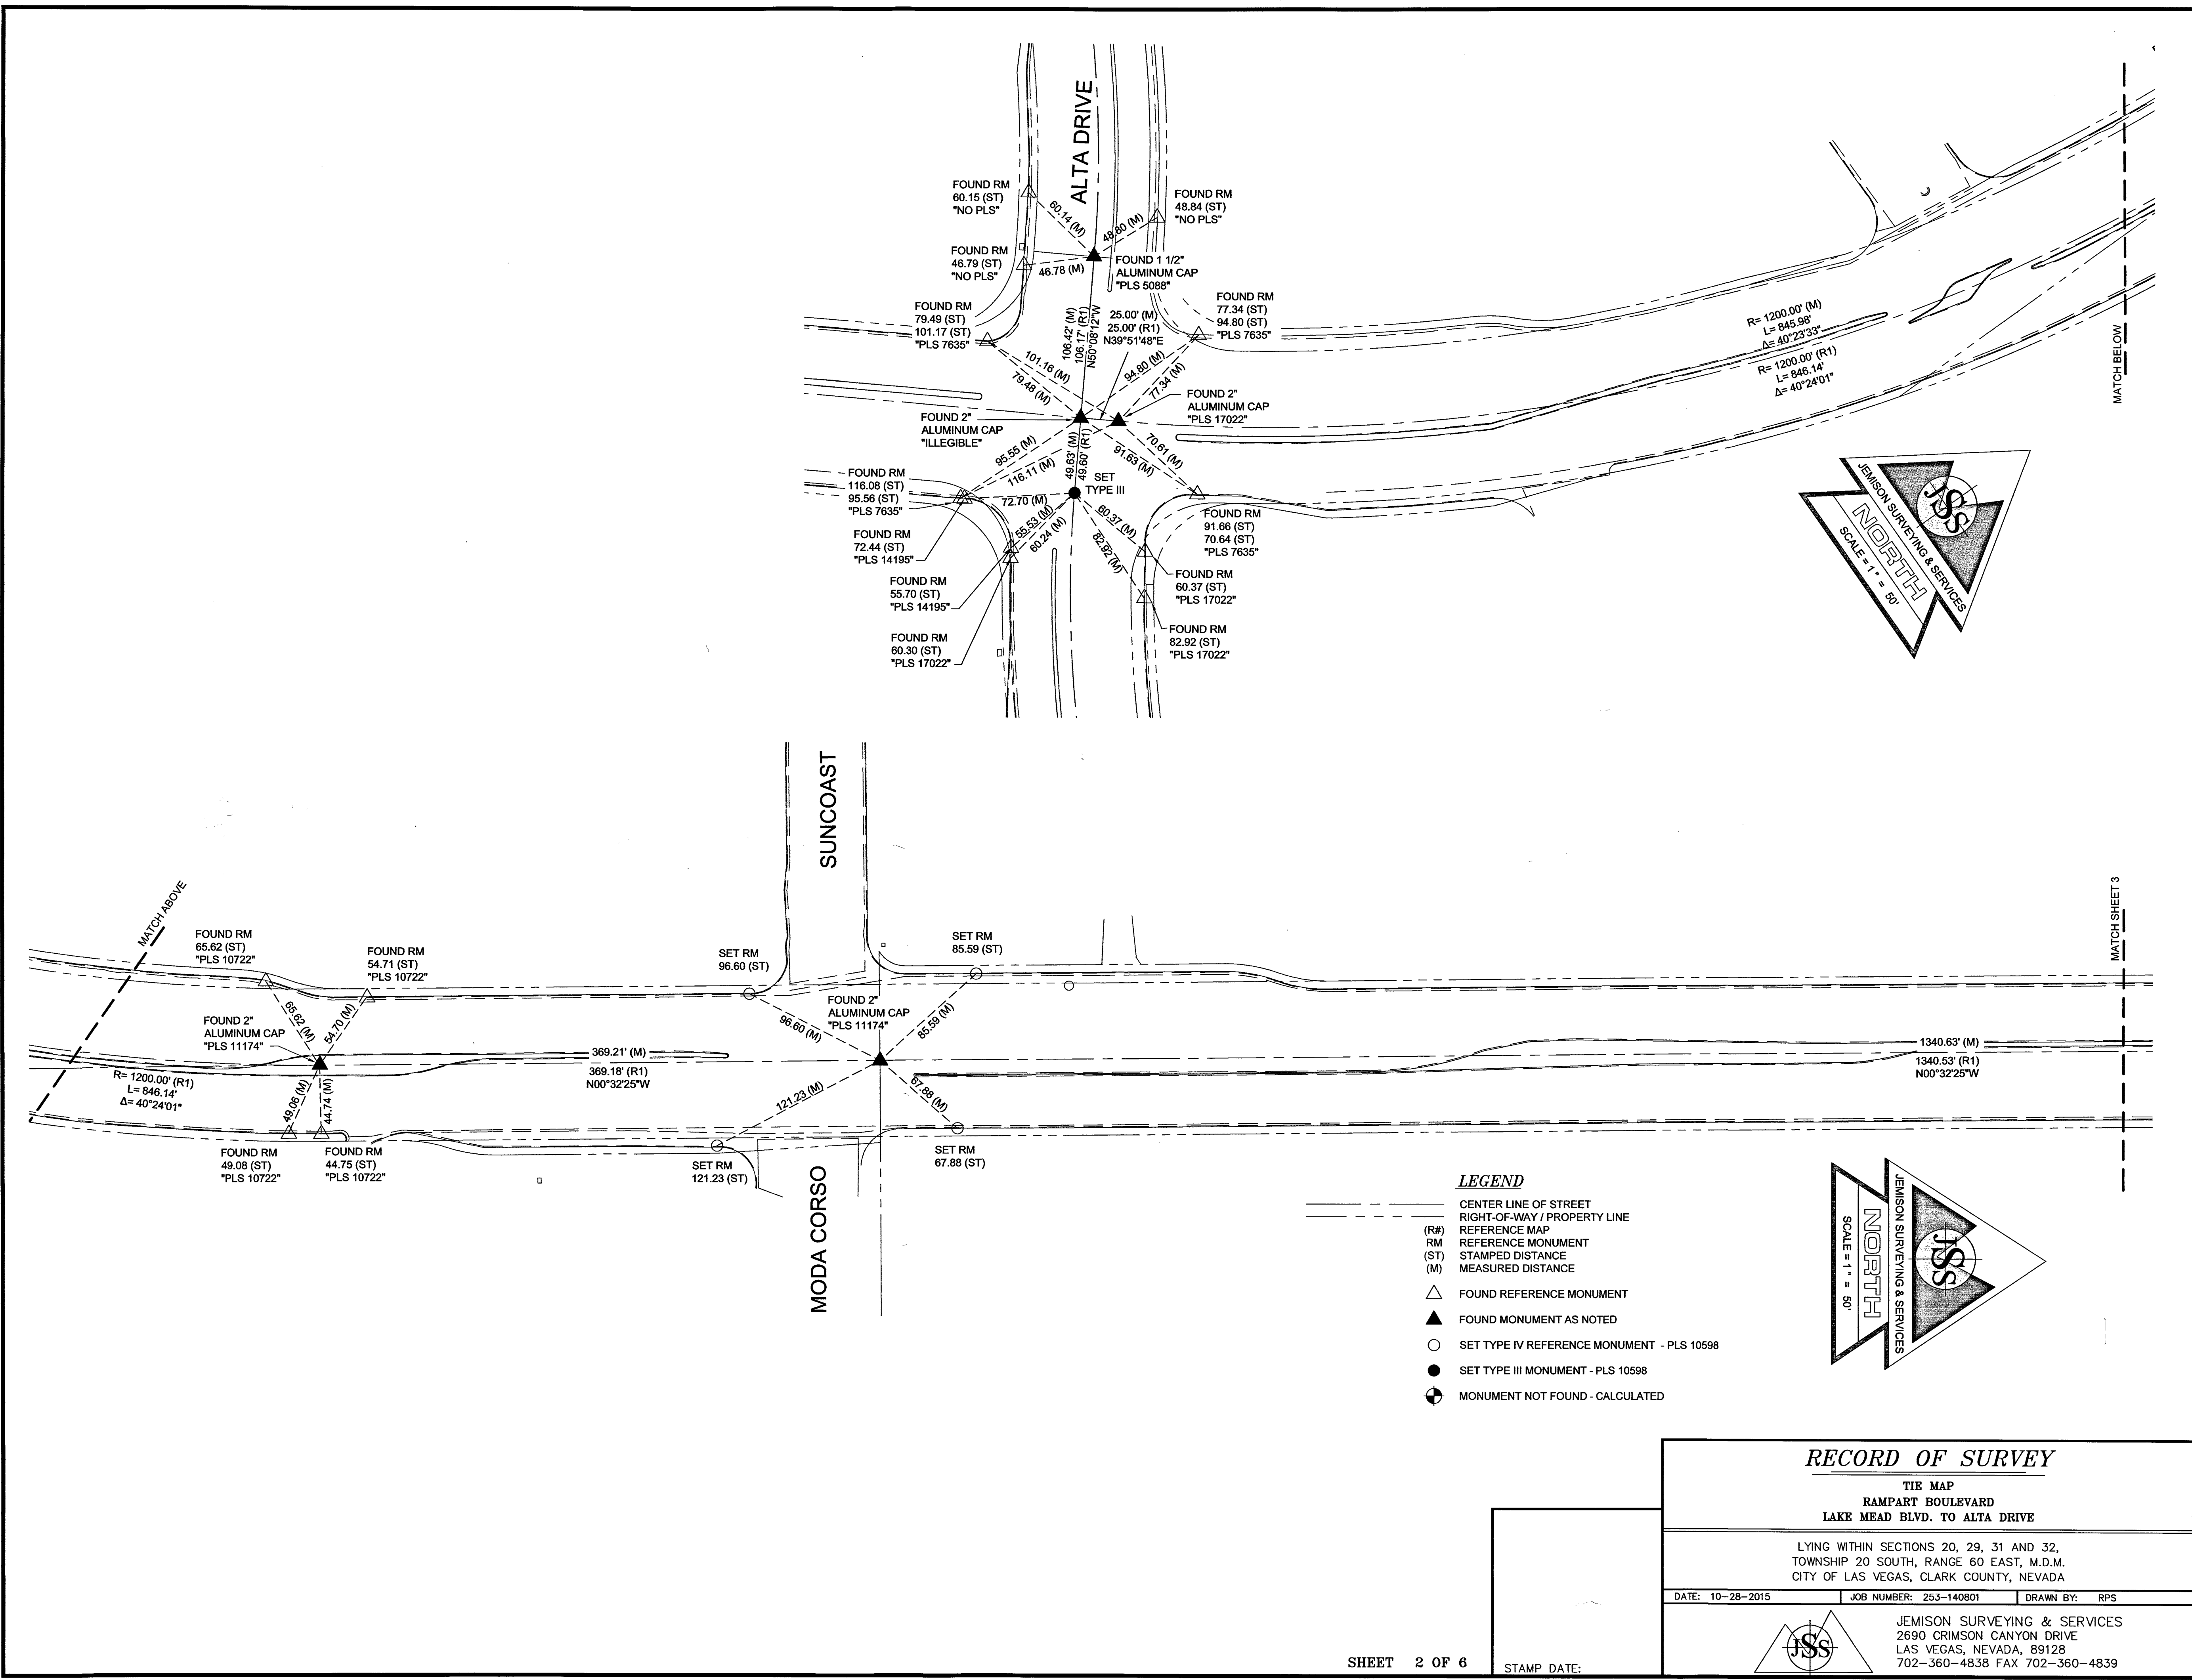

LEGEND

- CENTER LINE OF STREET
- - - RIGHT-OF-WAY / PROPERTY LINE
- (R#) REFERENCE MAP
- RM REFERENCE MONUMENT
- (ST) STAMPED DISTANCE
- (M) MEASURED DISTANCE
- △ FOUND REFERENCE MONUMENT
- ▲ FOUND MONUMENT AS NOTED
- SET TYPE IV REFERENCE MONUMENT - PLS 10598
- SET TYPE III MONUMENT - PLS 10598
- ⊙ MONUMENT NOT FOUND - CALCULATED

RECORD OF SURVEY


TIE MAP
RAMPART BOULEVARD
LAKE MEAD BLVD. TO ALTA DRIVE

LYING WITHIN SECTIONS 20, 29, 31 AND 32,
TOWNSHIP 20 SOUTH, RANGE 60 EAST, M.D.M.
CITY OF LAS VEGAS, CLARK COUNTY, NEVADA

DATE: 10-28-2015 JOB NUMBER: 253-140801 DRAWN BY: RPS



JEMISON SURVEYING & SERVICES
2690 CRIMSON CANYON DRIVE
LAS VEGAS, NEVADA, 89128
702-360-4838 FAX 702-360-4839

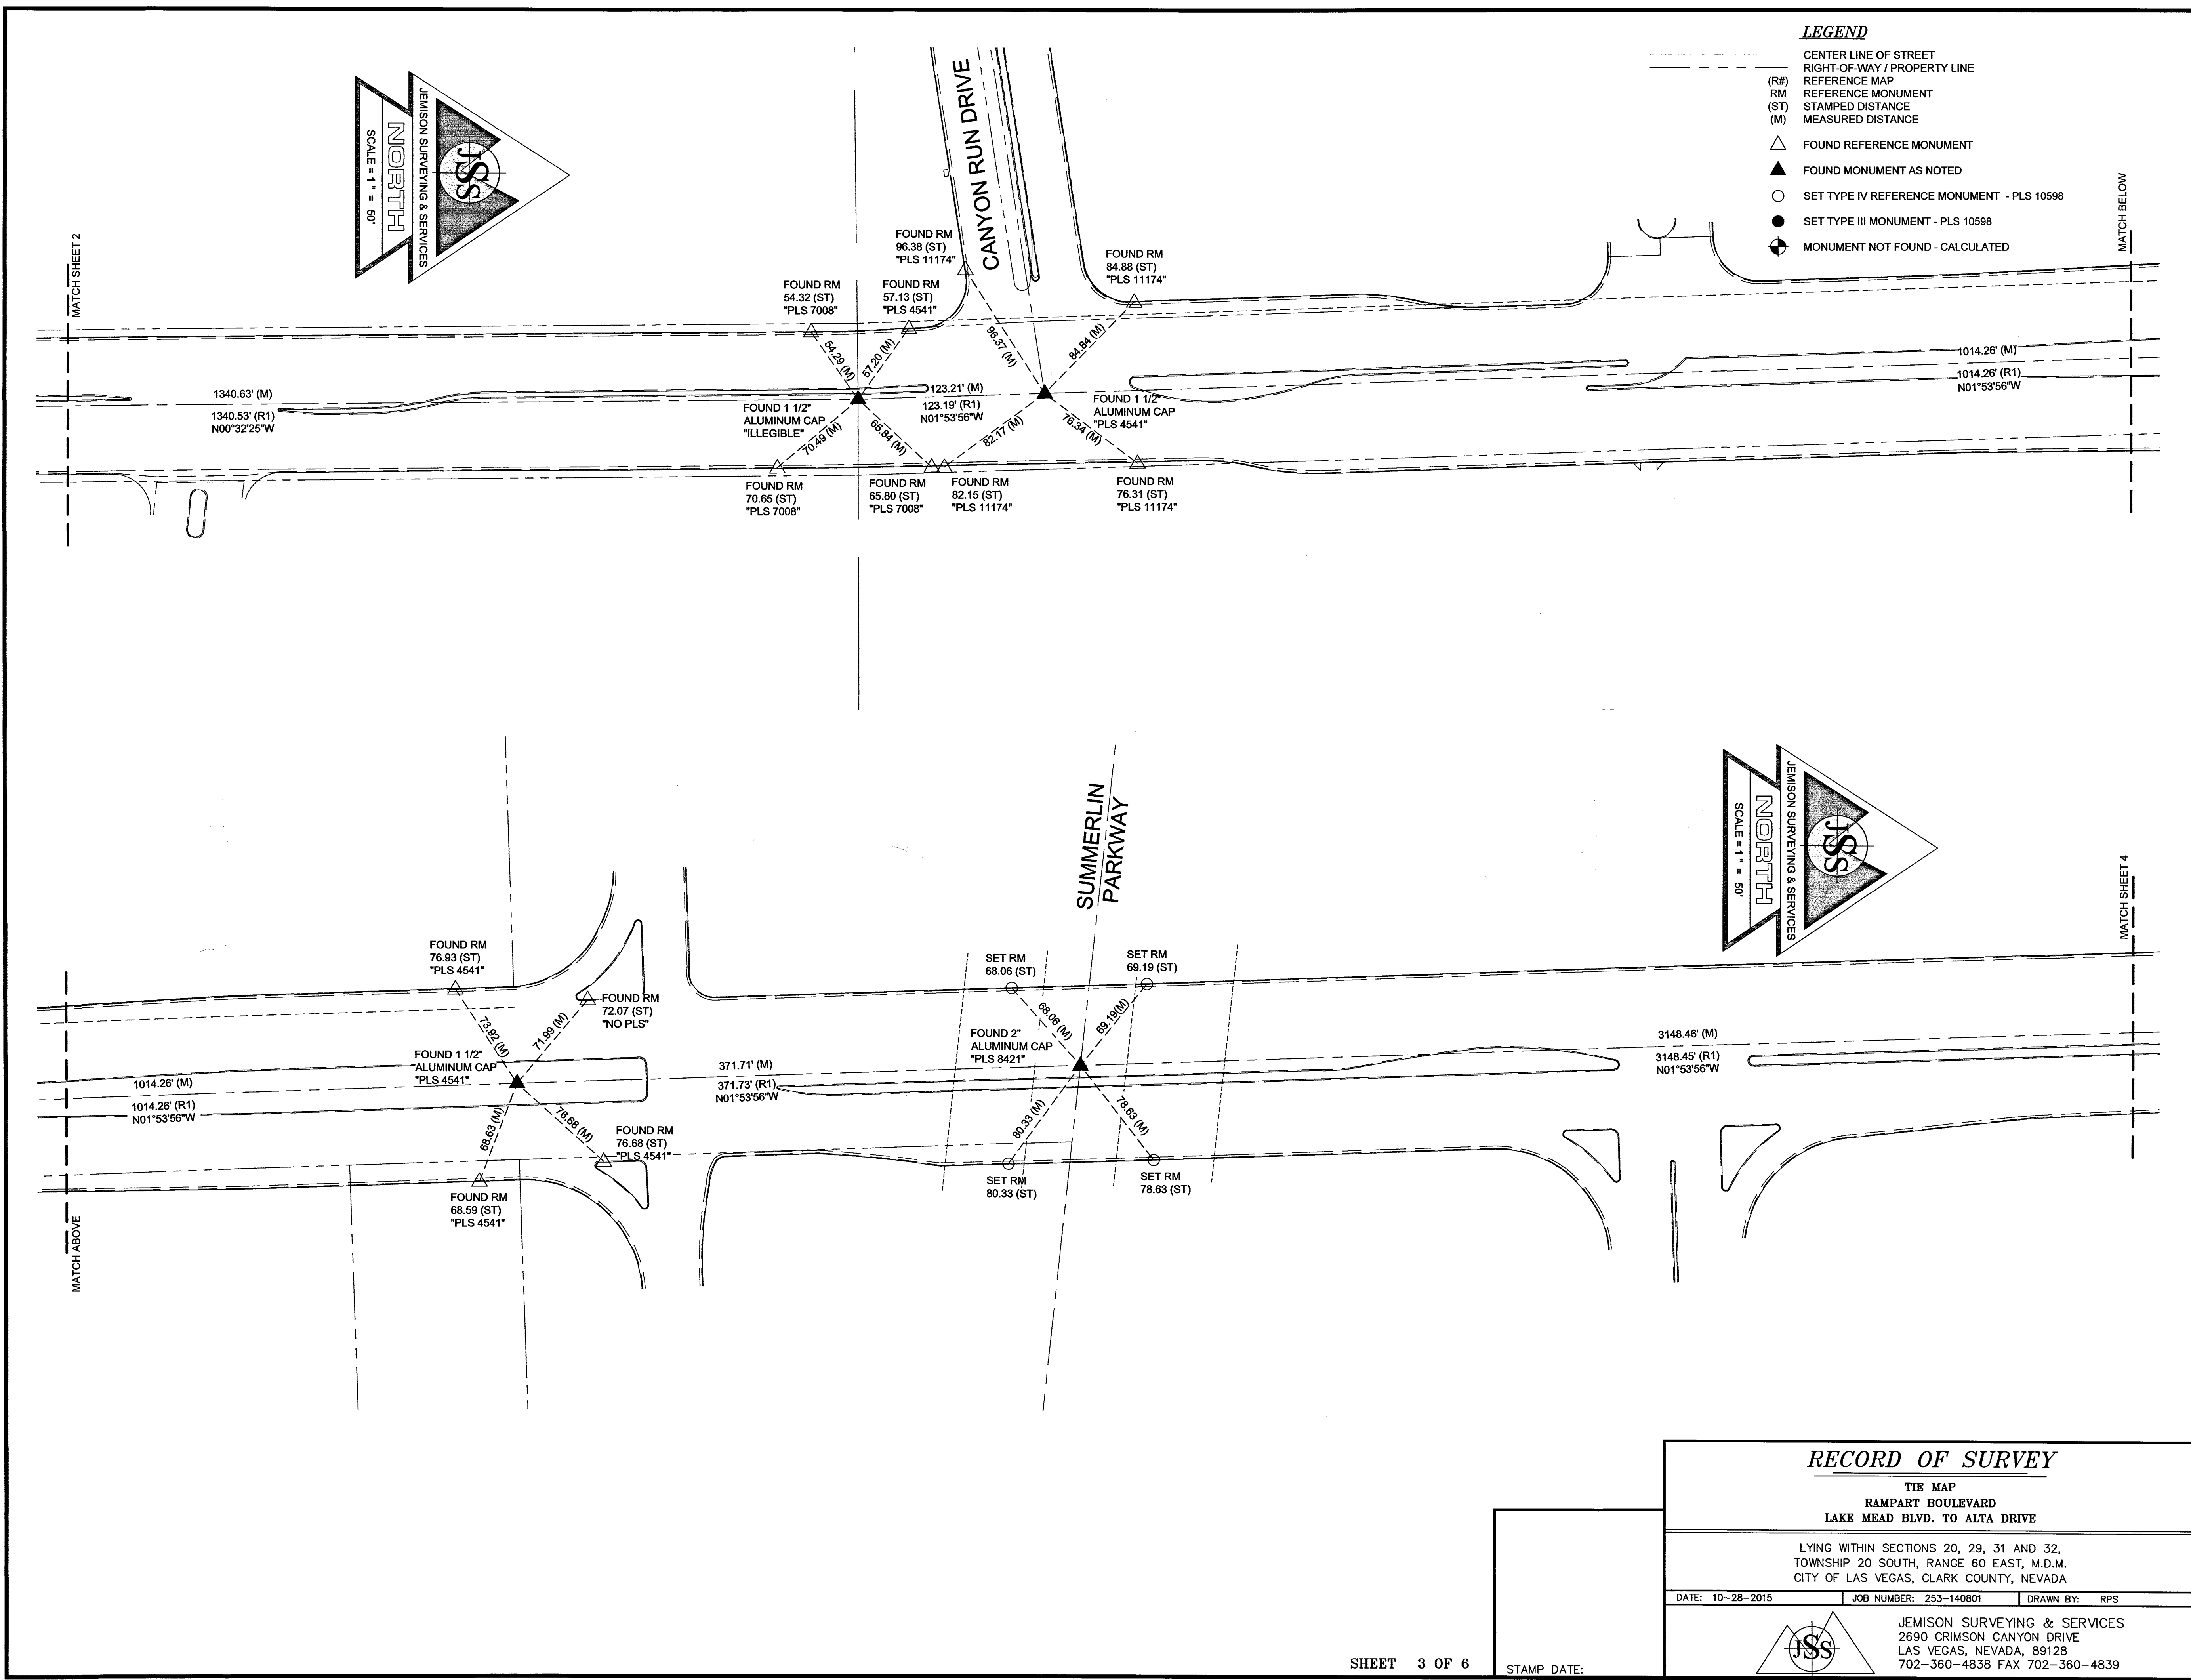

RECORD OF SURVEY




TIE MAP
RAMPART BOULEVARD
LAKE MEAD BLVD. TO ALTA DRIVE

LYING WITHIN SECTIONS 20, 29, 31 AND 32,
TOWNSHIP 20 SOUTH, RANGE 60 EAST, M.D.M.
CITY OF LAS VEGAS, CLARK COUNTY, NEVADA

DATE: 10-28-2015 JOB NUMBER: 253-140801 DRAWN BY: RPS





JEMISON SURVEYING & SERVICES
2690 CRIMSON CANYON DRIVE
LAS VEGAS, NEVADA, 89128
702-360-4838 FAX 702-360-4839

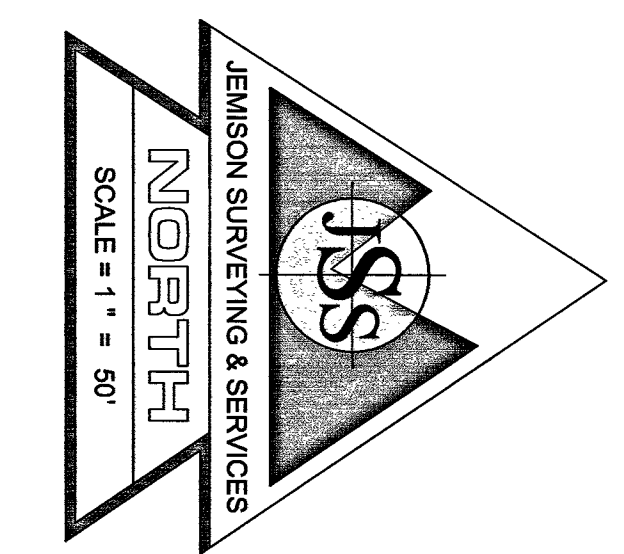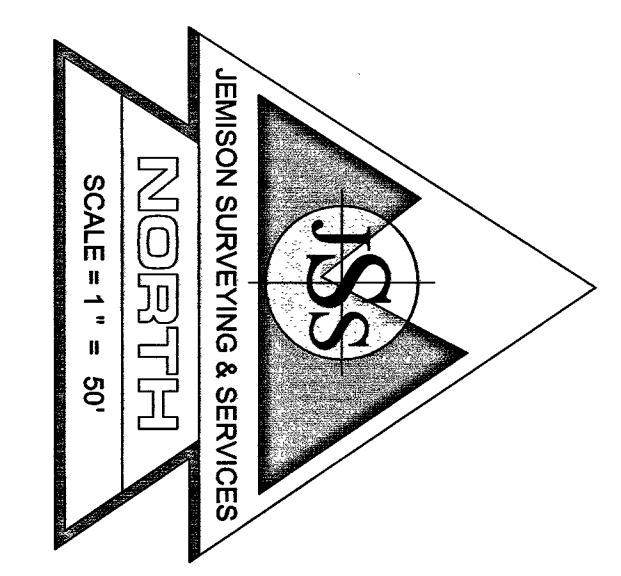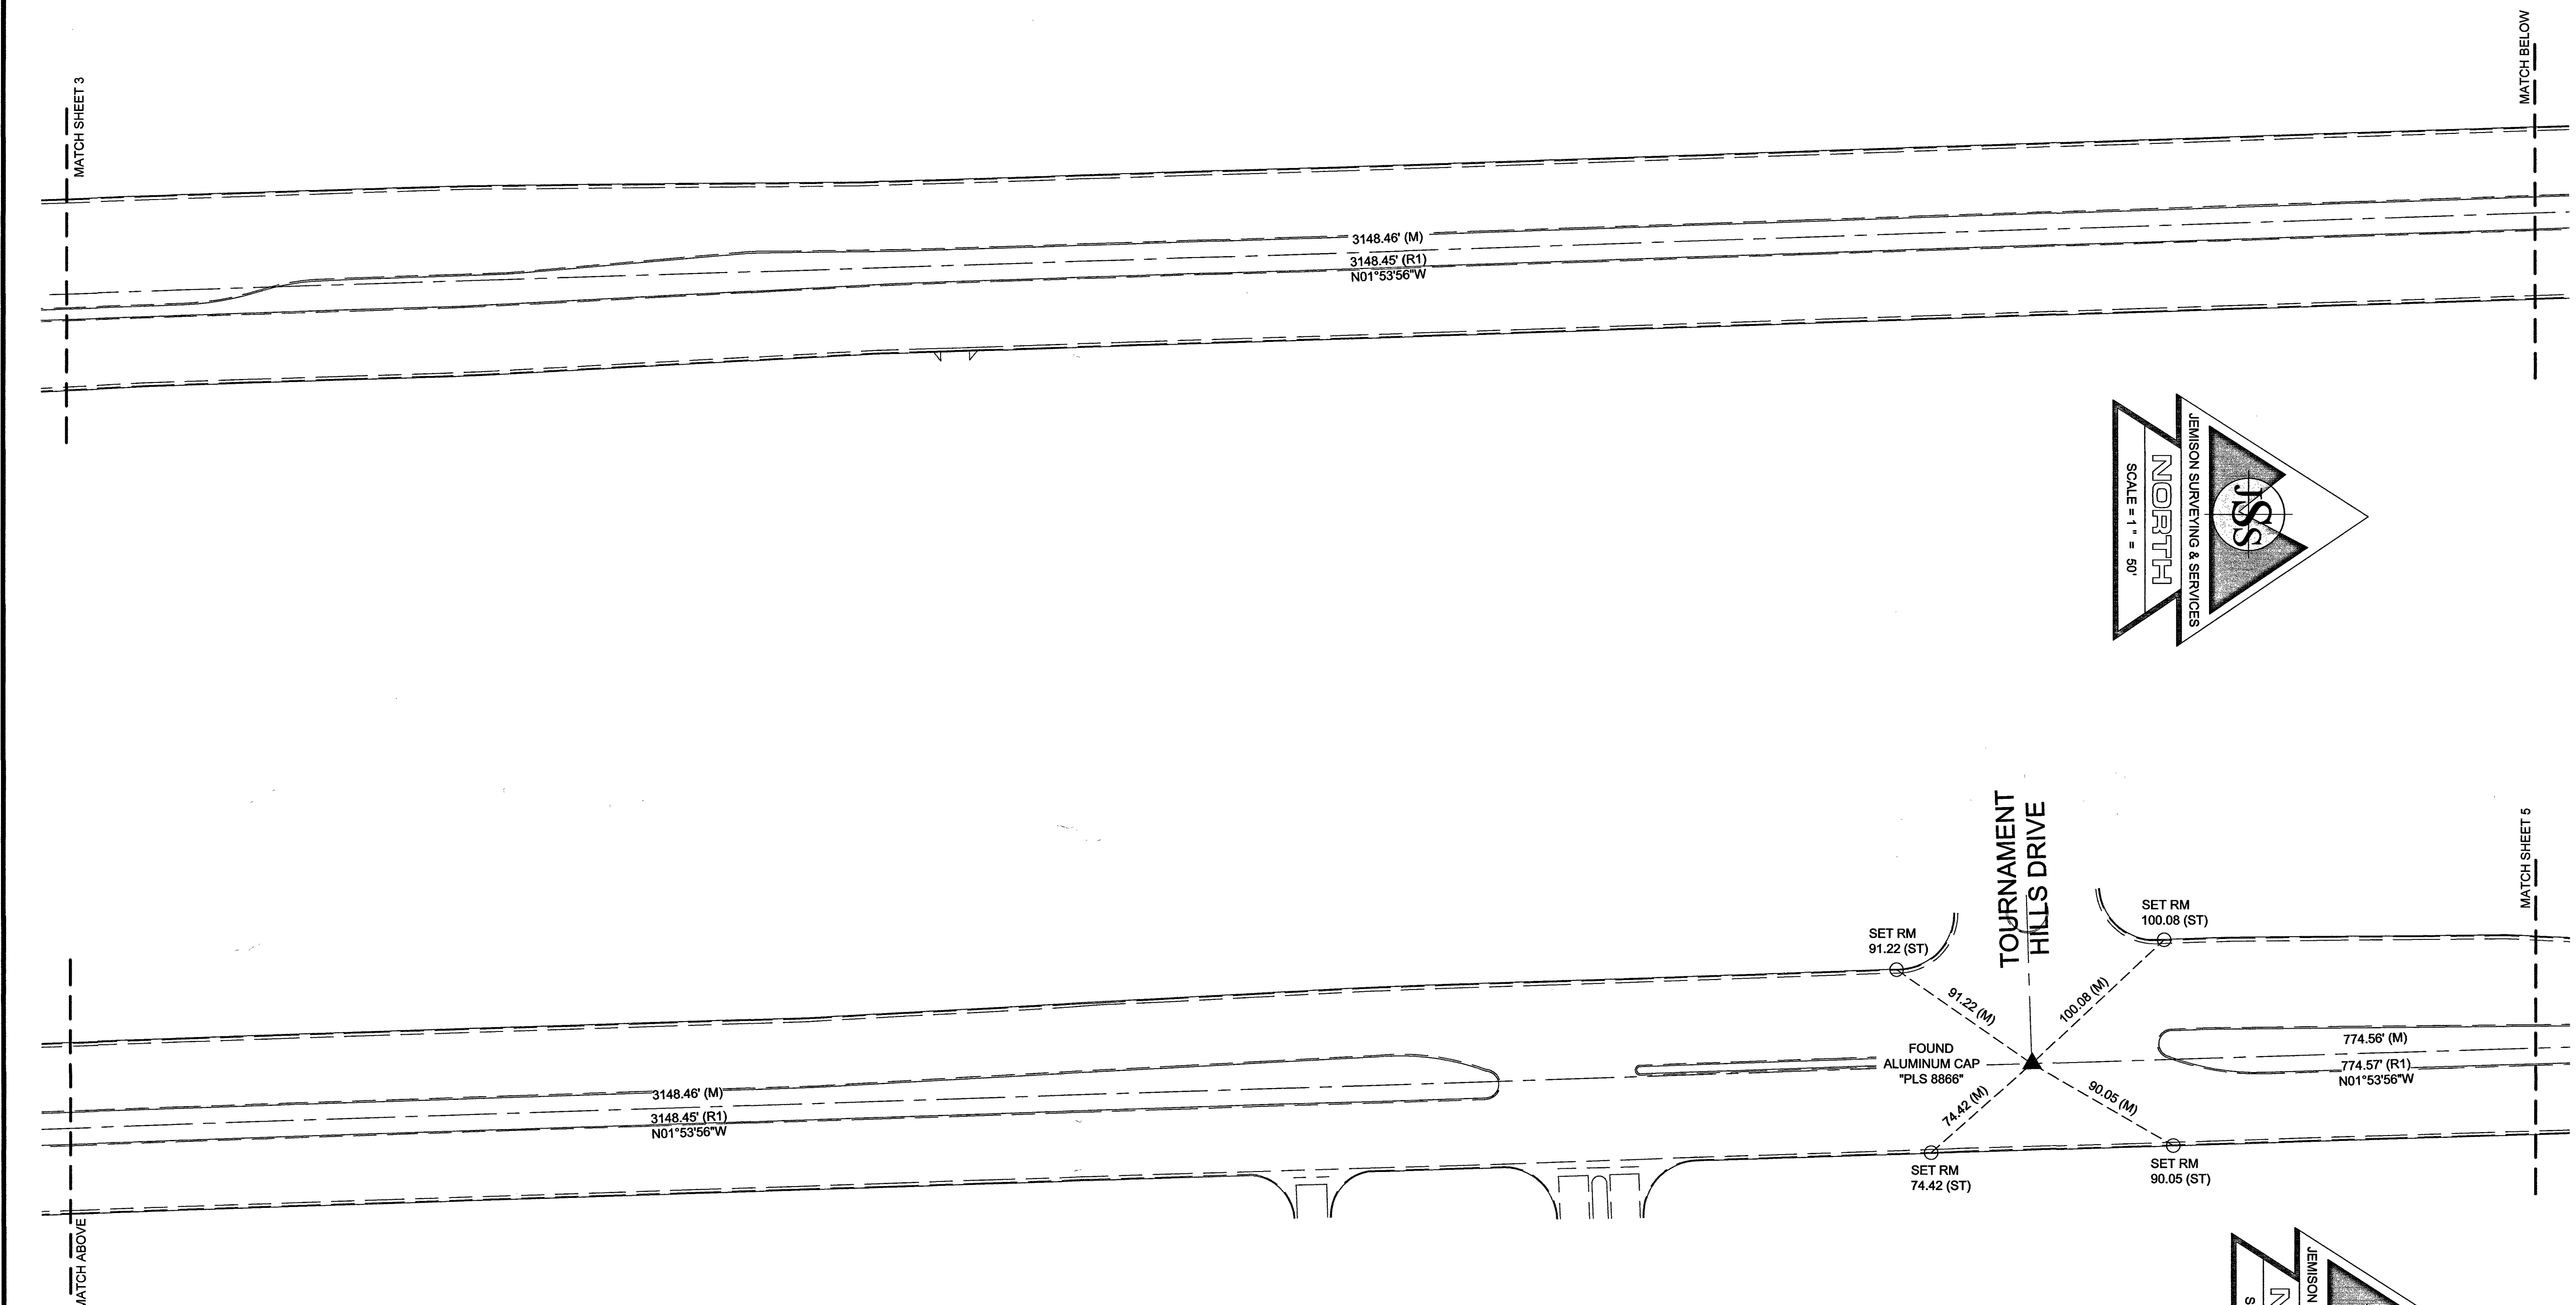


- LEGEND**
- CENTER LINE OF STREET
 - - - RIGHT-OF-WAY / PROPERTY LINE
 - (R#) REFERENCE MAP
 - RM REFERENCE MONUMENT
 - (ST) STAMPED DISTANCE
 - (M) MEASURED DISTANCE
 - △ FOUND REFERENCE MONUMENT
 - ▲ FOUND MONUMENT AS NOTED
 - SET TYPE IV REFERENCE MONUMENT - PLS 10598
 - SET TYPE III MONUMENT - PLS 10598
 - ⊙ MONUMENT NOT FOUND - CALCULATED

RECORD OF SURVEY		
TIE MAP RAMPART BOULEVARD LAKE MEAD BLVD. TO ALTA DRIVE		
LYING WITHIN SECTIONS 20, 29, 31 AND 32, TOWNSHIP 20 SOUTH, RANGE 60 EAST, M.D.M. CITY OF LAS VEGAS, CLARK COUNTY, NEVADA		
DATE: 10-28-2015	JOB NUMBER: 253-140801	DRAWN BY: RPS
		JEMISON SURVEYING & SERVICES 2690 CRIMSON CANYON DRIVE LAS VEGAS, NEVADA, 89128 702-360-4838 FAX 702-360-4839

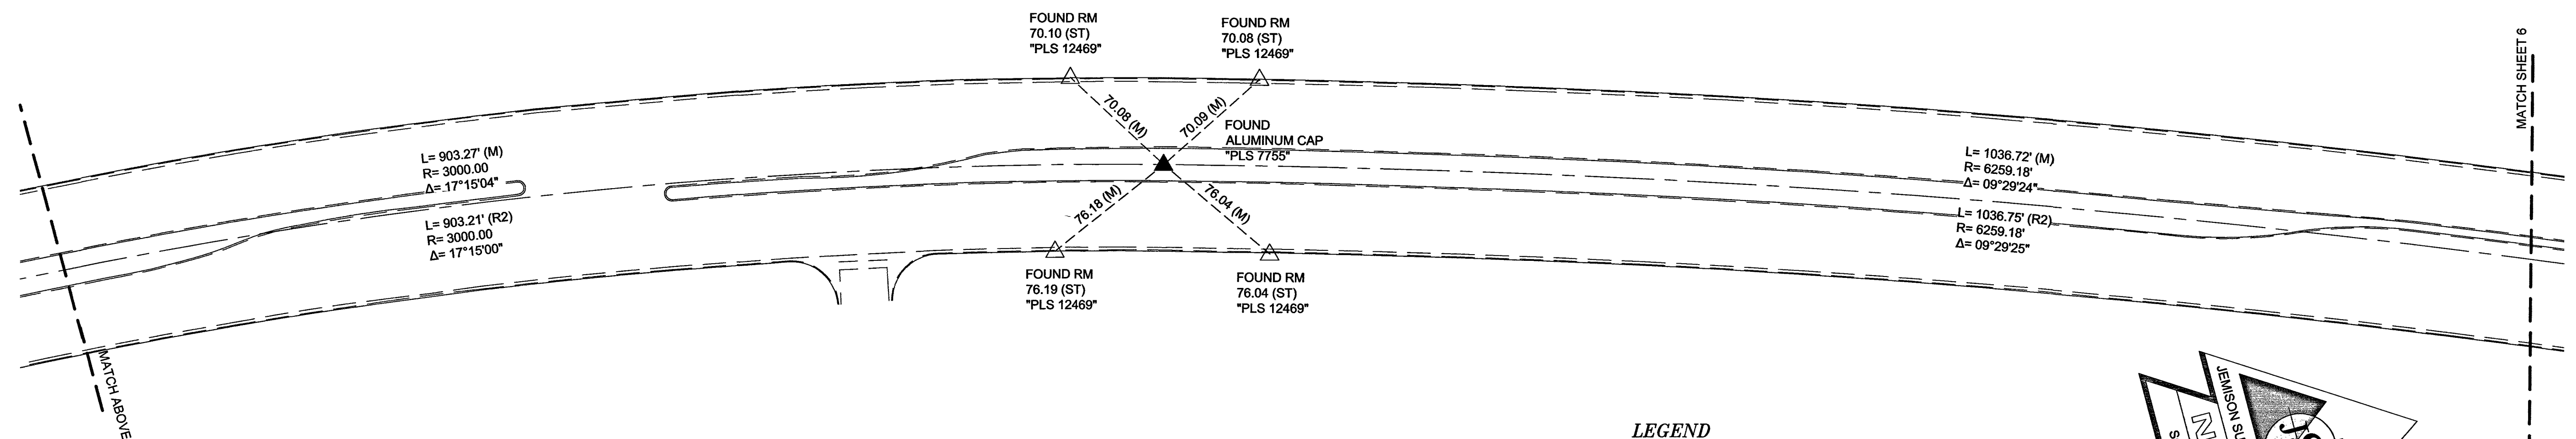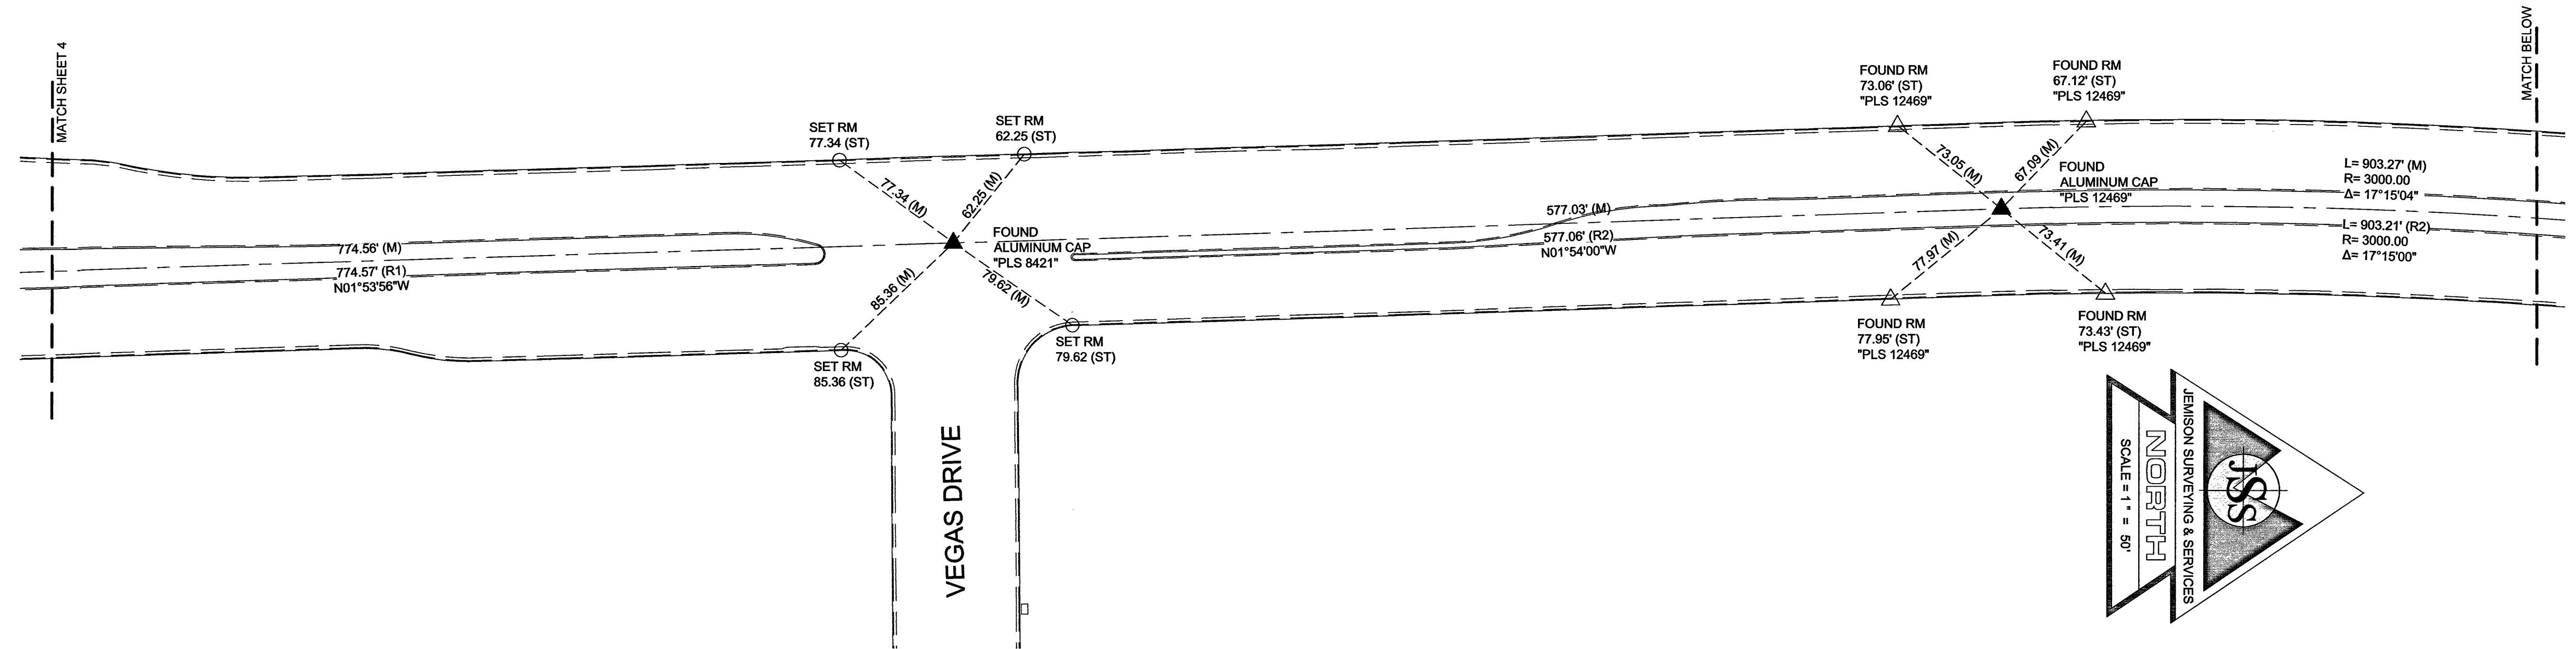

- LEGEND**
- CENTER LINE OF STREET
 - - - RIGHT-OF-WAY / PROPERTY LINE
 - (R#) REFERENCE MAP
 - RM REFERENCE MONUMENT
 - (ST) STAMPED DISTANCE
 - (M) MEASURED DISTANCE
 - △ FOUND REFERENCE MONUMENT
 - ▲ FOUND MONUMENT AS NOTED
 - SET TYPE IV REFERENCE MONUMENT - PLS 10598
 - SET TYPE III MONUMENT - PLS 10598
 - ⊕ MONUMENT NOT FOUND - CALCULATED

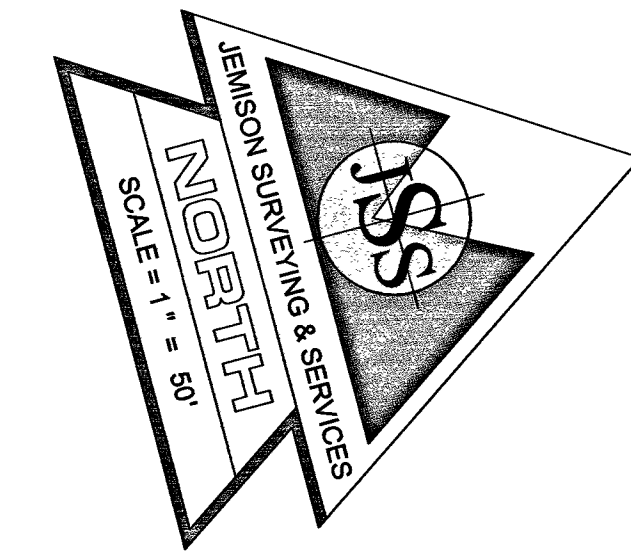

RECORD OF SURVEY





TIE MAP
RAMPART BOULEVARD
LAKE MEAD BLVD. TO ALTA DRIVE

LYING WITHIN SECTIONS 20, 29, 31 AND 32,
TOWNSHIP 20 SOUTH, RANGE 60 EAST, M.D.M.
CITY OF LAS VEGAS, CLARK COUNTY, NEVADA

DATE: 10-28-2015 JOB NUMBER: 253-140801 DRAWN BY: RPS



JEMISON SURVEYING & SERVICES
2690 CRIMSON CANYON DRIVE
LAS VEGAS, NEVADA, 89128
702-360-4838 FAX 702-360-4839

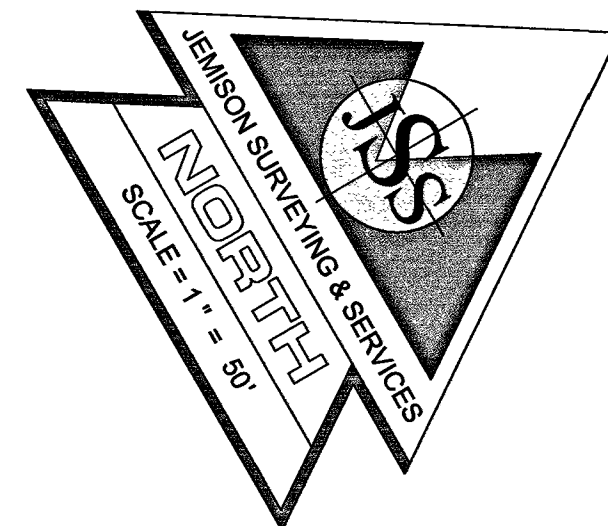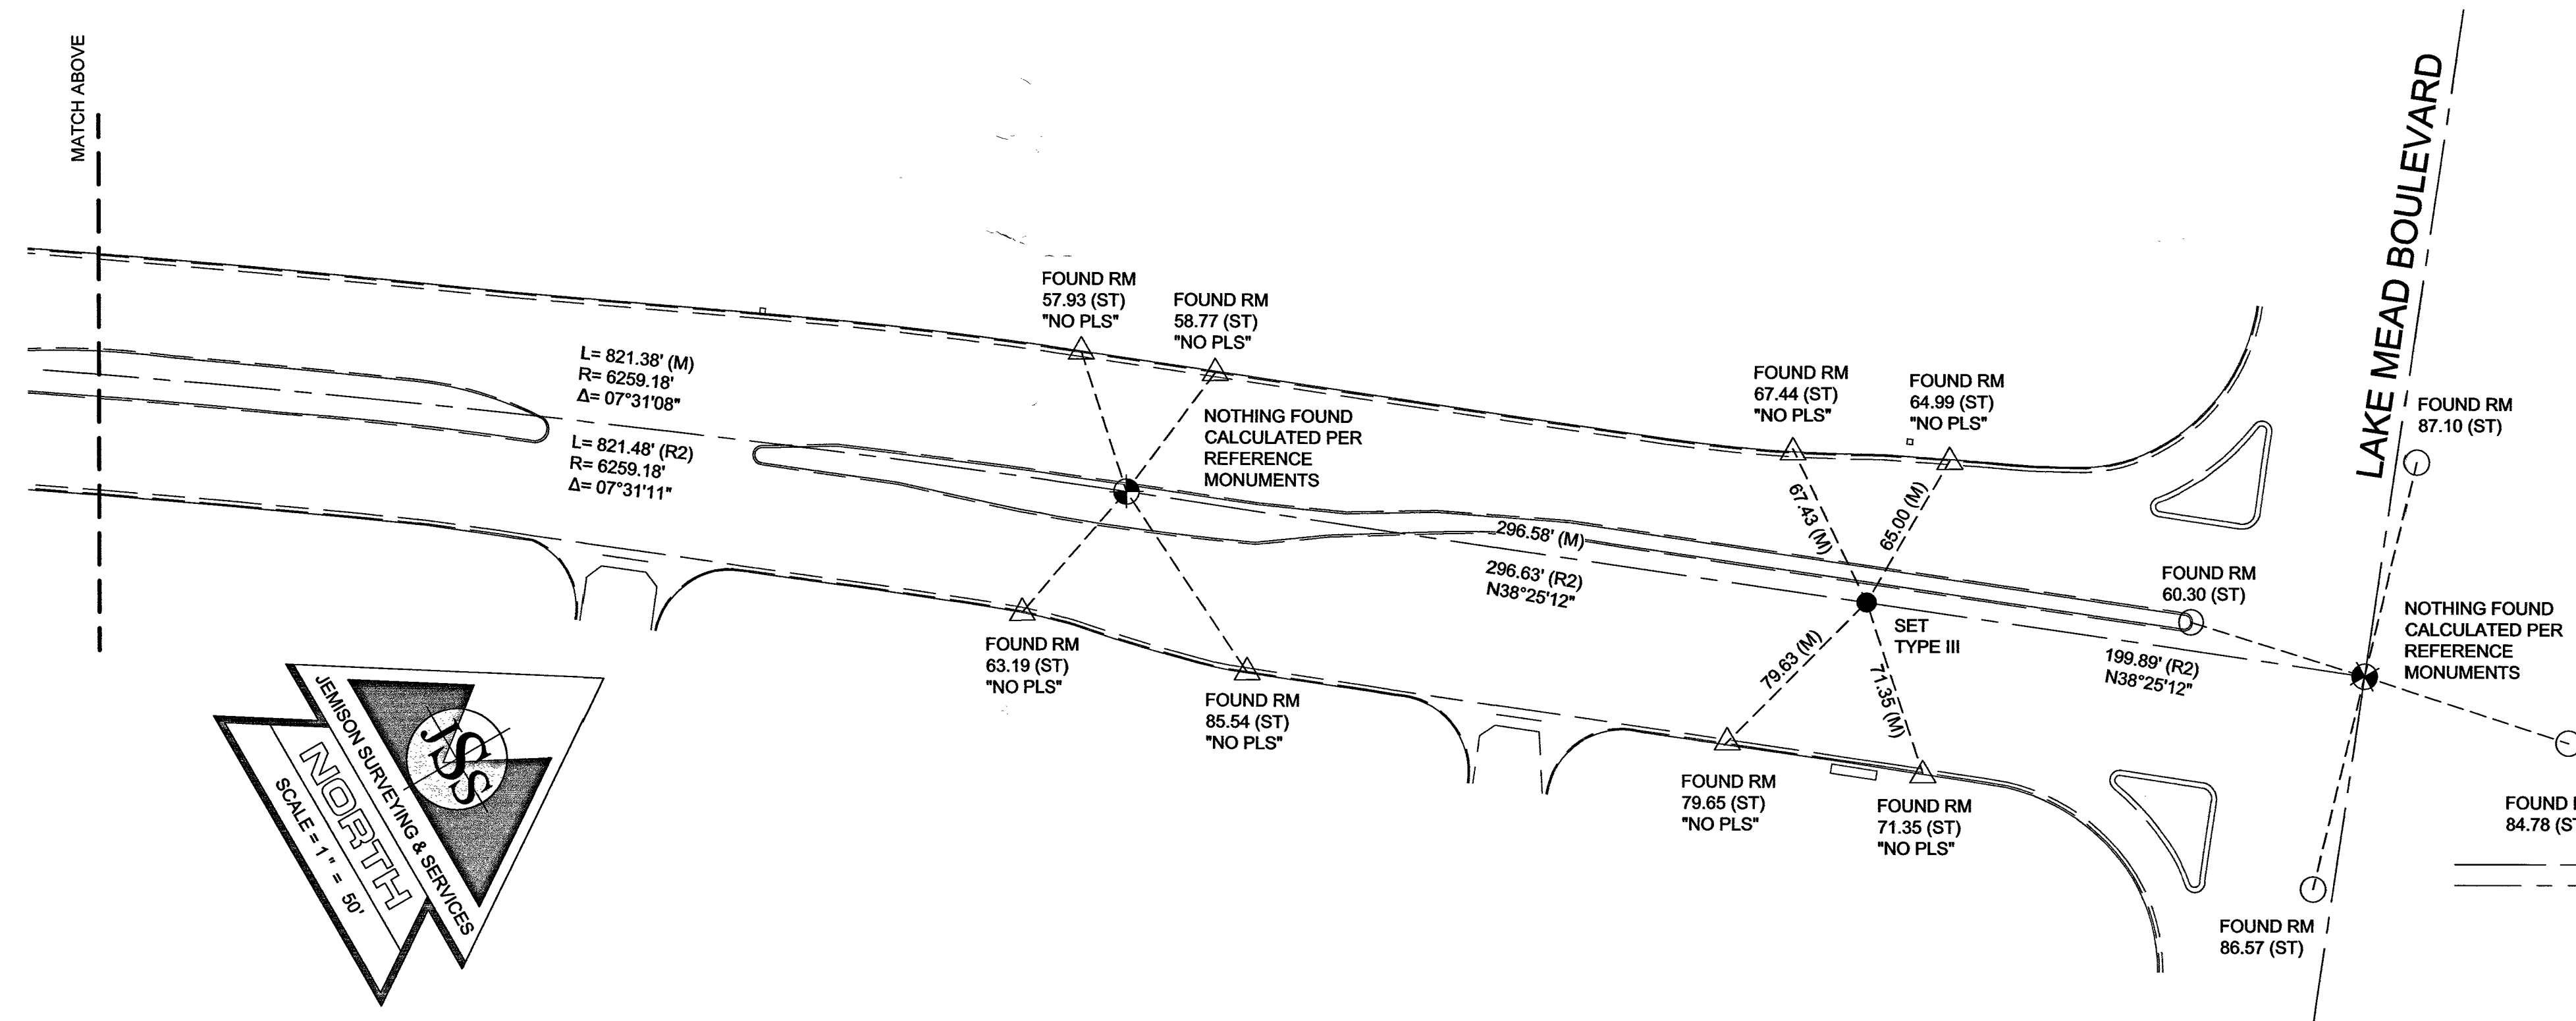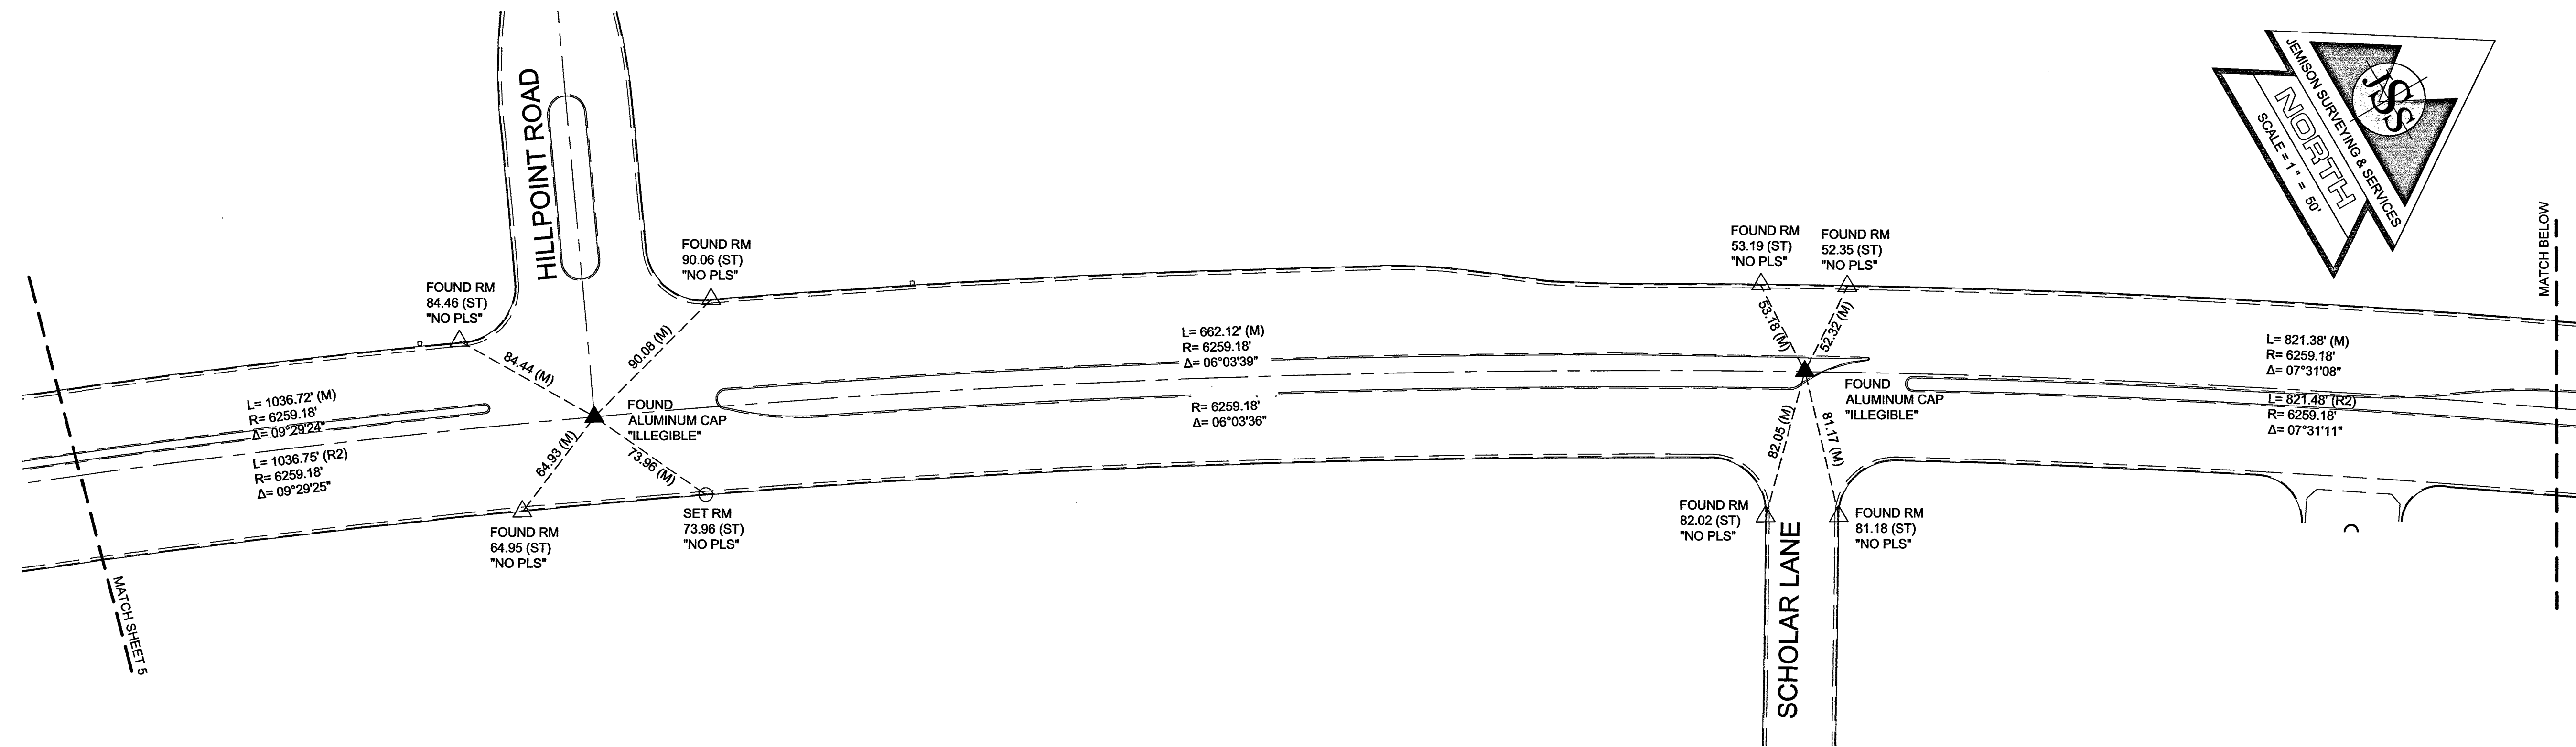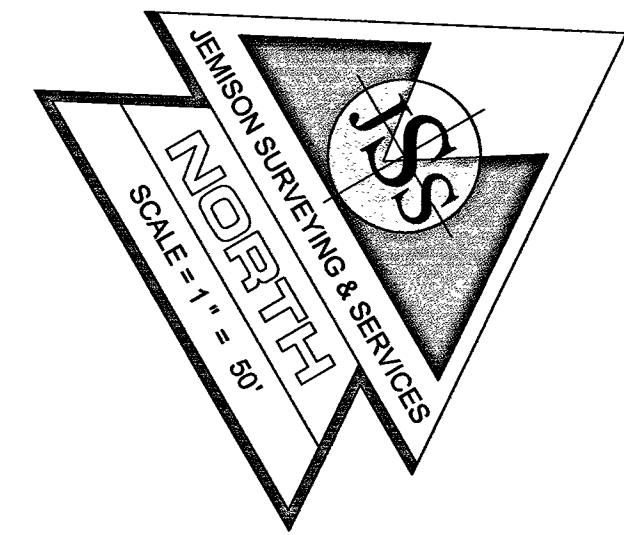

- LEGEND**
- CENTER LINE OF STREET
 - - - RIGHT-OF-WAY / PROPERTY LINE
 - (R#) REFERENCE MAP
 - RM REFERENCE MONUMENT
 - (ST) STAMPED DISTANCE
 - (M) MEASURED DISTANCE
 - △ FOUND REFERENCE MONUMENT
 - ▲ FOUND MONUMENT AS NOTED
 - SET TYPE IV REFERENCE MONUMENT - PLS 10598
 - SET TYPE III MONUMENT - PLS 10598
 - ⊕ MONUMENT NOT FOUND - CALCULATED

RECORD OF SURVEY

TIE MAP
RAMPART BOULEVARD
LAKE MEAD BLVD. TO ALTA DRIVE

LYING WITHIN SECTIONS 20, 29, 31 AND 32,
TOWNSHIP 20 SOUTH, RANGE 60 EAST, M.D.M.
CITY OF LAS VEGAS, CLARK COUNTY, NEVADA

DATE: 10-28-2015 JOB NUMBER: 253-140801 DRAWN BY: RPS



JEMISON SURVEYING & SERVICES
2690 CRIMSON CANYON DRIVE
LAS VEGAS, NEVADA, 89128
702-360-4838 FAX 702-360-4839