
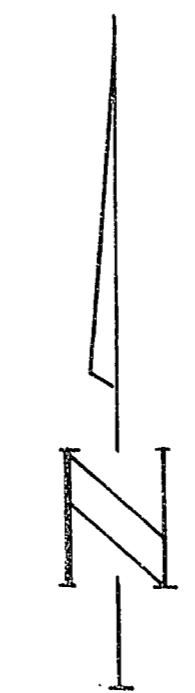


# RANCHO MANOR

## UNIT NOS. 1 & 2

MONUMENT TIES.

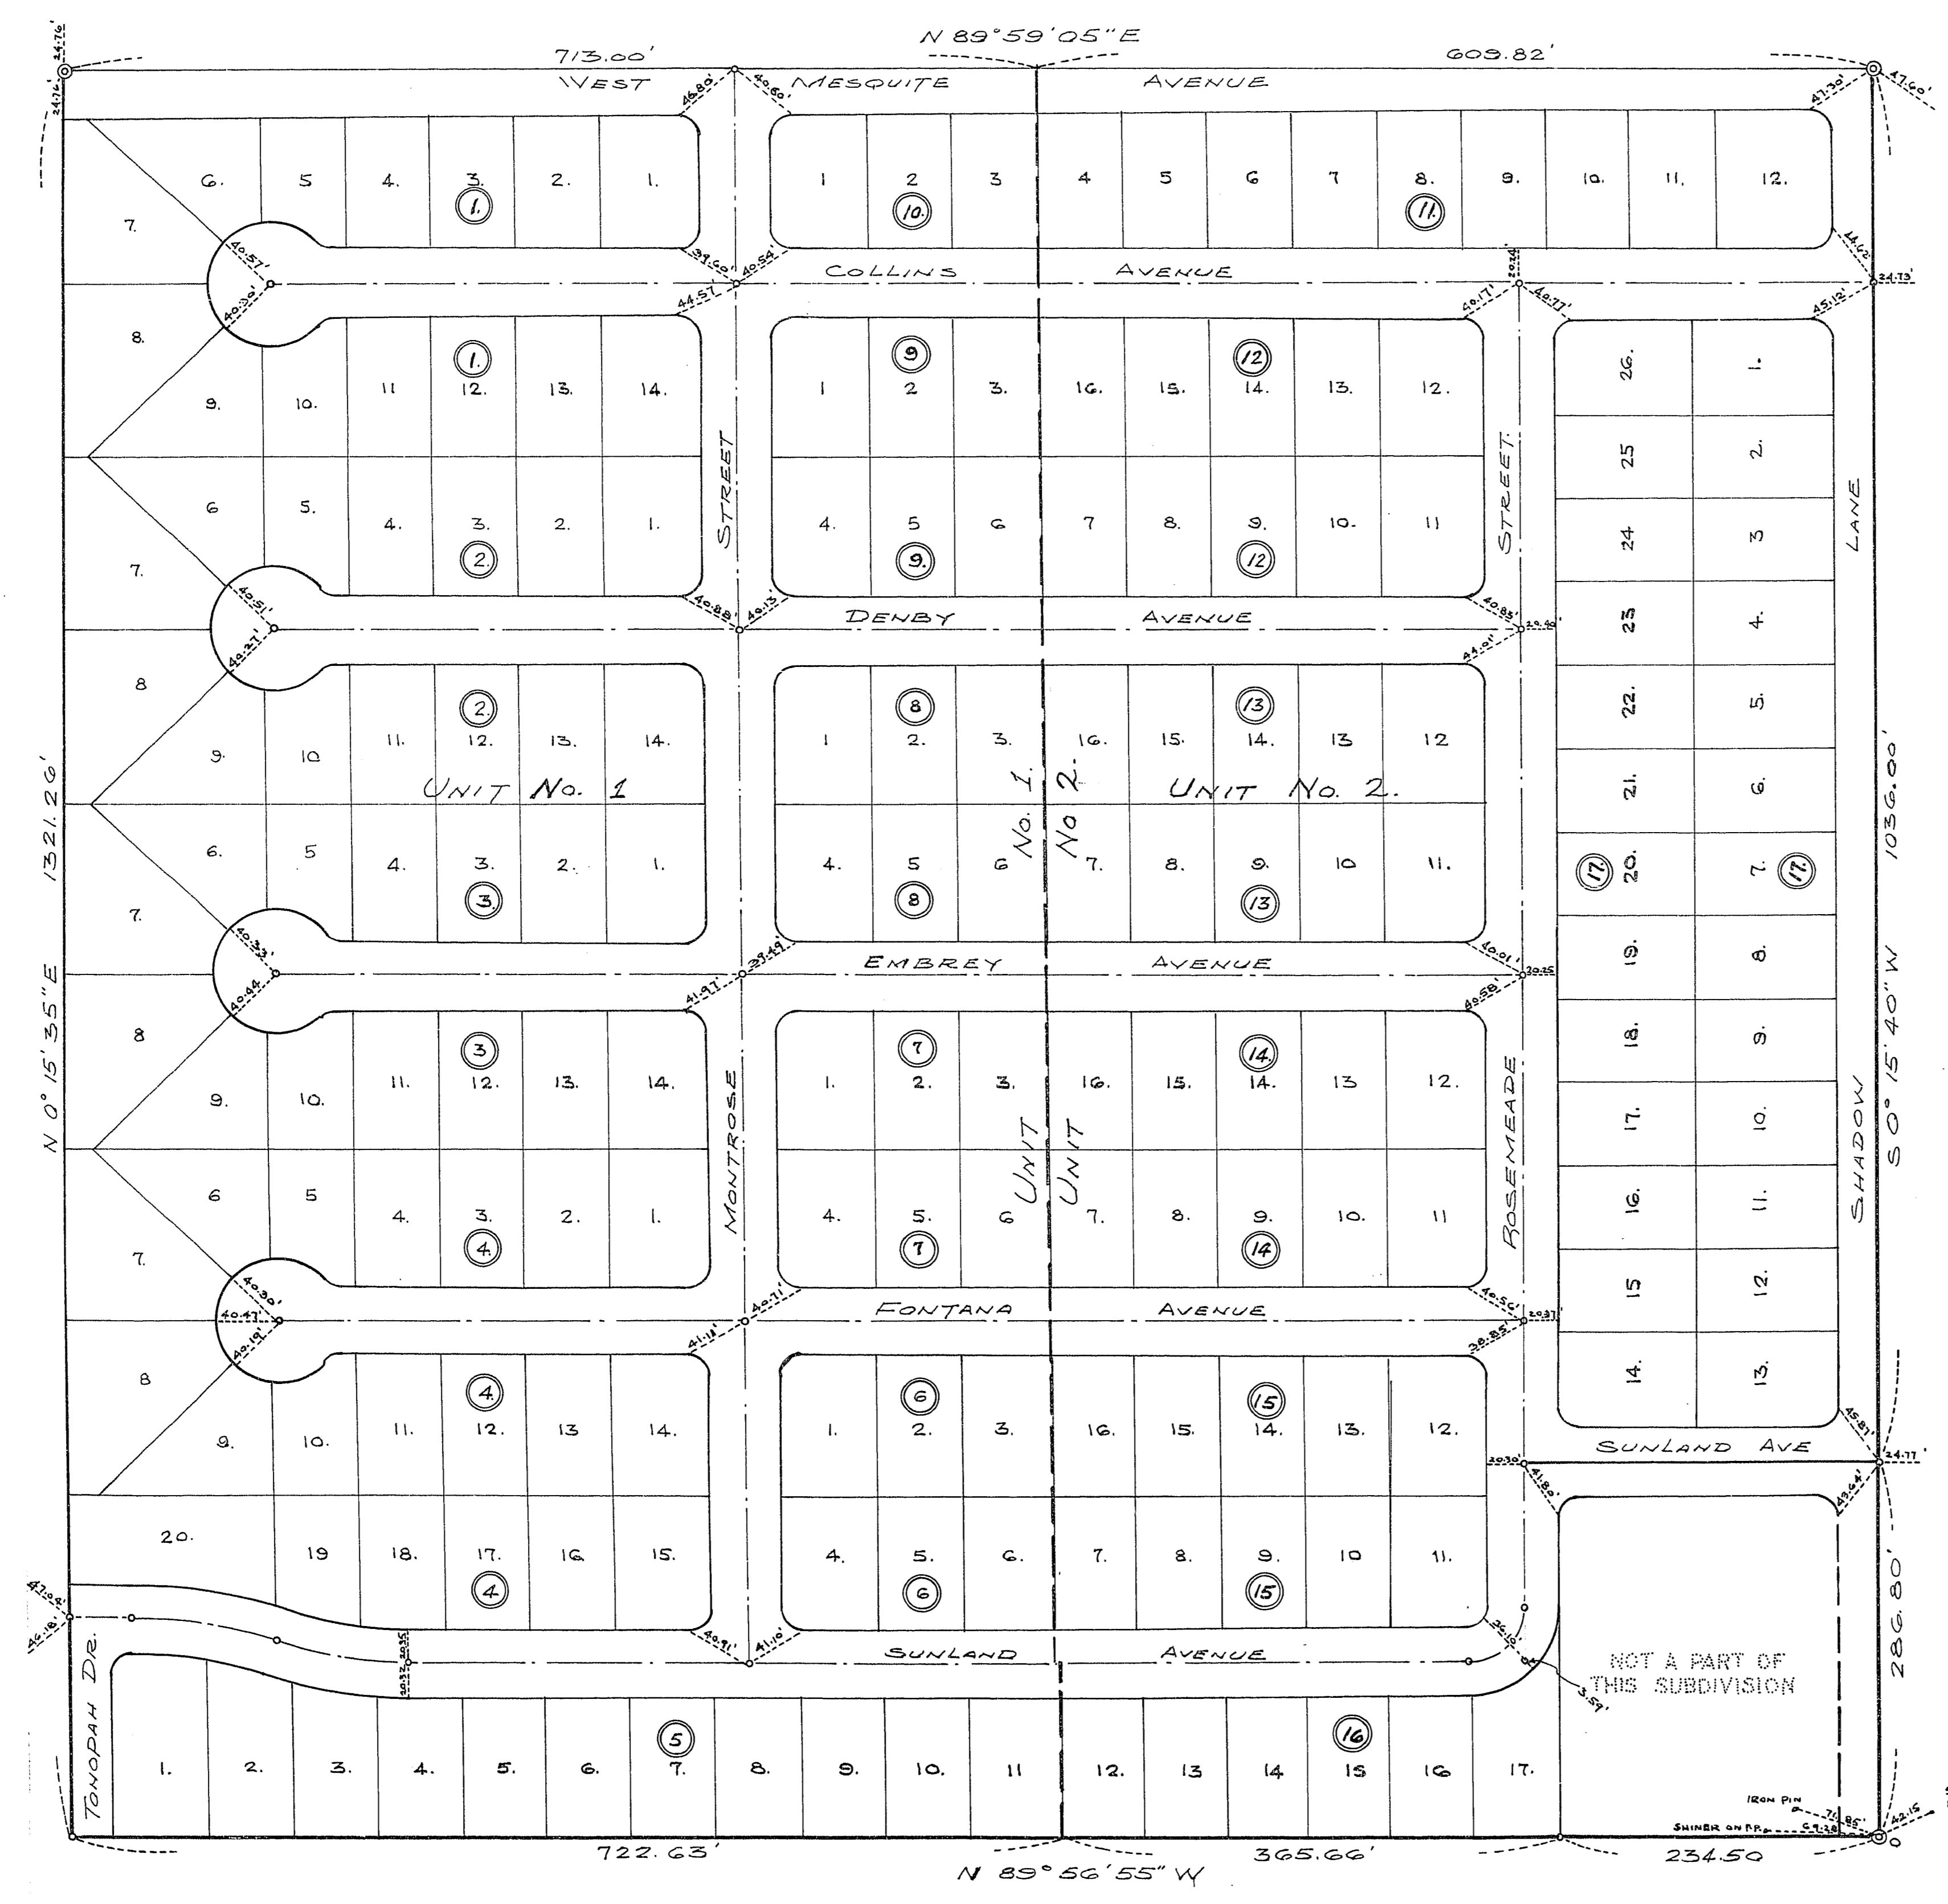

SCALE 1" = 80 FT.

