




1 TYP SECTION FOR 51' R/W
STD CROWN 0.42'
CANYON DRIVE, LANTERN LANE, JUSTICE LANE
STONEWOOD COURT, CAMEO CIRCLE, ROSEMARY LANE

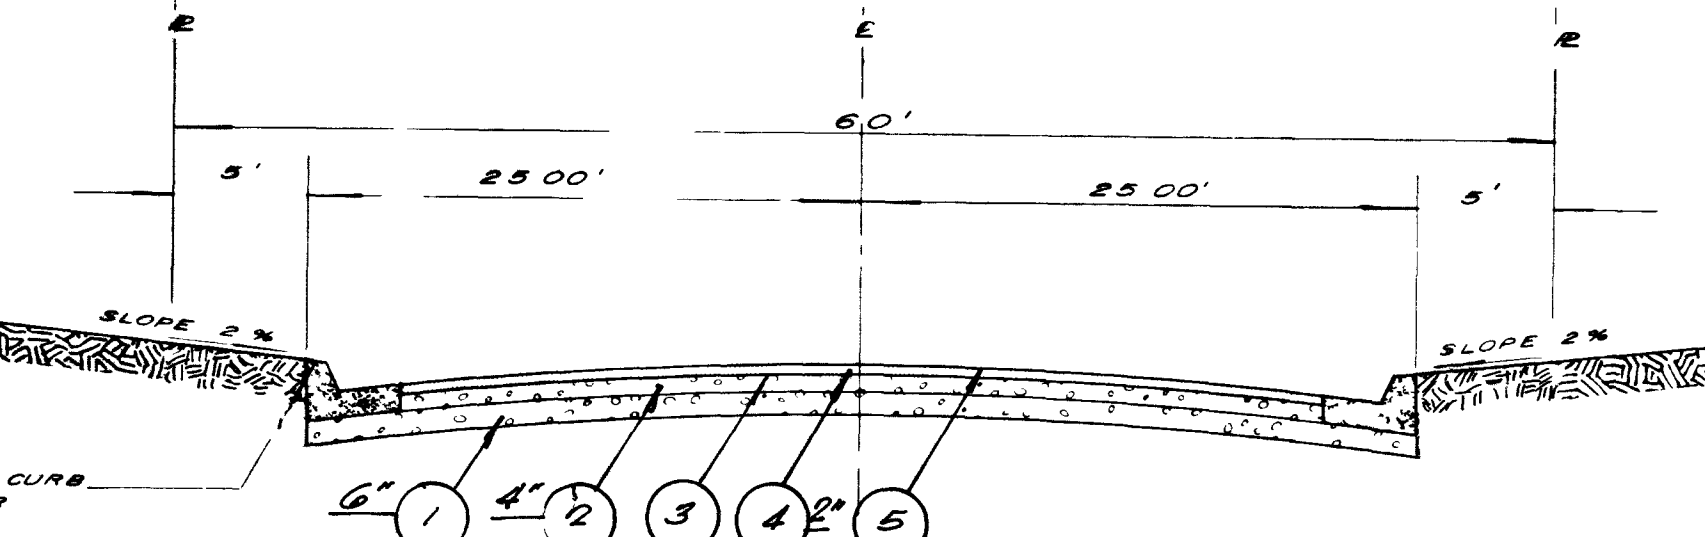


2 TYP SECTION FOR 60' R/W
STD CROWN 0.48'
CAMPBELL DRIVE, LANTERN LANE (EAST)

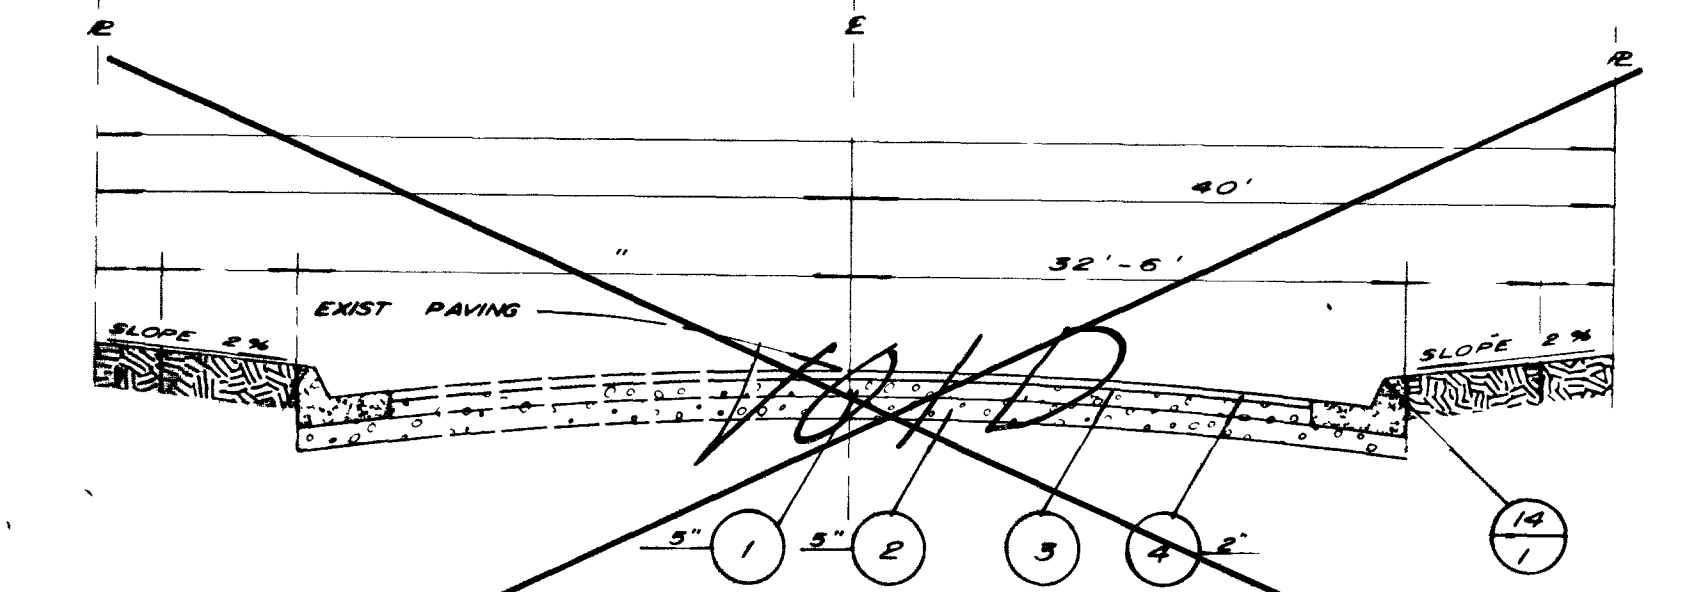

3 TYP SECTION FOR ALTA DRIVE
STD CROWN 0.60'

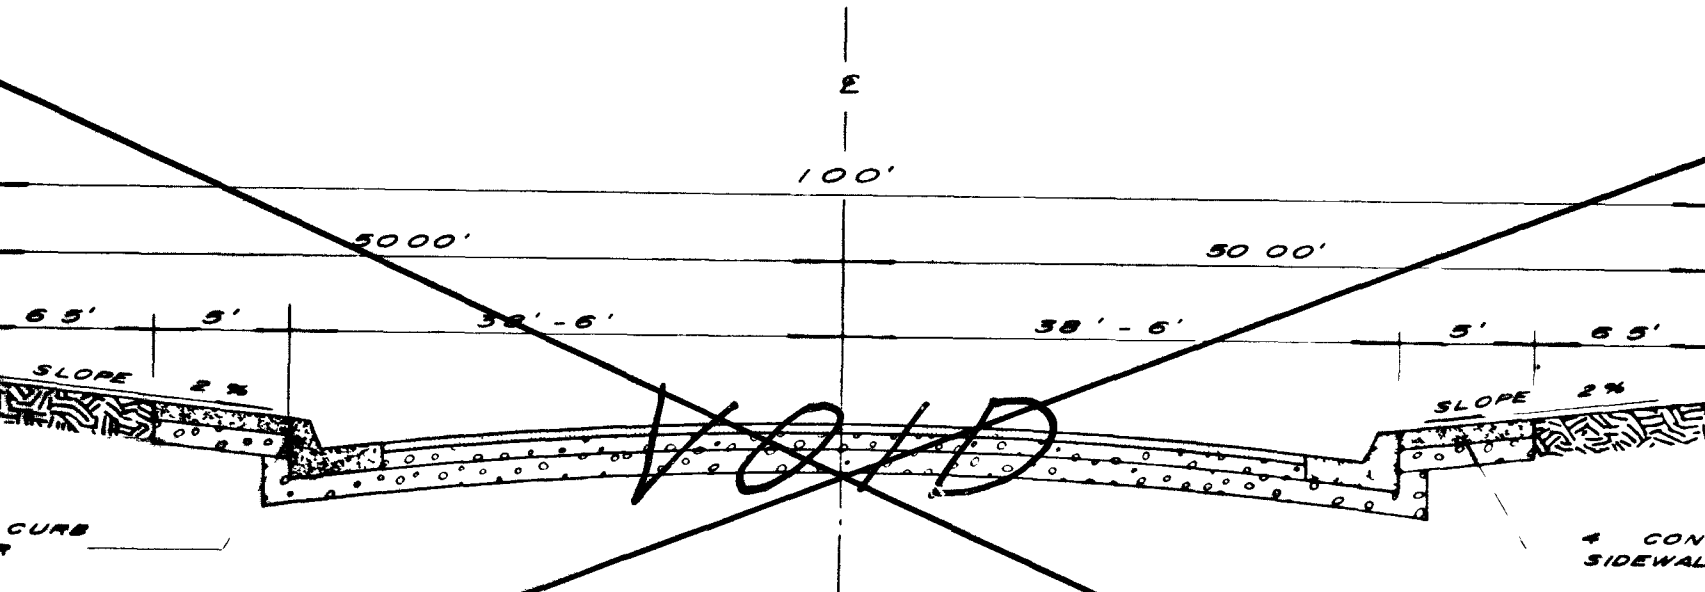


4 TYP SECTION FOR 100' R/W
STD CROWN 0.70'

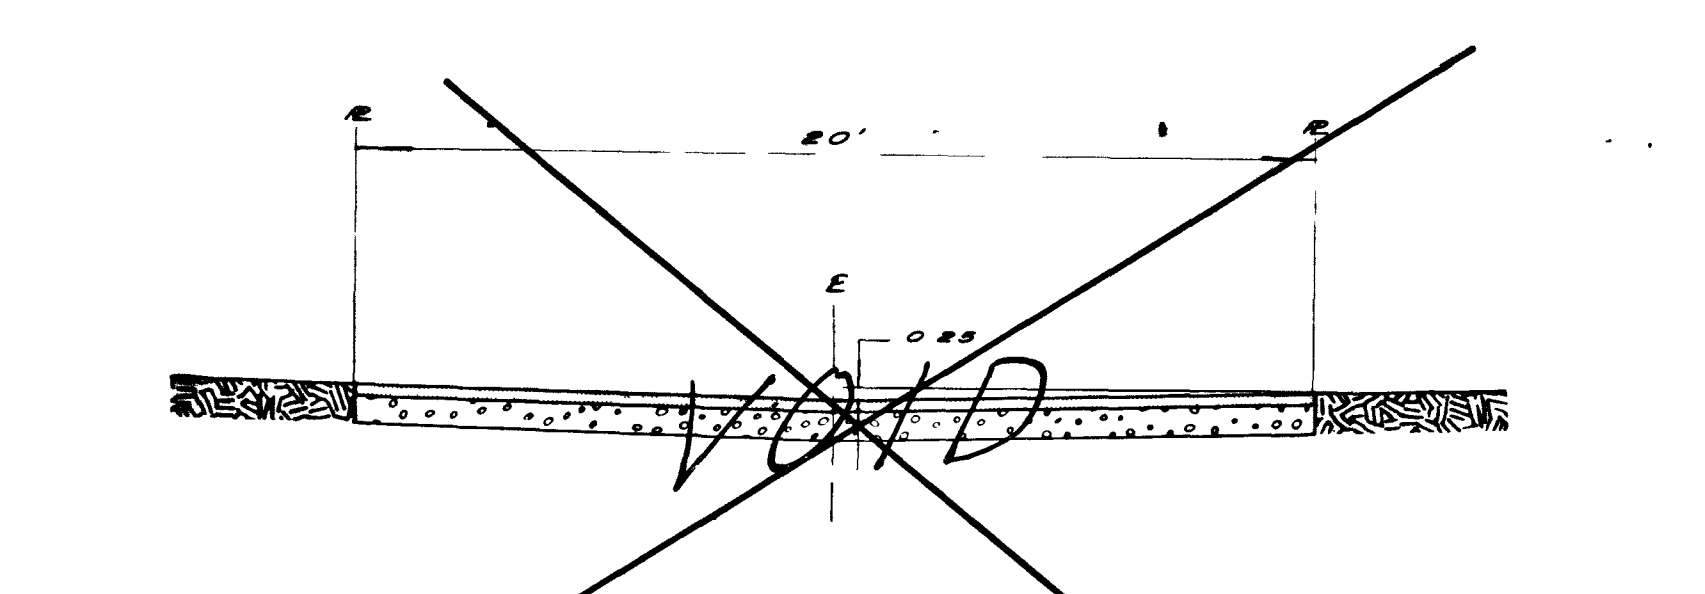


5 TYP ALLEY SECTION
INVERTED CROWN 0.25'

- LEGEND**
- 1 TYPE I GRAVEL BASE
 - 2 TYPE II GRAVEL BASE
 - 3 BITUMINOUS PRIME COAT
 - 4 BITUMINOUS ASPHALTIC CONCRETE
 - 5 BITUMINOUS FOG SEAL COAT
 - 6 BITUMINOUS SEAL COAT & CHIPS
 - 7 SECTION OR DETAIL NUMBER
 - 8 SHEET NUMBER OF SHEET ON WHICH DETAIL IS SHOWN

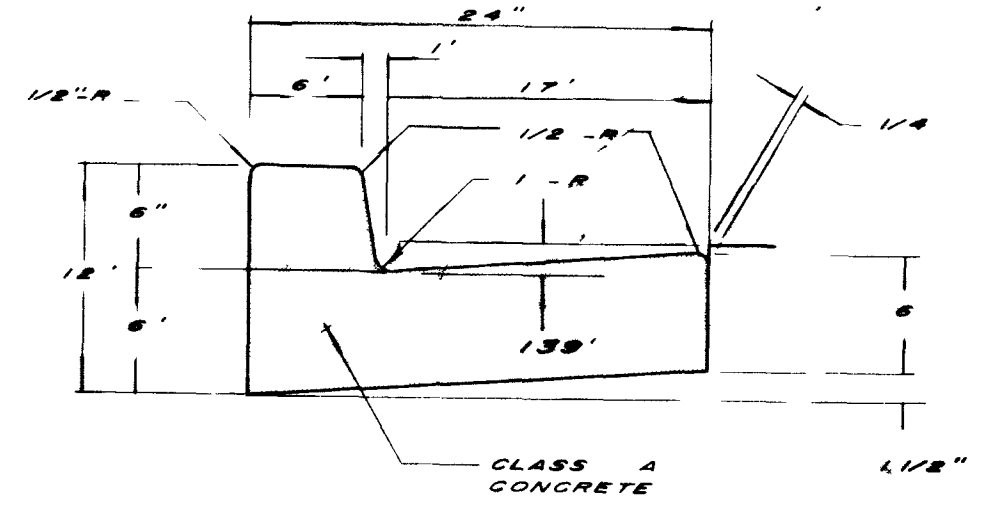

6 "L" TYPE CURB AND GUTTER

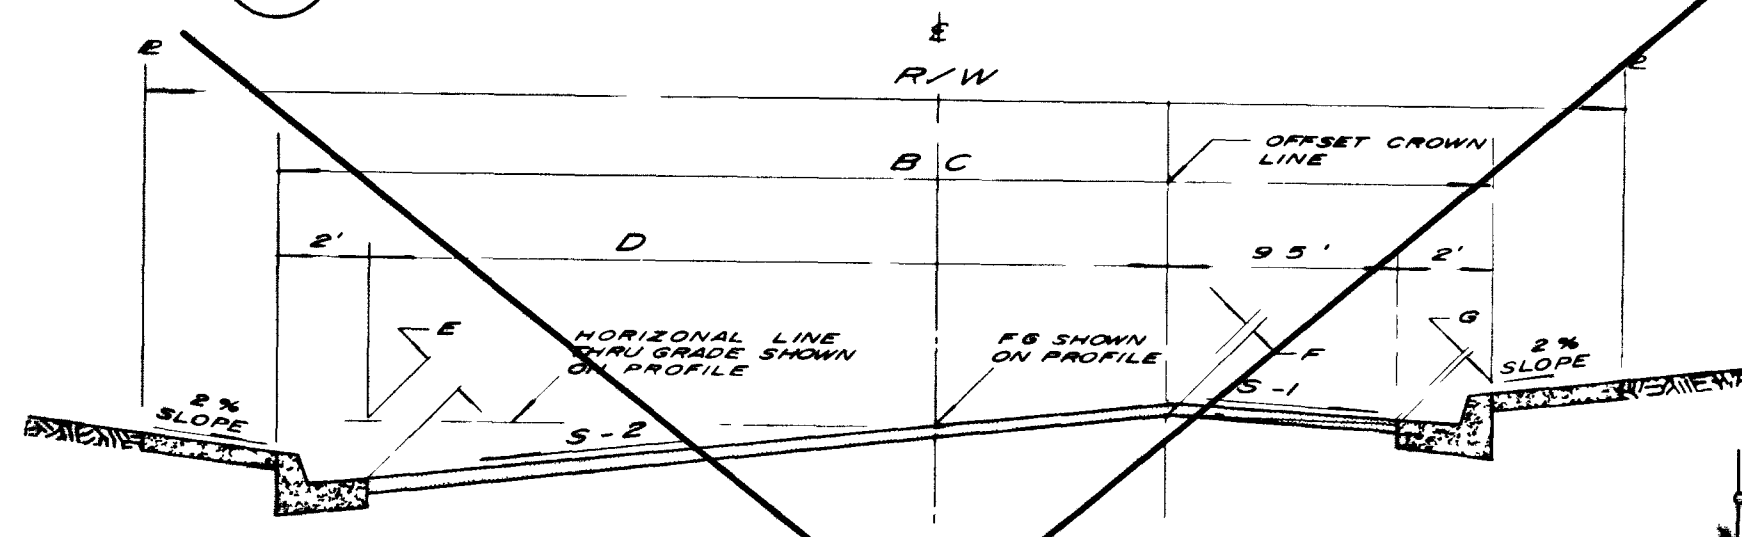


0.40' CROSSFALL

| R/W | BC | D | E | F | G | S-1 | S-2 | CROWN TO LOW FL | CROWN TO HIGH FL |
|-----|-----|-------|--------|--------|--------|----------|----------|-----------------|------------------|
| 31' | 4' | 27.5' | 0.365' | 0.17' | 0.035' | 0.0154FT | 0.0154FT | 0.681' | 0.281' |
| 40' | 20' | 38.5' | 0.348' | 0.200' | 0.038' | 0.0154FT | 0.0154FT | 0.681' | 0.281' |
| 60' | 65' | 51.5' | 0.332' | 0.221' | 0.079' | 0.0154FT | 0.0154FT | 0.681' | 0.281' |


0.60' CROSSFALL

| R/W | BC | D | E | F | G | S-1 | S-2 | CROWN TO LOW FL | CROWN TO HIGH FL |
|-----|-----|------|--------|--------|--------|----------|----------|-----------------|------------------|
| 80' | 65' | 5.5' | 0.321' | 0.303' | 0.161' | 0.0154FT | 0.0154FT | 0.681' | 0.281' |


7 TYP CROSSFALL SECTION FOR R/W

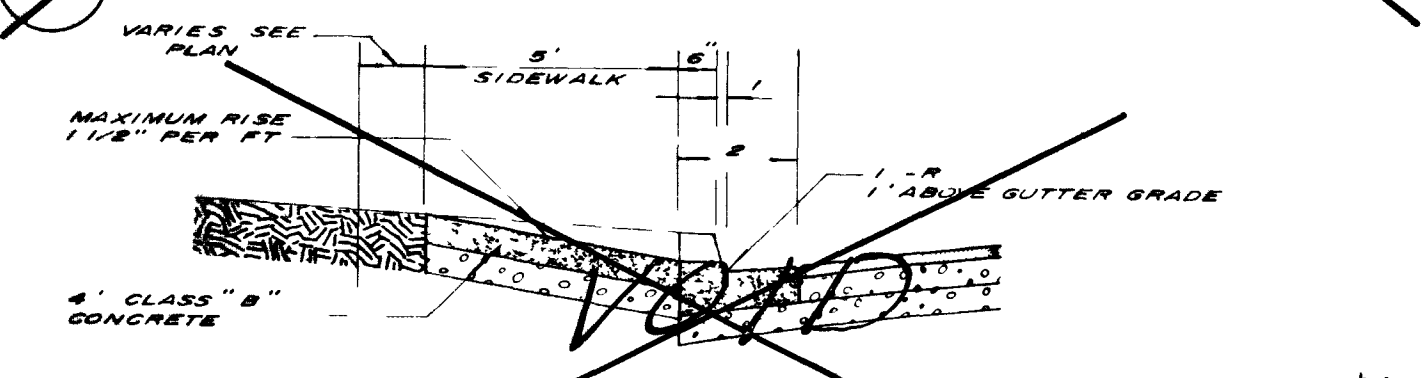


8 ROLL TYPE CURB DETAIL

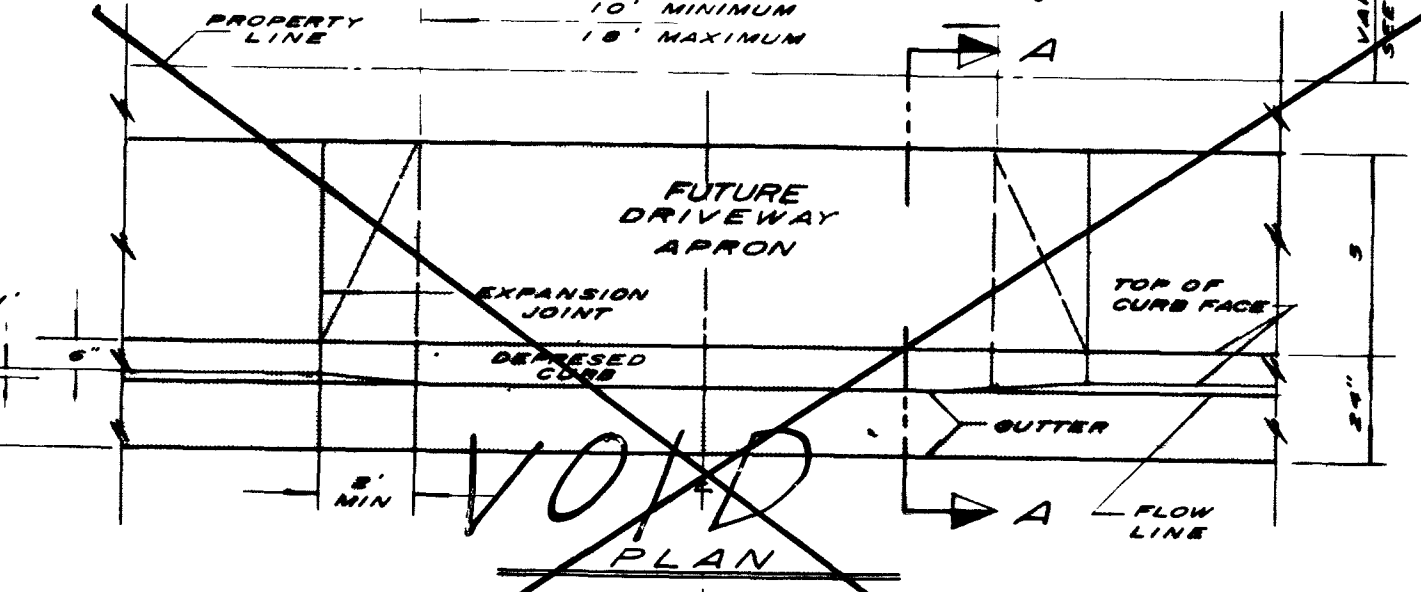


9 SECTION A - A

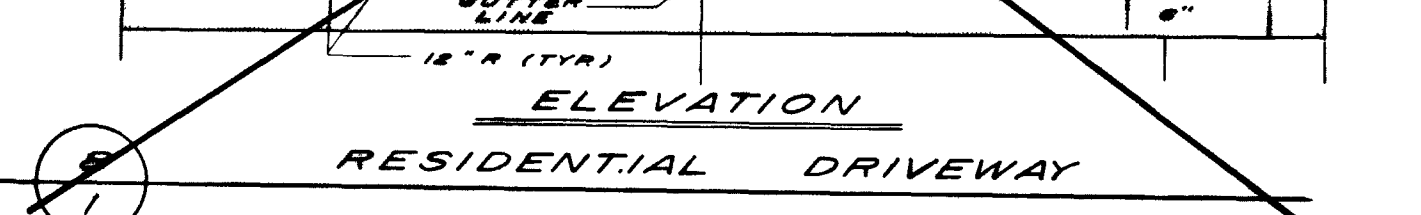


10 ELEVATION RESIDENTIAL DRIVEWAY

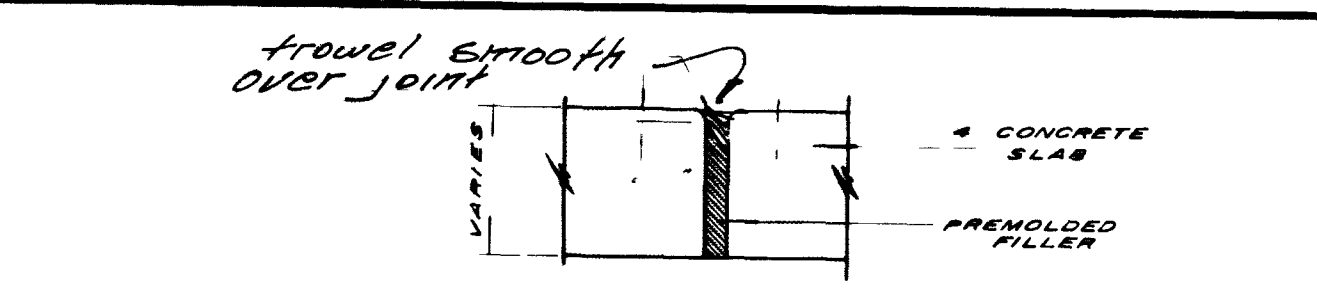


9 EXPANSION JOINT

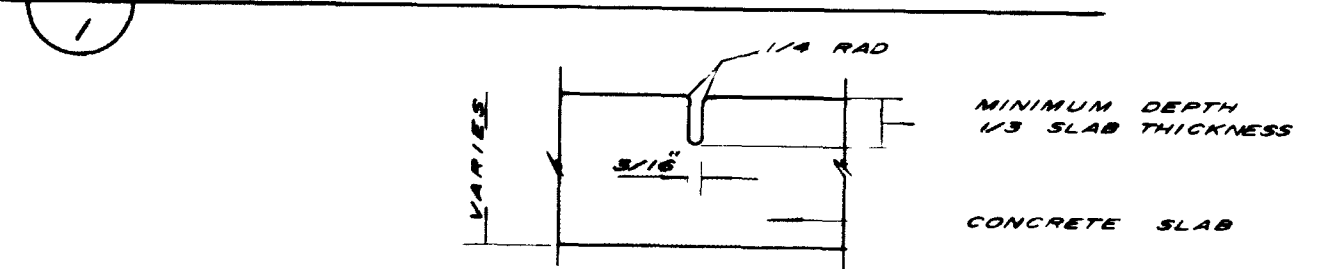


10 WEAKENED PLANE JOINT

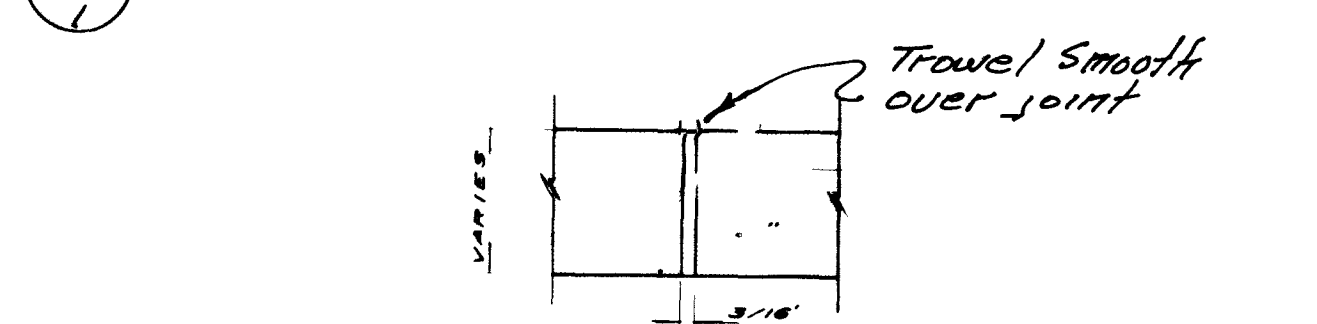

11 FORM PLATE JOINT

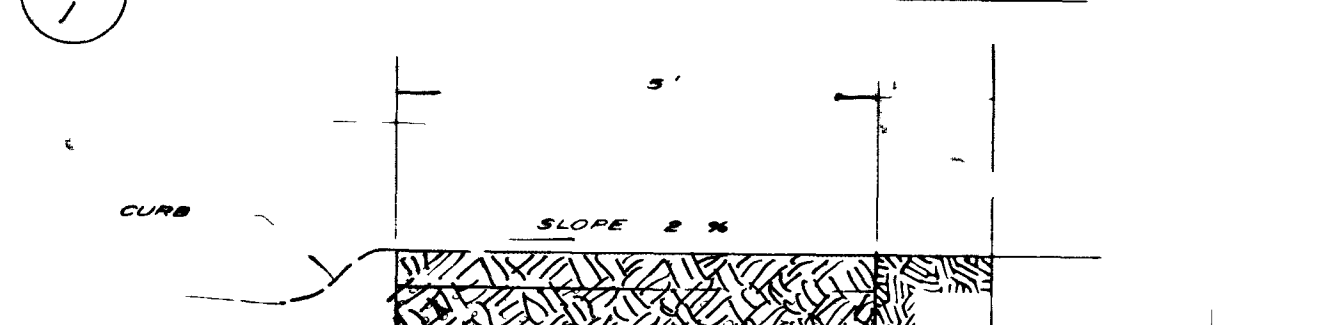


12 SECTION B - B

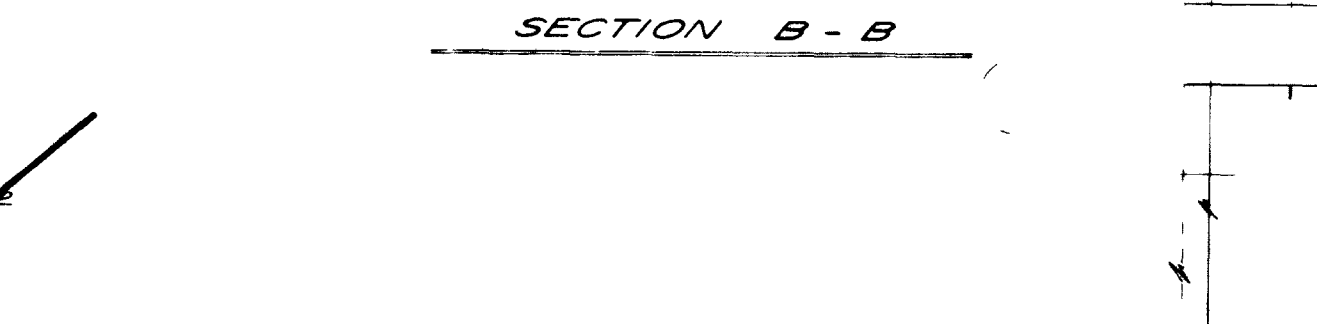


13 VALLEY GUTTER DETAIL




14 CURB RETURN DETAIL

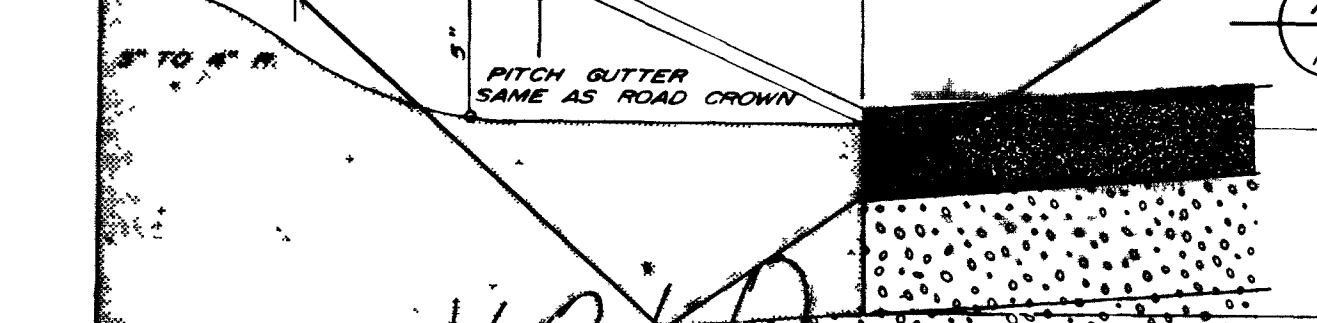


15 CONCRETE SWALE DETAIL

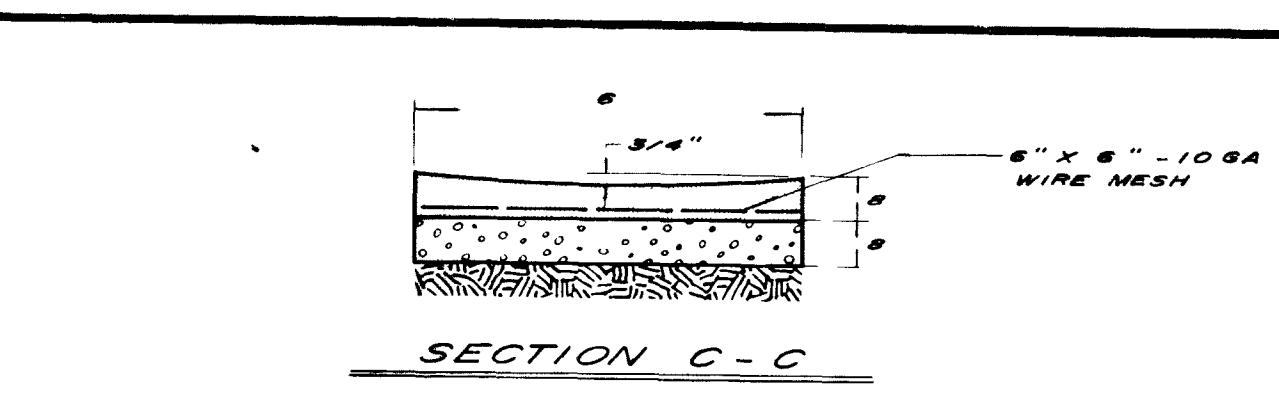


16 SECTION C - C

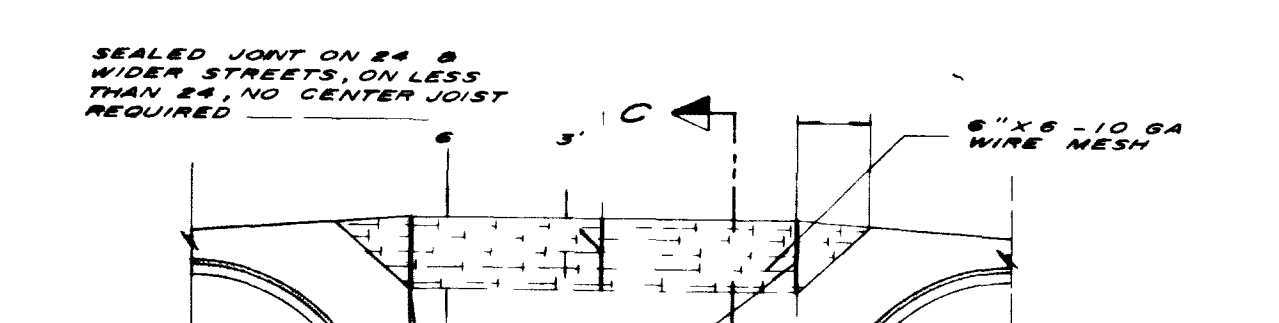

17 SEALED JOINT ON EXP. JOINT

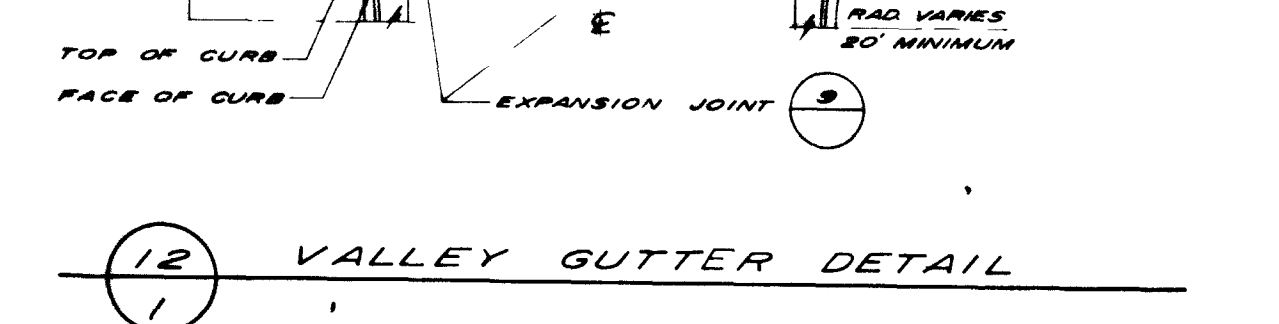


18 VALLEY GUTTER DETAIL

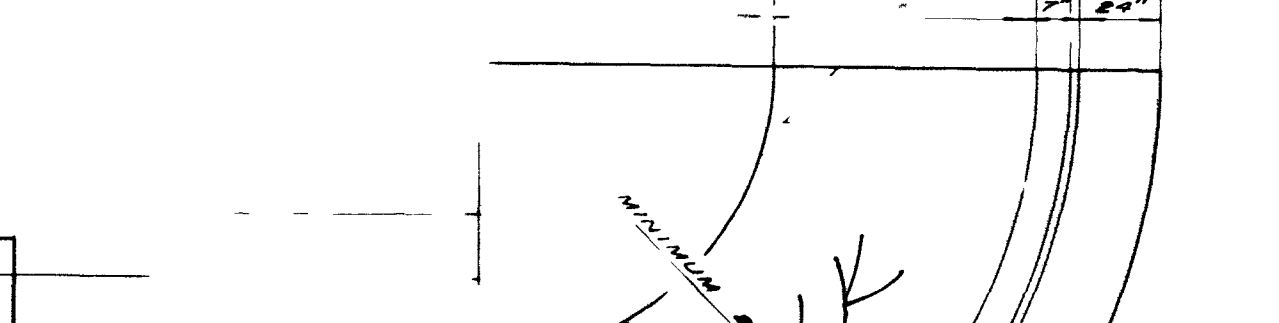


19 CURB RETURN DETAIL




20 CONCRETE SWALE DETAIL

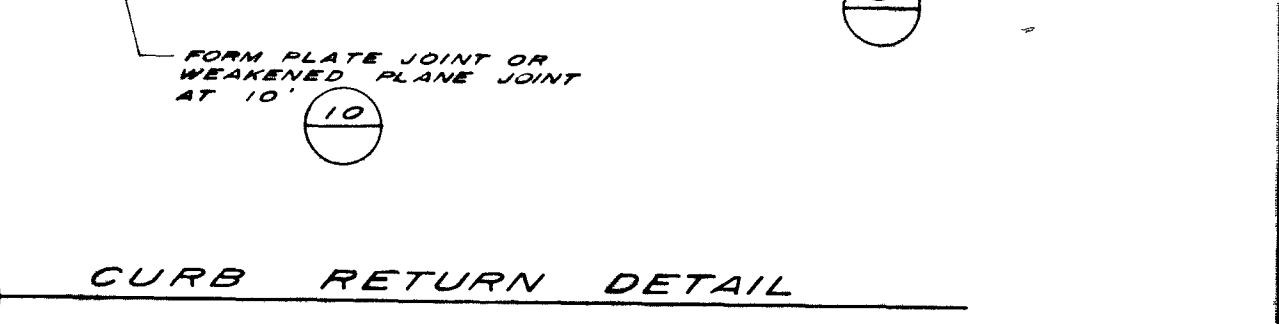



 


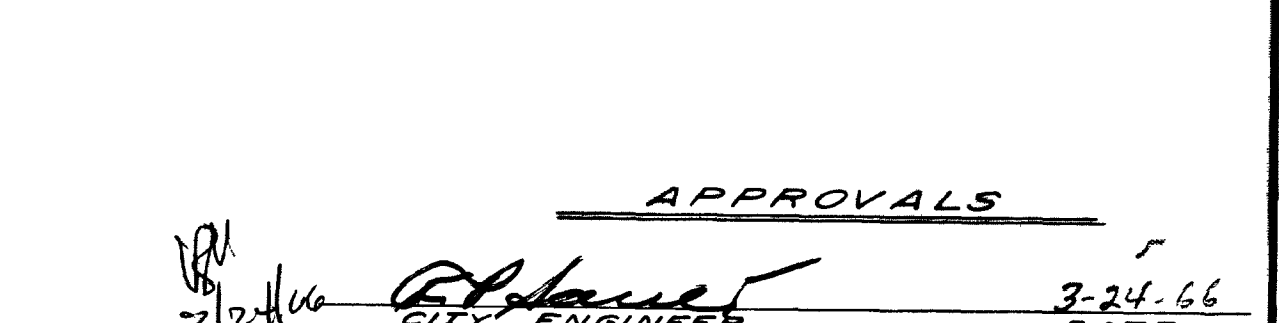


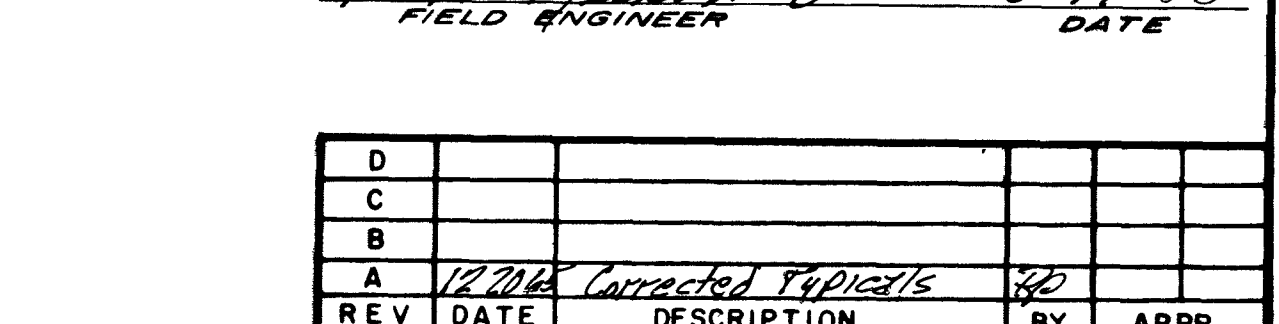


APPROVALS

3/24/66 *[Signature]* CITY ENGINEER 3-24-66 DATE

3-14-66 *[Signature]* FIELD ENGINEER 3-14-66 DATE




| REV | DATE | DESCRIPTION | BY | APPR |
|-----|------|----------------|----|------|

PANCHO NEVADA ESTATES
UNIT NO. 2


TYPICAL
STREET DETAILS
NO SCALE

WESTERN ENGINEERS, INC.
LAS VEGAS, NEVADA

APPROVED *[Signature]* DATE 4-1-66

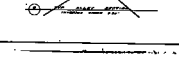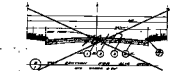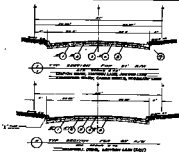


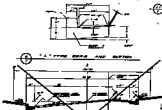

