
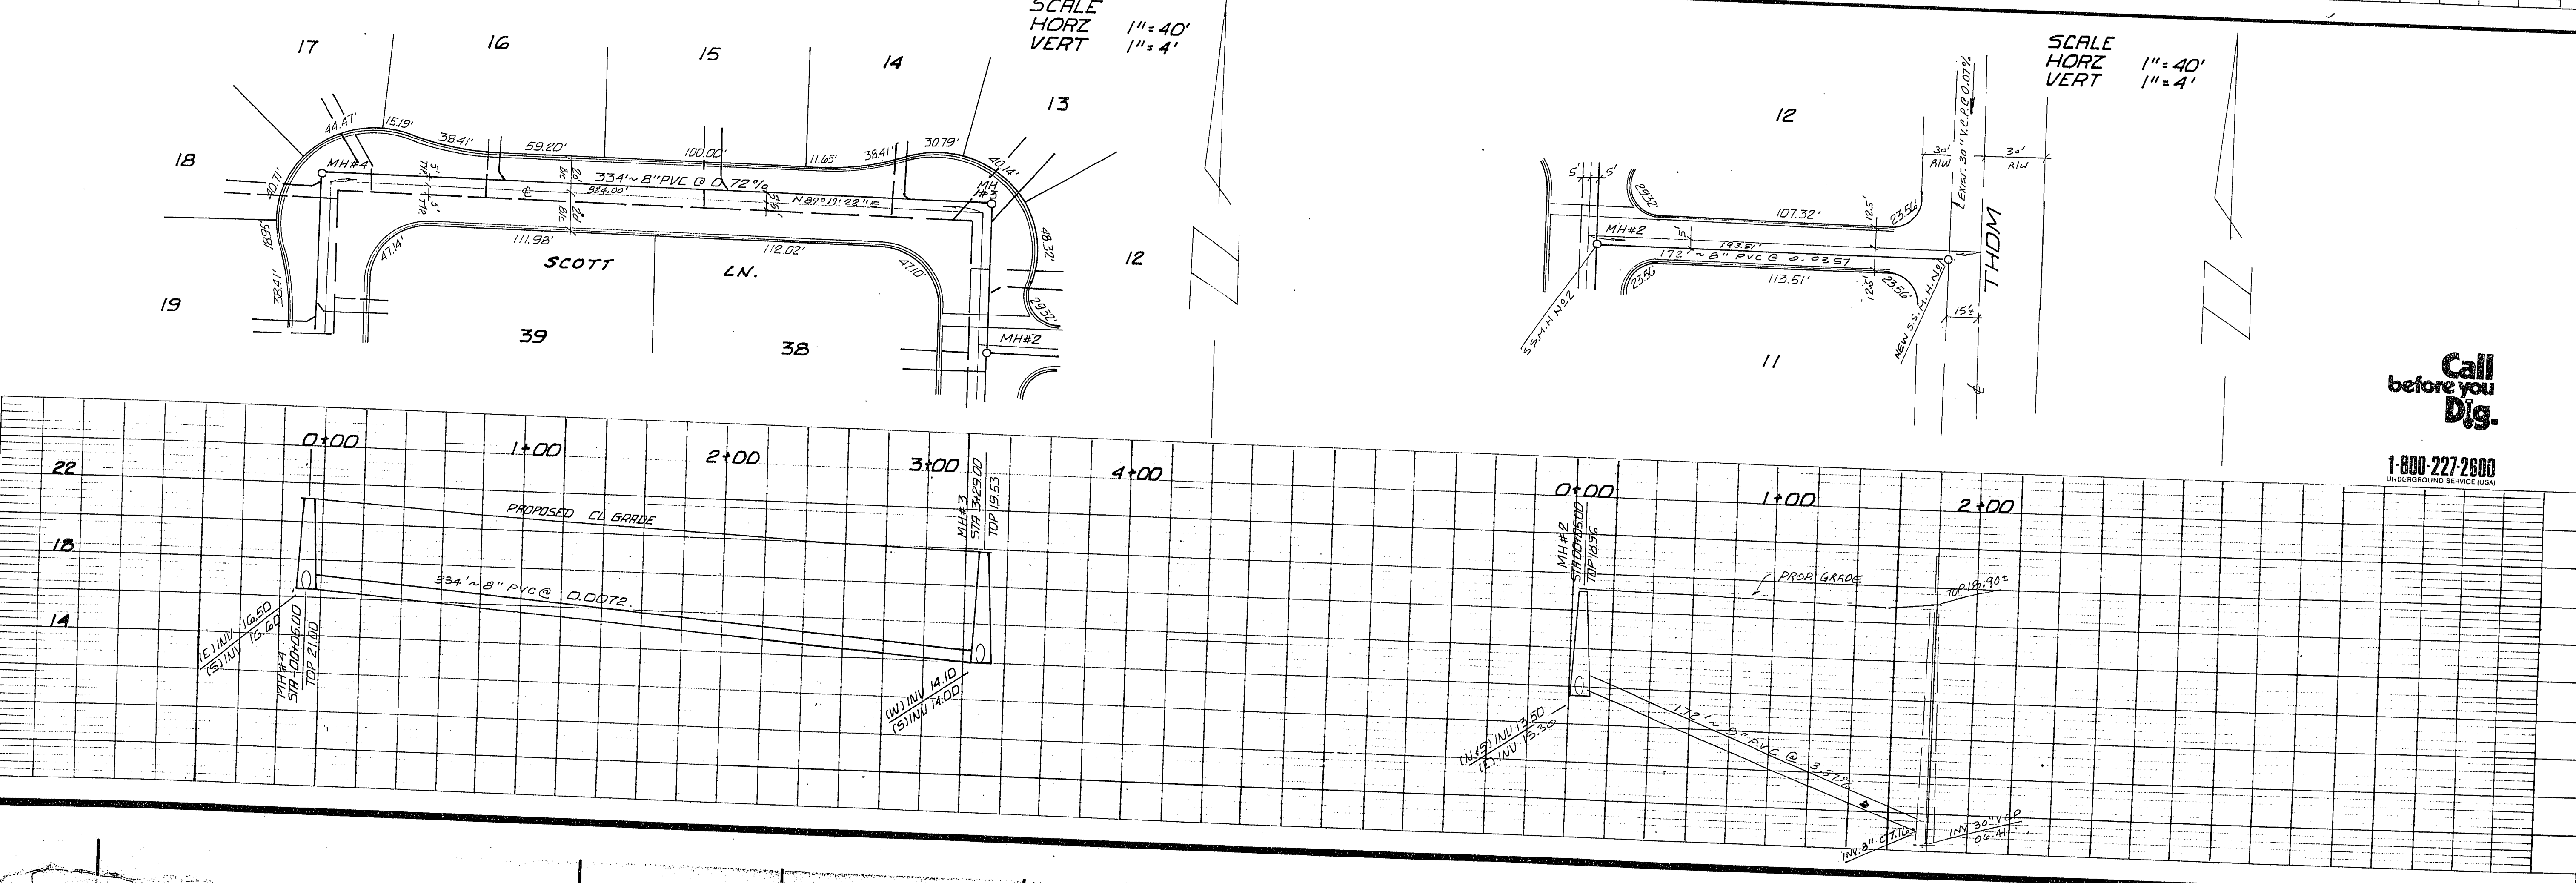


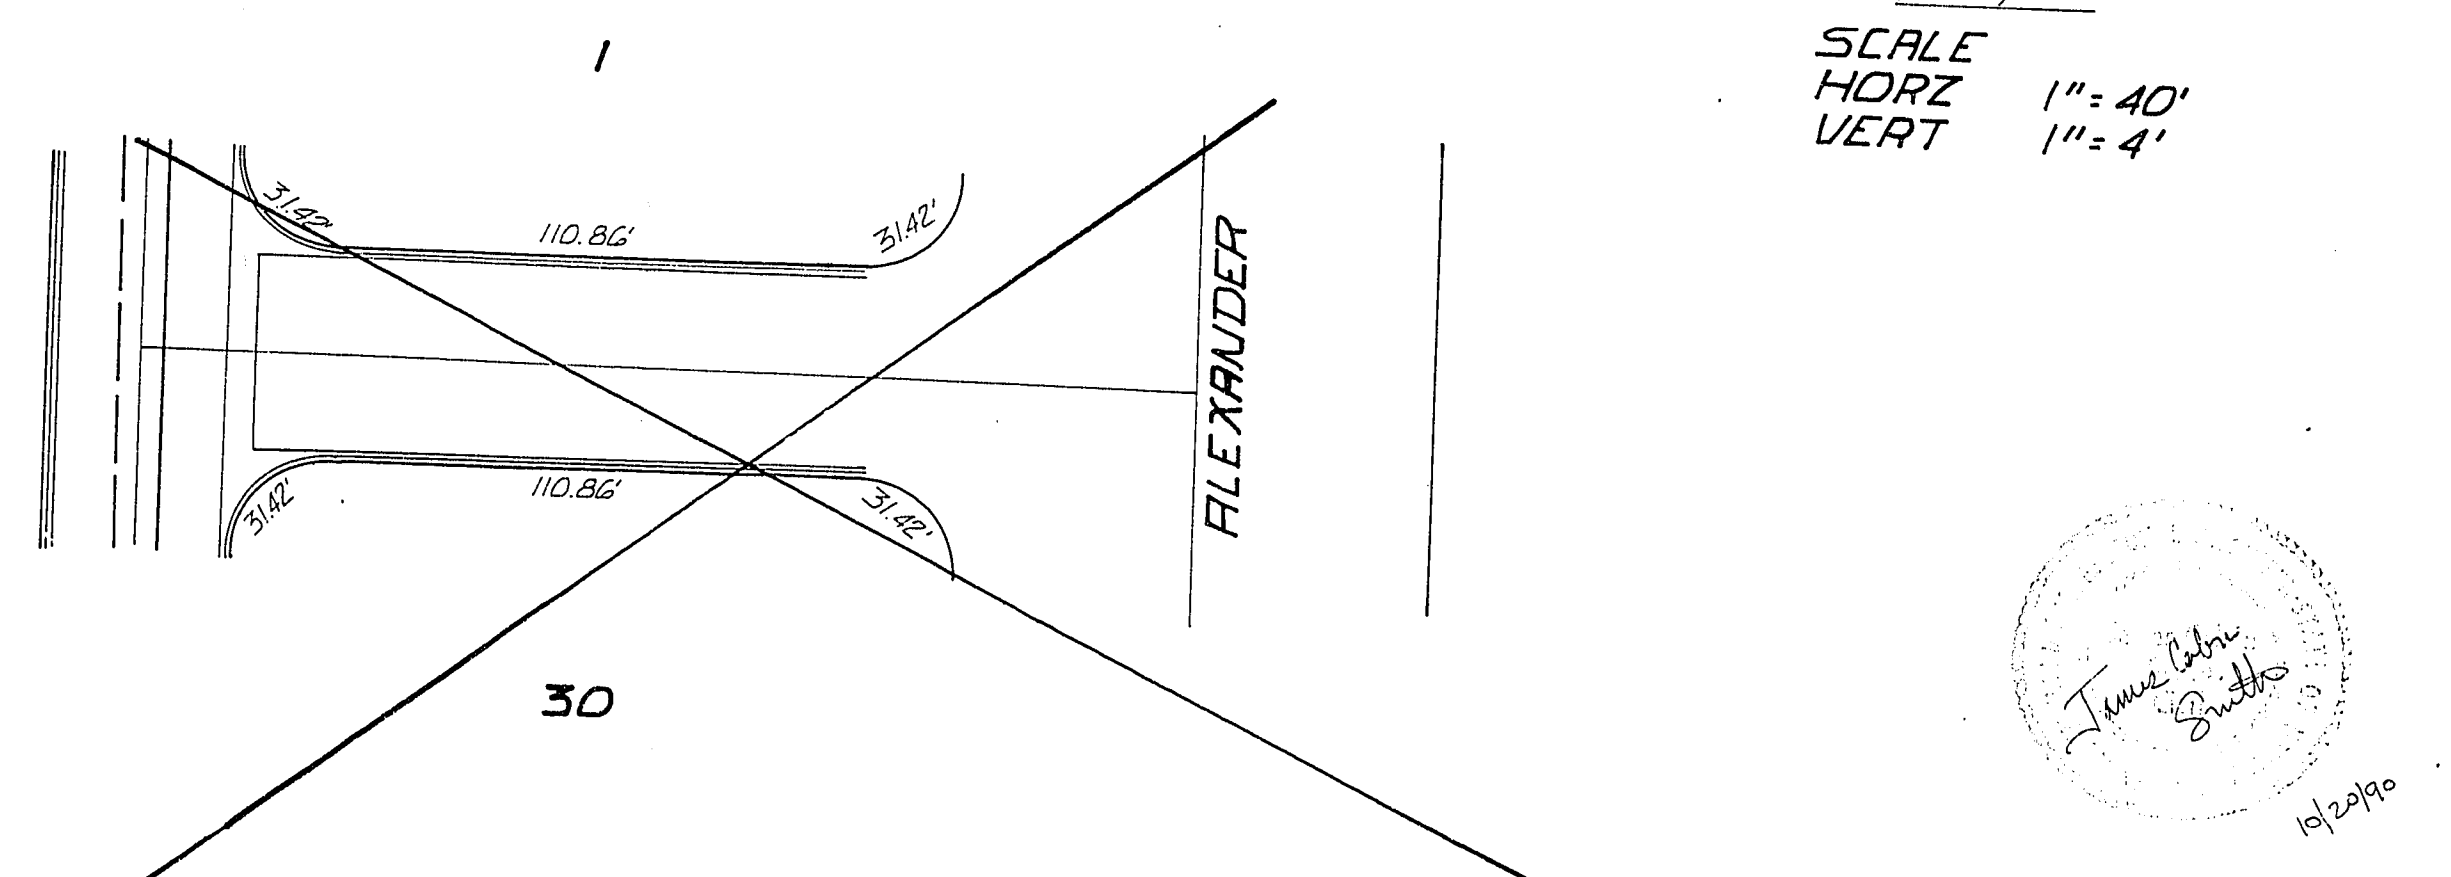

C I V SEWER NOTES

2. CISEL "S" OR "O" IN CURBS, WALKS, SEWER-GAS LATERALS, PASS UNDER THE CURB.
3. POLYVINYL CHLORIDE (PVC) SEWER PIPE SHALL MEET ASTM D 3034 SDR 35 SPECIFICATIONS, AND INSTALLED WITH SAND BEDDING AND BACKFILL OR TYPED 1 GRAVEL.
4. ALL HANDHOLES IN PAVED STREETS 8" OR LARGER, SHALL HAVE CONCRETE COCKARNS.
5. THE SADDLES SHALL BE USED TO CONNECT SEWER LATERALS TO EXISTING MAIN LINES UP TO 24" DIA. SIZES. CONNECTIONS TO 15" OR LARGER MAINS SHALL REQUIRE SPECIAL PROCEDURES.
6. ALL ONSTREET SANITARY SEWER WILL BE PRIVATELY OWNED AND MAINTAINED.

**Call
before you
Dig.**

1-800-227-2600
UNDERGROUND SERVICE (USA)

[illegible]

C. S. A. ENGINEERS & SURVEYORS

**RANCHO SAN MIGUEL SUBDIVISION
SANITARY SEWER**

DRAWN BY: DS
DATE: 10/20/90
SCALE: H 1"=40'
V 1"=4'

SHEET
OF
9 SHEETS