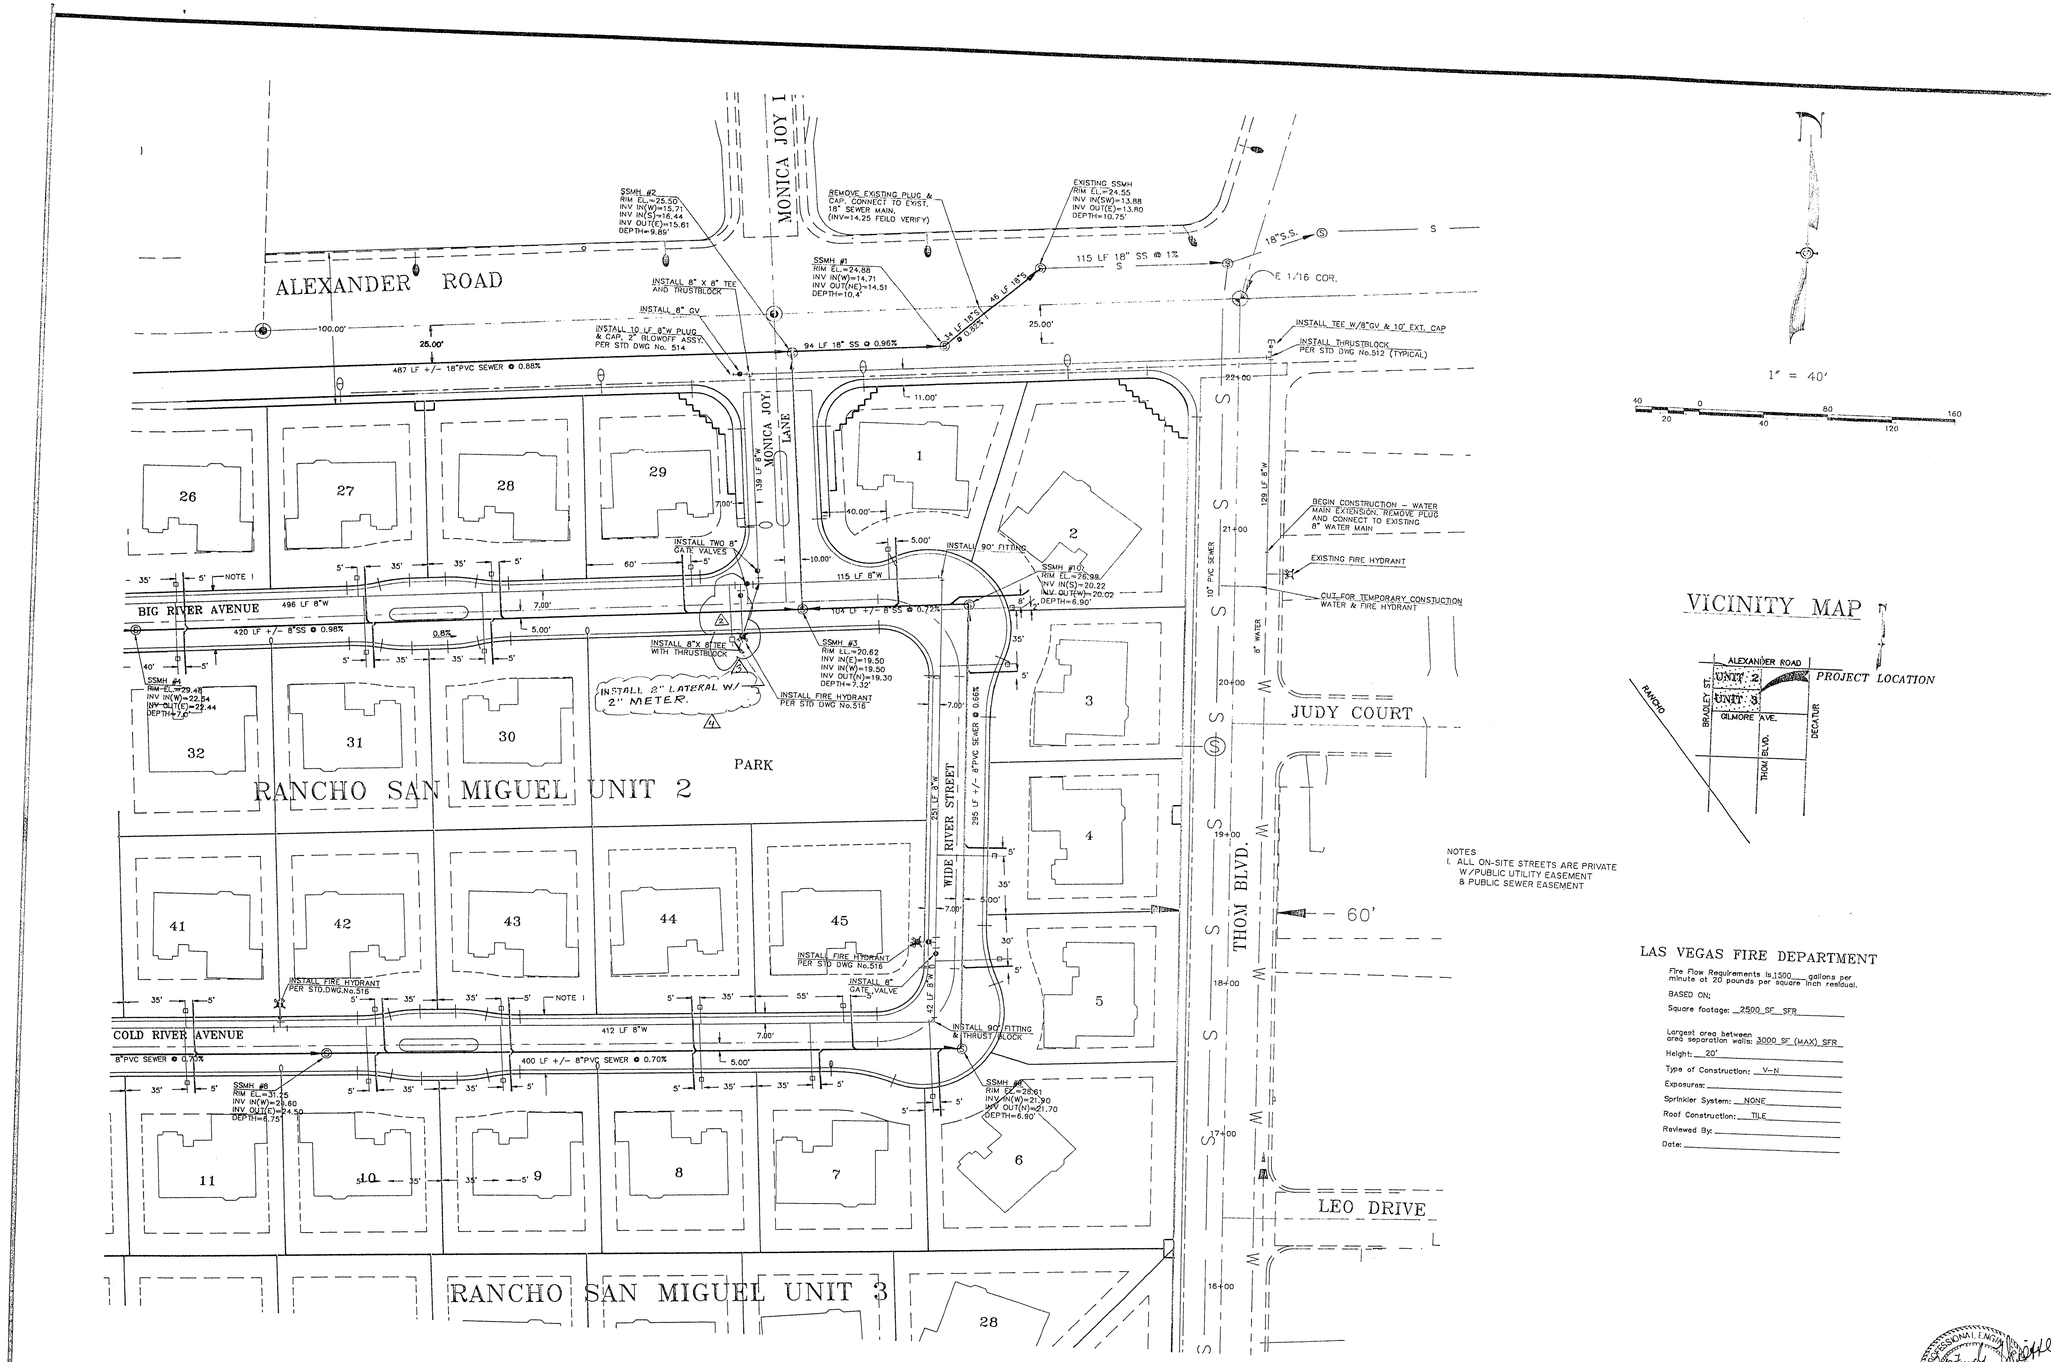

NOTES
1. ALL ON-SITE STREETS ARE PRIVATE W/PUBLIC UTILITY EASEMENT & PUBLIC SEWER EASEMENT

VICINITY MAP

LAS VEGAS FIRE DEPARTMENT

Fire Flow Requirements is 1500 gallons per minute at 20 pounds per square inch residual.

BASED ON:

Square footage: 2500 SF SFR

Largest area between area separation walls: 3000 SF (MAX) SFR

Height: 20'

Type of Construction: V-N

Exposures:

Sprinkler System: NONE

Roof Construction: TILE

Reviewed By:

Date:

SUMMIT™ ENGINEERING CORPORATION
CONSULTING ENGINEERS AND SURVEYORS
3900 SOUTH HIGHLAND, LAS VEGAS, NEVADA 89103
PHONE: (702) 252-3236 FAX: (702) 252-3247

DESIGNED BY: BL/CGT
DRAWN BY: LFG
CHECKED BY: CGT

RANCHO SAN MIGUEL UNIT 2
UTILITY PLAN EAST HALF

LAS VEGAS CLARK COUNTY NEVADA

REV.	DATE	DESCRIPTION	BY	APP'D
1	5/26/94	ADDED NOTE 1	K.K.A.	J.T.A.
2	8/01/94	ADDED 2"METER W/SERV. LATERAL	J.T.A.	[illegible]
3	8/04/94	REVISED METER TO 1"	J.T.A.	[illegible]
4	8/05/94	REVISED METER TO 2"	J.T.A.	[illegible]

SHEET 9 OF 15

SCALE
HORIZ. 1"=40'
VERT. NONE
JOB NO. 70648

REGISTERED PROFESSIONAL ENGINEER
JESSE
CIVIL
No. 6159
3/30/94

3074-4/73-2