



BACKFILL SHALL BE ANY EXCAVATED IMPORTED OR TRANSPORTED MATERIAL WHICH IS FREE FROM LARGE LUMPS GREATER THAN 3\"/>

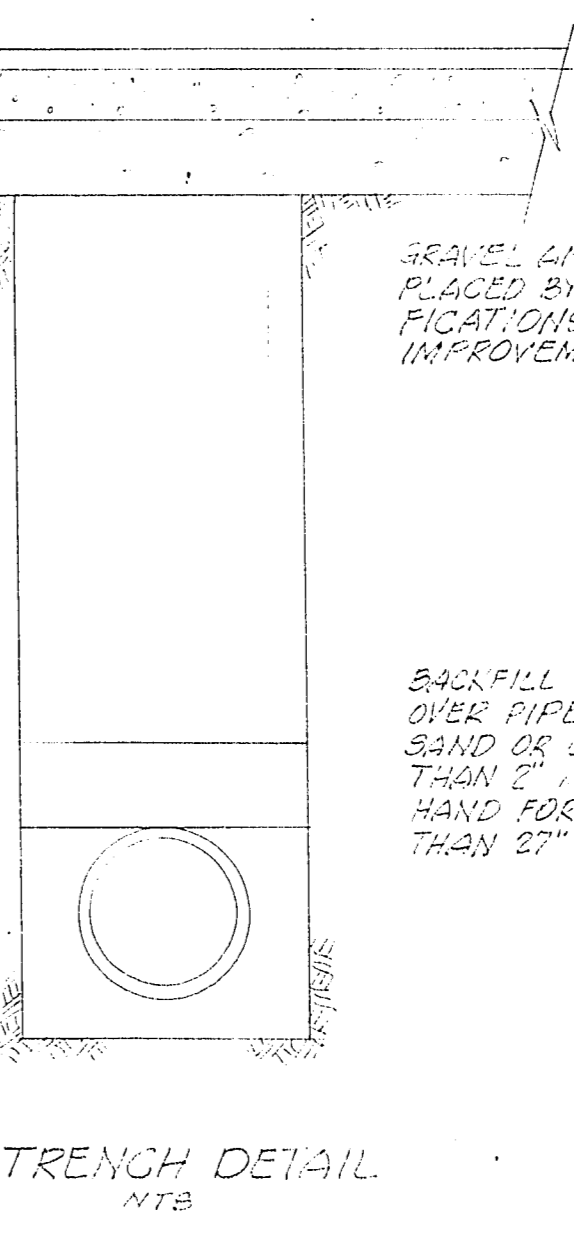

GRAVEL AND PAVEMENT TO BE PLACED BY OTHERS TO SPECIFICATIONS SHOWN ON IMPROVEMENT PLANS.

BACKFILL FOR 6\"/>

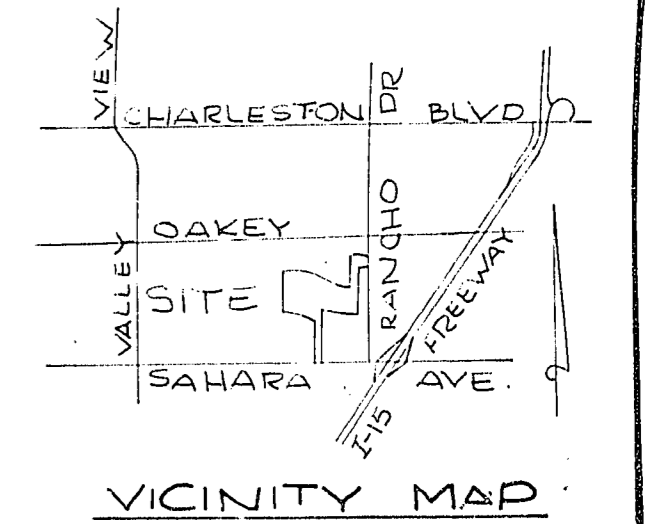

QUANTITY ESTIMATES

STANDARD MANHOLE	3 EA.
8\"/>	
4\"/>	
4\"/>	

APPROVED

CITY ENGINEER DATE

CLV SANITATION ENGINEER DATE

CLV FIELD OPERATIONS ENGINEER DATE

CLV QUALITY CONTROL ENGINEER DATE

SUBMITTED BY

JAMES L. MACFARLANE P.E. DATE 11/15/79
NEV. CERT. N° 3572

- GENERAL NOTES:**
- HOUSE SERVICES SHALL COMPLY WITH THE BUILDING CODE AS THE SEPARATION DISTANCE.
 - ALL HOUSES TO BE SERVED INDIVIDUALLY AT THE LOCATION SET OF THE UNIFORM PLUMBING CODE.
 - CONTRACTOR SHALL FURNISH THE ENGINEER WITH AN OBJECT DRAWINGS SHOWING THE EXACT LOCATION OF ALL HOUSE CONNECTIONS.
 - CONCRETE COLLARS TO BE CONSTRUCTED AT ALL MANHOLES AND WATER VALVES.
 - CHISEL S OR G WHEREVER SEEN OR HEARD TO BE BASE UNDER CURB.



VTN CONSULTING ENGINEERS • PLANNERS
2109 PINEHURST BLVD. LAS VEGAS, NEVADA 89105
702-735-8127

RANCHO SERENO - UNIT 3

MASTER SEWER PLAN

SCALE: 1" = 40'	WO. NO. 2547-3	DATE 11/15/79	SHEET	OF
HORIZ:	DES.	REV.	4	9
VERT:	CHK.	REV.		

Revised lots & laterals - 9-24-80 RJH

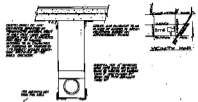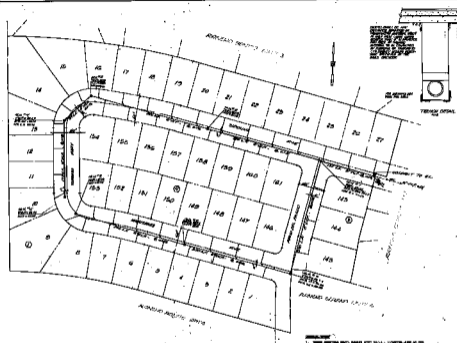

QUANTITY ESTIMATES




- NOTES:**









