



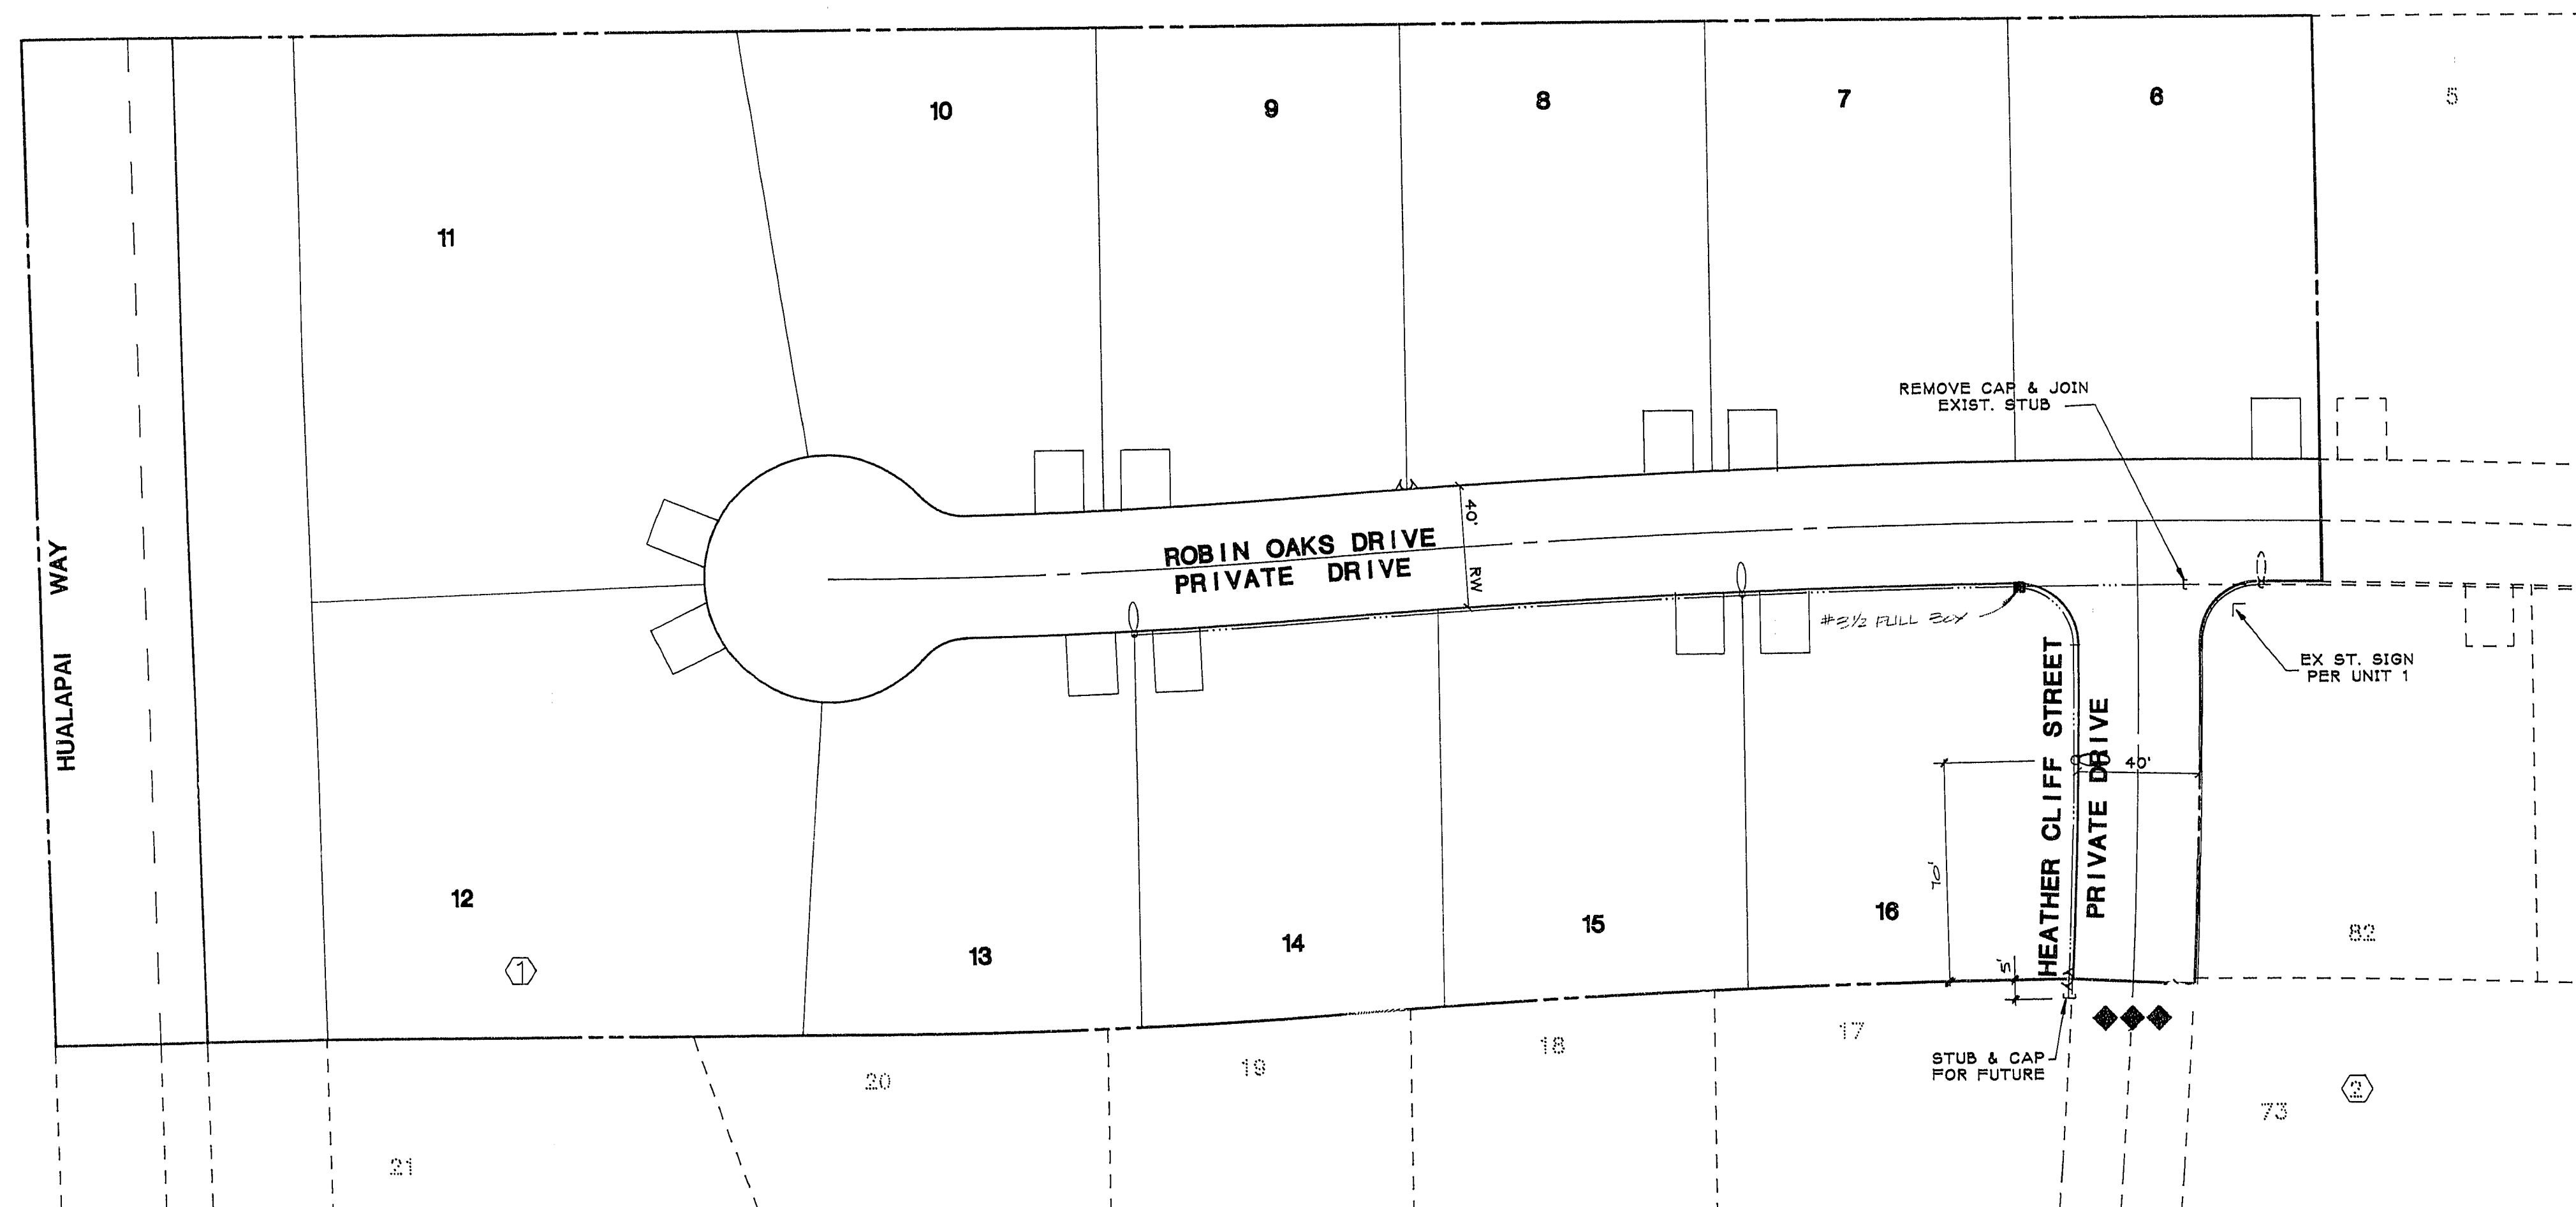

CLARK COUNTY BENCHMARK NO. C10SW04
RAILROAD SPIKE AT INTERSECTION OF SAHARA
& DURANGO.
CC ELEVATION = 2659.63
CLV ELEVATION = 2658.59

EXISTING UTILITY LOCATIONS SHOWN HEREIN ARE APPROXIMATE ONLY. IT SHALL BE THE CONTRACTOR'S RESPONSIBILITY TO DETERMINE THE EXACT VERTICAL AND HORIZONTAL LOCATION OF ALL EXISTING UNDERGROUND UTILITIES PRIOR TO COMMENCING CONSTRUCTION. NO REPRESENTATION IS MADE THAT ALL EXISTING UTILITIES ARE SHOWN HEREON. THE ENGINEER ASSUMES NO RESPONSIBILITY FOR UTILITIES NOT SHOWN OR UTILITIES NOT SHOWN IN THEIR PROPER LOCATION.

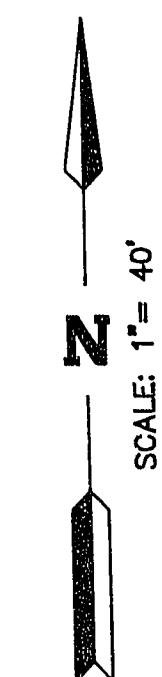

	100 WATT H.P.S LUMINAIRE	3 EA
•	11 GA. LIGHT STANDARD	2 EA
-----	1 1/4" PVC CONDUIT	492 LF
■	3 1/2" PULL BOX	1 EA.

ALL STREET LIGHTING INSTALLATIONS SHALL CONFORM TO THE LATEST ISSUE OF THE STANDARD DETAIL AND SPECIFICATIONS OF THE CITY OF LAS VEGAS, AND SHALL ALSO CONFORM TO THE UNIFORM STANDARD SPECIFICATIONS FOR PUBLIC WORKS' CONSTRUCTION OF OFF-SITE IMPROVEMENTS, CLARK COUNTY AREA, LATEST EDITION, UNLESS OTHERWISE NOTED. ALL HAND HOLE COVERS MUST BE INSTALLED, POLE CAPS POURED, AND PULL BOX LIDS BOLTED DOWN PRIOR TO ENERGIZING CIRCUIT. ALL WIRE MUST HAVE THW INSULATIONS.

1-800-227-2600
UNDERGROUND SERVICE (USA)

[illegible]


ESI ENGINEERS AND
 SURVEYORS INC.
 PLANNERS • CONSULTING ENGINEERS • SURVEYORS
 7010 B W. CHARLESTON BLVD. • LAS VEGAS, NEVADA 89117 • 702-791-6841
 FAX 702-791-6843
 REGISTERED PROFESSIONAL ENGINEERS
 No. 03383
 12-8-93
 SUBMITTED BY:

MASTER STREET LIGHT PLAN

REGENCY AT THE LAKES UNIT #2A

W.O. # : A795

BY : TB

DATE : JUNE 1993

SCALE : 1" = 40'

SHEET

16 7
OF 7 SHEETS

207 Y-4111-2A