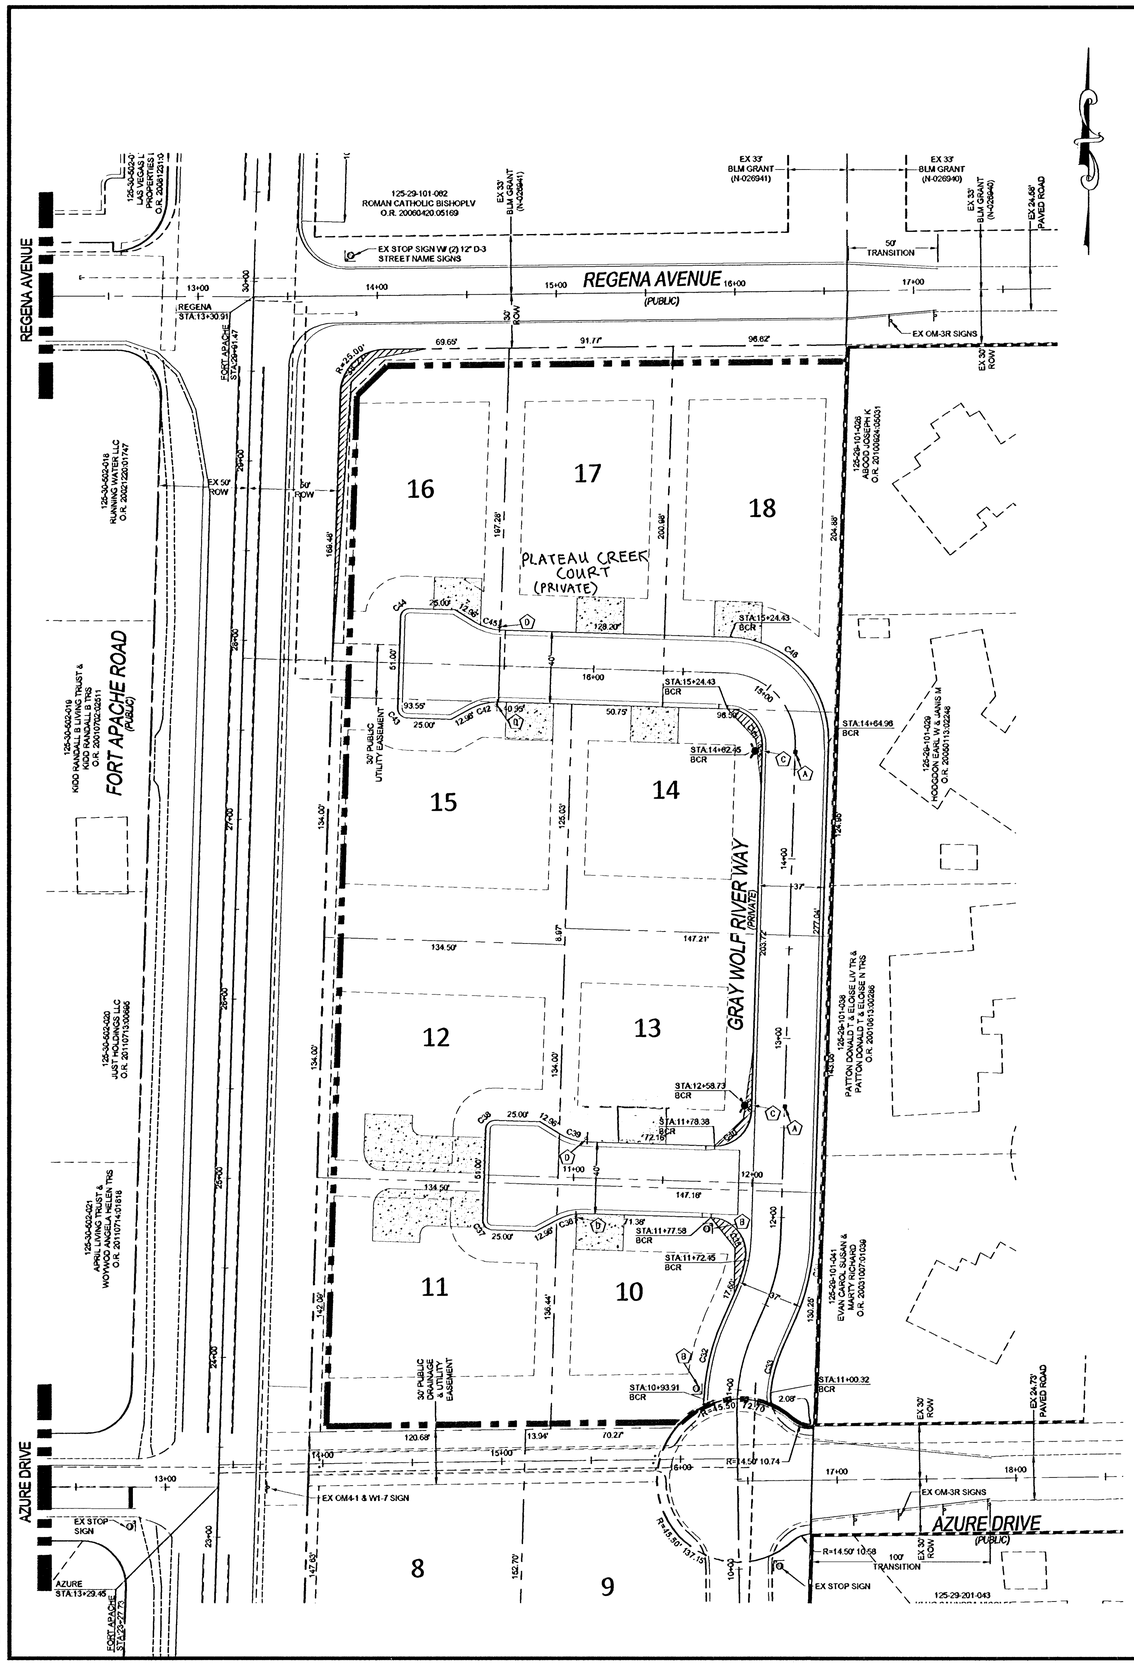

TRAFFIC CONSTRUCTION NOTES

(A) BLUE COLORED REFLECTIVE RAISED PAVEMENT MARKERS
(B) INSTALL 30" R1-1 "STOP" SIGN W/ (2) 9" D-3 "STREET NAME" SIGNS
(C) PAINT CURB RED 15' EACH SIDE OF HYDRANT (CURB LENGTH PERMITTING)
(D) INSTALL "NO PARKING BEYOND THIS POINT" SIGN (USD #212.1.S1)

TRAFFIC SIGN LEGEND

STOP — R1-1
NO PARKING BEYOND THIS POINT — PER USD#212.1.S1
STREET NAME — D-3

SIGHT VISIBILITY ZONE

NO STRUCTURE, VEGETATION, OR OBJECT OF ANY KIND IS PERMITTED OVER TWENTY FOUR (24) INCHES IN HEIGHT (MEASURED FORM THE TOP OF THE ADJACENT CURB IF CURB EXISTS) WITHIN THE SIGHT VISIBILITY ZONES.

LINE AND CURVE TABLE

Curve Table

Curve #	Length	Radius	Delta
C32	45.46	120.00	21.707
C33	26.20	83.00	18.087
C34	45.68	117.00	22.360
C35	34.68	20.00	99.293
C36	15.71	30.00	30.000
C37	7.85	5.00	90.000
C38	7.85	5.00	90.000
C39	15.71	30.00	30.000
C40	31.41	20.00	89.990
C41	31.42	20.00	90.010
C42	15.71	30.00	30.000
C43	7.85	5.00	90.000
C44	7.85	5.00	90.000
C45	15.71	30.00	30.000
C46	89.55	57.00	90.010

KEY MAP

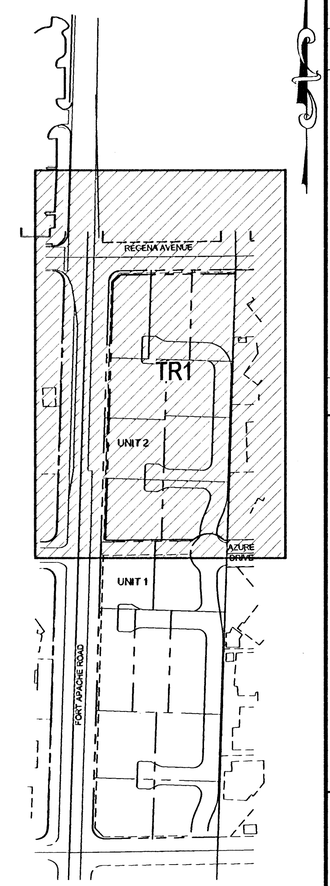

SCALE

40 0 20 40 80 160
(IN FEET)
1 inch = 40 ft.

LEGAL DESCRIPTION

THE WEST HALF (W ½) OF THE SOUTHWEST QUARTER (SW ¼) OF THE NORTHWEST QUARTER (NW ¼) OF THE NORTHWEST QUARTER (NW ¼) OF SECTION 29, TOWNSHIP 19 SOUTH, RANGE 60 EAST, M.D.M., CLARK COUNTY, NEVADA AND THE WEST HALF (W ½) OF THE NORTHWEST QUARTER (NW ¼) OF THE SOUTHWEST QUARTER (SW ¼) OF THE NORTHWEST QUARTER (NW ¼) OF SECTION 29, TOWNSHIP 19 SOUTH, RANGE 60 EAST, M.D.M., CLARK COUNTY, NEVADA.

BASIS OF BEARINGS

NORTH 01°14'05" EAST BEING THE WEST LINE OF THE SOUTHWEST QUARTER (SW ¼) OF THE NORTHWEST QUARTER (NW ¼) OF SECTION 29, TOWNSHIP 19 SOUTH, RANGE 60 EAST, M.D.M., CLARK COUNTY, NEVADA AS SHOWN ON THAT CERTAIN MAP ON FILE IN THE OFFICE OF THE CLARK COUNTY, NEVADA RECORDER IN FILE 108, PAGE 82 OF SURVEYS.

BENCHMARK

CC BM NO. 8LV9029W4 - CITY OF LAS VEGAS PIN AND ROUND PLATE IN CONCRETE PAD, SOUTHEAST CORNER OF TROPICAL PKWY. AND FORT APACHE RD.

ELEVATION 789.682M/2590.82FT (NAVD 88 DATUM)

Call Before You Dig
AVOID CUTTING UNDERGROUND UTILITY LINES. IT'S COSTLY.
CALL 811 or 1-800-227-2600
AND
CLARK COUNTY TRAFFIC OPERATIONS 1-800-455-7544

AVOID HITTING OVERHEAD POWER LINES. IT'S COSTLY.
CALL BEFORE YOU DO OVERHEAD
1-702-227-2929

AVOID HITTING UNDERGROUND TRAFFIC SIGNAL SYSTEMS AND STREET LIGHT SYSTEM CONDUITS. IT'S COSTLY.
UnderGround — Call before you
1-702-455-7511
CLARK COUNTY TRAFFIC OPERATIONS
1-702-229-6611
LAS VEGAS AREA COMPUTERIZED TRAFFIC SYSTEM

Clark County Public Works
ACCEPTED
BY: _____ DATE:
ACCEPTANCE OF THESE PLANS SHALL NOT BE CONSTRUEDTO BE A PERMIT FOR, OR AN APPROVAL OF ANY VIOLATION OF STATE, COUNTY OR FEDERAL LAW SPECIFICATIONS OR THE MANUAL OF UNIFORM TRAFFIC CONTROL DEVICES

NO.	DESCRIPTION	SHTS.	APPR.	DATE

REVISIONS

D R HORTON
330 CAROUSEL PKWY
HENDERSON, NV 89014
(702) 638-3600 FAX: (800) 908-4601

TANEY ENGINEERING
6030 S. JONES BLVD STE# 100
LAS VEGAS, NV 89118
(702) 362-8844 FAX: (702) 362-6233

REGENA AND FORT APACHE
UNIT 2
A RESIDENTIAL SUBDIVISION

TRAFFIC AND HORIZONTAL CONTROL PLAN

ROBERT D. CUNNINGHAM Exp. 12-31-12 CIVIL No. 15735 — REGISTERED PROFESSIONAL ENGINEER — STATE OF NEVADA
6/29/12
ENGINEER'S SEAL

DATE:	6/29/2012
SCALE:	1"=40'
JOB NO:	DRH-11-024
DESIGNED BY:	MC/SF
CHECKED BY:	RDC
SHEET NAME:	TR1
SHEET:	09 OF 9

HTE#12-16980
CC (CLV SEWER)

45289 3021/1057-2.

FILE NAME: 09 TR1.DWG