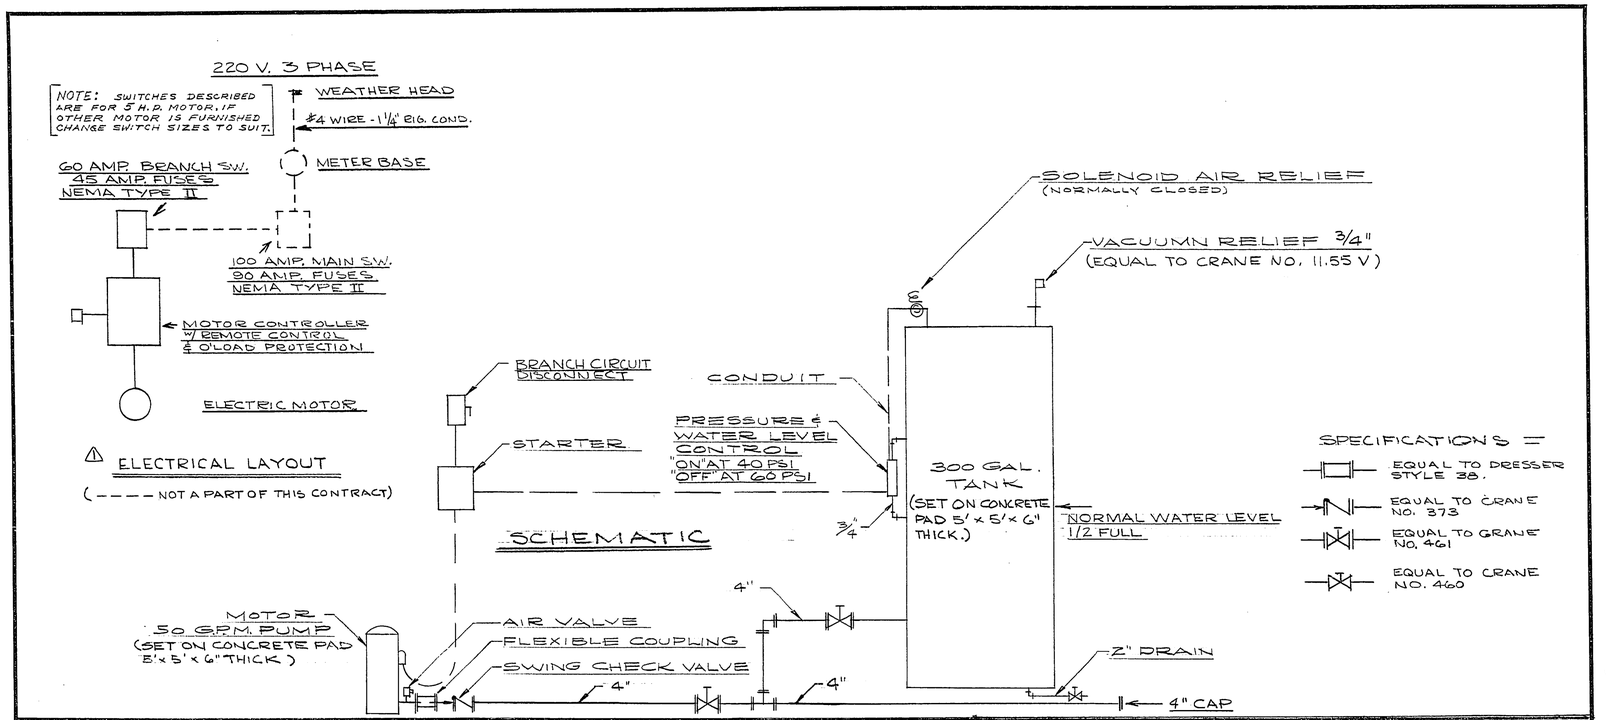

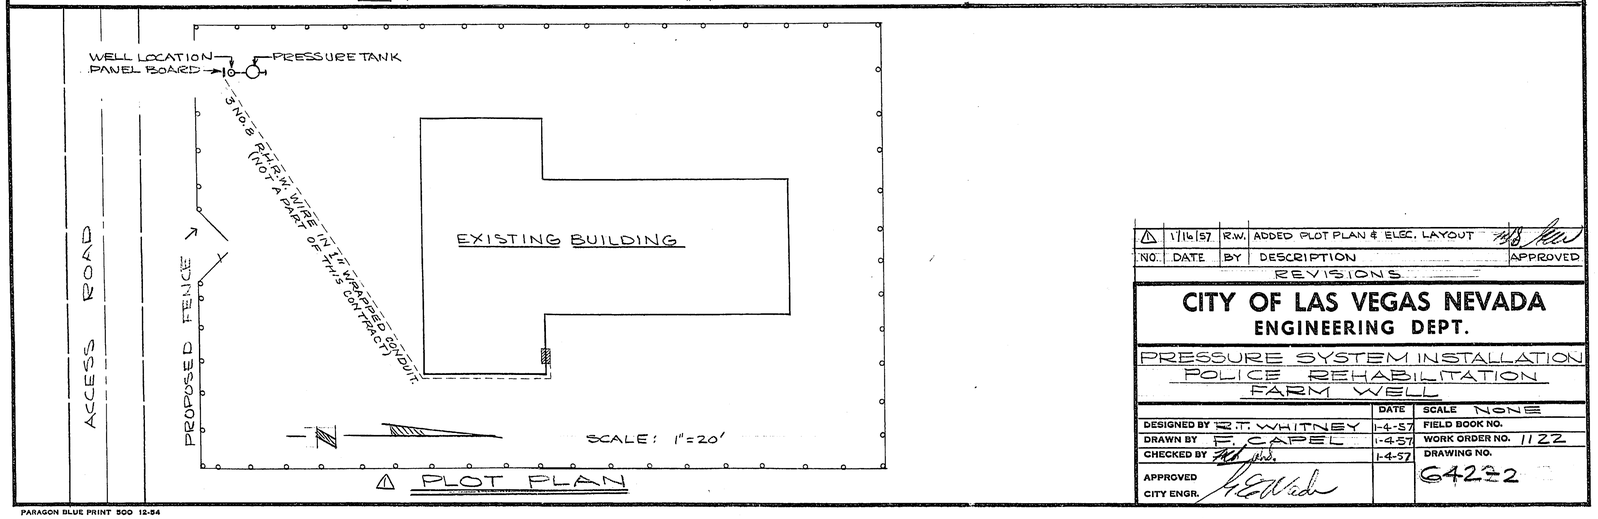

NO.	DATE	BY	DESCRIPTION	APPROVED
1	1/16/57	R.W.	ADDED PLOT PLAN & ELEC. LAYOUT	

REVISIONS

CITY OF LAS VEGAS NEVADA
ENGINEERING DEPT.

PRESSURE SYSTEM INSTALLATION
POLICE REHABILITATION
FARM WELL

		DATE		
DESIGNED BY	R.T. WHITNEY	1-4-57	SCALE	NONE
DRAWN BY	F. CAPEL	1-4-57	FIELD BOOK NO.	
CHECKED BY		1-4-57	WORK ORDER NO.	1122
APPROVED CITY ENGR.			DRAWING NO.	64272

PARAGON BLUE PRINT 500 12-54

5-57