


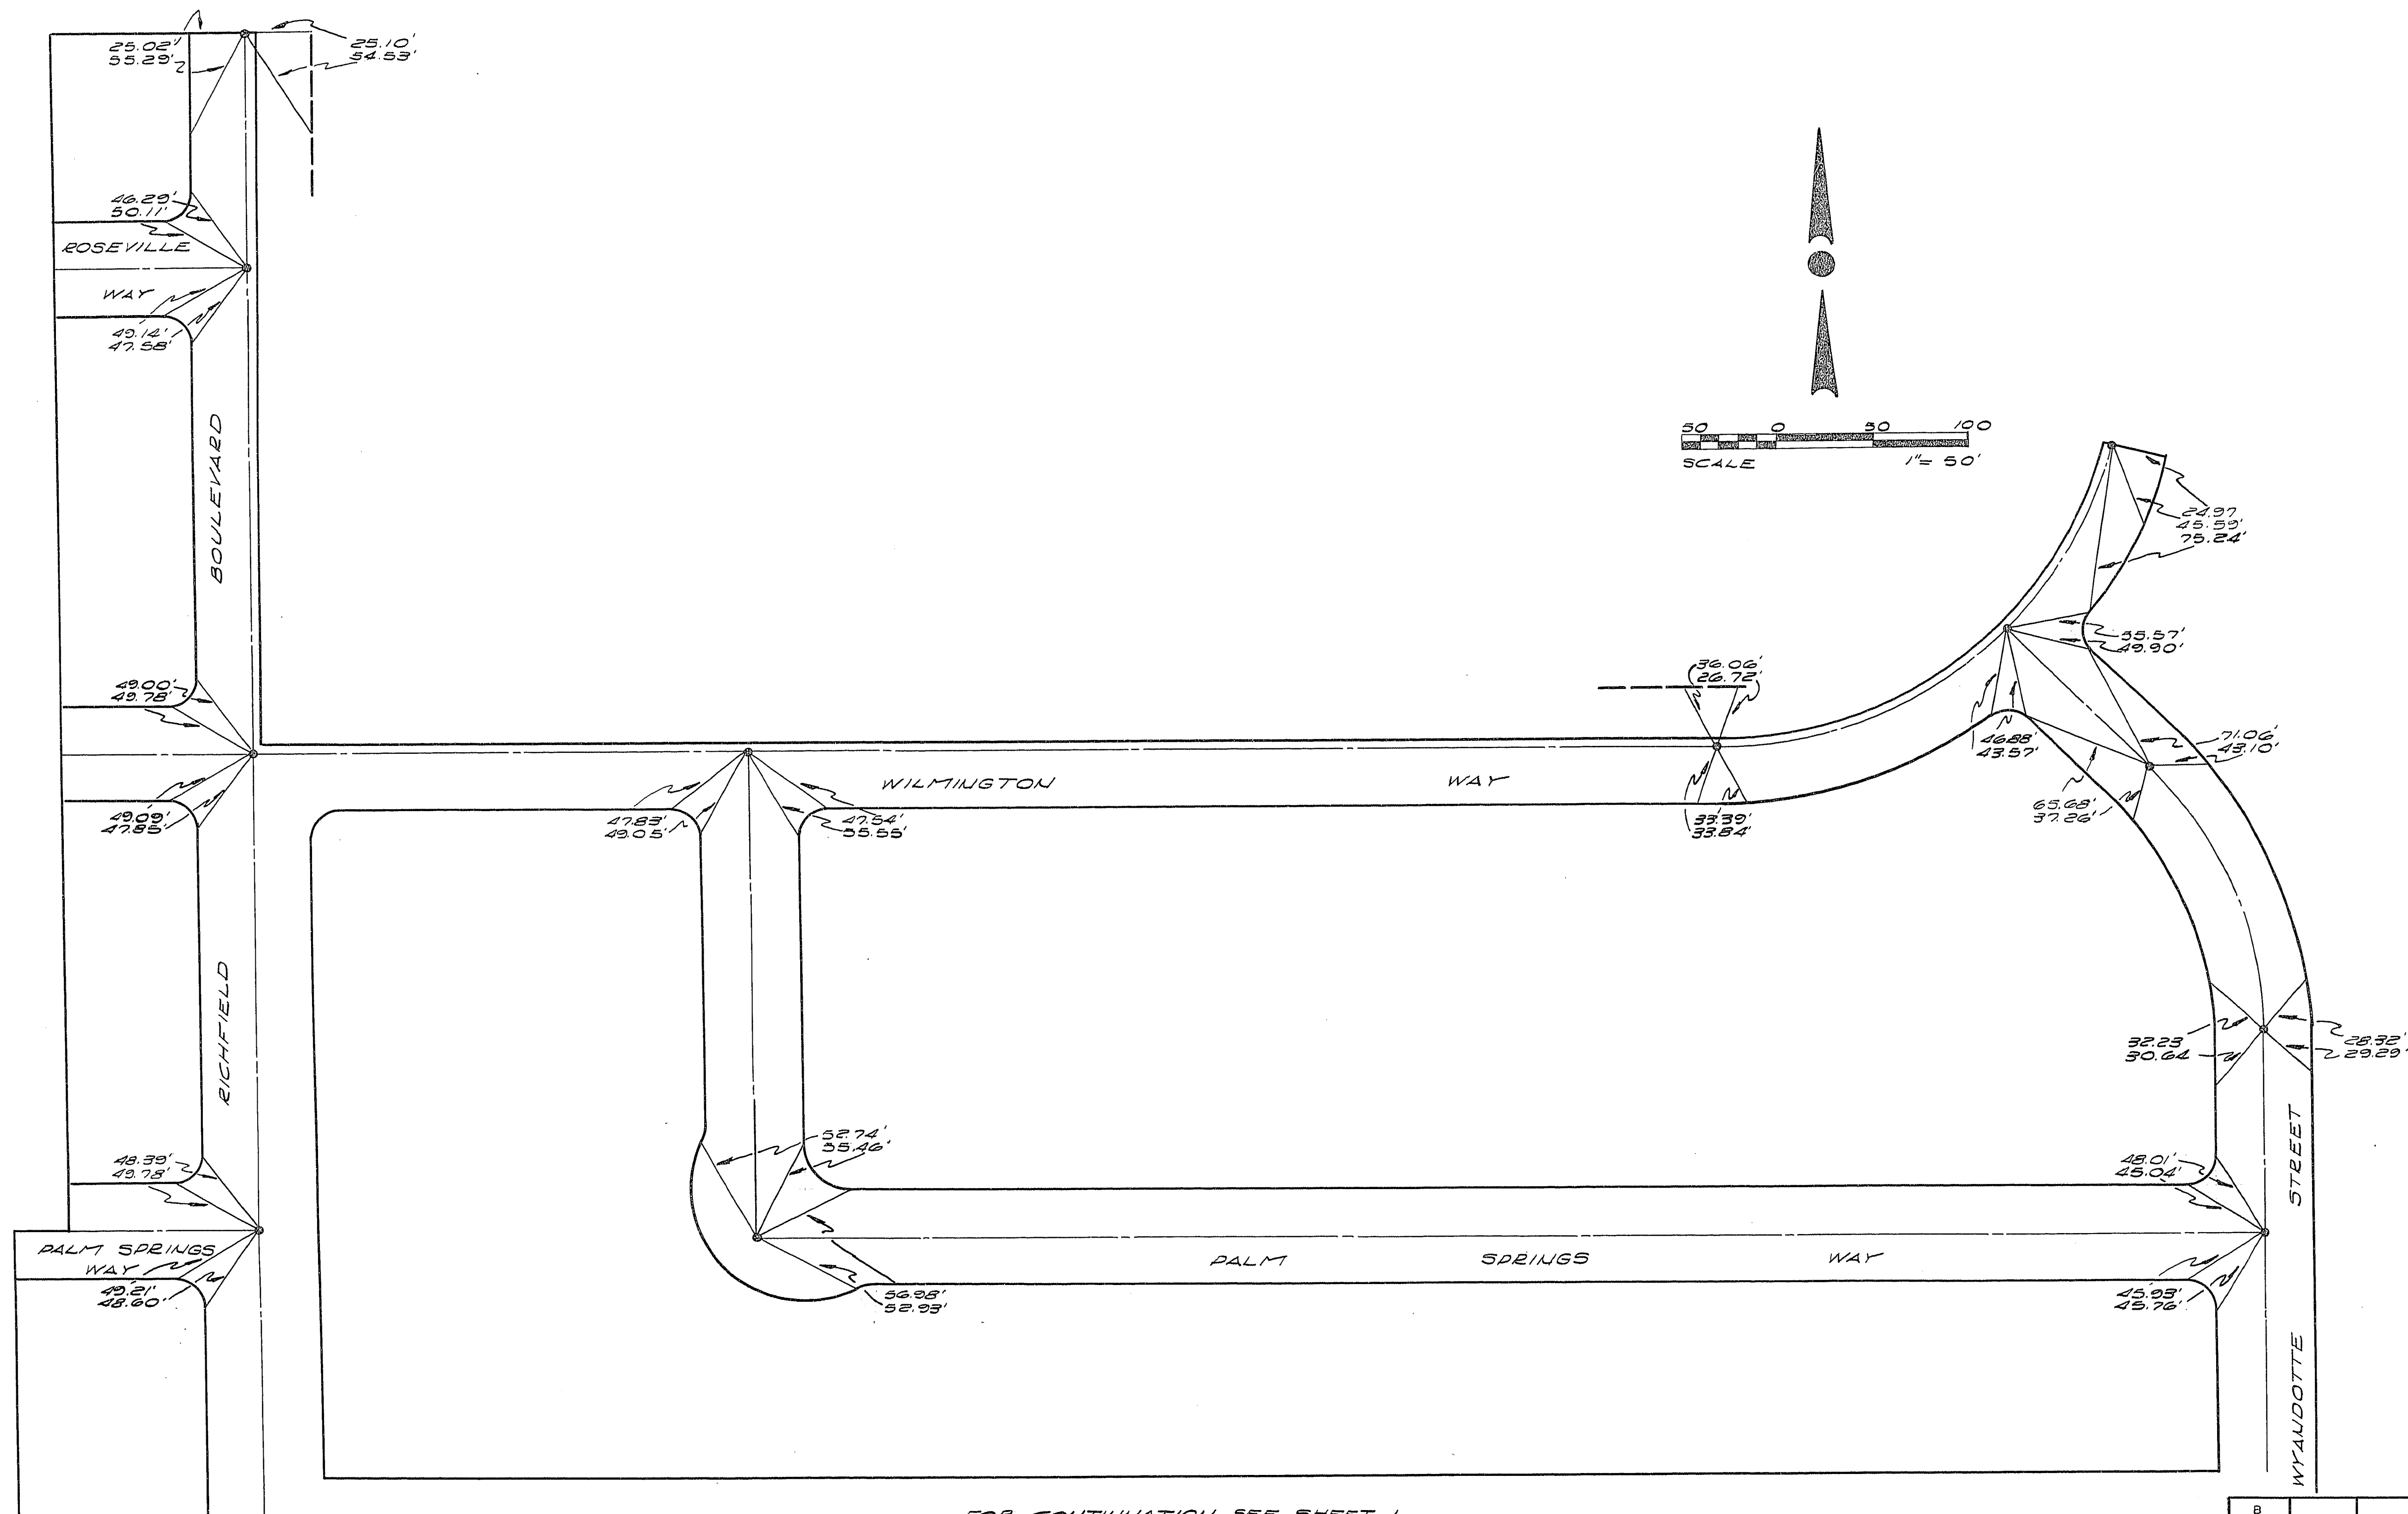

FOR CONTINUATION SEE SHEET 1

NOTES

1. ALL MONUMENTS SET BY B.L.S. 1412.
2. ALL MONUMENT REFERENCE TIES ARE THIS 'X' IN TOP OF CURB.

B				
A				
REV.	DATE	DESCRIPTION	BY	APPROVED
MONUMENT MAP				
FOR				
RICHFIELD VILLAGE UNIT NO. 4.A				
DESIGNED	WESTERN ENGINEERS, INC.		SHEET 2	
DRAWN	L.S.	LAS VEGAS	NEVADA	OF 2
CHECKED	APPROVED		DATE 8-14-63	

058-2640-4A
2 of 2