
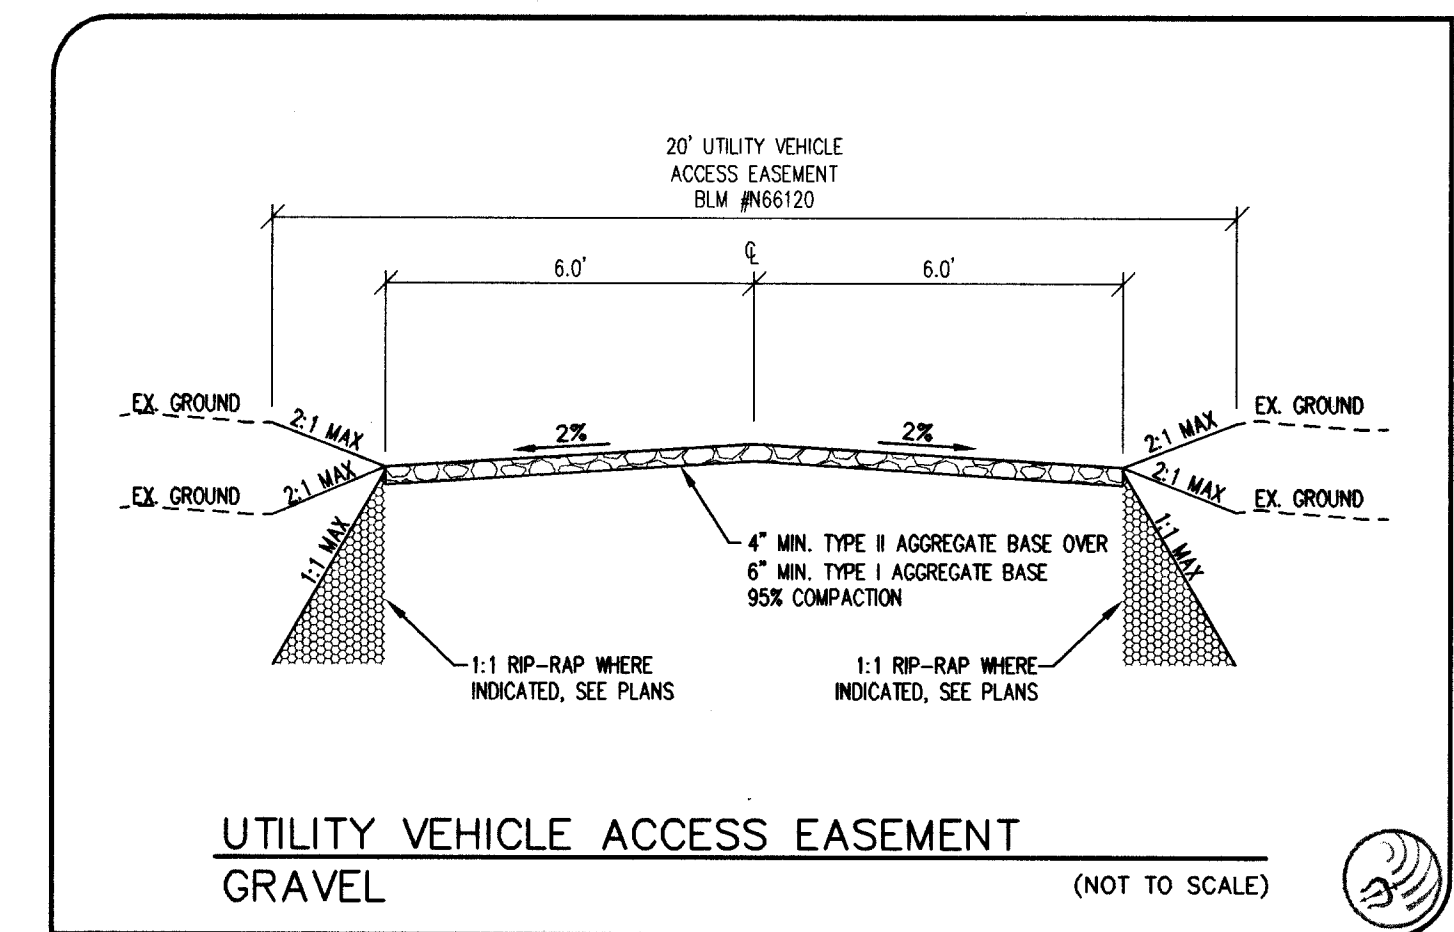
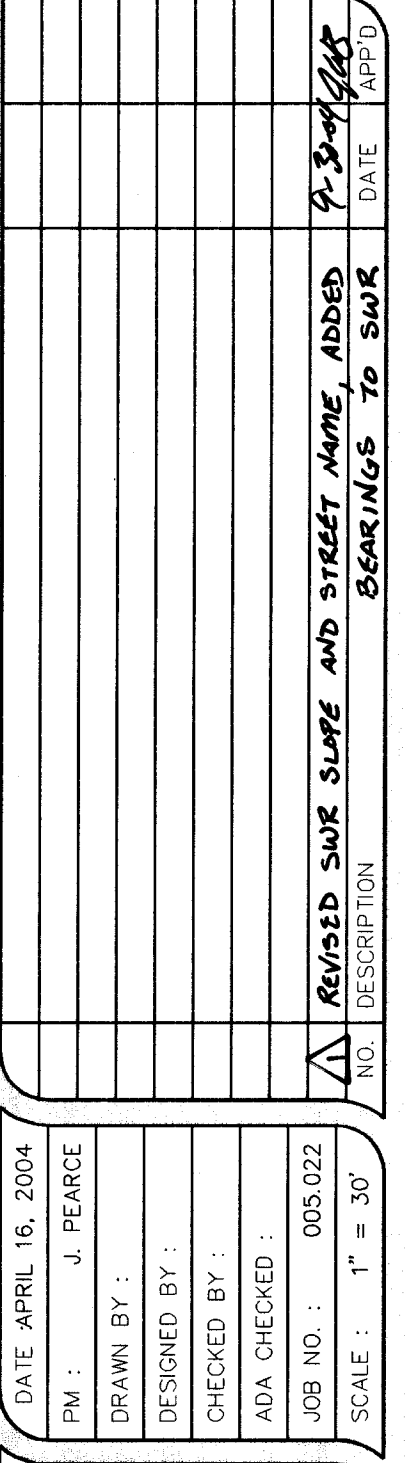


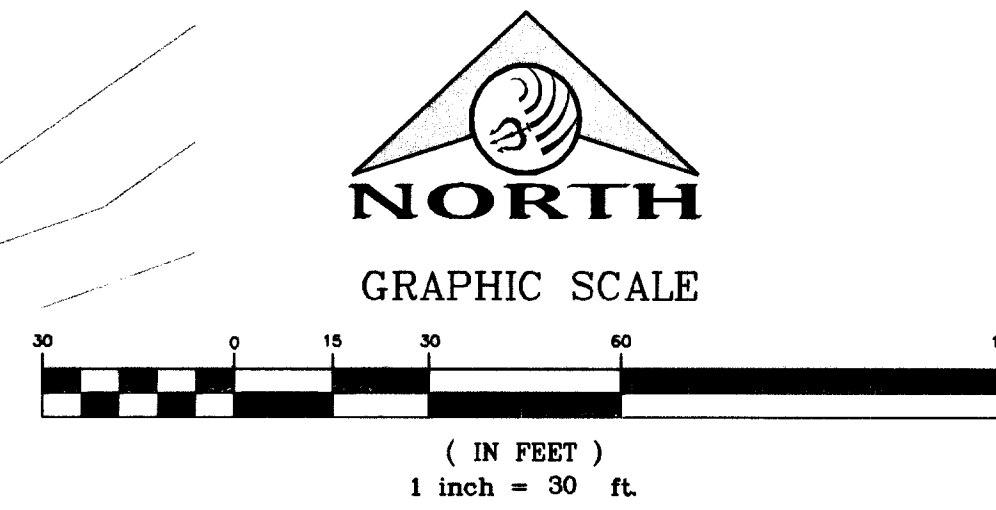

ALL PRIVATE STREETS ARE PUBLIC DRAINAGE,
EASEMENTS TO BE PRIVATELY MAINTAINED, CITY OF
LAS VEGAS SEWER EASEMENT, AND P.U.E.

NORTH 87°08'54" EAST
BEING THE NORTH LINE OF THE NORTHWEST QUARTER (NW
1/4) OF THE NORTHWEST QUARTER (NW 1/4) OF SECTION
12, TOWNSHIP 20 SOUTH, RANGE 59 EAST M.D.M., AS
SHOWN IN FILE 89, OF SURVEYS, PAGE 03 IN THE OFFICE
OF THE CLARK COUNTY, NEVADA RECORDER.

CITY OF LAS VEGAS VERTICAL CONTROL
BENCHMARK No. 1LV09 12NNW6

RIVET AND PLATE IN CONCRETE PAD (TRANS SW7040) ON
THE EAST SIDE OF CLIFF SHADOWS $\pm$ 175 FEET NORTH OF
ALEXANDER.

NAVD 88 ELEVATION = 887.6822 METERS (2912.34) FEET

SHEET **9** OF 14
C.L.V. DWG.#
10744831 7251

Avoid hitting overhead power lines. It's costly. Call before you do Overhead 1-702-593-6111	Avoid cutting underground utility lines. It's costly. Call before you Dig. 1-800-227-2600 UNDERGROUND SERVICE ALERT (USA)
---	---