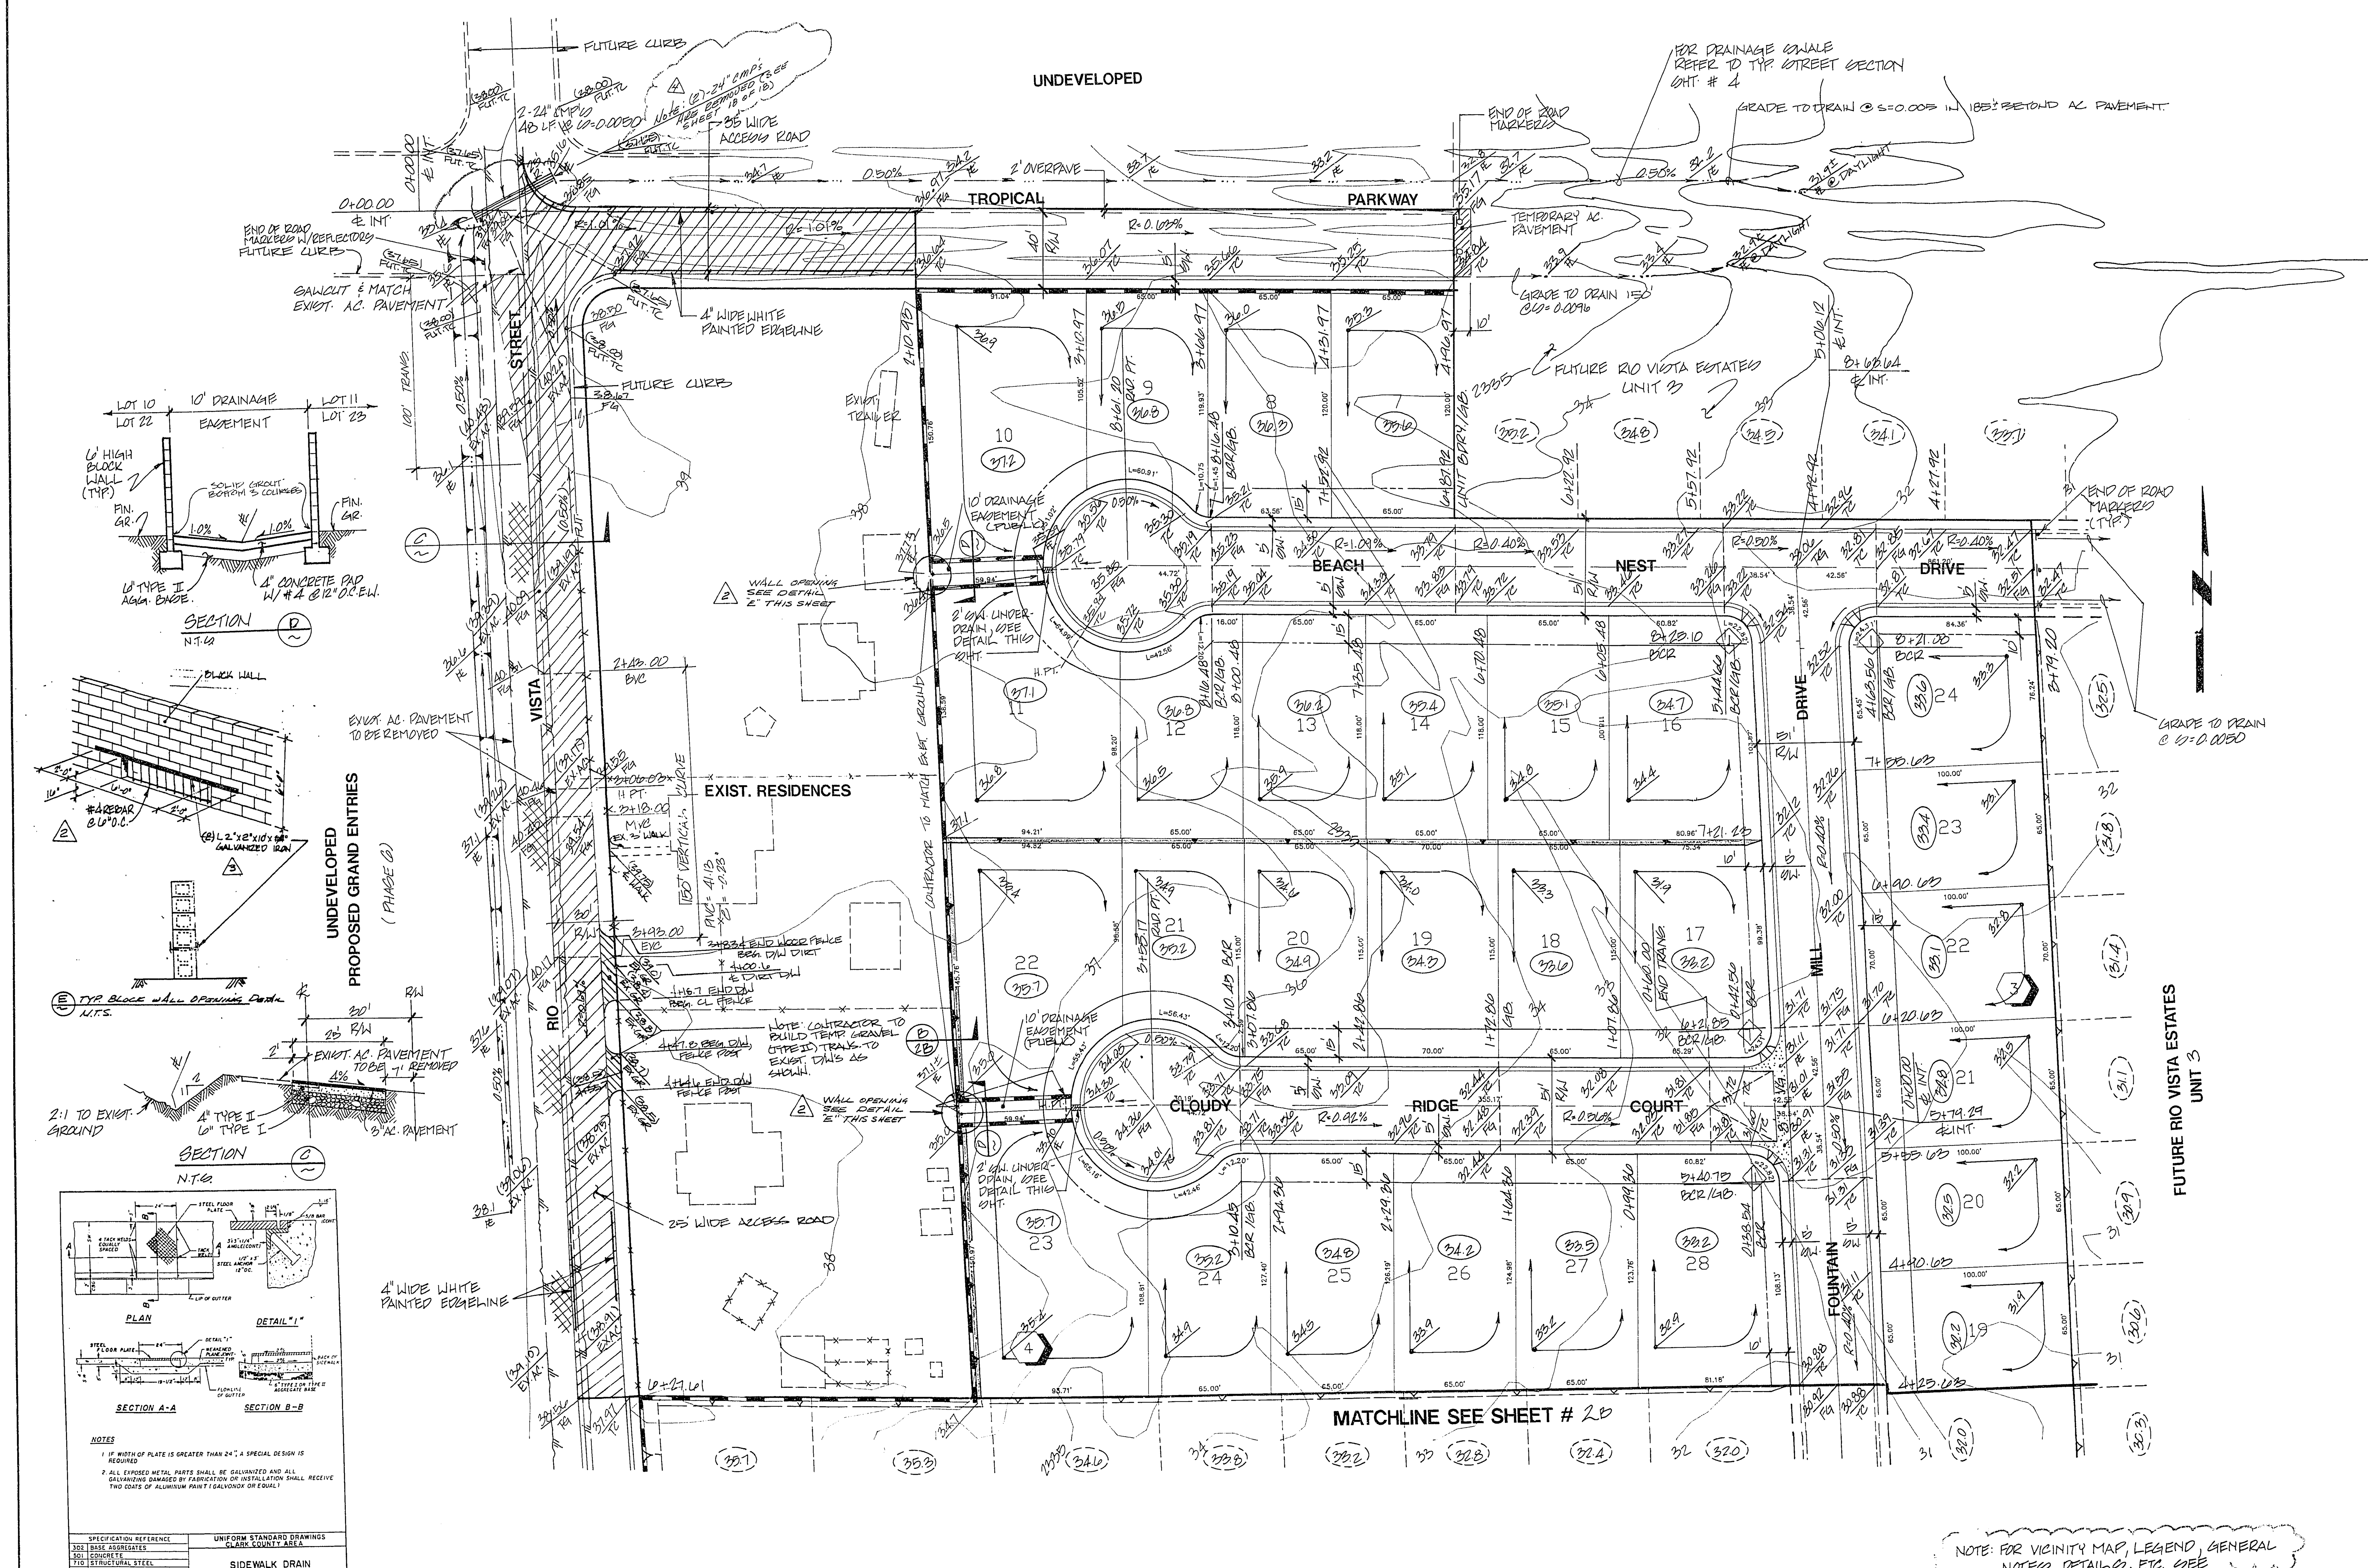

NOTE: FOR VICINITY MAP, LEGEND, GENERAL NOTES, DETAILS, ETC. SEE SHEET # 2B.

BENCHMARK
5/8" REBAR IN GROUND 50' WEST OF CENTERLINE OF RAINBOW BOULEVARD AND WELCOME LANE, 8' NORTH OF TELEPHONE STAND PIPE.
BM#1LV9034E4
ELEVATION = 2319.049

REV	DATE	BY	REVISION
4	4-19-96	DH	REMOVE (2)-24" CMP'S @ TROPICAL PARKWAY
3	7-10-95	DH	CHANGED (2) 6'x2'x12' TO (2) 6'x2'x16'
2	4-19-95	DH	ADD BLOCK WALL OPENING DETAIL
1	10/14/94	WJR	REV. TO CMP SPER CLV. COMMENTS

U.S. HOME
CITY OF LAS VEGAS, NEVADA

vtn nevada
CONSULTING ENGINEERS • PLANNERS • LAND SURVEYORS
2727 SOUTH RAINBOW BOULEVARD
LAS VEGAS, NEVADA 89102-5148 PHONE (702) 873-7550 FAX (702) 362-2597

TITLE: ROUGH GRADING PLAN

PROJECT: RIO VISTA ESTATES
UNIT 1

SEAL
9/20/93

WO NO. 4508-1
BY TEH, WJR
DATE 9/93
SCALE 1" = 40'
SHEET 3 OF 18 SHEETS

107Y-4321-1

11-13-201