


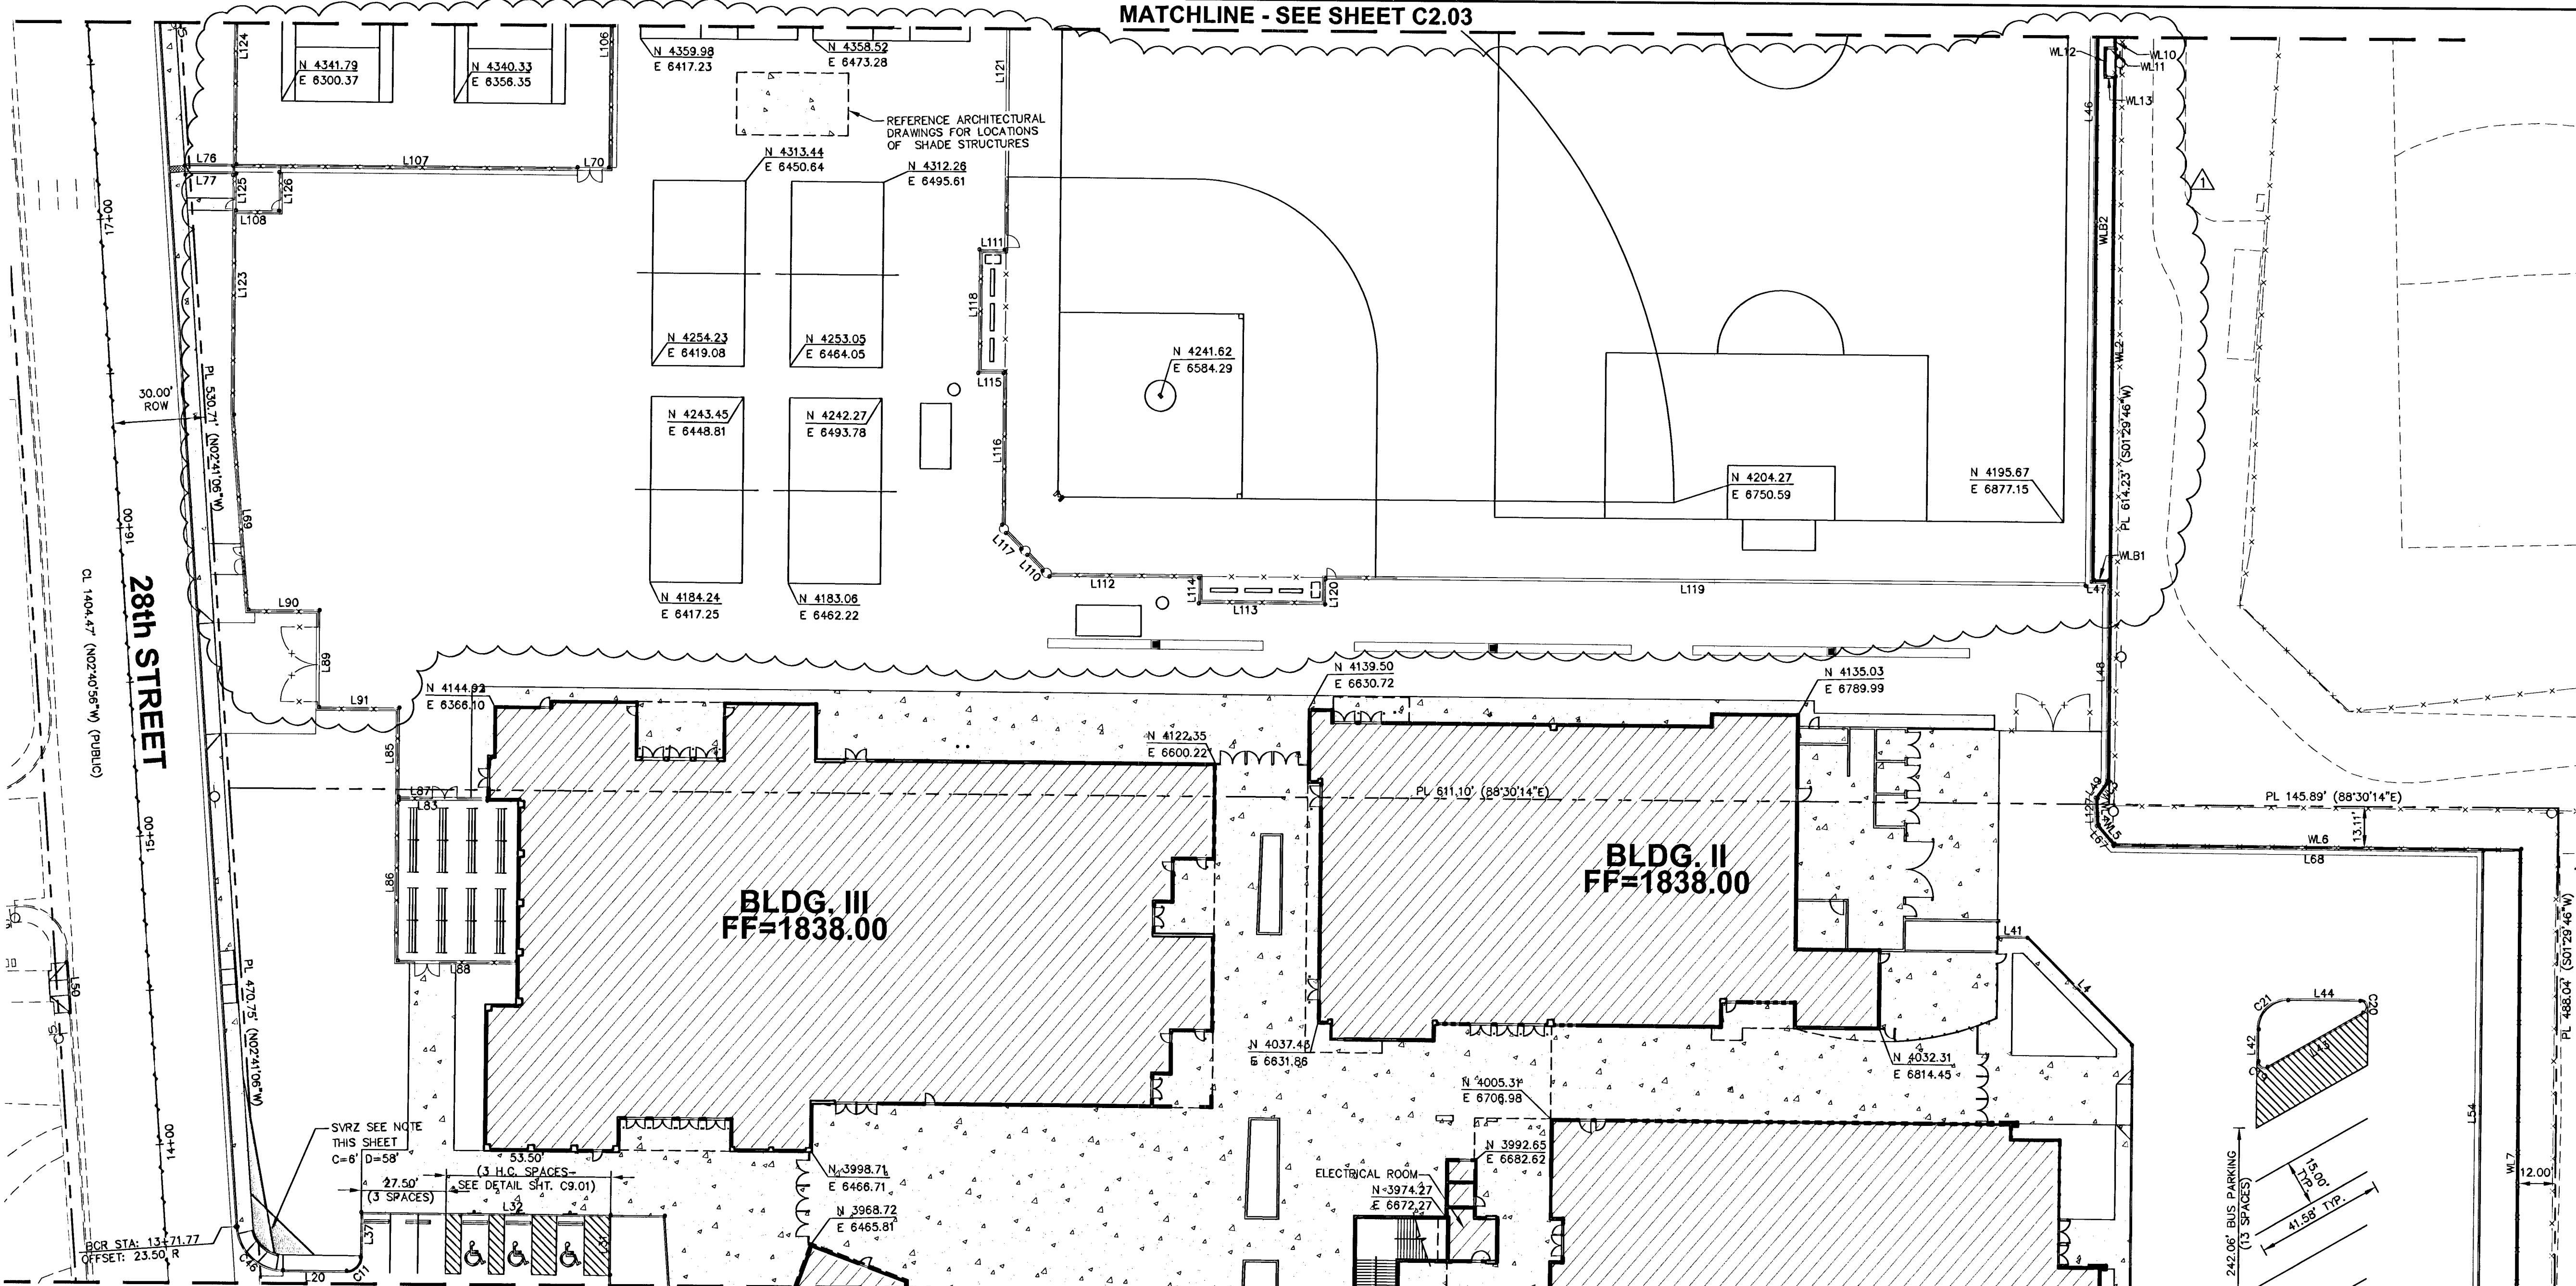

PARKING COUNT:
xx STANDARD
x HC
xx BUS

TRAFFIC NOTES:
① 4" YELLOW PARKING STRIPE

SIGHT VISIBILITY RESTRICTION ZONE:
NO WALLS, FENCES, TREES, SHRUBS, UTILITY APPURTENANCES OR ANY OTHER OBJECT, OTHER THAN TRAFFIC CONTROL DEVICES AND STREET LIGHT POLES, MAY BE CONSTRUCTED OR INSTALLED WITHIN THE SIGHT VISIBILITY ZONE UNLESS SAID OBJECT IS MAINTAINED AT LESS THAN 24" IN HEIGHT, MEASURED FROM TOP OF CURB, OR WHERE NO CURB EXISTS, A HEIGHT OF 27" MEASURED FROM THE TOP OF ADJACENT ASPHALT, GRAVEL OR PAVEMENT STREET SURFACE PER C.O.U.S.D. #201.2.

GENERAL NOTES:
1. ALL DIMENSIONS AND LINE/CURVE TABLES ARE TO BACK OF CURB. REFER TO THE MASTER SITE PLAN SHEET C2.00 FOR PROPERTY LINE INFORMATION ALONG RIGHT-OF-WAY.
2. THE CONTRACTOR SHALL PROVIDE PILOT AND ALIGNMENT LINES FOR THE ENGINEERS APPROVAL PRIOR TO PERFORMING ANY MARKING WORK. CONTACT THE ENGINEER 48 HOURS IN ADVANCE.
3. ALL APPLICATION METHODS SHALL BE CONFIRMED BY THE OWNER AND MANUFACTURER PRIOR TO INSTALLATION. ALL PAVEMENT MARKING FILM SHALL NOT BE PLACED EARLIER THAN (2) WEEKS AFTER FINAL A.C. LAYER IS PLACED. ALL MATERIALS AND EQUIPMENT SHALL BE IN ACCORDANCE WITH THE MANUFACTURER'S SPECIFICATIONS. ALL PAVEMENT MARKING FILM ARROWS AND LEGENDS SHALL BE TYPE I PAVEMENT MARKING FILM. ALL OTHER PAVEMENT MARKING FILM SHALL BE TYPE 2.
4. THE CONTRACTOR SHALL TAKE ALL PRECAUTIONARY MEASURES NECESSARY TO PROTECT EXISTING IMPROVEMENTS FROM DAMAGE. ALL IMPROVEMENTS OR STRUCTURES DAMAGED BY THE CONTRACTOR'S OPERATIONS SHALL BE REPAIRED OR REPLACED TO THE SATISFACTION OF THE ENGINEER AT THE EXPENSE OF THE CONTRACTOR.
5. THE GIVEN MUTCD REFERENCE IS TO BE USED FOR GUIDANCE IN MAKING THE SIGNS. VARIATIONS TO THE STANDARD MUTCD SIGN ONLY AFFECT THE SIGN'S LAYOUT AND GRAPHICS. ALL LETTERING SIZES AND SIGN COLORS ARE PER THE GIVEN MUTCD REFERENCE.
6. SEE ARCH PLANS FOR SIDEWALK CJ PATTERNS.

NOTE TO CONTRACTOR:
1. REFER TO THE MASTER SITE PLAN SHEET C2.00 FOR LINE/CURVE TABLES.

LEGEND
CL OR SURVEY LINE
PROPERTY LINE
ROW LINE
EASEMENT LINE
SAWTOOTH LINE
SCARP LINE
HEAVY AC PVMT.
LIGHT AC PVMT.
CONC. PVMT.
MANHOLES & DESCRIPTIONS
① = SANITARY SEWER
② = STORM DRAIN
③ = ELECTRICAL
④ = TELEPHONE
CAP
DESCRIPTION:
EXISTING:
PROPOSED:
BO VALVE
CLEAN OUT
FDC
FIRE HYDRANT
GATE VALVE
REDUCER
100W HPS STREETLIGHT
150W HPS STREETLIGHT
200W HPS STREETLIGHT
250W HPS STREETLIGHT
400W HPS STREETLIGHT
5' CONTOUR LINE
1' CONTOUR LINE
EDGE OF PVMT.
"A" TYPE CURBS
"L" TYPE CURBS
WALLS
FENCES
SPOT ELEVATIONS
SIGNS

GRAPHIC SCALE
1 inch = 30 ft.

BENCHMARK:
CITY OF LAS VEGAS BENCHMARK #2LV01 36W6, A RIVET & PLATE IN TOP OF CURB @ SE CORNER OF STEWART AND 28TH ST.
ELEVATION = 557.7395 METERS (NAVD 88)
ELEVATION = 1829.85 FEET (CALCULATED NAVD 88)

BASIS OF BEARINGS:
S88°30'14"E, BEING THE NORTH LINE OF THE SW 1/4 OF SECTION 36, TOWNSHIP 20 SOUTH RANGE 61 EAST, M.D.M., CITY OF LAS VEGAS, CLARK COUNTY, NEVADA. RECORDED IN FILE 100 PAGE 50 OF PARCEL MAPS.

Call before you Dig
Avoid cutting underground utility lines. It's costly.

Call before you OVERHEAD
1-702-227-2929
CLARK COUNTY TRAFFIC OPERATIONS
1-702-455-7544

Call 811
1-800-227-2600
CLARK COUNTY TRAFFIC OPERATIONS
1-702-455-7544










REVISIONS			
REV.	DESCRIPTION	DATE	BY
1	REVISED SITE TO LEAVE PORTION OF EXIST. SCHOOL BLDGS. REVISED LINE/CURVE NUMBERS REVISED CALLOUTS	9/4/09	SP

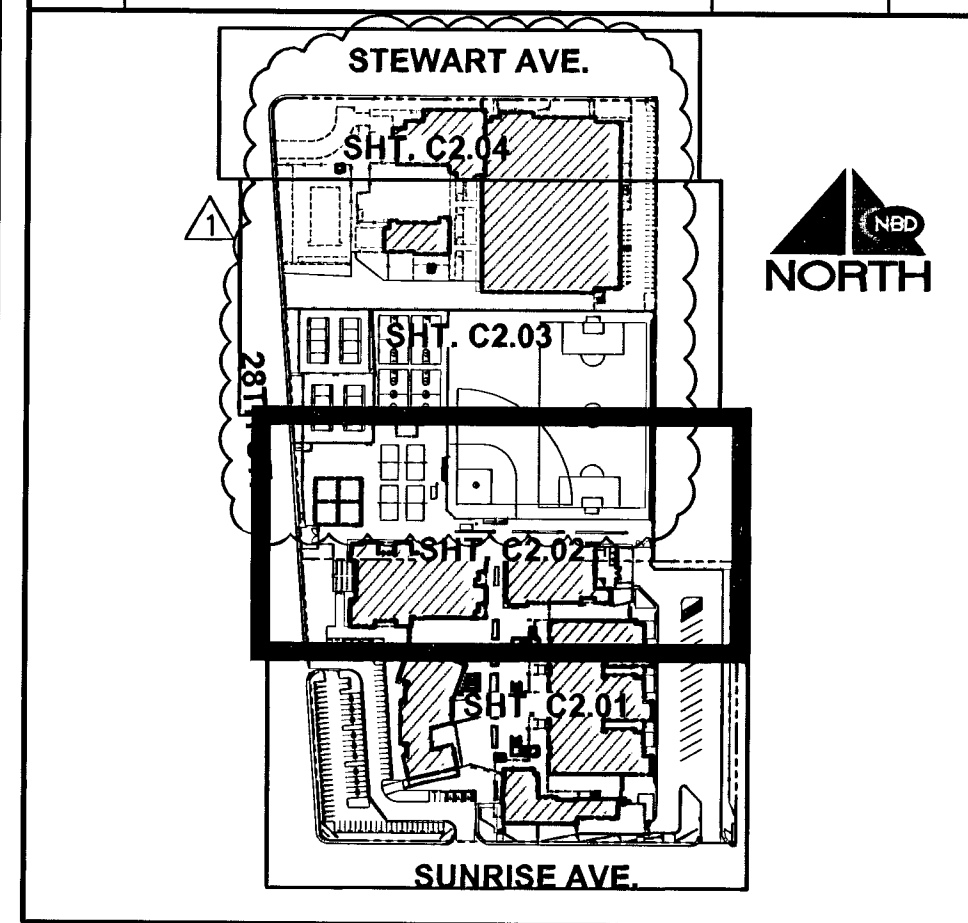

DO NOT SCALE DRAWINGS

Nevada By Design
NBD
ENGINEERING CONSULTANTS
3315 East Harmon Avenue
Las Vegas, NV 89121
www.nvdesign.com

Professional Engineer Seal:
STATE OF NEVADA
JAMIE MARGULIES
CIVIL
EXP. 12/31/09
7/24/09

Project Information:
PROJECT NO. 0724-08
DESIGNER JAMIE MARGULIES
APPROVED BY DATE
DRAWN BY RCS
CHECKED BY CLN
SUBMITTAL BID
DATE 01/15/2007
PROJECT NO. WP-0553 / 05477

CLARK COUNTY SCHOOL DISTRICT
CONSTRUCTION MANAGEMENT
4828 PEARL STREET
LAS VEGAS, NEVADA 89121

ROY MARTIN MIDDLE SCHOOL REPLACEMENT
28th STREET / SUNRISE AVENUE
HORIZONTAL CONTROL

WELLES - PUGLEY ARCHITECTS L.L.C.
2480 e. tampa ave, suite 202, las vegas, nevada 89121
ph 702.455.1150 fax 702.455.7539 e-mail wlpdesign@comcast.net
© 2002

CCSD
CLARK COUNTY SCHOOL DISTRICT

REPLLOT

C2.02

SHEET 9 of 49

CLV DRAWING NO. 715-3B

PL NO. 21350