


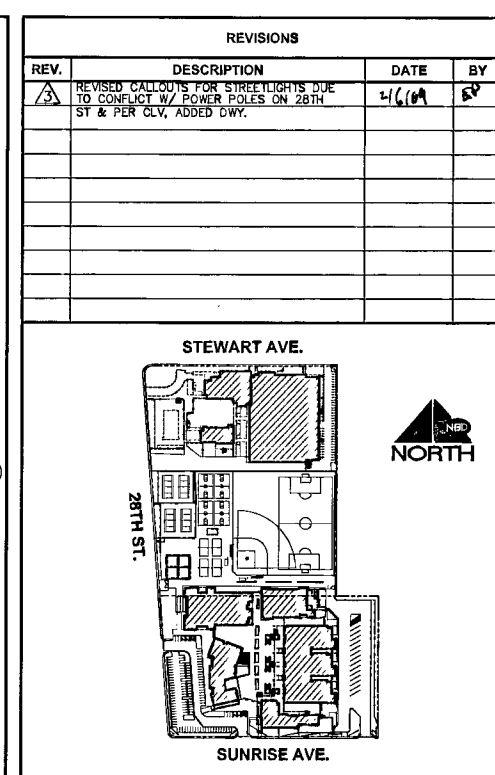

DATE	05/05/2007
PROJECT NO.	05-053 / 05477
SUBMITAL	BID
BACKLOG BY	CLN
RCS	
DOWN BY	
DATE	05/15/2007

SHEET NO.

C6.08

SHEET 34 of 49

CLV DRAWING NO.	715-3B	IR NO.	21350
-----------------	--------	--------	-------

REPLD7