



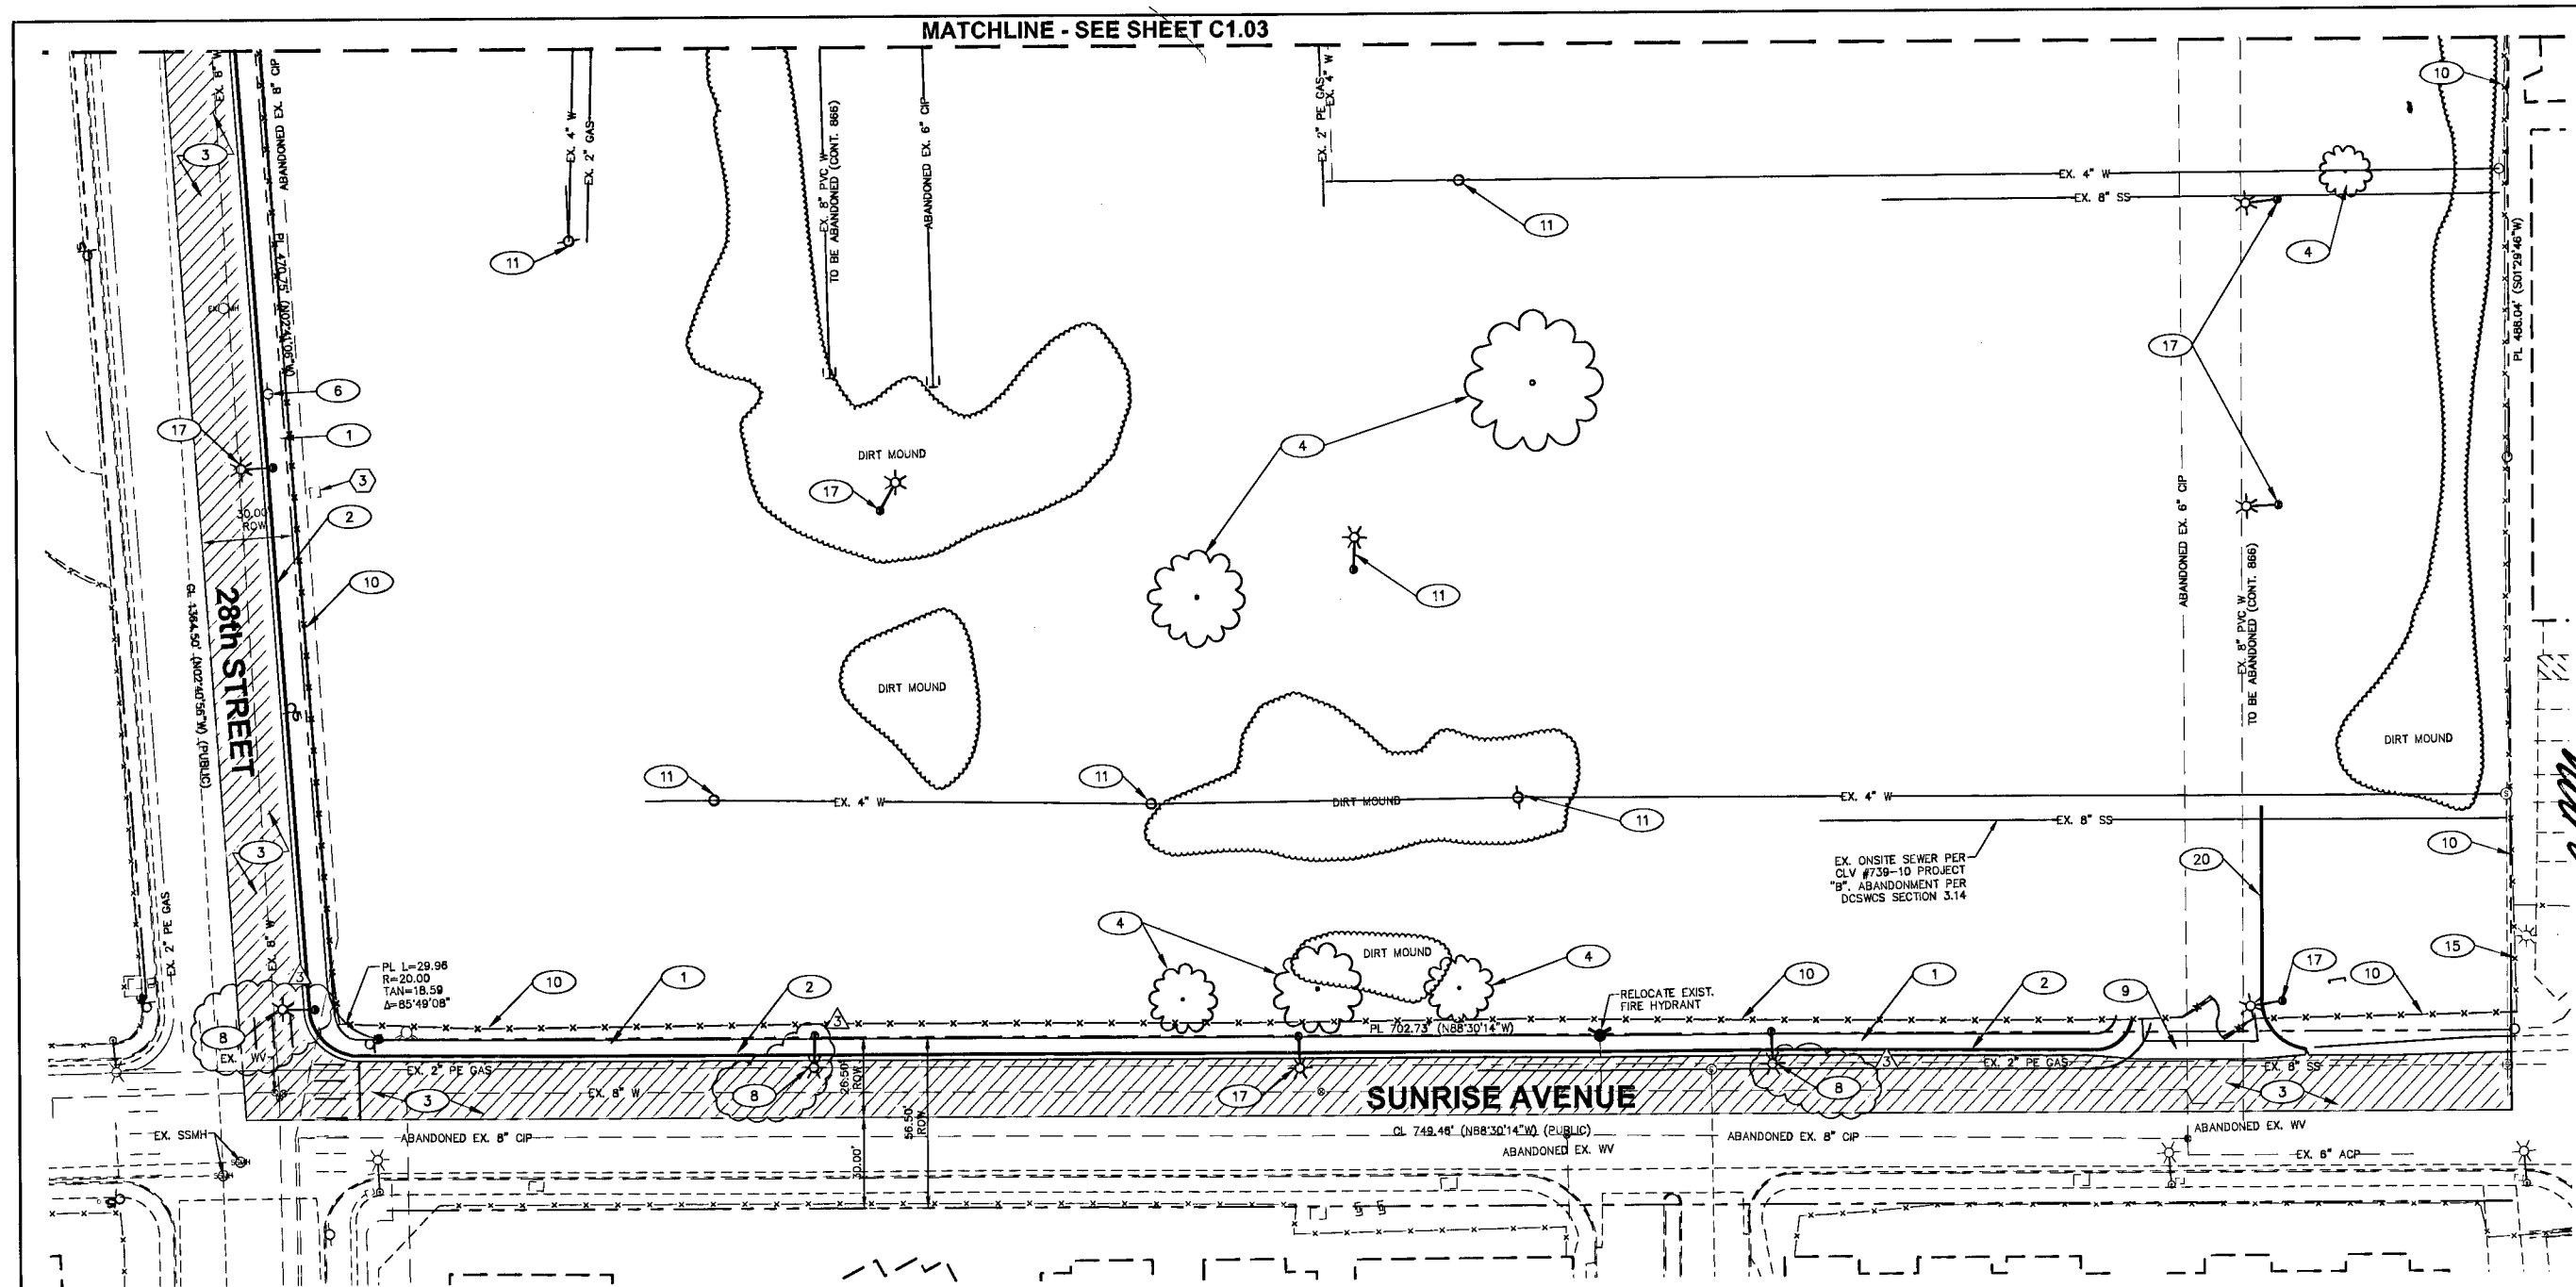

REVISIONS			
REV.	DESCRIPTION	DATE	BY
1	REVISED DEMO CALLOUTS FOR STREETLIGHTS DUE TO CONFLICT W/ POWER POLES ON 28TH ST & PER CLV	2/16/07	SP

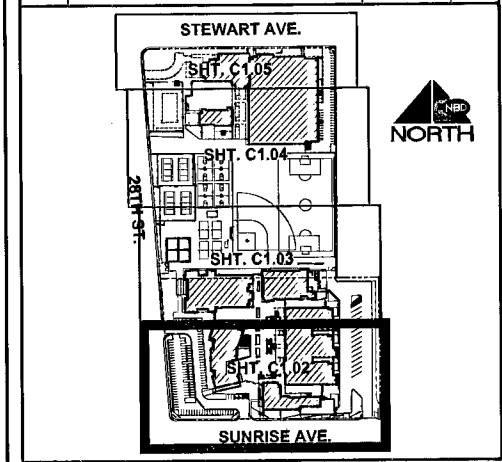

CLAYTON L. NIELSEN
STATE OF NEVADA
LICENSE NO. 15533
CIVIL ENGINEERING

DESIGNED BY: JAMIE MARGULIES
CHECKED BY: CLN
DATE: 01/15/2007
PROJECT NO: 0553 / 05477

(4) - 4" CT METERS (ACCT #'S 23251 AND 31241) ABANDONMENT OF EXISTING SERVICE(S) - LARGER THAN 2"

THE CONTRACTOR SHALL NOTIFY THE INSPECTION DIVISION AT THE LVVWD (702-258-3227) 48 HOURS PRIOR TO THE REQUESTED REMOVAL TIME TO ALLOW THE DISTRICT TO TAKE THE FINAL METER READING. AFTER THE FINAL METER READING, THE CONTRACTOR MAY THEN BEGIN THE REMOVAL PROCEDURES FOR THE AFFECTED SERVICE AS FOLLOWS:

ALL VALVES TO BE ABANDONED SHALL BE ABANDONED IN THE CLOSED POSITION, UNLESS SHOWN OTHERWISE, BY REMOVING A MINIMUM OF THE TOP TWENTY-FOUR (24) INCHES OF THE VALVE BOX, AND THEN FILLING THE BOTTOM OF THE BOX WITH A MINIMUM OF EIGHT (8) INCHES OF SAND OR TYPE II AGGREGATE BASE. THE REMAINING PORTION OF THE VALVE BOX SHALL BE FILLED WITH CONCRETE HAVING A COMPRESSIVE STRENGTH OF AT LEAST TWO-THOUSAND (2,000) PSI. IF THE VALVE IS TO BE ABANDONED IN THE CLOSED POSITION, THE LATERAL MUST BE CUT WITHIN THREE (3) FEET OF THE ABANDONED VALVE, OR AS SHOWN ON PLANS, AND CAPPED, WHERE A JOINT OR COUPLING IN THE EXISTING PIPE IS UNCOVERED AT THE CUT AND CAP LOCATIONS, THE INSTALLATION OF A PLUG MAY BE PERMITTED WITH DISTRICT APPROVAL. THE CONTRACTOR SHALL INSTALL A CONCRETE THRUST BLOCK IN ACCORDANCE WITH THE PROVISIONS OF THE UDACS PLATE No.5 AT ALL CAP OR PLUG LOCATIONS. THE EXISTING METER(S) SHALL BE REMOVED AND/OR BACKFILL THE ABANDONED VAULT WITH TYPE II MATERIAL.

ESN.027 REV. 8/1/04

ABANDONMENT OF EXISTING SERVICE LATERALS (3" and larger)

THE CONTRACTOR SHALL NOTIFY THE AGENCY TWO (2) FULL BUSINESS DAYS PRIOR TO THE REQUESTED REMOVAL TIME TO ALLOW THE AGENCY TO TAKE THE FINAL METER READING AND TO NOTIFY THE AGENCY OF THE IMPENDING WORK. THE CONTRACTOR MAY THEN BEGIN REMOVAL PROCEDURES FOR THE AFFECTED SERVICE AS FOLLOWS:

ALL VALVES TO BE ABANDONED SHALL BE ABANDONED IN THE CLOSED POSITION, UNLESS SHOWN OTHERWISE, BY REMOVING A MINIMUM OF THE TOP TWENTY-FOUR (24) INCHES OF THE VALVE BOX, AND THEN FILLING THE BOTTOM OF THE BOX WITH A MINIMUM OF EIGHT (8) INCHES OF SAND OR TYPE II AGGREGATE BASE. THE REMAINING PORTION OF THE VALVE BOX SHALL BE FILLED WITH CONCRETE HAVING A COMPRESSIVE STRENGTH OF AT LEAST TWO-THOUSAND (2,000) PSI.

IF THE VALVE IS TO BE ABANDONED IN THE CLOSED POSITION, THE LATERAL MUST BE CUT WITHIN THREE (3) FEET OF THE ABANDONED VALVE, OR AS SHOWN ON PLANS, AND CAPPED, WHERE A JOINT OR COUPLING IN THE EXISTING PIPE IS UNCOVERED AT THE CUT AND CAP LOCATIONS, THE INSTALLATION OF A PLUG MAY BE PERMITTED WITH DISTRICT APPROVAL. THE CONTRACTOR SHALL INSTALL A CONCRETE THRUST BLOCK IN ACCORDANCE WITH THE PROVISIONS OF THE UDACS PLATE No.5 AT ALL CAP OR PLUG LOCATIONS.

THE EXISTING METER(S) SHALL BE REMOVED AND DELIVERED TO THE AGENCY. THE CONTRACTOR SHALL THEN REMOVE AND/OR BACKFILL THE ABANDONED VAULT WITH TYPE II MATERIAL.

ABANDONED VALVE CUT AND CAP

ALL VALVES TO BE ABANDONED SHALL BE ABANDONED IN THE CLOSED POSITION, UNLESS SHOWN OTHERWISE, BY REMOVING A MINIMUM OF THE TOP TWENTY-FOUR (24) INCHES OF THE VALVE BOX, AND THEN FILLING THE BOTTOM OF THE BOX WITH A MINIMUM OF EIGHT (8) INCHES OF SAND OR TYPE II AGGREGATE BASE. THE REMAINING PORTION OF THE VALVE BOX SHALL BE FILLED WITH CONCRETE HAVING A COMPRESSIVE STRENGTH OF AT LEAST TWO-THOUSAND (2,000) PSI.

IF THE VALVE IS TO BE ABANDONED IN THE CLOSED POSITION, THE LATERAL MUST BE CUT WITHIN THREE (3) FEET OF THE ABANDONED VALVE, OR AS SHOWN ON PLANS, AND CAPPED, WHERE A JOINT OR COUPLING IN THE EXISTING PIPE IS UNCOVERED AT THE CUT AND CAP LOCATIONS, THE INSTALLATION OF A PLUG MAY BE PERMITTED WITH DISTRICT APPROVAL. THE CONTRACTOR SHALL INSTALL A CONCRETE THRUST BLOCK IN ACCORDANCE WITH THE PROVISIONS OF THE UDACS PLATE No.5 AT ALL CAP OR PLUG LOCATIONS.

THE EXISTING METER(S) SHALL BE REMOVED AND DELIVERED TO THE AGENCY. THE CONTRACTOR SHALL THEN REMOVE AND/OR BACKFILL THE ABANDONED VAULT WITH TYPE II MATERIAL.

DISPOSAL OF ASBESTOS CEMENT PIPE SHALL BE IN ACCORDANCE WITH AWWA, LOCAL STATE, AND FEDERAL REGULATIONS.
ESN.053 REV. 06/01/04

NOTE
CONTRACTOR SHALL NOT ASSUME ANY SALVAGE VALUE.

WATER NOTES:
(NOT ALL KEY NOTES ARE USED ON THIS DRAWING)

1 ABANDON FIRE HYDRANT LATERAL PER U.D.A.C.S. STANDARDS - REFER TO NOTES THIS SHEET.

2 ABANDON 6" DOMESTIC LATERAL PER U.D.A.C.S. STANDARDS - REFER TO NOTES THIS SHEET.

3 REMOVE EXIST. 2-4" METERS & VAULT & ASSOCIATED PIPING.

L.V.V.W.D. APPROVAL 2/17/07 AND 8/16/07
N/A FOR LVVWD - REFER TO SHTS. C3.00 - C3.04
L.V.V.W.D. PROJ. 113482 DATE

- DEMOLITION NOTES:**
(NOT ALL KEY NOTES ARE USED ON THIS DRAWING)
- 1 REMOVE EXIST. CONCRETE SIDEWALK.
 - 2 REMOVE EXIST. CURB AND GUTTER.
 - 3 SAWCUT AND REMOVE EXIST. ASPHALT.
 - 4 REMOVE EXIST. TREES, SHRUBS, & LANDSCAPING.
 - 5 REMOVE EXIST. STRUCTURE.
 - 6 EXIST. POWER POLES TO REMAIN (PROTECT IN PLACE).
 - 7 REMOVE EXIST. CONC.
 - 8 REMOVE & RELOCATE EXISTING STREETLIGHT. REMOVE AND RETURN LUMINAIRE AND WIRE TO CITY OF LAS VEGAS YARDS AT 3104 E. BONANZA ROAD. CALL 24 HOURS BEFORE RETURNING AT 229-6331.
 - 9 REMOVE EXIST. CROSS GUTTER & SPANDREL.
 - 10 REMOVE EXIST. FENCE.
 - 11 REMOVE EXIST. POWER POLES.
 - 12 EXIST. PORTABLE BLDGS. TO BE REMOVED BY OWNER. CONTRACTOR TO COORDINATE.
 - 13 REMOVE & RELOCATE EXISTING STREETLIGHT TO NEW FOUNDATION - SEE SHEET C6.08
 - 14 EXIST. STREETLIGHT TO REMAIN (PROTECT IN PLACE).
 - 15 EXIST. WALL OR FENCE TO REMAIN (PROTECT IN PLACE).
 - 16 NOT USED.
 - 17 REMOVE EXISTING STREETLIGHTS. REMOVE AND RETURN STREET LIGHT POLE/S AND WIRE TO CITY OF LAS VEGAS YARDS AT 3104 E. BONANZA ROAD. CALL 24 HOURS BEFORE RETURNING AT 229-6331.
 - 18 REMOVE EXIST. FIRE HYDRANT.
 - 19 REMOVE EXIST. LIGHT POLES.
 - 20 REMOVE EXIST. CURB.
 - 21 REMOVE EXIST. WALL.

GRAPHIC SCALE
(IN FEET)
1 inch = 30 ft

BENCHMARK:
CITY OF LAS VEGAS BENCHMARK #2LV01 36W6, A RIVET & PLATE IN TOP OF CURB @ SE CORNER OF STEWART AND 28TH ST.
ELEVATION = 557.7395 METERS (NAVD 88)
ELEVATION = 1829.85 FEET (CALCULATED NAVD 88)

BASIS OF BEARINGS:
S88°30'14"E, BEING THE NORTH LINE OF THE SW 1/4 OF SECTION 38, TOWNSHIP 20 SOUTH RANGE 61 EAST, M.D.M., CITY OF LAS VEGAS, CLARK COUNTY, NEVADA. RECORDED IN FILE 100 PAGE 50 OF PARCEL MAPS.

Call before you Dig
Avoid cutting underground utility lines. It's costly.

Call 811
1-800-227-2600
1-702-227-2929

LEGEND	CL OR SURVEY LINE	EASEMENT LINE	HEAVY AC P.W.M.T.	MANHOLES & DESCRIPTIONS ③ = SANITARY SEWER ④ = STORM DRAIN ⑤ = ELECTRICAL ⑥ = TELEPHONE	CAP [	DESCRIPTION:	BO VALVE	CLEAN OUT	FDC	FIRE HYDRANT	GATE VALVE	REDUCER	100w HPS STREETLIGHT	150w HPS STREETLIGHT	200w HPS STREETLIGHT	250w HPS STREETLIGHT	400w HPS STREETLIGHT	5' CONTOUR LINE	1' CONTOUR LINE	EDGE OF P.W.M.T.	"A" TYPE CURBS	"L" TYPE CURBS	WALLS	FENCES	SPOT ELEVATIONS	SIGNS		
	PROPERTY LINE	SAWCUT LINE	LIGHT AC P.W.M.T.			EXISTING:	⦿	○	⦿	⦿	▷	⦿	⦿	⦿	⦿	⦿	⦿	⦿	---	---	---	---	---	---	---	---	(12.34)	---
	ROW LINE	SCARP LINE	CONC. P.W.M.T.			PROPOSED:	⦿	⦿	⦿	⦿	▷	⦿	⦿	⦿	⦿	⦿	⦿	⦿	---	---	---	---	---	---	---	---	12.34 BC	---

Nevada By Design
ENGINEERING CONSULTANTS
3515 East Harmon Avenue
Las Vegas, NV 89121
www.nvbydesign.com

CLARK COUNTY SCHOOL DISTRICT
CONSTRUCTION MANAGEMENT
4828 PEARL STREET
LAS VEGAS, NEVADA 89121

ROY MARTIN MIDDLE SCHOOL REPLACEMENT
DEMOLITION PLAN
28TH STREET / SUNRISE AVENUE

C1.02
SHEET 3 of 49
715-3B 21350