
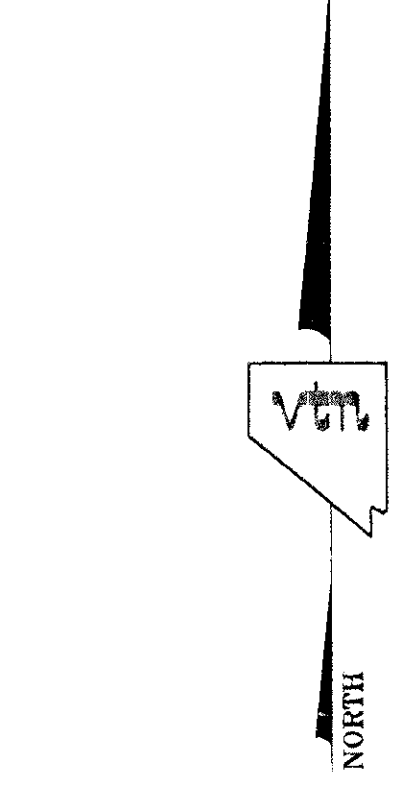


12807

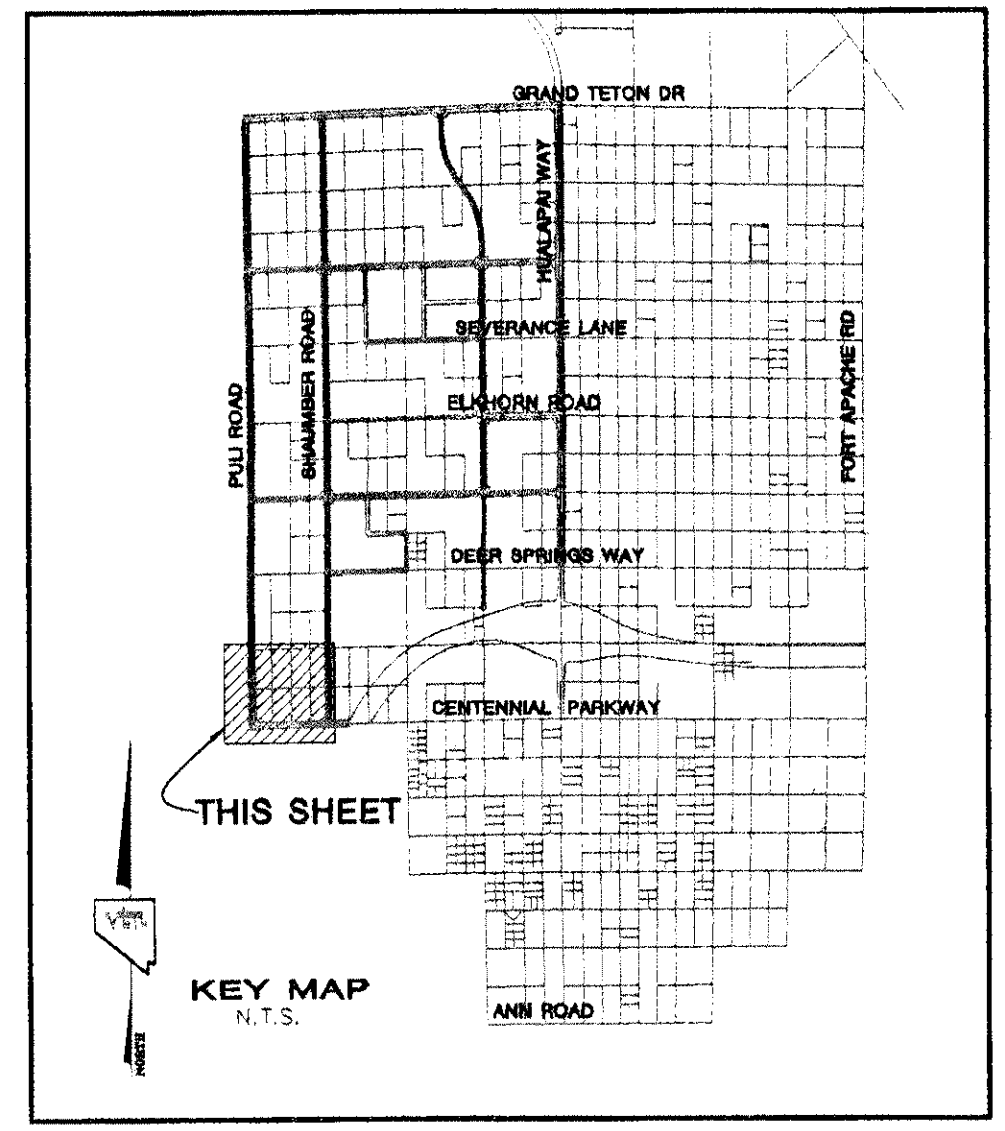

ZON - 1520  
 TMP - 6189  
 FMP - 0712  
 10615 BARNACLE AVE. (MSK)

**NOTES**

- (1) NO MORE THAN TWO (2) OF THE SAME COURTYARD PLAN NUMBERS ARE ALLOWED TO BE ADJACENT TO ONE ANOTHER. SECTION 3.3.1 OF THE CLIFFS EDGE DESIGN GUIDELINES.
- (2) NO MORE THAN THREE (3) CONTIGUOUS LOTS MAY HAVE THE SAME REAR SETBACK; OTHERWISE AN ADDITIONAL OFFSET OF AT LEAST 3' IS REQUIRED. SECTION 3.3.2 OF THE CLIFFS EDGE DESIGN GUIDELINES.
- (3) NO MORE THAN THREE (3) ADJACENT DWELLINGS MAY HAVE THE SAME REAR SETBACK; OTHERWISE AN ADDITIONAL OFFSET OF AT LEAST 3' IS REQUIRED. SECTION 3.3.5 OF THE CLIFFS EDGE DESIGN GUIDELINES.

Lot # 3  
 8-15-11  
 CLV 42215 - 42218

Call before you Dig  
 1-800-227-2600

Call before you Overhead  
 1-702-227-2929

CITY OF LAS VEGAS		RYLAND HOMES	
8625 W. RUSSEL ROAD LAS VEGAS, NV 89146 (702) 360-7300		RYLAND HOMES 8625 W. RUSSEL ROAD LAS VEGAS, NV 89146 (702) 360-7300	
LOT FIT ANALYSIS		RYLAND HOMES @ CLIFFS EDGE PODS 305 AND 309	
DRAWN BY:	MAY, 2008	CHECKED BY:	MAY, 2008
DESIGNED BY:		PROJECT NO:	5,998
		SCALE:	1" = 60' HORIZ. NA VERT.
SHEET LF1		REVISION	
1 OF 2 SHEETS		7	BY
DRAWING NO.		6	DATE
		5	REV
		4	
		3	
		2	
		1	