


GREATER LAS VEGAS

TRACT No 2

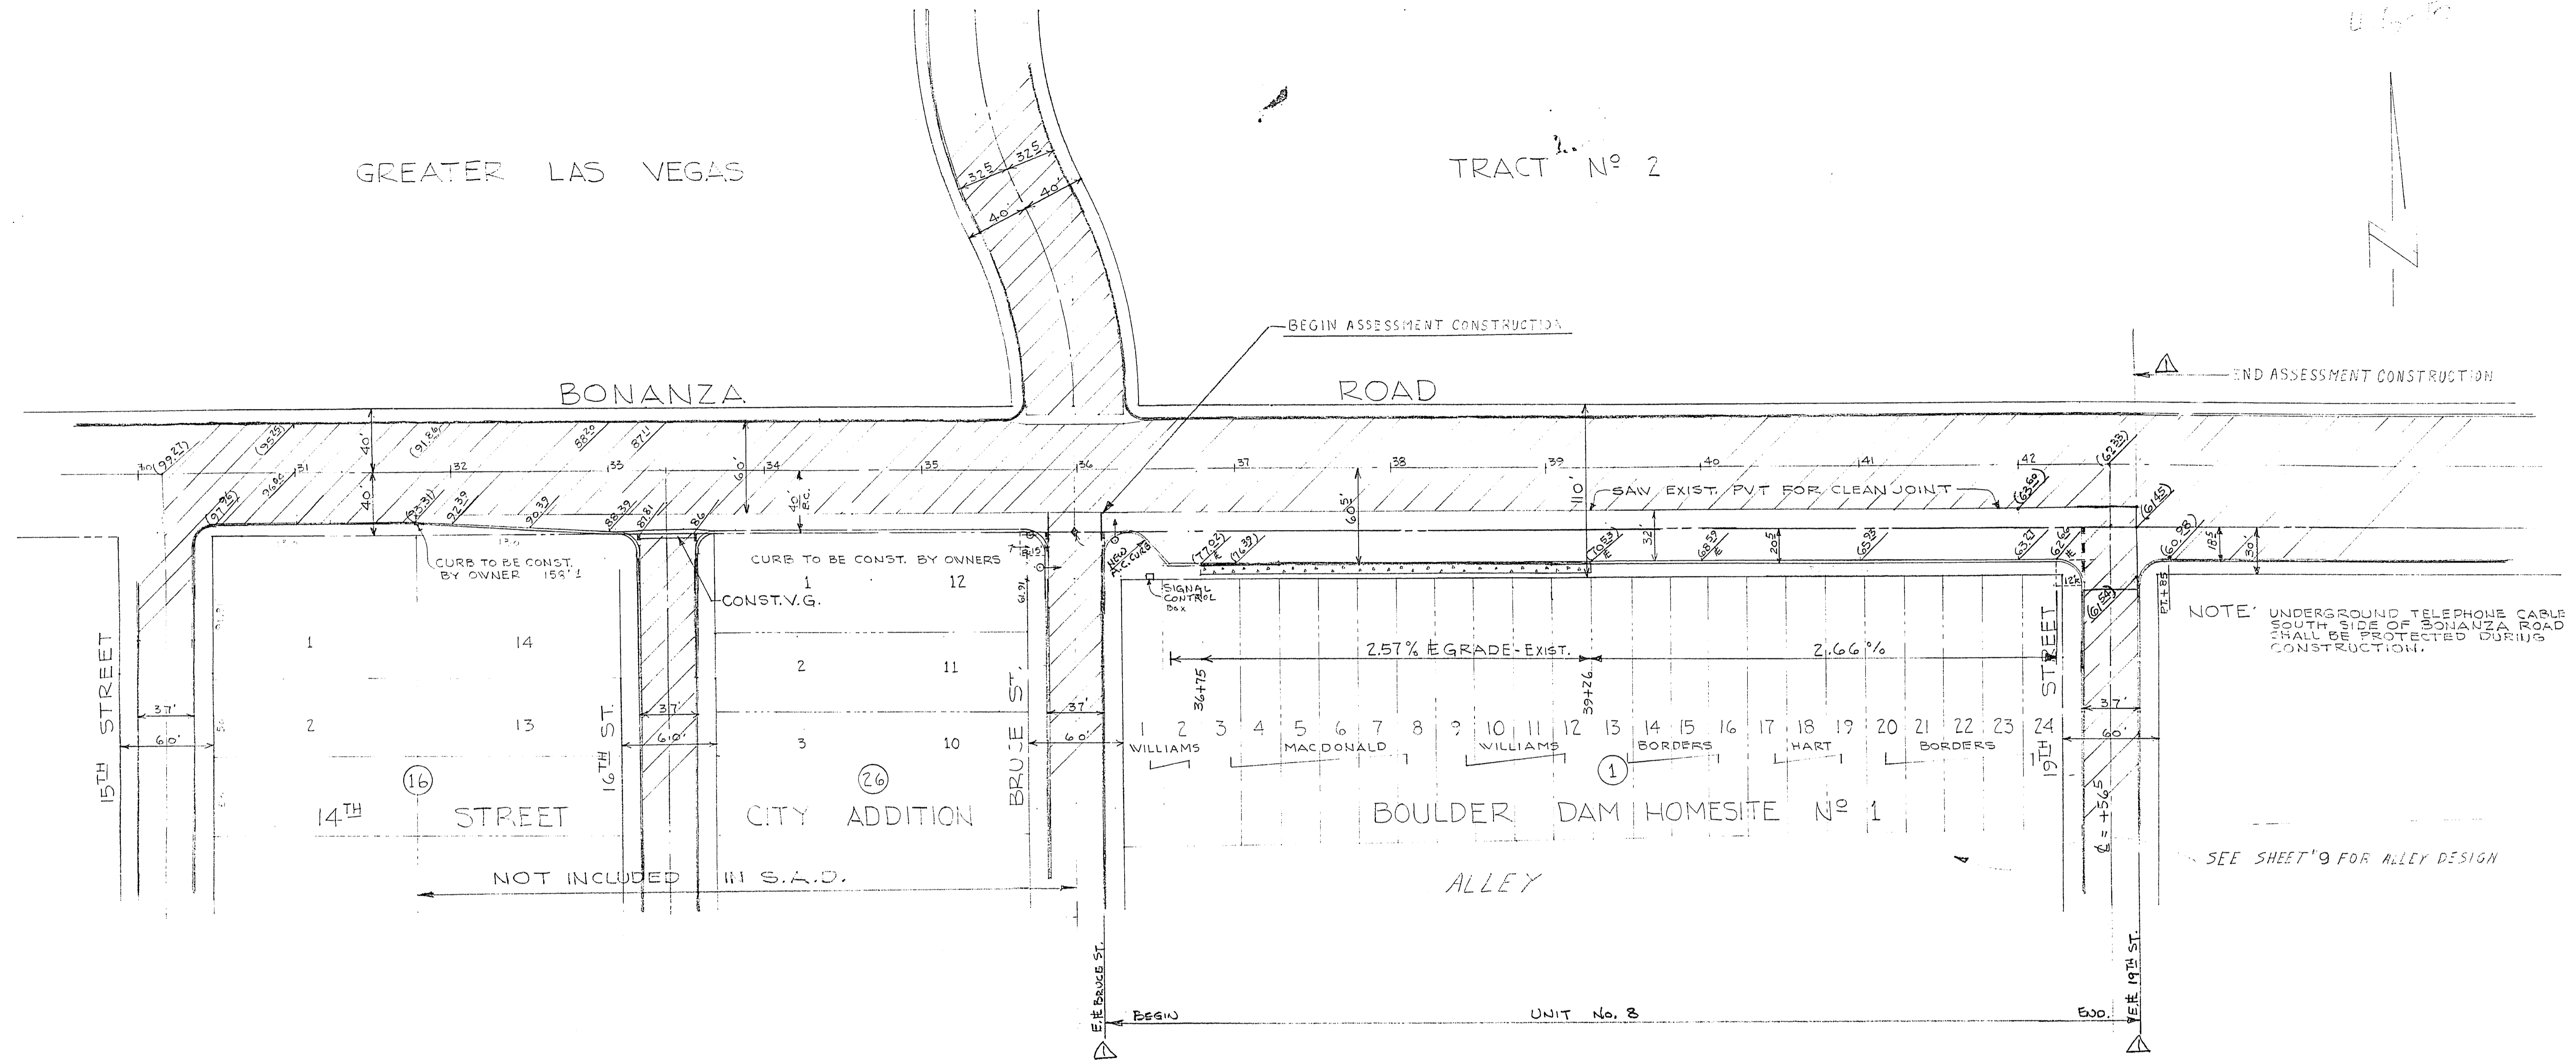

REVISION Δ Flow Line Grades & Construction Limits
 S.A.D. 445 UNIT 8

CITY OF LAS VEGAS NEVADA ENGINEERING DEPT.		
BONANZA ROAD - 16 TH TO 19 TH		
DES.	DATE	SC. (H) 1" = 50'
DR. PATTERSON	1-11-63	SC. (V) 1"
CKD. [Signature]		F.B.K. NO. 67-7X
APPROVED BY CITY ENGR.	2/5/63	P.L.G. NO.
[Signature]		DRAWING NO. 445