

PLAN

DATE	
BY	
CHECKED	
APPROVED	
NO.	

PROFILE

DATE	
BY	
CHECKED	
APPROVED	
NO.	

NOTE:
 ① ALL UTILITIES SHOWN ON THESE PLANS ARE INDICATED FOR CONTRACTOR'S CONVENIENCE ONLY. THE CITY ASSUMES NO RESPONSIBILITY AS TO THE EXACT LOCATION OR DEPTH. IT SHALL BE THE RESPONSIBILITY OF THE CONTRACTOR TO VERIFY LOCATION AND DEPTH WITH UTILITY CO'S INVOLVED AND EXERCISE EXTREME CAUTION AT ALL TIMES TO PROTECT THESE UTILITIES. ANY DAMAGES WILL BE REPAIRED AT CONTRACTOR'S EXPENSE.
 ② ONLY CONCENTRIC MANHOLES TO BE USED IN THIS CONTRACT

EXISTING UTILITIES ARE LOCATED ON THE PLANS FOR THE CONVENIENCE OF THE CONTRACTOR ONLY. THE CONTRACTOR SHALL BEAR FULL RESPONSIBILITY FOR PROTECTION OF UTILITIES AND THE CITY BEARS NO RESPONSIBILITY FOR UTILITIES NOT SHOWN ON THE PLANS OR NOT IN THE LOCATION SHOWN ON THE PLANS.

STATIONS REVISED PER NEW SURVEY HOUSE LATERALS ADDED, STA. 13+76 TO 15+11. GRADE CHANGED FROM 0.30% TO 0.45% BETWEEN MH. #4 & MH. #5. ELEV. REV. AT 15+00.

REV. APPROVED BY: [Signature] DATE: 11/17/65
 APPROVED BY: [Signature] DATE: 11/17/65

CONTRACT DRAWING

SAD 467 SANITARY SEWER

CITY OF LAS VEGAS NEVADA
 ENGINEERING DEPT.


REVERE (H) LAKE MEAD TO
 CAREY (KINSELLA)

DATE	11/17/65	SC. NO.	50
DR. DODD	11/17/65	SC. NO.	5
DR. J. J. SOW	11/17/65	FW. NO.	207X
CHK. [Signature]	11/17/65	FW. NO.	
APPROVED BY CITY ENGR.	[Signature]	DRAWING NO.	



THE SURFACE OF THE
FLOOR SHALL BE
AS SHOWN

LADDER W

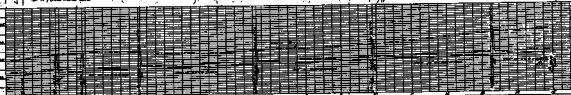


WHERE DO? STREET

LADDER




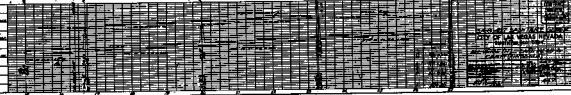

LADDER W

