5-2-88

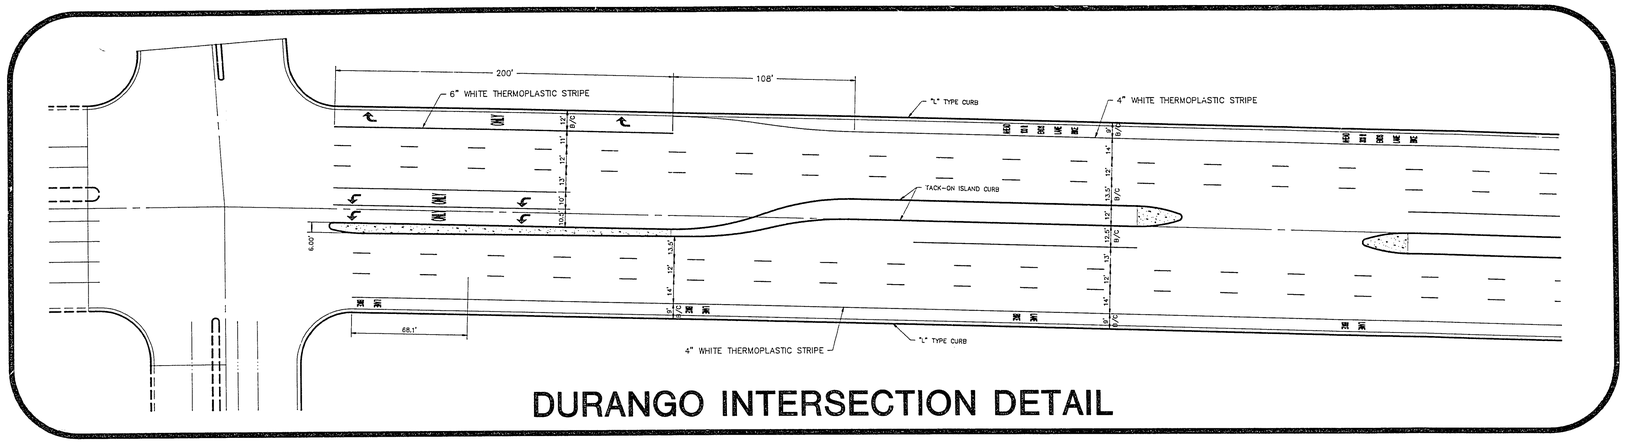

DURANGO INTERSECTION DETAIL

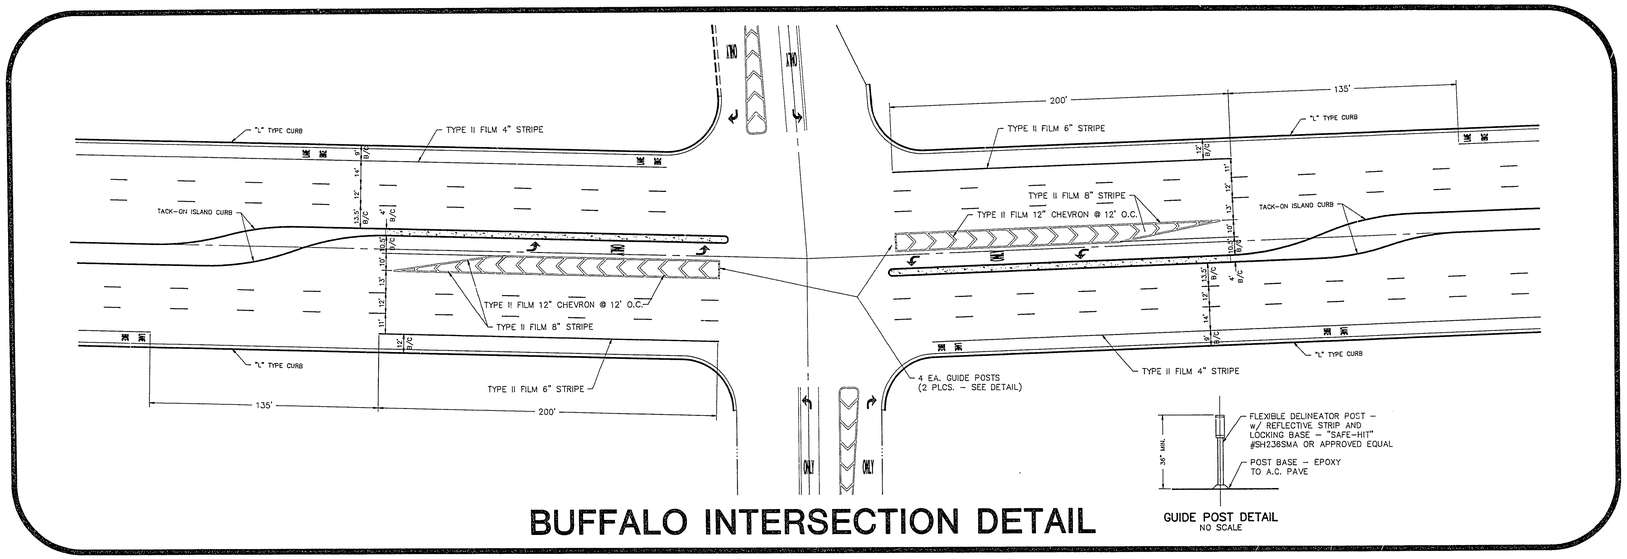

BUFFALO INTERSECTION DETAIL

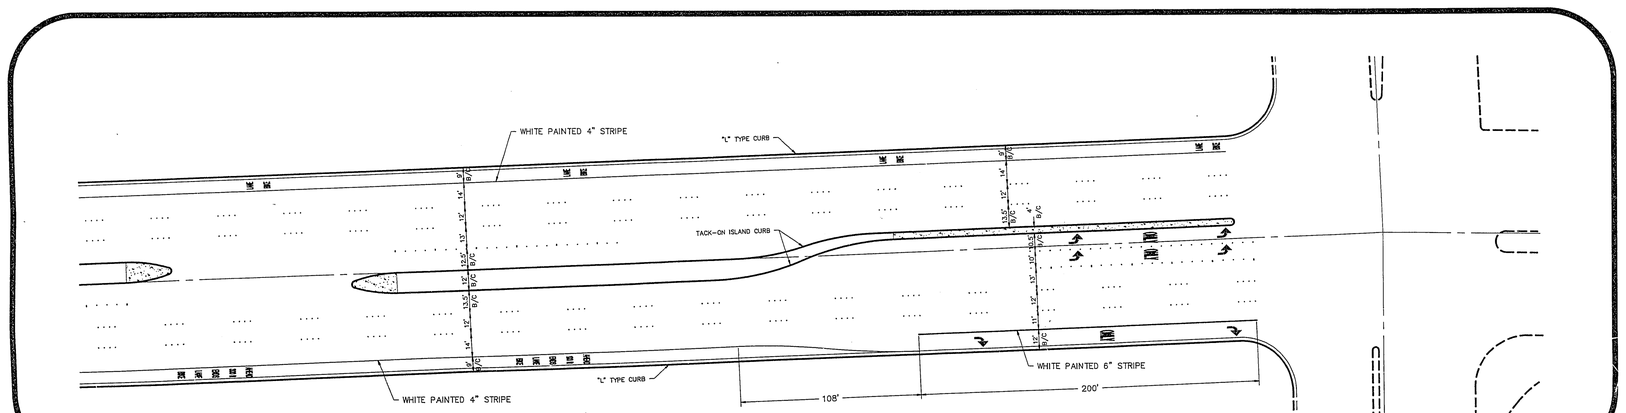

RAINBOW INTERSECTION DETAIL

N

SCALE: 1" = 40'

APRVL	REV	DATE	BY	REVISION

ENGINEERS & SURVEYORS, INC.
7008 BW. SAHARA AVENUE
LAS VEGAS, NEVADA 89117
(702) 876-1455
CIVIL

STATE OF NEVADA
REGISTERED PROFESSIONAL ENGINEER
No. 5000

SUBMITTED BY:

9/1/92

TITLE: INTERSECTION DELINEATION DETAILS

PROJECT: S.I.D. No. 1427 - SAHARA AVENUE (DURANGO DRIVE TO RAINBOW BOULEVARD)

W.O. # :	130-9520
BY :	GENE/DSR
DATE :	JUNE 1992
SCALE :	1"=40'

C.L.V. DRAWING No. 107-V-2036

T-11 43 / 43

Sh 6 of 3

107-V2036

"As Built"