

CONDITIONAL APPROVAL OF VALVED OUTLET (6\"/>

NOTE: APPROVAL OF THESE PLANS FOR THE WATER STUBOUT INSTALLATIONS WILL NOT BE CONSTRUED AS A COMMITMENT FOR WATER SERVICE TO THESE PROPERTIES.


REVISION	DATE	BY	DESCRIPTION
1	05-08-95	DWC	ADD SAN. & WATER LAT. & DRIVE (SHEET 6-25-73)
2	07-15-95	DWC	DELETE & WATER LAT. & STA. 06+57.00 (MURKIN SHEET)

 SUBMITTED BY: *[Signature]* 6/25/92

**Call before you Dig**  
 1-800-227-2600  
 UNDERGROUND SERVICE, USA

NOTE: SEE SHEET 2 OF 43, GENERAL NOTE NO. 17 FOR UTILITY CROSSINGS.

NOTE: ALL FINISH GRADES OF ASPHALT SHALL BE FLUSH WITH LIP OF GUTTER. ADJUST EXISTING AND PROPOSED MANHOLES IN THE PAVEMENT AREA ACCORDINGLY.

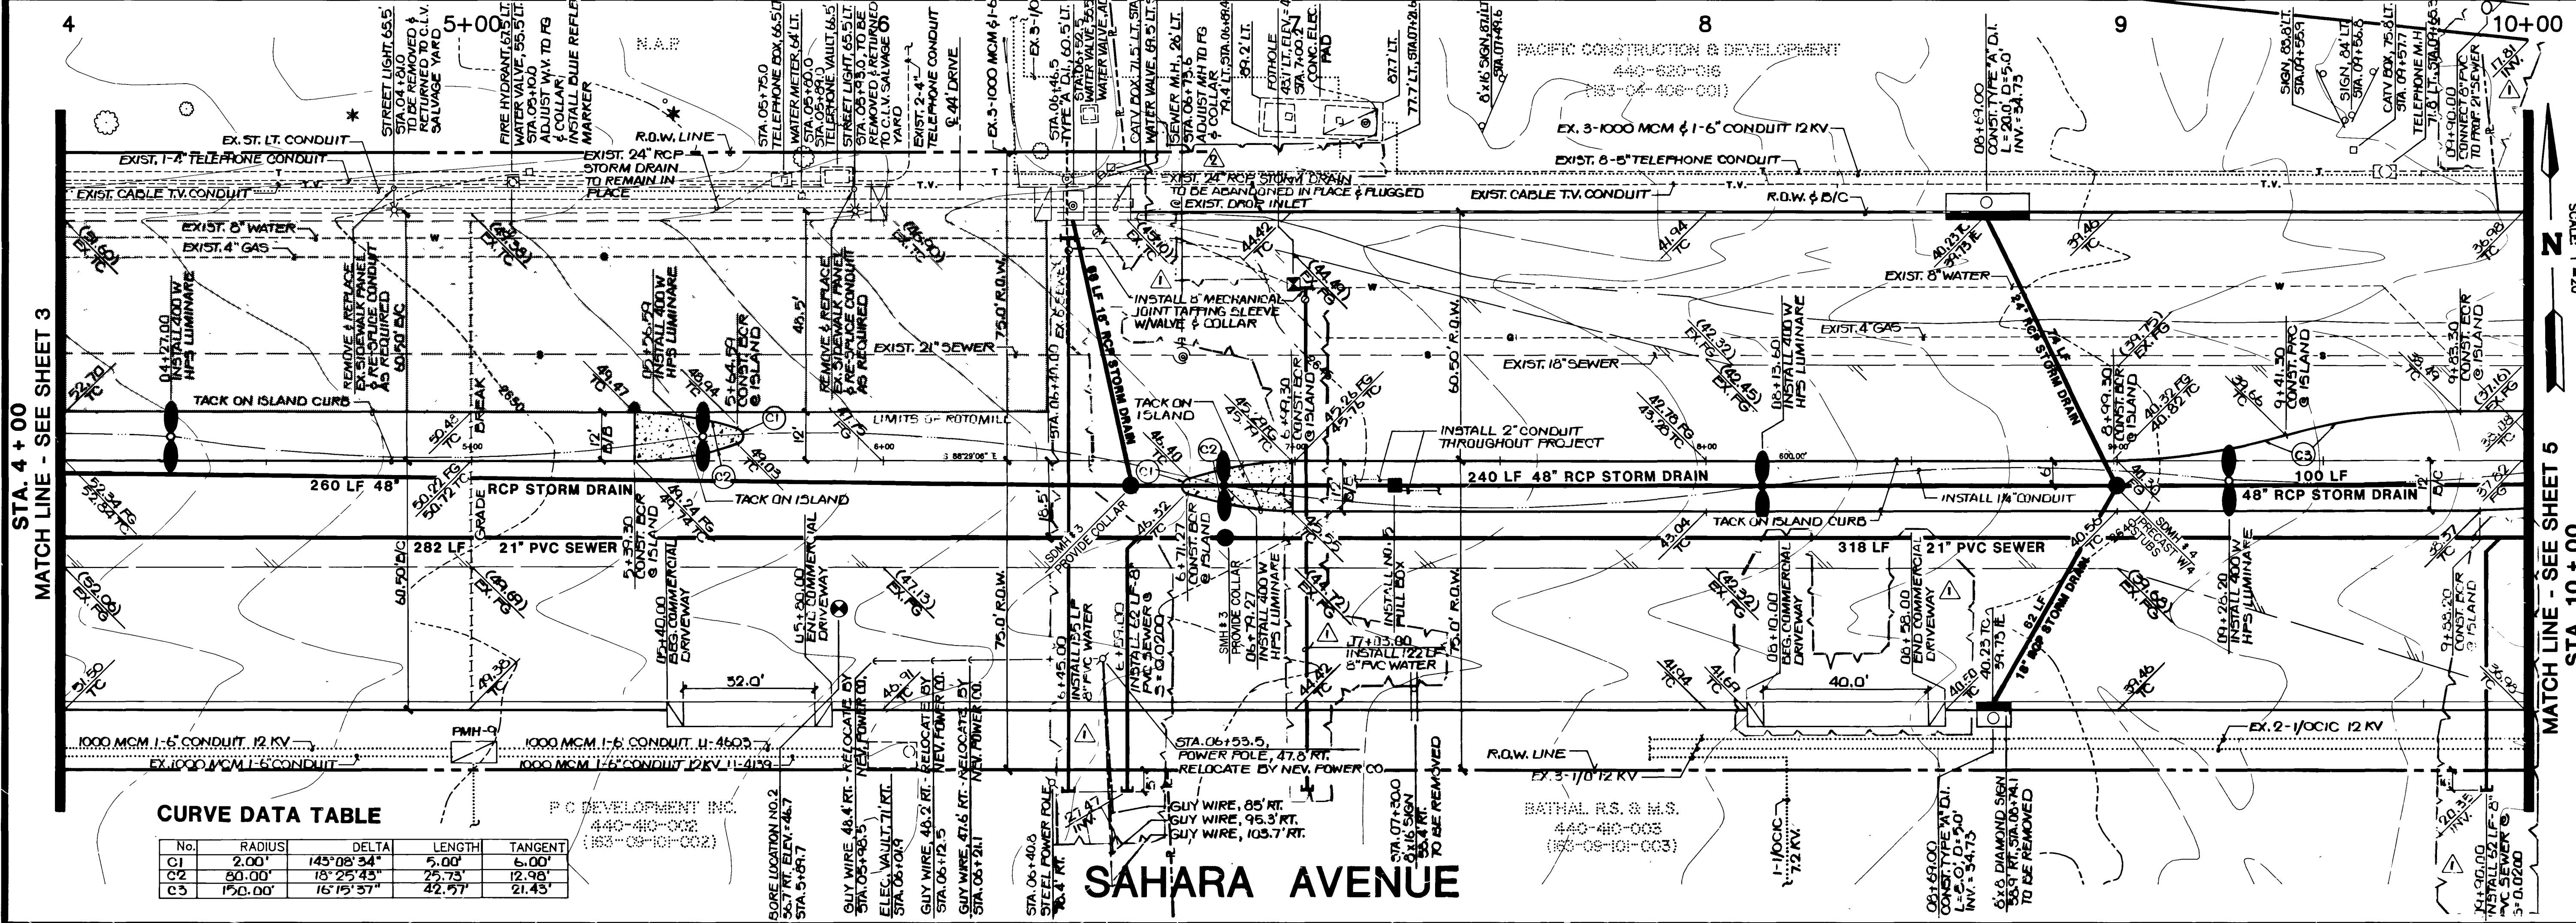

**CURVE DATA TABLE**

No.	RADIUS	DELTA	LENGTH	TANGENT
C1	2.00'	145°08'34"	5.00'	6.00'



SCALE: 1"=20'

**STREET & SEWER PLAN & PROFILE**  
 (STA. 4+00 TO STA. 10+00)

PROJECT: **S.I.D.1427 - SAHARA AVENUE (DURANGO DRIVE TO RAINBOW BOULEVARD)**

W.O. #: 130-9520  
 BY: CHAO/BLOOM  
 DATE: 5/91  
 SCALE: VERT. 1"=4'  
 HORIZ. 1"=20'

CLV. DRAWING NO. **4**  
 107-V-2036 **43**

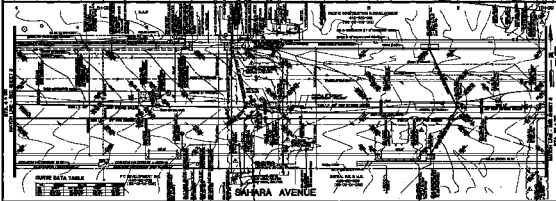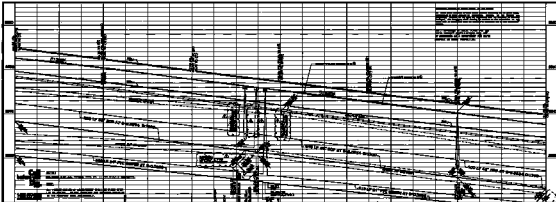




